


DRAWING NUMBER MD-216-39WL-EG-CV-GAD-1707 REV D01

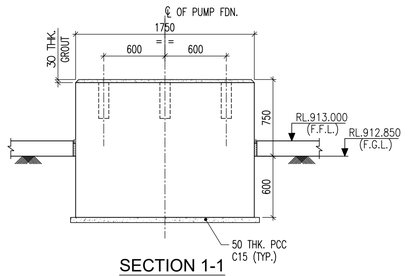


SECTION 1-1
(SCALE 1:30)

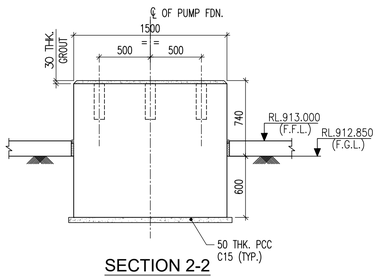


SECTION 2-2
(SCALE 1:30)

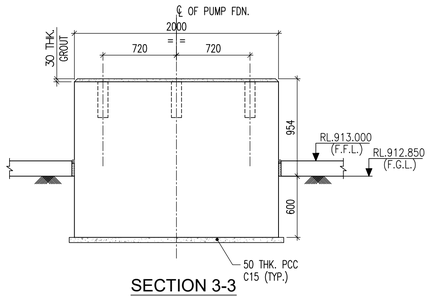


SECTION 3-3
(SCALE 1:30)

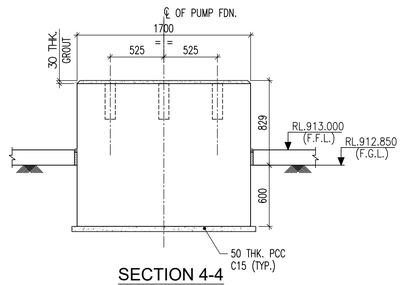


SECTION 4-4
(SCALE 1:30)

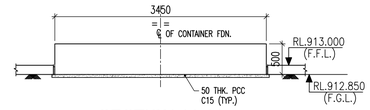


SECTION 11-11
(SCALE 1:50)

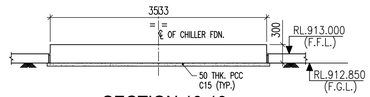


SECTION 10-10
(SCALE 1:50)

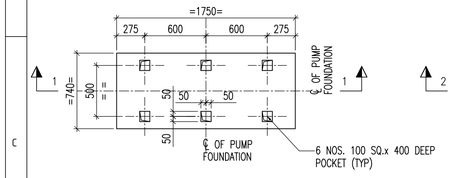


FDN. FOR PUMP MKD.
39WF-PMP-001, 002
(SCALE 1:30)

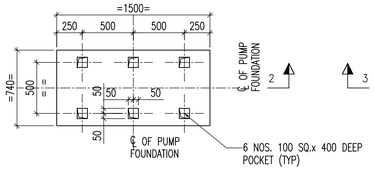


FDN. FOR PUMP MKD.
39WF-PMP-003, 004
(SCALE 1:30)

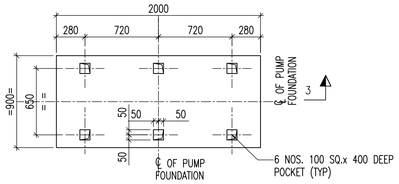


FDN. FOR PUMP MKD.
39WL-PMP-006 & 007
(SCALE 1:30)

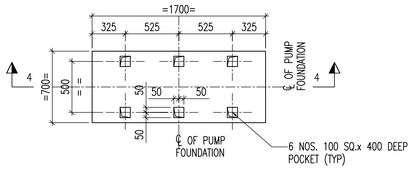


FDN. FOR PUMP MKD.
39WL-PMP-014 & 015
(SCALE 1:30)

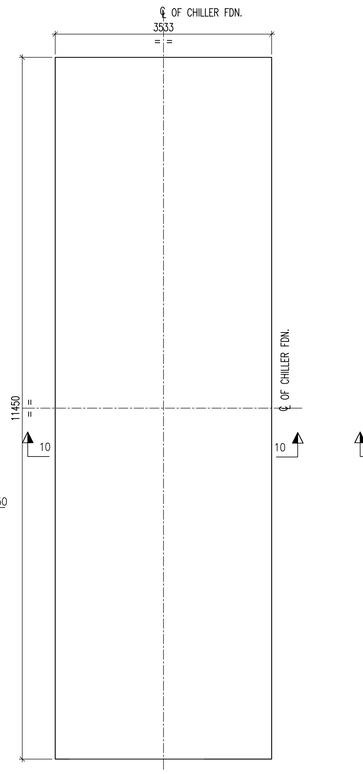


FDN. FOR CHILLER MKD.
39WL-CLR-001
(SCALE 1:50)

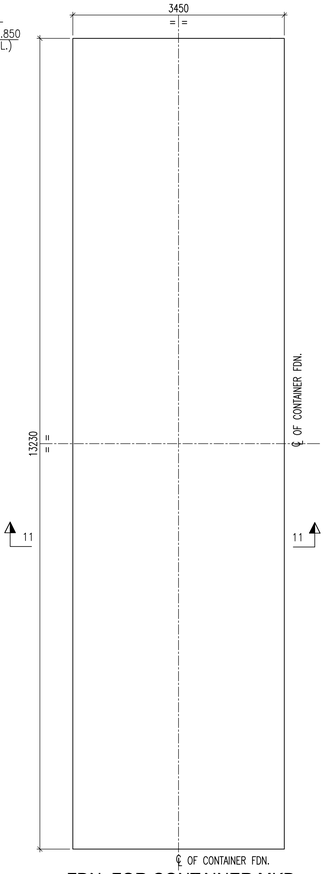


FDN. FOR CONTAINER MKD.
39WL-CON-001 & 002
(SCALE 1:50)

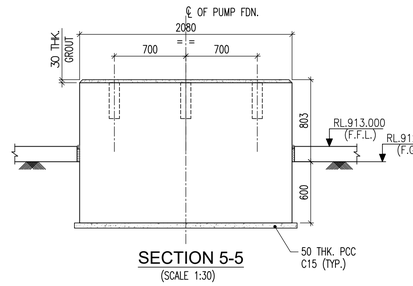


SECTION 5-5
(SCALE 1:30)

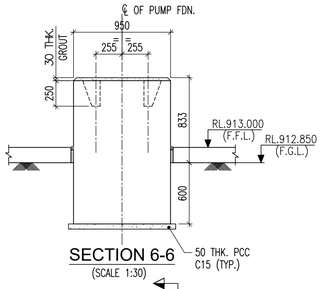


SECTION 6-6
(SCALE 1:30)

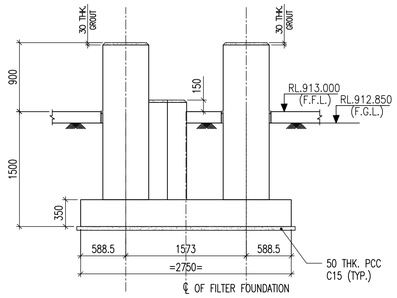


SECTION 7-7
(SCALE 1:40)

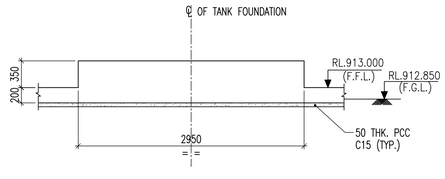


SECTION 8-8
(SCALE 1:40)

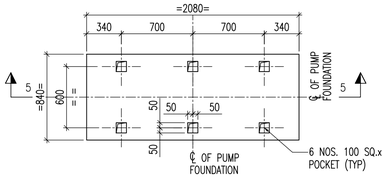


FDN. FOR PUMP MKD.
39WQ-PMP-008, 009
(SCALE 1:30)

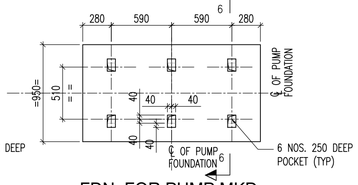


FDN. FOR PUMP MKD.
39WL-PMP-200, 201
(SCALE 1:30)

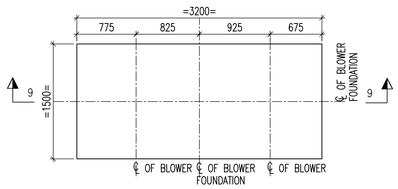


FDN. FOR BLOWER MKD.
39WL-BLW-201 & 202
(SCALE 1:40)

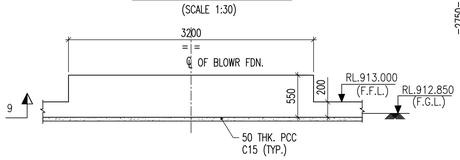


SECTION 9-9
(SCALE 1:40)

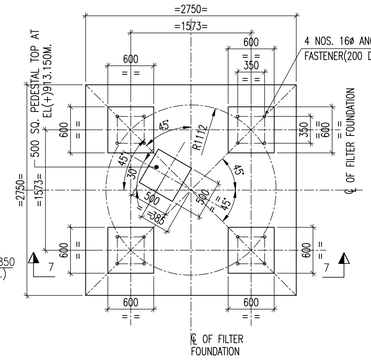


FDN. FOR, FILTER MKD.
39WL-FLT-200, 201, 202,203 & 206
(SCALE 1:40)

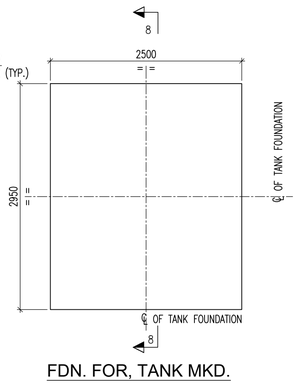

FDN. FOR, TANK MKD.
39WL-TNK-002
(SCALE 1:40)

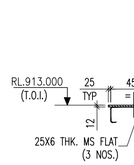

VIEW : X-X

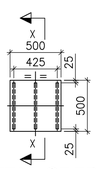

DETAIL OF EP1
(SCALE - 1:30)

LEGEND :-

R.L. – REDUCED LEVEL
℄ – CENTRE LINE
T.O.C. – TOP OF CONCRETE
TYP. – TYPICAL
F.G.L. – FINISHED GROUND LEVEL
F.F.L. – FINISHED FLOOR LEVEL
B.O.F. – BOTTOM OF FOUNDATION
MKD. – MARKED
P.C.C – PLAIN CEMENT CONCRETE
DET. – DETAIL
SQ. – SQUARE
R.C. – REINFORCED CONCRETE
FDN. – FOUNDATION
THK. – THICK

NOTES:-

1. ALL DIMENSIONS ARE IN MILLIMETRES AND LEVELS AND CO-ORDINATES ARE IN METRES UNLESS OTHERWISE STATED.
2. NET SAFE BEARING CAPACITY OF SOIL AT BOTTOM OF FOUNDATION CONSIDER 200KN/ SQ. M
3. GRADE OF CONCRETE SHALL BE C35 (35MPa) FOR FOUNDATION & C15 (15MPa) FOR BLINDING CONCRETE.
4. GRADE OF REINFORCEMENT SHALL BE DEFORMED BAR 420 MPa (GRADE 60) – ASTM A615/A615M.
5. IF ANY PART OF FOUNDATION COMES ON BACKFILL ZONE OF ADJACENT FOUNDATION OR ANY LOOSE SOIL ARE ENCOUNTERED BELOW FOUNDATION LEVEL THE SAME SHALL BE REMOVED AND FILLED WITH PCC (C15).
6. CLEAR COVER TO REINFORCEMENT SHALL BE a. FOUNDATIONS = 50 MM., b. COLUMNS = 50 MM.
7. FOR STANDARD REINFORCEMENT DETAIL & GENERAL NOTES FOR CIVIL WORKS REFER DRAWING NO. MD-216-1000-EG-CV-DED-1005 & 1001.
8. THIS DRAWING SHOULD BE READ IN CONJUNCTION WITH DRAWING NO. MD-216-39WL-EG-CV-GAD-1708, MD-216-39WL-EG-CV-GAD-1706, 1709 ,1710, 1716, 1717 &, 1551

DOCUMENT NUMBER	REFERENCE DOCUMENTS	REV	DATE	REVISION DESCRIPTION	DRN	CHK	ENG	APP	EMP
MD-216-39WL-EG-CV-GAD-1708	DETAIL OF FOUNDATION								
MD-216-39WL-EG-CV-GAD-1707	LAYOUT & DETAIL OF FOUNDATION	D01	09/03/2023	AS-BUILT	ABS	SJM	AVG	AG	
MD-216-1000-EG-ST-CRT-1001	CIVIL, STRUCTURAL & ARCHITECTURAL-DESIGN CRITERIA	C02	17/02/2021	ISSUED FOR CONSTRUCTION AND REVISED AS MKD. △C02	ABS	SJM	AVG	AG	
MD-216-3310-EG-ME-GAD-1055	PLAN AT EL. +913.000	C01	27/11/2020	ISSUED FOR CONSTRUCTION.	SC	TG	AVG	AG	
MD-216-3310-EG-CV-GAD-1177	LAYOUT & DETAIL OF GRADE SLAB	A01	12/10/2020	ISSUED FOR REFERENCE	SC	TG	AVG	AG	

RESERVED FOR VENDOR LOGO AND DRAWING NUMBER

LARSEN & TOUBRO

This drawing is the property of LARSEN & TOUBRO and must not be passed on to any person or body not authorized by us to receive it nor be copied or otherwise made use either in full or in part by such person or body without our prior permission in writing.

Outotec

The content of these documents are the sole property of Outotec Oyj. Any rights not expressly granted herein are reserved. Reproduction, transfer or distribution of part or all of the contents in any form without prior written permission of Outotec is prohibited.

MA'ADEN معادن
Saudi Arabian Mining Company شركة التعدين العربية السعودية

This document and the information contained herein is Ma'aden proprietary know-how. This document or any part thereof should not be reproduced, stored in a retrieval system or transmitted by any means, electronic or otherwise, or divulged without prior written permission of Ma'aden.

LARSEN & TOUBRO DRAWING NUMBER	019045_080_C_G_24436_002	REVISION 3
OUTOTEC DRAWING NUMBER	900707 _GAU01 _AG11 _MTL01 _39233	DOCUMENT ID OU100704409 REVISION 3

DRAWN	SC	12/10/2020
CHECKED	TG	12/10/2020
ENGINEER	AVG	13/10/2020
APPROVED	AG	13/10/2020
EMPLOYER		
SCALE	1:20, 1:50, 1:150	A1

MANSOURAH - MASSARAH GOLD PROJECT
GENERAL ARRANGEMENT DRAWING
RAW WATER
GA. & DETAILS OF FOUNDATION

DRAWING NUMBER MD-216-39WL-EG-CV-GAD-1707 REV D01