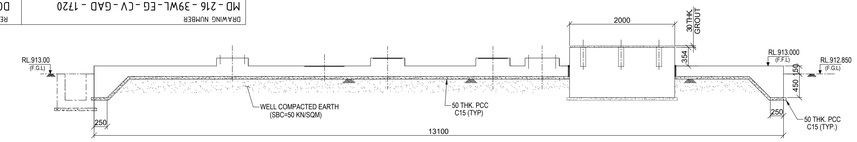
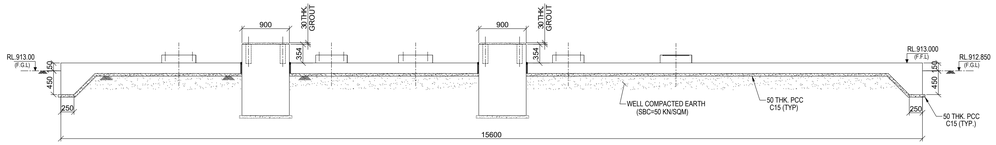
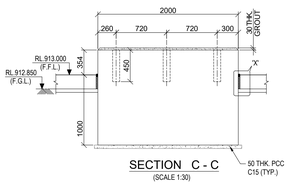
DRAWING NUMBER: MD-216-39WL-EG-CV-GAD-1720 REV D01



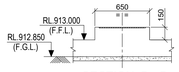

SECTION A - A
( SCALE - 1:40 )





SECTION B - B
( SCALE - 1:40 )





SECTION C - C
(SCALE 1:30)





SECTION D - D
(SCALE 1:25)

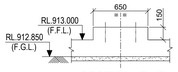



SECTION E - E
(SCALE 1:25)

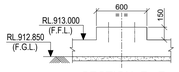



SECTION F - F
(SCALE 1:25)

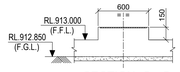



SECTION G - G
(SCALE 1:25)

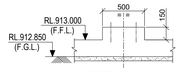



SECTION H - H
(SCALE 1:25)

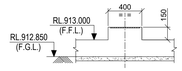



SECTION J - J
(SCALE 1:25)

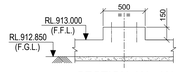



SECTION K1 - K1
(SCALE 1:25)

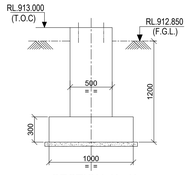



SECTION K - K
(SCALE 1:25)

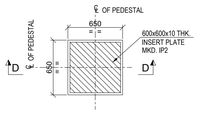

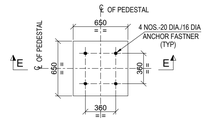

TYP. DETAIL OF PEDESTAL MKD. P1
(SCALE 1:25)



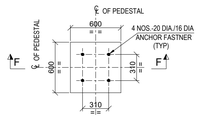

TYP. DETAIL OF PEDESTAL MKD. P2
(SCALE 1:25)



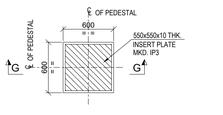

TYP. DETAIL OF PEDESTAL MKD. P3
(SCALE 1:25)



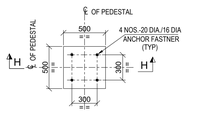

TYP. DETAIL OF PEDESTAL MKD. P4
(SCALE 1:25)



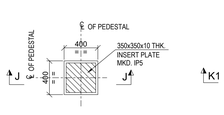

TYP. DETAIL OF PEDESTAL MKD. P5
(SCALE 1:25)



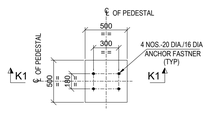

TYP. DETAIL OF PEDESTAL MKD. P6
(SCALE 1:25)



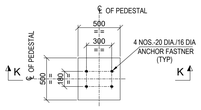

TYP. DETAIL OF PEDESTAL MKD. P7A
(SCALE 1:25)



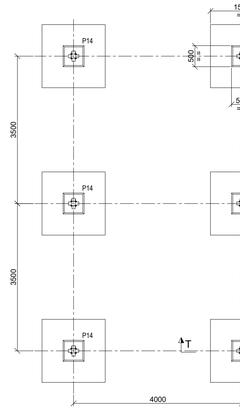

TYP. DETAIL OF PEDESTAL MKD. P7
(SCALE 1:25)





FOUNDATION PLAN FOR SHED
(SCALE 1:50)

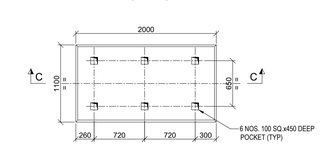

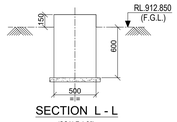

DETAIL OF PUMP FOUNDATION MKD. 39WL-PMP-004 & 39WL-PMP-005
(SCALE 1:30)





SECTION L - L
(SCALE 1:25)

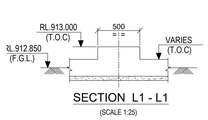



SECTION L1 - L1
(SCALE 1:25)

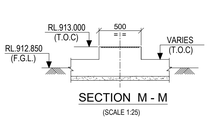



SECTION M - M
(SCALE 1:25)

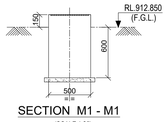



SECTION M1 - M1
(SCALE 1:25)

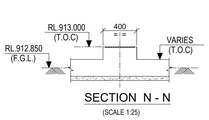



SECTION N - N
(SCALE 1:25)

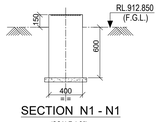



SECTION N1 - N1
(SCALE 1:25)

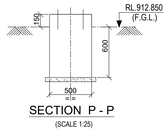



SECTION P - P
(SCALE 1:25)

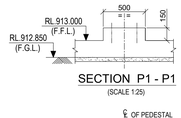



SECTION P1 - P1
(SCALE 1:25)

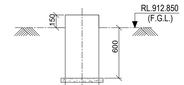



SECTION R - R
(SCALE 1:25)

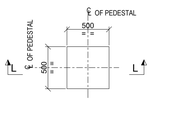

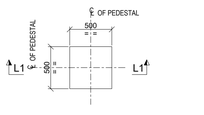

TYP. DETAIL OF PEDESTAL MKD. P8
(SCALE 1:25)



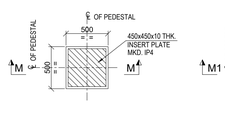

TYP. DETAIL OF PEDESTAL MKD. P8A
(SCALE 1:25)



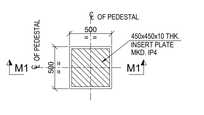

TYP. DETAIL OF PEDESTAL MKD. P9
(SCALE 1:25)



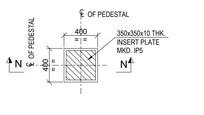

TYP. DETAIL OF PEDESTAL MKD. P9A
(SCALE 1:25)



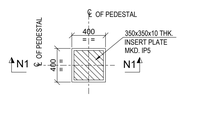

TYP. DETAIL OF PEDESTAL MKD. P10
(SCALE 1:25)



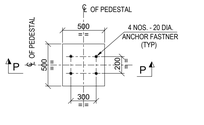

TYP. DETAIL OF PEDESTAL MKD. P10A
(SCALE 1:25)



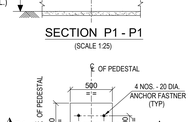

TYP. DETAIL OF PEDESTAL MKD. P11
(SCALE 1:25)



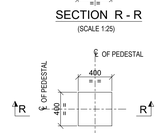

TYP. DETAIL OF PEDESTAL MKD. P11A
(SCALE 1:25)



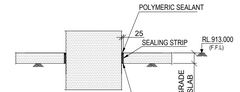

TYP. DETAIL OF PEDESTAL MKD. P12
(SCALE 1:25)





DETAIL - X
(SCALE 1:30)

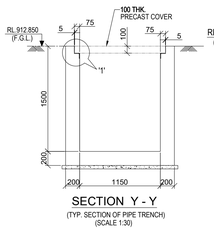

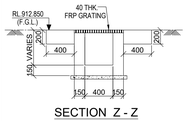

SECTION Y - Y
(TYP. SECTION OF PIPE TRENCH)
(SCALE 1:30)



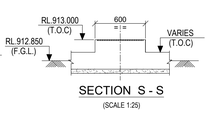

SECTION Z - Z
(TYP. SECTION OF OPEN DRAIN)
(SCALE 1:30)





SECTION S - S
(SCALE 1:25)

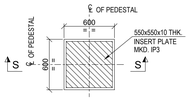

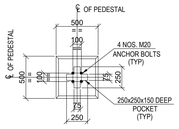

TYP. DETAIL OF PEDESTAL MKD. P13
(SCALE 1:25)



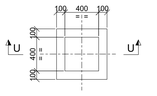

TYP. DETAIL OF PEDESTAL MKD. P14
(SCALE 1:25)



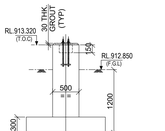

TYP. DETAIL OF PIT MKD. PT1
(SCALE 1:25)





SECTION T - T
( SCALE - 1:40 )

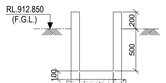


SECTION U - U
(SCALE 1:25)

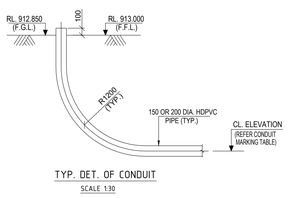



TYP. DET. OF CONDUIT
SCALE 1:30

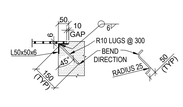



DETAIL - Y
(SCALE 1:10)

| CONDUIT MARKING TABLE | | |
|---|---|---|
| CONDUIT TAG | CL. OF ELEVATION | DIA. OF CONDUIT |
| C01 | RL. 912.350 | 200 |
| C02 | RL. 912.350 | 200 |
| C03 | RL. 912.350 | 200 |
| C04 | RL. 912.350 | 200 |
| C05 | RL. 912.350 | 200 |
| C06 | RL. 912.050 | 200 |
| C07 | RL. 912.050 | 200 |
| C08 | RL. 912.050 | 200 |
| C09 | RL. 912.050 | 200 |
| C10 | RL. 912.050 | 200 |
| C11 | RL. 911.750 | 200 |
| C12 | RL. 911.750 | 200 |
| C13 | RL. 911.750 | 200 |
| C14 | RL. 911.750 | 200 |
| C15 | RL. 911.750 | 200 |


| CONDUIT MARKING TABLE | | |
|---|---|---|
| CONDUIT TAG | CL. OF ELEVATION | DIA. OF CONDUIT |
| C16 | RL. 911.600 | 200 |
| C17 | RL. 911.600 | 200 |
| C18 | RL. 911.600 | 200 |
| C19 | RL. 911.600 | 200 |
| C20 | RL. 911.600 | 200 |
| C21 | RL. 911.300 | 200 |
| C22 | RL. 911.300 | 200 |
| C23 | RL. 911.300 | 200 |
| C24 | RL. 911.300 | 200 |
| C25 | RL. 911.300 | 200 |
| C26 | RL. 911.000 | 200 |
| C27 | RL. 911.000 | 200 |
| C28 | RL. 911.000 | 200 |
| C29 | RL. 911.000 | 200 |
| C30 | RL. 911.000 | 200 |
| C31 | RL. 912.100 | 100 |
| C32 | RL. 912.100 | 100 |
| C33 | RL. 912.100 | 100 |
| C34 | RL. 912.100 | 100 |

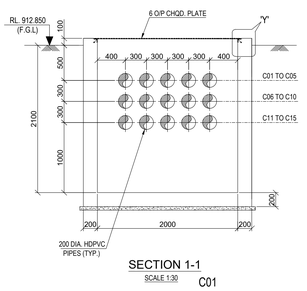



SECTION 1-1
SCALE 1:30 C01

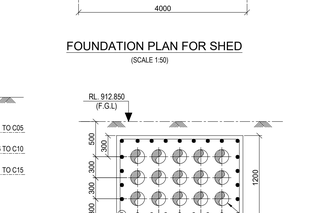

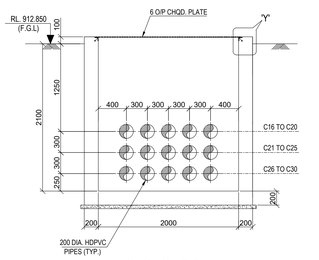

TYP. CROSS SECTION OF CONCRETE ENCASED CONDUIT BANK
(SCALE 1:30)





SECTION 2-2
SCALE 1:30

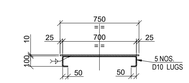



SECTION S1 - S1
(SCALE 1:20)

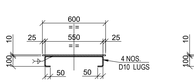



SECTION S2 - S2
(SCALE 1:20)

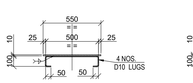



SECTION S3 - S3
(SCALE 1:20)

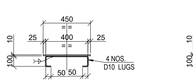



SECTION S4 - S4
(SCALE 1:20)

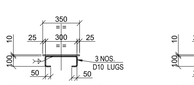



SECTION S5 - S5
(SCALE 1:20)

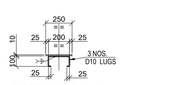



SECTION S6 - S6
(SCALE 1:20)

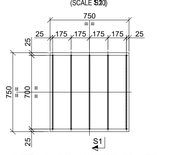

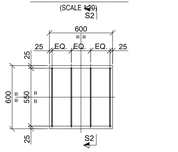

DETAIL OF INSERT PLATE MKD. IP1
(SCALE 1:20)



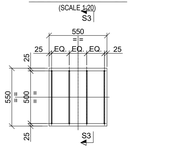

DETAIL OF INSERT PLATE MKD. IP2
(SCALE 1:20)



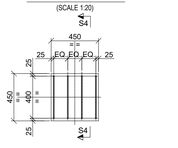

DETAIL OF INSERT PLATE MKD. IP3
(SCALE 1:20)



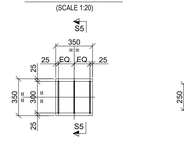
DETAIL OF INSERT PLATE MKD. IP4
(SCALE 1:20)



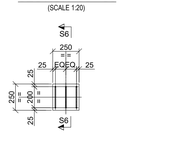
DETAIL OF INSERT PLATE MKD. IP5
(SCALE 1:20)




DETAIL OF INSERT PLATE MKD. IP6
(SCALE 1:20)

LEGEND :-

R.L - REDUCED LEVEL
℄ -CENTRE LINE
T.O.C. - TOP OF CONCRETE
TYP - TYPICAL
P.C.C - PLAIN CEMENT CONCRETE
MKD. - MARKED
THK. - THICK
R.C.C - REINFORCED CEMENT CONCRETE
C/C - CENTRE TO CENTRE
DET - DETAIL
DRG. - DRAWING
T.O.P - TOP OF PAVING
F.G.L - FINISHED GROUND LEVEL
I.L - INVERT LEVEL
F.F.L - FINISHED FLOOR LEVEL
DIA. - DIAMETER

NOTES :-

1. ALL DIMENSIONS ARE IN MILLIMETRES AND LEVELS AND CO-ORDINATES ARE IN METRES, UNLESS OTHERWISE STATED.
2. GRADE OF CONCRETE SHALL BE C35 FOR FOUNDATION.
3. GRADE OF REINFORCEMENT SHALL BE DEFORMED BAR ASTM A615 - GRADE 60 (fy = 420 MPa).
4. NET SAFE BEARING CAPACITY OF SOIL AT BOTTOM OF FOUNDATION HAS BEEN CONSIDERED 200KN/SQM
5. IF ANY PART OF FOUNDATION COMES ON BACKFILL ZONE OF ADJACENT FOUNDATION OR ANY LOOSE SOIL ARE ENCOUNTERED BELOW FOUNDATION LEVEL THE SAME SHALL BE REMOVED AND FILLED WITH PCC (15MPa).
6. STRUCTURAL FILL SHALL CONFORM TO PROVISIONS OF DOCUMENT MD-216-1000-EG-CV-MST-1698.
7. FOR GENERAL NOTES OF CIVIL WORKS & STANDARD REINFORCEMENT DETAIL REFER DRAWING NO. MD-216-1000-EG-CV-DED-1001 & 1005.
8. FOR PLAN DETAIL REFER DRAWING NO. MD-216-39WL-EG-CV-GAD-1719.

| DOCUMENT NUMBER | REFERENCE DOCUMENTS | REV | DATE | REVISION DESCRIPTION | DRN | CHK | ENG | APP | EMP |
|---|---|---|---|---|---|---|---|---|---|
| MD-216-1000-EG-ST-GAD-1007 | RAW WATER - MISCELLANEOUS PIPE & CABLE SUPPORTS | D01 | 09/03/2023 | AS-BUILT | SYA | SJM | AVG | AG | |
| | PLAN, ELEVATION & SECTION | C02 | 21/02/2022 | ISSUED FOR CONSTRUCTION & REVISED AS MKD. C02 | SYA | SJM | AVG | AG | |
| MD-216-39WL-EG-PE-GAD-V563-1020 | 39WL RAW WATER - RAW WATER DISTRIBUTION PIPE | C01 | 08/04/2021 | ISSUED FOR CONSTRUCTION & REVISED AS MKD. C01 | AMJ | SJM | AVG | AG | |
| MD-216-1000-EG-ST-CRT-1001 | CIVIL,STRUCTURAL AND ARCHITECTURAL DESIGN CRITERIA | A01 | 12/02/2021 | ISSUED FOR APPROVAL | AMJ | SJM | AVG | AG | |

RESERVED FOR VENDOR LOGO AND DRAWING NUMBER

LARSEN & TOUBRO

This drawing is the property of LARSEN & TOUBRO and must not be passed on to any person or body not authorized by us to receive it nor be copied or otherwise made use either in full or in part by such person or body without our prior permission in writing.

Outotec

The content of these documents are the sole property of Outotec Oyj. Any rights not expressly granted herein are reserved. Reproduction, transfer or distribution of part or all of the contents in any form without prior written permission of Outotec is prohibited.

MA'ADEN معادن
Saudi Arabian Mining Company شركة معادن العربية السعودية

This document and the information contained herein is Ma'aden proprietary know-how. This document or any part thereof should not be reproduced, stored in a retrieval system or transmitted by any means, electronic or otherwise, or divulged without prior written permission of Ma'aden.

LARSEN & TOUBRO DRAWING NUMBER: 019045_080_C_G_24643_001 — REVISION: 3
OUTOTEC DRAWING NUMBER: 900707__GAU01__AG11__MTL01__39254 — DOCUMENT ID: OU100717186 — REVISION: 3

| | | |
|---|---|---|
| DRAWN | AMJ | 10/02/2021 |
| CHECKED | SJM | 11/02/2021 |
| ENGINEER | AVG | 10/02/2021 |
| APPROVED | AG | 15/02/2021 |
| EMPLOYER | | |
| SCALE | 1:100, 50, 30, 10 | A0 |

MANSOURAH - MASSARAH GOLD PROJECT
GENERAL ARRANGEMENT DRAWING
RAW WATER
DETAILS OF FOUNDATIONS & GRADE SLAB

DRAWING NUMBER: MD - 216 - 39WL-EG-CV-GAD - 1720 — REV: D01