


DRAWING NUMBER MD - 216 - 39WL - EG - CV - GAD - 1721 | REV D01

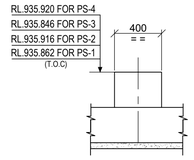


DETAIL OF PIPE SUPPORT
MKD. PS-1,PS-2 & PS-3
(SCALE 1:25)

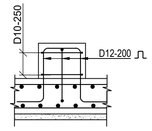


DETAIL OF PIPE SUPPORT
MKD. PS-1,PS-2 & PS-3
(RCC DETAIL)
(SCALE 1:25)

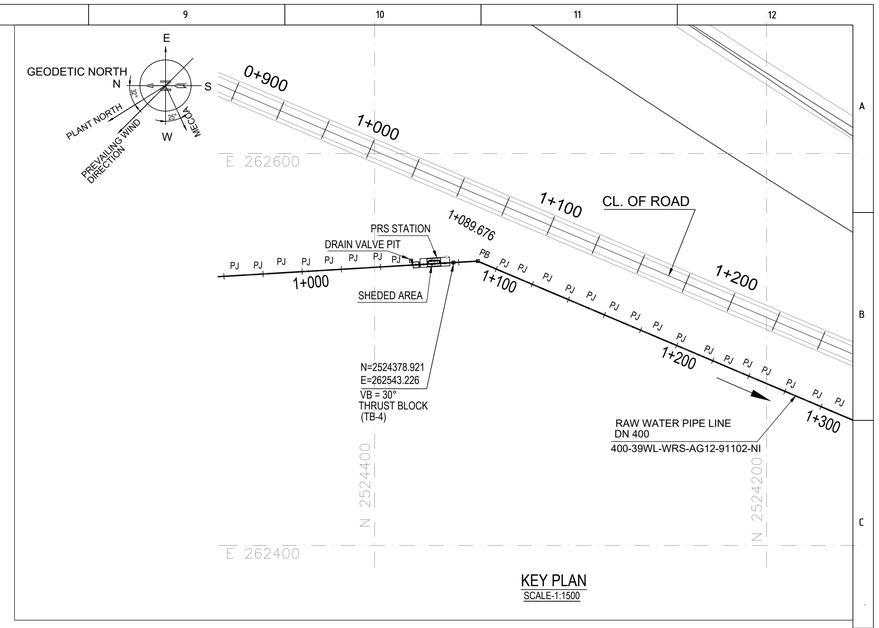


KEY PLAN
SCALE-1:1500

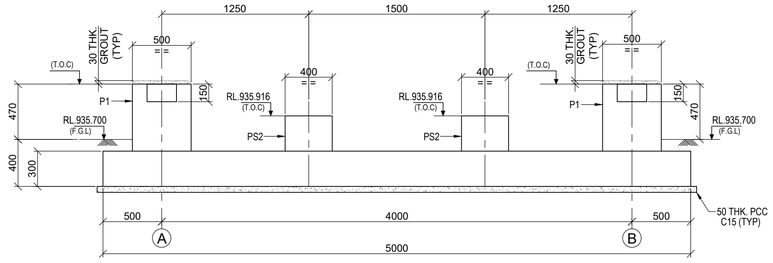


SECTION A - A
(SCALE 1:25)

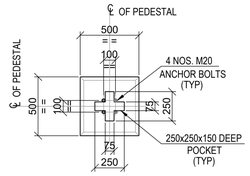


TOP PLAN OF
PEDESTAL MKD. P1
(SCALE 1:25)

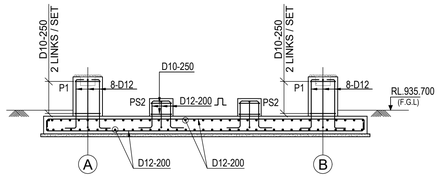


SECTION A - A
(RC DETAIL)
(SCALE 1:50)

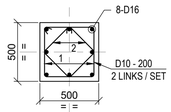


RC DETAIL OF PEDESTAL
MKD. P1
(SCALE 1:25)

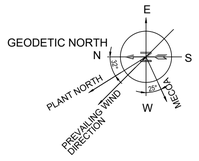

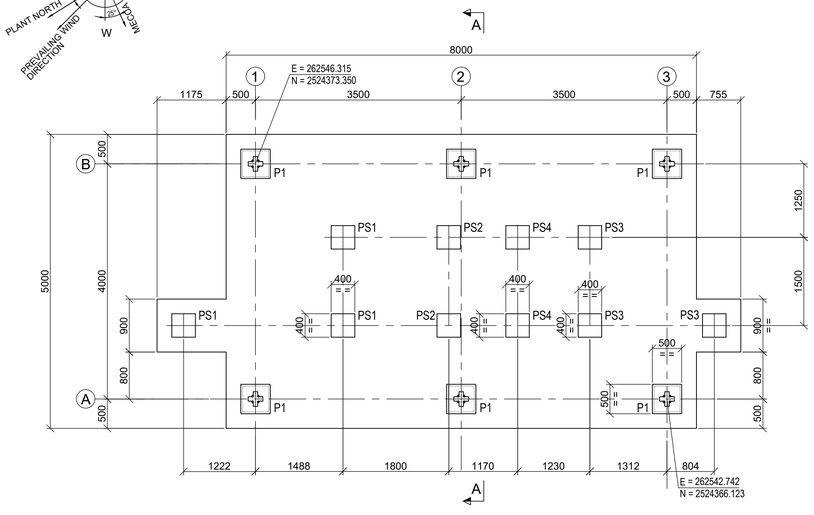

DETAIL OF FOUNDATION FOR SHED
(SCALE 1:50)

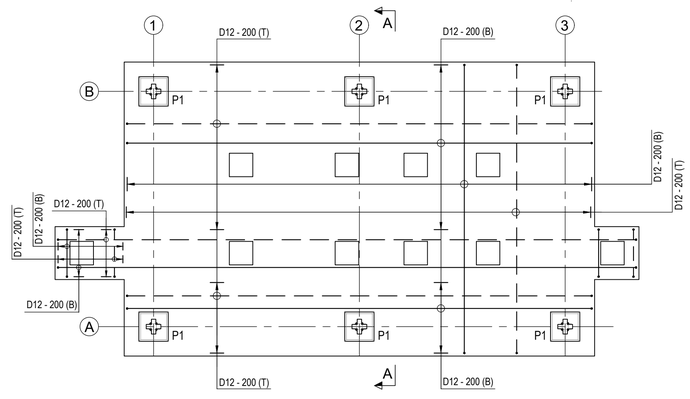

RC DETAIL OF FOUNDATION FOR SHED
(SCALE 1:50)

LEGEND :-

R.L. - REDUCED LEVEL
THK. - THICK
TYP. - TYPICAL
MKD. - MARKED
T.O.C - TOP OF CONCRETE
T.O.G - TOP OF GROUT
℄ - CENTRE LINE
P.C.C - PLAIN CEMENT CONCRETE
F.G.L. - FINISHED GROUND LEVEL.
GA - GENERAL ARRANGEMENT
B.O.F. - BOTTOM OF FOUNDATION
DIA - DIAMETER
FDN. - FOUNDATION
STR. - STRUCTURAL
RC. - REINFORCED CONCRETE
REF. - REFER
DRG. - DRAWING
BOTTOM REINF.(B) - ————
TOP REINF.(T) - – – – –

NOTES:-

1. ALL DIMENSIONS ARE IN MILLIMETRES AND LEVELS AND CO-ORDINATES ARE IN METRES UNLESS OTHERWISE STATED.
2. MINIMUM REINFORCED CONCRETE GRADE TO BE USED FOR SUPERSTRUCTURE & SUBSTRUCTURES IS M35(5000 PSI).
3. MINIMUM LEAN CONCRETE GRADE TO BE USED FOR THE SUB-STRUCTURES IS M15(2175 PSI).
4. ALL REINFORCING STEEL SHALL BE DEFORMED BILLET STEEL BARS CONFORMING TO ASTM-A615, WITH MINIMUM YIELD STRENGTH OF FY420 MPA .
5. THE NET SOIL BEARING CAPACITY CONSIDERED IN FOUNDATION DESIGN IS 350 KPA(REFER DOC 216-3000-EG-CV-CAL-1008-A02).
6. WATER PROOFING INSULATION SHALL BE AS PER PROJECT SPECS AND ITS MATERIAL TO BE APPROVED BY ENGINEER ON SITE.
7. FOR STANDARD REINFORCEMENT DETAIL & GENERAL NOTES FOR CIVIL WORKS REFER DRAWING NO. MD-216-1000-EG-CV-DED-1005 &1001.
8. STRUCTURAL FILL SHALL CONFORM TO PROVISIONS OF DOCUMENT MD-216-1000-EG-CV-MST-1698.

DOCUMENT NUMBER	REFERENCE DOCUMENTS			REVISION DESCRIPTION	DRN	CHK	ENG	APP	EMP
MD-216-39WL-EG-ST-GAD-1008	VALVE SHED PLAN, ELEVATION & SECTION								
MD-216-39WL-EG-CV-GAD-1639	RAW WATER PIPE LINE								
	EXCAVATION PLAN 1KM TO 2KM	D01	09/03/2023	AS-BUILT	PML	SJM	AVG	AG	
MD-216-39WL-EG-PL-LAD-1004	RAW WATER	C01	31/01/2022	ISSUED FOR CONSTRUCTION AND REVISED AS PER EMPLOYER	PML	SJM	AVG	AG	
	L-SECTION 1KM TO 2KM (TAPPING PT. TO MMGP)			COMMENTS ON 30/12/2021	PML	SJM	AVG	AG	
MD-216-1000-EG-ST-CRT-1001	CIVIL,STRUCTURAL AND ARCHITECTURAL DESIGN CRITERIA	A01	29/10/2021	ISSUED FOR APPROVAL	PML	SJM	AVG	AG	

RESERVED FOR VENDOR LOGO AND DRAWING NUMBER

LARSEN & TOUBRO

This drawing is the property of *LARSEN & TOUBRO* and must not be passed on to any person or body not authorized by us to receive it nor be copied or otherwise made use either in full or in part by such person or body without our prior permission in writing.

Outotec

The content of these documents are the sole property of Outotec Oyj. Any rights not expressly granted herein are reserved. Reproduction, transfer or distribution of part or all of the contents in any form without prior written permission of Outotec is prohibited.

MA'ADEN معادن
Saudi Arabian Mining Company شركة التعدين العربية السعودية

This document and the information contained herein is Ma'aden proprietary know-how. This document or any part thereof should not be reproduced, stored in a retrieval system or transmitted by any means, electronic or otherwise, or divulged without prior written permission of Ma'aden.

LARSEN & TOUBRO DRAWING NUMBER: O19045_080_C_G_24650_001 | REVISION: 2
OUTOTEC DRAWING NUMBER: 900707 _GAU01 _AG11 _MTL01 _39256 | DOCUMENT ID: OU100719478 | REVISION: 2

DRAWN	PML	25/10/2021
CHECKED	SJM	28/10/2021
ENGINEER	AVG	25/10/2021
APPROVED	AG	29/10/2021
EMPLOYER		
SCALE	1:50,15,10	A1

MANSOURAH - MASSARAH GOLD PROJECT
GENERAL ARRANGEMENT DRAWING
RAW WATER
DETAIL OF FOUNDATION FOR SHED

DRAWING NUMBER: MD - 216 - 39WL- EG - CV - GAD - 1721 | REV: D01