


DRAWING NUMBER MD - 216 - 3350 - EG - CV - DED - 1225 REV D01

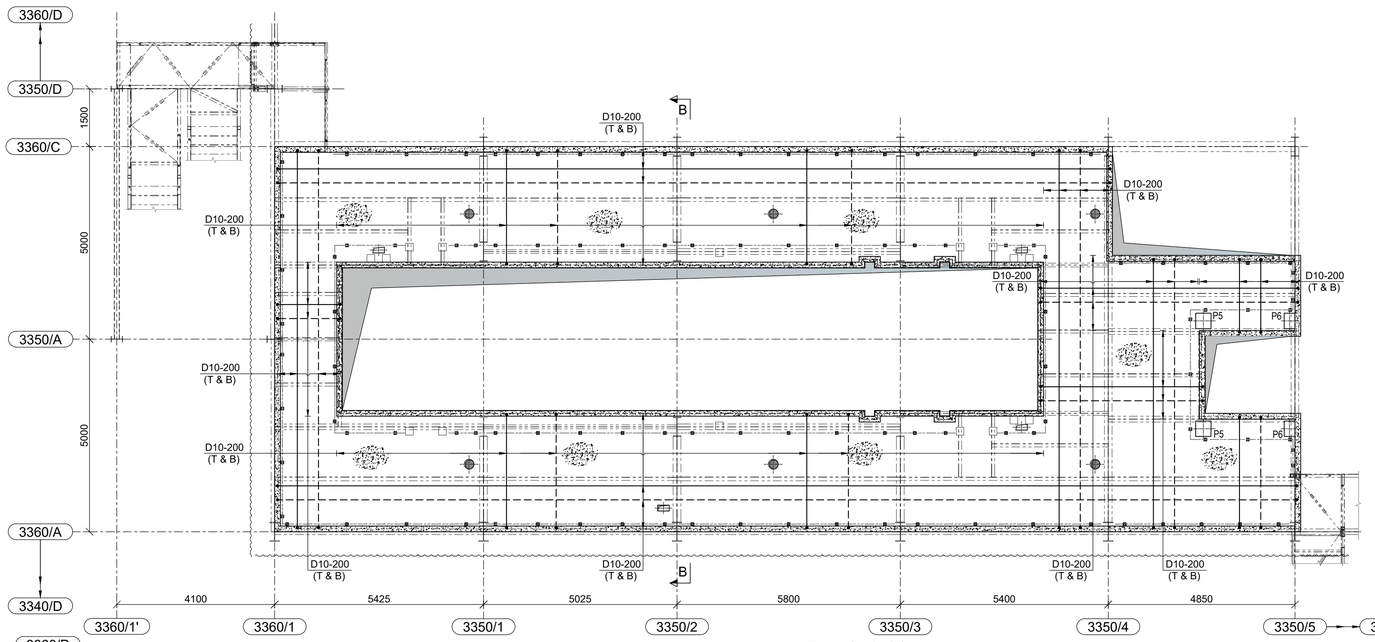


PLAN AT RL.+927.230(T.O.C.)
(CONCRETE FLOOR SLAB 150 THK. (APPROXIMATE))
(SCALE - 1 : 75)

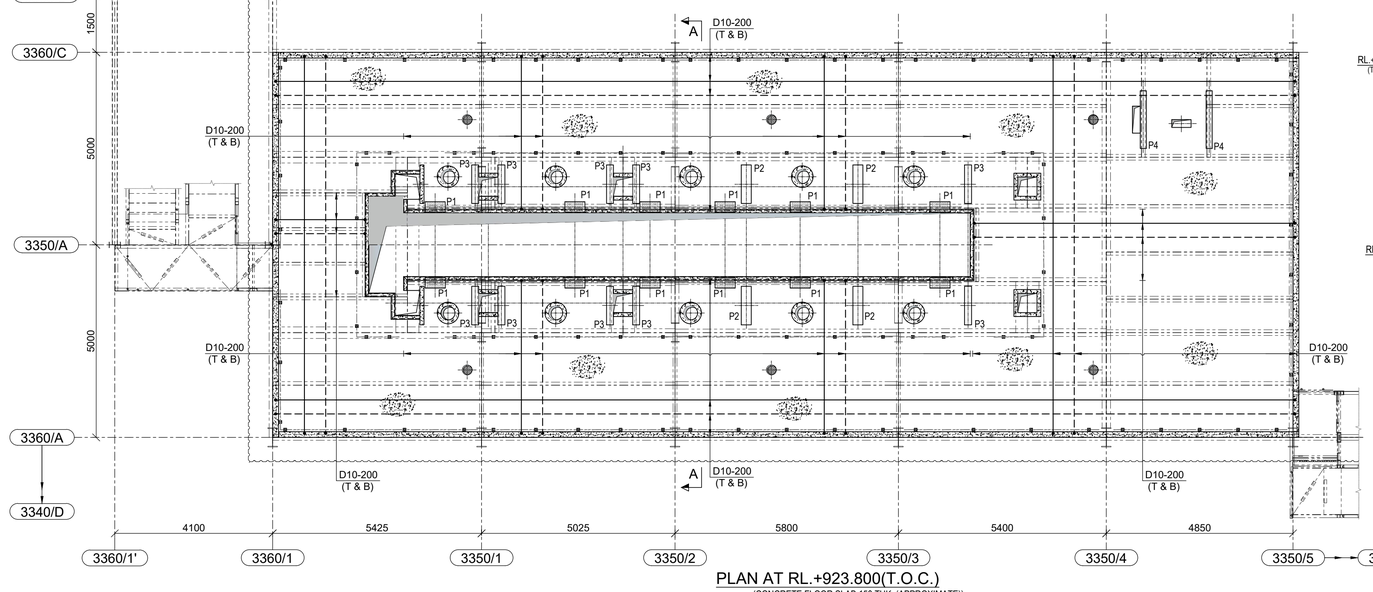


PLAN AT RL.+923.800(T.O.C.)
(CONCRETE FLOOR SLAB 150 THK. (APPROXIMATE))
(SCALE - 1 : 75)

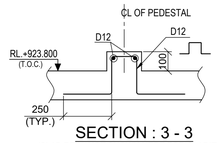


SECTION : 3 - 3
(SLAB REIN. NOT SHOWN HERE FOR CLARITY)
(SCALE - 1 : 15)

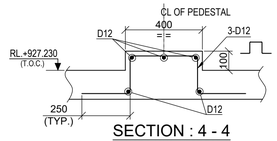


SECTION : 4 - 4
(SLAB REIN. NOT SHOWN HERE FOR CLARITY)
(SCALE - 1 : 15)

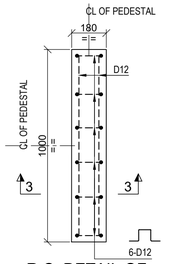


R.C. DETAIL OF PEDESTAL MKD. P3
(12 NOS. REQUIRED)
(SCALE - 1 : 15)

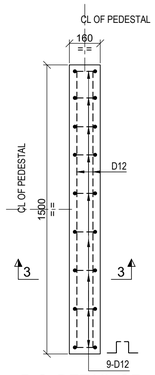


R.C. DETAIL OF PEDESTAL MKD. P4
(2 NOS. REQUIRED)
(SCALE - 1 : 20)

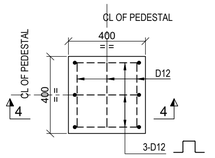


R.C. DETAIL OF PEDESTAL MKD. P5
(2 NOS. REQUIRED)
(SCALE - 1 : 20)

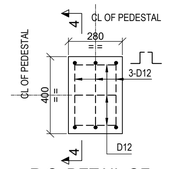


R.C. DETAIL OF PEDESTAL MKD. P6
(2 NOS. REQUIRED)
(SCALE - 1 : 20)

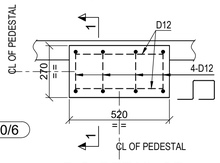


R.C. DETAIL OF PEDESTAL MKD. P1
(12 NOS. REQUIRED)
(SCALE - 1 : 15)

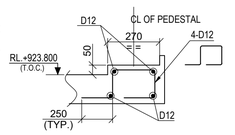


SECTION : 1 - 1
(SLAB REIN. NOT SHOWN HERE FOR CLARITY)
(SCALE - 1 : 15)

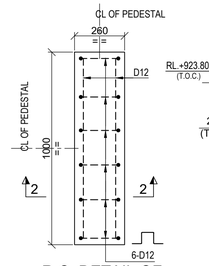


R.C. DETAIL OF PEDESTAL MKD. P2
(4 NOS. REQUIRED)
(SCALE - 1 : 15)

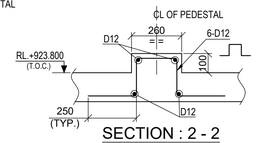



SECTION : 2 - 2
(SLAB REIN. NOT SHOWN HERE FOR CLARITY)
(SCALE - 1 : 15)

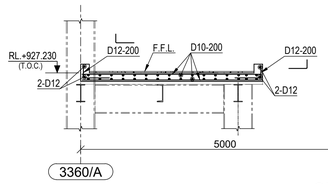

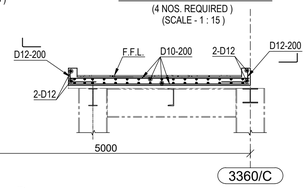

SECTION : B - B
(SCALE - 1 : 50)

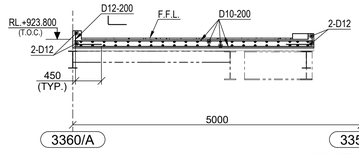

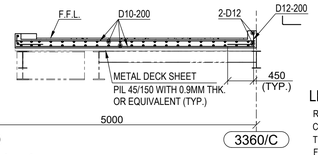

SECTION : A - A
(SCALE - 1 : 50)

LEGEND :-
RL. - REDUCED LEVEL.
CL - CENTRE LINE.
T.O.C. - TOP OF CONCRETE.
F.F.L. - FINISHED FLOOR LEVEL.
TYP. - TYPICAL.
R.C. - REINFORCED CONCRETE..
DET. - DETAIL.
MKD. - MARKED.
THK. - THICKNESS.
T - TOP.
B - BOTTOM.
- - - - - - TOP REINFORCEMENT.
——— BOTTOM REINFORCEMENT.

NOTES :-
1. ALL DIMENSIONS ARE IN MILLIMETRES AND LEVELS AND CO-ORDINATES ARE IN METRES. UNLESS OTHERWISE STATED.
2. THIS DRAWING SHALL BE READ IN CONJUNCTION WITH DRG. NO. MD-216-3350-EG-CV-GAD-1223.
3. ALL OTHER NOTES REFER DRAWING NO. MD-101-SMEM-EG-ST-DST-0001 TO 0008.

DOCUMENT NUMBER	REFERENCE DOCUMENTS	REV	DATE	REVISION DESCRIPTION	DRN	CHK	ENG	APP	EMP
MD-216-1000-EG-CV-DED-1003	ANCHOR BOLTS STANDARD DETAILS								
MD-216-3000-EG-CV-RPT-1008	GEOTECHNICAL REPORT								
MD-216-3350-EG-ME-GAD-1040	G.A. DRG. CON. FILTRATION SECTION D-D								
MD-216-3350-EG-ME-GAD-1039	G.A. DRG. CON. FILTRATION SECTION C-C								
MD-216-3350-EG-ME-GAD-1038	G.A. DRG. CON. FILTRATION SECTION A-A & B-B	D01	10/03/2023	AS-BUILT	PDK	SGC	SHD	PRI	
MD-216-3350-EG-ME-GAD-1037	G.A. DRG CON. FILTRATION PLAN AT EL.+927.300	C03	11/05/2021	ISSUED FOR CONSTRUCTION & REVISED AS MKD C03	PDK	SGC	SHD	PRI	
MD-216-3350-EG-ME-GAD-1036	G.A. DRG CON. FILTRATION PLAN AT EL.+923.900	C02	27/11/2020	ISSUED FOR CONSTRUCTION & REVISED AS MKD C02	PDK	SGC	SHD	PRI	
MD-216-3350-EG-ME-GAD-1035	G.A. DRG CON. FILTRATION PLAN AT EL.+919.350	C01	23/04/2020	ISSUED FOR CONSTRUCTION & REVISED AS PER	PDK	SGC	SHD	PRI	
MD-216-3350-EG-ME-GAD-1034	G.A. DRG CON. FILTRATION PLAN AT EL.+913.500			EMPLOYER COMMENTS ON DTD. 17/04/20 &					
MD-216-3350-EG-ST-GAD-2195	CONCENTRATE FILTRATION PLAN, ELEVATION & DETAILS			REVISED AS MKD C01					
MD-216-3350-EG-ST-GAD-2194	DETAILS OF PURLIN & SIDE RUNNER	A01	19/03/2020	ISSUED FOR REFERENCE	PDK	SGC	SHD	PRI	

RESERVED FOR VENDOR LOGO AND DRAWING NUMBER

LARSEN & TOUBRO

This drawing is the property of LARSEN & TOUBRO and must not be passed on to any person or body not authorized by us to receive it nor be copied or otherwise made use either in full or in part by such person or body without our prior permission in writing.

Outotec

The content of these documents are the sole property of Outotec Oyj. Any rights not expressly granted herein are reserved. Reproduction, transfer or distribution of part or all of the contents in any form without prior written permission of Outotec is prohibited.

MA'ADEN معادن
Saudi Arabian Mining Company شركة التعدين العربية السعودية

This document and the information contained herein is Ma'aden proprietary know-how. This document or any part thereof should not be reproduced, stored in a retrieval system or transmitted by any means, electronic or otherwise, or divulged without prior written permission of Ma'aden.

LARSEN & TOUBRO DRAWING NUMBER: 019045_450_C_D_24096_002 — REVISION: 4
OUTOTEC DRAWING NUMBER: 900707__GAU01__SF01__CTB13__33501 — DOCUMENT ID: OU100666582 — REVISION: 4

DRAWN	PDK	11/03/2020
CHECKED	SGC	18/03/2020
ENGINEER	SHD	03/03/2020
APPROVED	PRI	19/03/2020
EMPLOYER		
SCALE 1:100 1:50		A1

MANSOURAH - MASSARAH GOLD PROJECT
DETAIL DRAWING
CONCENTRATE FILTRATION
R.C. DET. OF FLOOR AT RL.923.800 & RL.927.230

DRAWING NUMBER: MD - 216 - 3350 - EG - CV - DED - 1225 — REV: D01