


DRAWING NUMBER: MD-216-3350-EG-CV-GAD-1222 REV D01

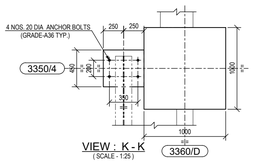


VIEW : K - K
(SCALE - 1:25)

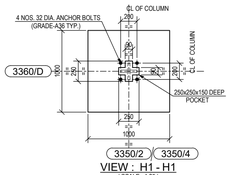


VIEW : H1 - H1
(SCALE - 1:25)

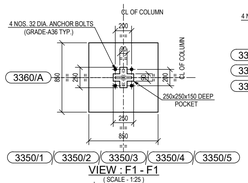


VIEW : F1 - F1
(SCALE - 1:25)

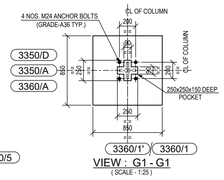


VIEW : G1 - G1
(SCALE - 1:25)

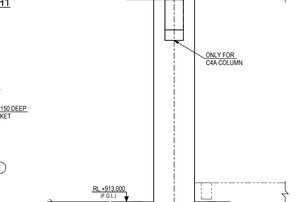


SECTION : H - H
(SCALE - 1:50)

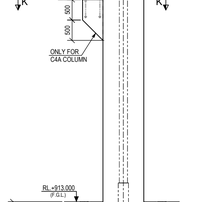


SECTION : J - J
(SCALE - 1:50)

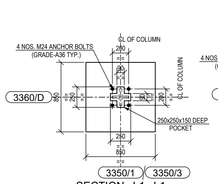


SECTION : L1 - L1
(SCALE - 1:25)

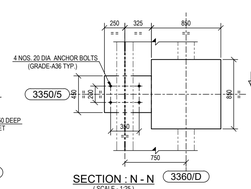


SECTION : N - N
(SCALE - 1:25)

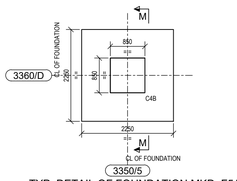


TYP. DETAIL OF FOUNDATION MKD. F5A
(1 NO. REQUIRED)
(SCALE - 1:50)

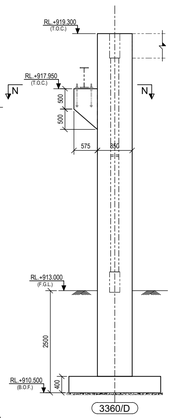


SECTION : M - M
(SCALE - 1:50)

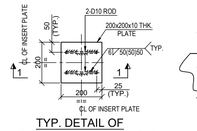


TYP. DETAIL OF INSERT PLATE MKD. IP-1
(4 NOS. REQUIRED)
(SCALE- 1:10)

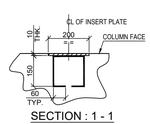


SECTION : 1 - 1
(SCALE- 1:10)

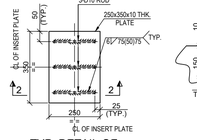


TYP. DETAIL OF INSERT PLATE MKD. IP-2
(1 NO. REQUIRED)
(SCALE- 1:10)

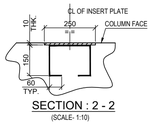


SECTION : 2 - 2
(SCALE- 1:10)

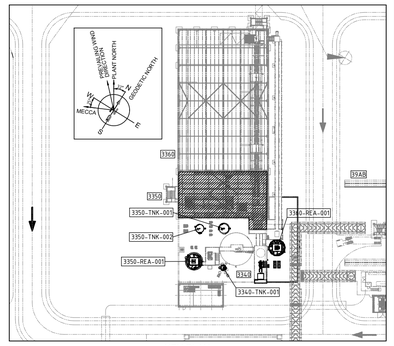

KEY PLAN
(SCALE- 1:500)

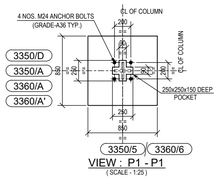


VIEW : P1 - P1
(SCALE - 1:25)

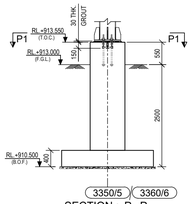


TYP. DETAIL OF BOLT


SCHEDULE OF BOLTS (ASTM 1554)						
D BOLT DIA. MM	BxB BOTTOM PLATE (SQUARE) SQ MM	DIMENSIONS (MM)				
		L	A	C	T	H
20	60x60	450	150	100	10	30
25/M24	75x75	600	175	125	12	30
32	100x100	800	200	150	16	35

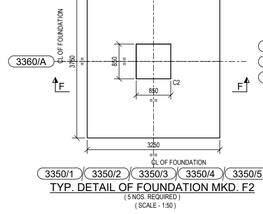


TYP. DETAIL OF FOUNDATION MKD. F2
(5 NOS. REQUIRED)
(SCALE - 1:50)

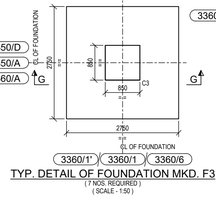


TYP. DETAIL OF FOUNDATION MKD. F3
(7 NOS. REQUIRED)
(SCALE - 1:50)

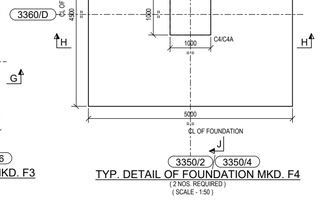


TYP. DETAIL OF FOUNDATION MKD. F4
(2 NOS. REQUIRED)
(SCALE - 1:50)

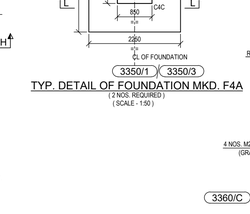


TYP. DETAIL OF FOUNDATION MKD. F4A
(2 NOS. REQUIRED)
(SCALE - 1:50)

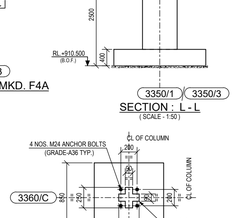


SECTION : L - L
(SCALE - 1:50)

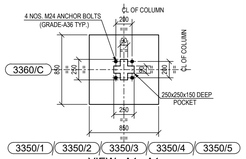


VIEW : A1 - A1
(SCALE - 1:25)

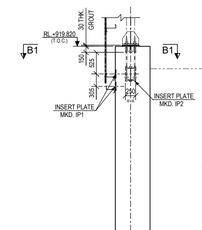


VIEW : B1 - B1
(SCALE - 1:25)

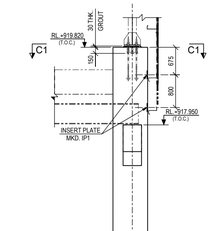


VIEW : C1 - C1
(SCALE - 1:25)

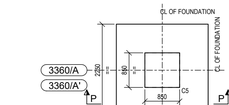


TYP. DETAIL OF FOUNDATION MKD. F5
(3 NOS. REQUIRED)
(SCALE - 1:50)

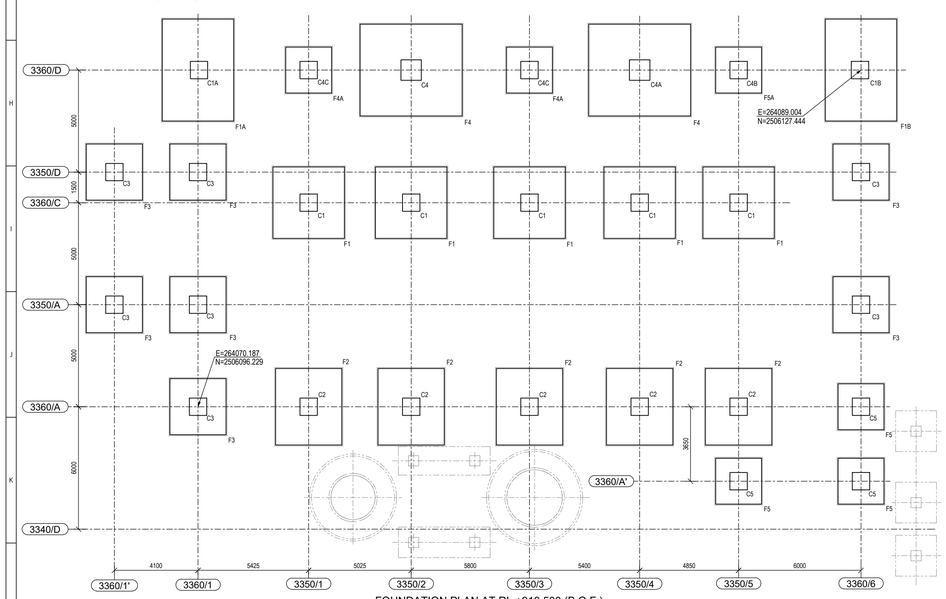


FOUNDATION PLAN AT RL +910.500 (B.O.F.)
(SCALE - 1:100)

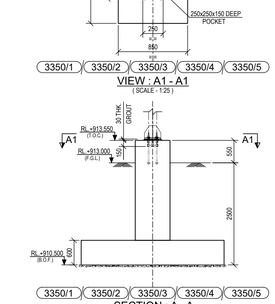


TYP. DETAIL OF FOUNDATION MKD. F1
(5 NOS. REQUIRED)
(SCALE - 1:50)

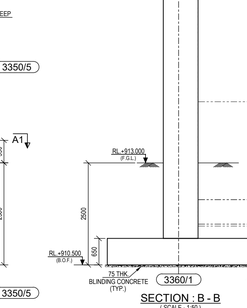


TYP. DETAIL OF FOUNDATION MKD. F1A
(1 NO. REQUIRED)
(SCALE - 1:50)

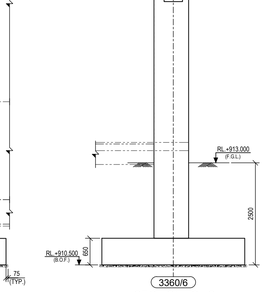

TYP. DETAIL OF FOUNDATION MKD. F1B
(1 NO. REQUIRED)
(SCALE - 1:50)

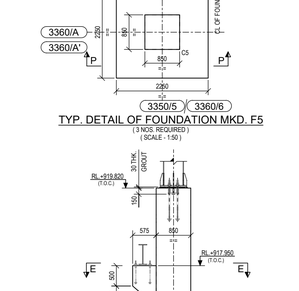

SECTION : D - D
(SCALE - 1:50)

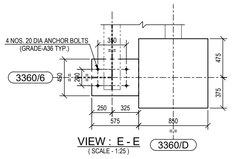

VIEW : E - E
(SCALE - 1:25)

LEGEND :-

RL - REDUCED LEVEL
T.O.C. - TOP OF CONCRETE.
F.G.L. - FINISHED GROUND LEVEL
B.O.F. - BOTTOM OF FOOTING.
CL - CENTRE LINE.
TYP. - TYPICAL.
THK. - THICK.
MKD. - MARKED.

NOTES :-

1. ALL DIMENSIONS ARE IN MILLIMETERS AND LEVELS AND CO-ORDINATES ARE IN METERS. UNLESS OTHERWISE STATED.
2. GRADE OF CONCRETE SHALL BE 35 MPa FOR FOUNDATION & 15 MPa FOR BLINDING CONCRETE.
3. GRADE OF REINFORCEMENT SHALL BE DEFORMED BAR 420 MPa (GRADE 60) - ASTM A615/A615M.
4. NET SAFE BEARING CAPACITY OF SOIL AT BOTTOM OF FOUNDATION CONSIDER 450KN/ SQ. M.
5. CLEAR COVER TO MAIN REINFORCEMENT SHALL BE 75 mm FOR RAFT & 50 mm FOR COLUMN.
6. IF ANY PART OF FOUNDATION COMES ON BACKFILL ZONE OF ADJACENT FOUNDATION OR ANY LOOSE SOIL ARE ENCOUNTERED BELOW FOUNDATION LEVEL THE SAME SHALL BE REMOVED AND FILLED WITH PCC.
7. THIS DRAWING SHALL BE READ IN CONJUNCTION WITH DRAWING NO. MD-216-3340-EG-CV-GAD-1214 & 1215 AND MD-216-3360-EG-CV-GAD-1229, 1230 & 1231.
8. FOR R.C. DETAIL REFER DRAWING NO. MD-216-3350-EG-CV-DED-1224.
9. ALL OTHER NOTES REFER DRAWING NO. MD-101-SMEM-EG-ST-DST-0001 TO 0008.

DOCUMENT NUMBER	REFERENCE DOCUMENTS
MD-216-1000-EG-CV-DED-1003	ANCHOR BOLTS STANDARD DETAILS
MD-216-3000-EG-CV-RPT-1008	GEOTECHNICAL REPORT
MD-216-3350-EG-ME-GAD-1040	G.A. DRG. CONCENTRATE FILTRATION SECTION D-D
MD-216-3350-EG-ME-GAD-1039	G.A. DRG. CONCENTRATE FILTRATION SECTION C-C
MD-216-3350-EG-ME-GAD-1038	G.A. DRG. CONCENTRATE FILTRATION SECTION A-A & B-B
MD-216-3350-EG-ME-GAD-1037	G.A. DRG CONCENTRATE FILTRATION PLAN AT EL.+927.330
MD-216-3350-EG-ME-GAD-1036	G.A. DRG CONCENTRATE FILTRATION PLAN AT EL.+923.900
MD-216-3350-EG-ME-GAD-1035	G.A. DRG CONCENTRATE FILTRATION PLAN AT EL.+919.350
MD-216-3350-EG-ME-GAD-1034	G.A. DRG CONCENTRATE FILTRATION PLAN AT EL.+913.500
MD-216-3350-EG-ST-GAD-2195	CONCENTRATE FILTRATION PLAN, ELEVATION & DETAILS
MD-216-3350-EG-ST-GAD-2194	DETAILS OF PURLIN & SIDE RUNNER

REV	DATE	REVISION DESCRIPTION	DRN	CHK	ENG	APP	EMP
D01	19/04/2023	AS-BUILT	PDK	SGC	SHD	PRI	
C03	30/10/2020	ISSUED FOR CONSTRUCTION & REVISED AS MKD. C03	PDK	SGC	SHD	PRI	
C02	11/08/2020	ISSUED FOR CONSTRUCTION & REVISED AS MKD. C02	PDK	SGC	SHD	PRI	
C01	27/04/2020	ISSUED FOR CONSTRUCTION	PDK	SGC	SHD	PRI	
A02	01/04/2020	REVISED AS PER EMPLOYER COMMENTS	PDK	SGC	SHD	PRI	
		ON DATED 27/03/2020 & REVISE AS MKD. A02					
A01	10/03/2020	ISSUED FOR REFERENCE	PDK	SGC	SHD	PRI	

DOCUMENT NUMBER	REFERENCE DOCUMENTS
MD-216-3340-EG-ST-CRT-1001	CIVIL, STRUCTURAL AND ARCHITECTURAL DESIGN CRITERIA

RESERVED FOR VENDOR LOGO AND DRAWING NUMBER

LARSEN & TOUBRO

This drawing is the property of LARSEN & TOUBRO and must not be passed on to any person or body not authorized by us to receive it nor be copied or otherwise made use either in full or in part by such person or body without our prior permission in writing.

Outotec

The content of these documents are the sole property of Outotec Oyj. Any rights not expressly granted herein are reserved. Reproduction, transfer or distribution of part or all of the contents in any form without prior written permission of Outotec is prohibited.

MA'ADEN معادن Saudi Arabian Mining Company

This document and the information contained herein is Ma'aden proprietary know-how. This document or any part thereof should not be reproduced, stored in a retrieval system or transmitted by any means, electronic or otherwise, or divulged without prior written permission of Ma'aden.

LARSEN & TOUBRO DRAWING NUMBER	REVISION
019045_450_C_G_24095_002	5
OUTOTEC DRAWING NUMBER	DOCUMENT ID / REVISION
900707__GAU01__SF01__MTL01__33528	OU100666567 / 5

DRAWN	PDK	03/03/2020
CHECKED	SGC	07/03/2020
ENGINEER	SHD	28/03/2020
APPROVED	PRI	10/03/2020
EMPLOYER		
SCALE	1:100	A0

MANSOURAH - MASSARAH GOLD PROJECT
GENERAL ARRANGEMENT DRAWING
CONCENTRATE FILTRATION
G.A. & DETAILS OF FILTRATION BUILDING FDN.

DRAWING NUMBER: MD - 216 - 3350 - EG - CV - GAD - 1222 REV: D01