


DRAWING NUMBER MD-216-3350-EG-CV-GAD-1223 REV D01

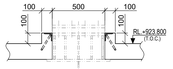


SECTION : 1 - 1
(SCALE - 1 : 20)

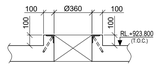


SECTION : 2 - 2
(SCALE - 1 : 20)

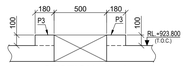


SECTION : 3 - 3
(SCALE - 1 : 20)

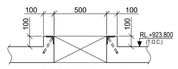


SECTION : 4 - 4
(SCALE - 1 : 20)

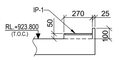


SECTION : 5 - 5
(SCALE - 1 : 20)

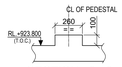


SECTION : 6 - 6
(SCALE - 1 : 20)

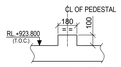


SECTION : 7 - 7
(SCALE - 1 : 20)

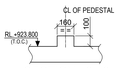


SECTION : 8 - 8
(SCALE - 1 : 20)

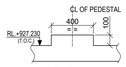


SECTION : 9 - 9
(SCALE - 1 : 20)

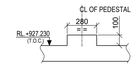


SECTION : 10 - 10
(SCALE - 1 : 20)

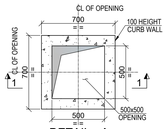


DETAIL - A
(SCALE - 1 : 20)

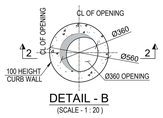


DETAIL - B
(SCALE - 1 : 20)

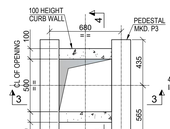


DETAIL - C
(SCALE - 1 : 20)

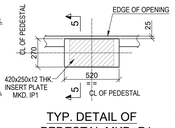


TYP. DETAIL OF PEDESTAL MKD. P1
(12 NOS. REQUIRED)
(SCALE - 1 : 20)

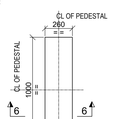


TYP. DETAIL OF PEDESTAL MKD. P2
(4 NOS. REQUIRED)
(SCALE - 1 : 20)

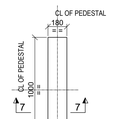


TYP. DETAIL OF PEDESTAL MKD. P3
(12 NOS. REQUIRED)
(SCALE - 1 : 20)

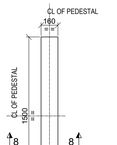


TYP. DETAIL OF PEDESTAL MKD. P4
(2 NOS. REQUIRED)
(SCALE - 1 : 20)

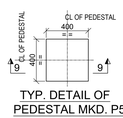


TYP. DETAIL OF PEDESTAL MKD. P5
(2 NOS. REQUIRED)
(SCALE - 1 : 20)

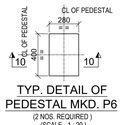


TYP. DETAIL OF PEDESTAL MKD. P6
(2 NOS. REQUIRED)
(SCALE - 1 : 20)

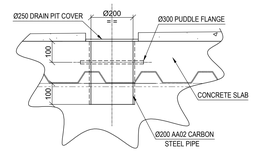


SECTION : D1 - D1
(SCALE - 1 : 10)

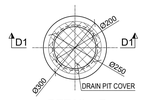


DETAIL - D
(12 NOS. REQUIRED)
(SCALE - 1 : 10)

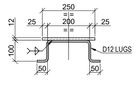


SECTION S1 - S1
(SCALE 1:10)

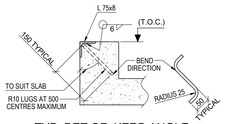


TYP. DET.OF KERB ANGLE
(FOR CUTOUT LOCATION)
(SCALE- 1:10)

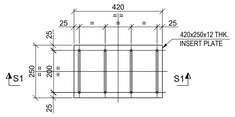


DETAIL OF INSERT PLATE - IP1
(SCALE 1:10)

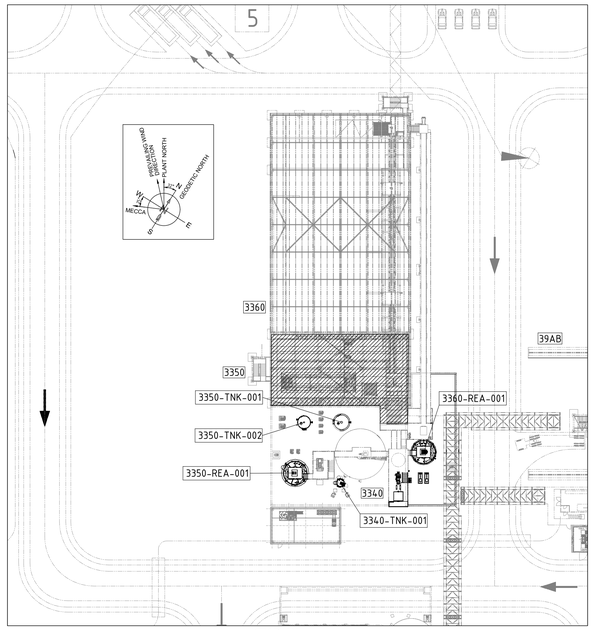


KEY PLAN
(SCALE- 1:500)

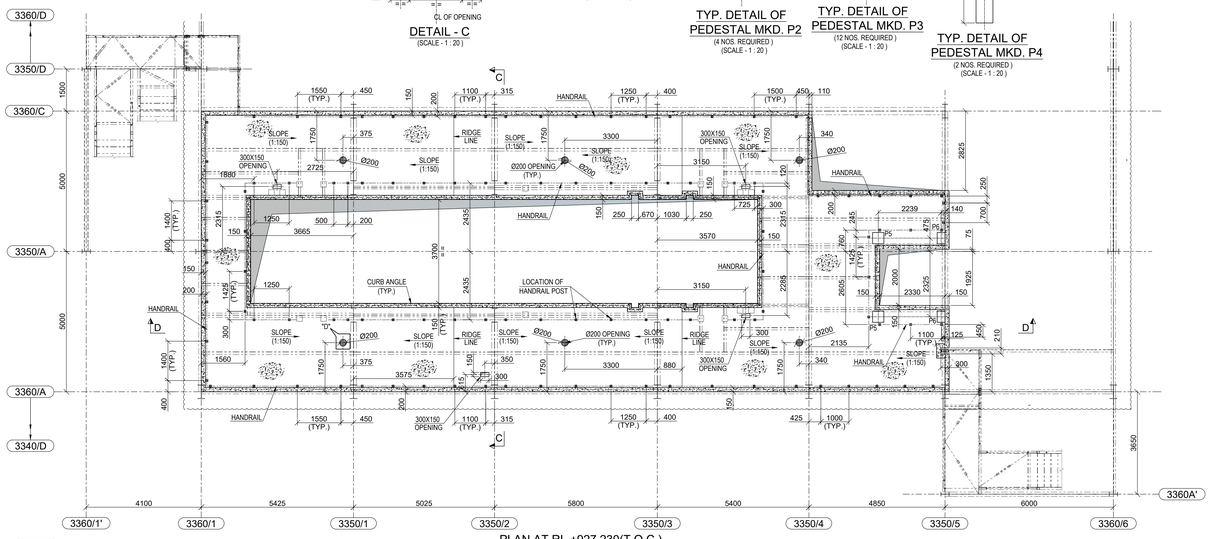


PLAN AT RL.+927.230(T.O.C.)
(CONCRETE FLOOR SLAB 150 THK. (APPROXIMATE))
(SCALE - 1 : 75)

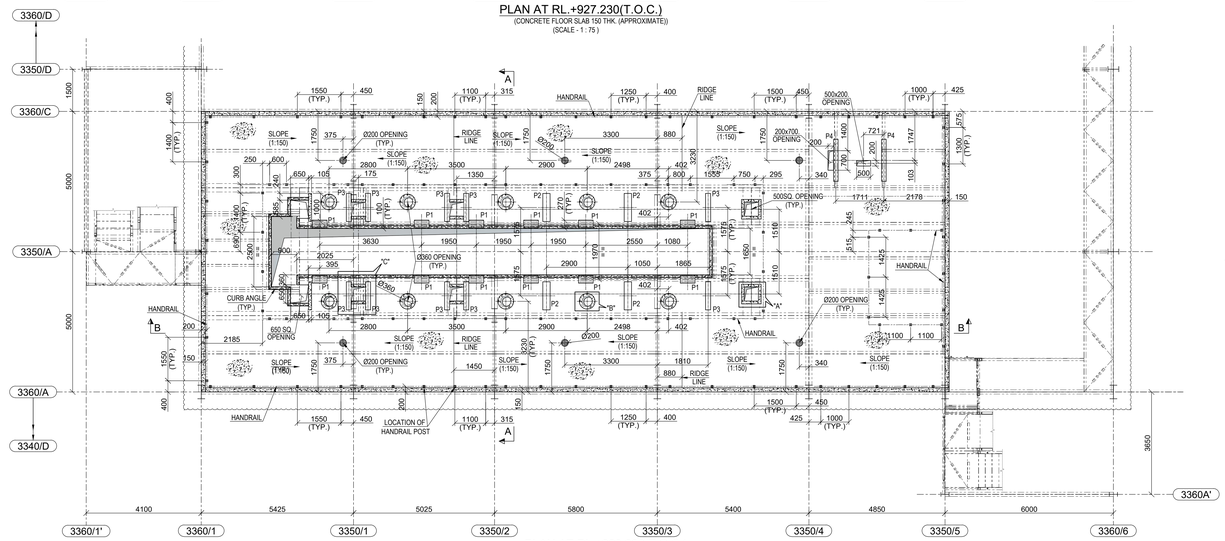


PLAN AT RL.+923.800(T.O.C.)
(CONCRETE FLOOR SLAB 150 THK. (APPROXIMATE))
(SCALE - 1 : 75)

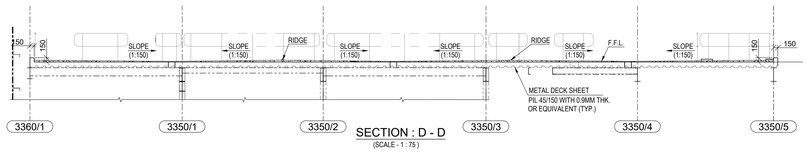


SECTION : D - D
(SCALE - 1 : 75)

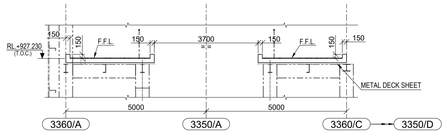

SECTION : C - C
(SCALE - 1 : 75)

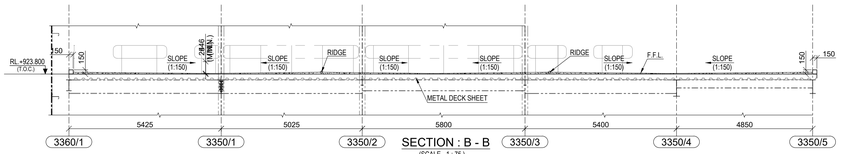

SECTION : B - B
(SCALE - 1 : 75)

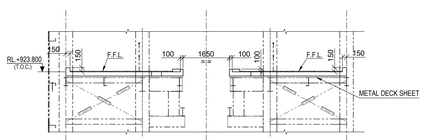

SECTION : A - A
(SCALE - 1 : 75)

LEGEND :-

RL. - REDUCED LEVEL.
T.O.C. - TOP OF CONCRETE.
F.F.L. - FINISHED FLOOR LEVEL.
℄ - CENTRE LINE.
TYP. - TYPICAL.
THK. - THICK.
MKD. - MARKED.
Ø - DIAMETER.
G.A. - GENERAL ARRANGEMENT.
R.C. - REINFORCED CONCRETE..
DET. - DETAIL.

NOTES :-

1. ALL DIMENSIONS ARE IN MILLIMETRES AND LEVELS AND CO-ORDINATES ARE IN METRES. UNLESS OTHERWISE STATED.
2. GRADE OF CONCRETE SHALL BE 35 MPa FOR FOUNDATION & 15 MPa FOR BLINDING CONCRETE.
3. GRADE OF REINFORCEMENT SHALL BE DEFORMED BAR 420 MPa (GRADE 60) - ASTM A615/A615M.
4. NET SAFE BEARING CAPACITY OF SOIL AT BOTTOM OF FOUNDATION CONSIDER 450KN/ SQ. M.
5. CLEAR COVER TO MAIN REINFORCEMENT SHALL BE 75 mm FOR RAFT & 50 mm FOR COLUMN.
6. IF ANY PART OF FOUNDATION COMES ON BACKFILL ZONE OF ADJACENT FOUNDATION OR ANY LOOSE SOIL ARE ENCOUNTERED BELOW FOUNDATION LEVEL THE SAME SHALL BE REMOVED AND FILLED WITH PCC.
7. THIS DRAWING SHALL BE READ IN CONJUNCTION WITH DRAWING NO. MD-216-3340-EG-CV-GAD-1214 & 1215 AND MD-216-3360-EG-CV-GAD-1229, 1230 & 1231.
8. FOR R.C. DETAIL REFER DRAWING NO. MD-216-3350-EG-CV-DED-1024.
9. ALL OTHER NOTES REFER DRAWING NO. MD-101-SMEM-EG-ST-DST-0001 TO 0008.

DOCUMENT NUMBER	REFERENCE DOCUMENTS
MD-216-1000-EG-CV-DED-1003	ANCHOR BOLTS STANDARD DETAILS
MD-216-3000-EG-CV-RPT-1008	GEOTECHNICAL REPORT
MD-216-3350-EG-ME-GAD-1040	G.A. DRG. CONCENTRATE FILTRATION SECTION D-D
MD-216-3350-EG-ME-GAD-1039	G.A. DRG. CONCENTRATE FILTRATION SECTION C-C
MD-216-3350-EG-ME-GAD-1038	G.A. DRG. CONCENTRATE FILTRATION SECTION A-A & B-B
MD-216-3350-EG-ME-GAD-1037	G.A. DRG CONCENTRATE FILTRATION PLAN AT EL.+927.330
MD-216-3350-EG-ME-GAD-1036	G.A. DRG CONCENTRATE FILTRATION PLAN AT EL.+923.900
MD-216-3350-EG-ME-GAD-1035	G.A. DRG CONCENTRATE FILTRATION PLAN AT EL.+919.350
MD-216-3350-EG-ME-GAD-1034	G.A. DRG CONCENTRATE FILTRATION PLAN AT EL.+913.500
MD-216-3350-EG-ST-GAD-2195	CONCENTRATE FILTRATION PLAN, ELEVATION & DETAILS
MD-216-3350-EG-ST-GAD-2194	DETAILS OF PURLIN & SIDE RUNNER

REFERENCE DOCUMENTS	REV	DATE	REVISION DESCRIPTION	DRN	CHK	ENG	APP	EMP
	D01	10/03/2023	AS-BUILT	AMJ	SGC	SHD	PRI	
	C03	11/05/2021	ISSUED FOR CONSTRUCTION & REVISED AS MKD. C02	AMJ	SGC	SHD	PRI	
	C02	27/11/2020	ISSUED FOR CONSTRUCTION & REVISED AS MKD. C01	PDK	SGC	SHD	PRI	
	C01	23/04/2020	ISSUED FOR CONSTRUCTION &REVISED AS PER EMPLOYER	PDK	SGC	SHD	PRI	
			COMMENTS ON DTD. 17/04/20 & REVISED AS MKD. C01					
	A01	19/03/2020	ISSUED FOR REFERENCE	PDK	SGC	SHD	PRI	

RESERVED FOR VENDOR LOGO AND DRAWING NUMBER

LARSEN & TOUBRO

This drawing is the property of LARSEN & TOUBRO and must not be passed on to any person or body not authorized by us to receive it nor be copied or otherwise made use either in full or in part by such person or body without our prior permission in writing.

Outotec

The content of these documents are the sole property of Outotec Oyj. Any rights not expressly granted herein are reserved. Reproduction, transfer or distribution of part or all of the contents in any form without prior written permission of Outotec is prohibited.

MA'ADEN معادن
Saudi Arabian Mining Company شركة معادن العربية السعودية

This document and the information contained herein is Ma'aden proprietary know-how. This document or any part thereof should not be reproduced, stored in a retrieval system or transmitted by any means, electronic or otherwise, or divulged without prior written permission of Ma'aden.

LARSEN & TOUBRO DRAWING NUMBER: 019045_450_C_G_24095_003 — REVISION: 4
OUTOTEC DRAWING NUMBER: 900707__GAU01__SF01__MTL01__33529 — DOCUMENT ID: OU100666568 — REVISION: 4

DRAWN	PDK	10/03/2020
CHECKED	SGC	18/03/2020
ENGINEER	SHD	03/03/2020
APPROVED	PRI	19/03/2020
EMPLOYER		
SCALE	1:100	A0

MANSOURAH - MASSARAH GOLD PROJECT
GENERAL ARRANGEMENT DRAWING
CONCENTRATE FILTRATION
G.A. & DET. OF FLOOR AT RL.923.800 & RL.927.230

DRAWING NUMBER: MD - 216 - 3350 - EG - CV - GAD - 1223 — REV: D01