


DRAWING NUMBER MD-216-3710-EG-CV-DED-1384 REV D01

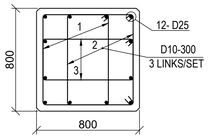


C1 REINF. PLAN
SCALE 1:25

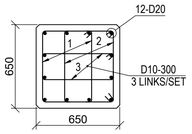


C2 REINF. PLAN
SCALE 1:25

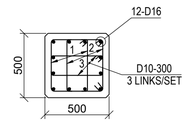


C3 REINF. PLAN
SCALE 1:25

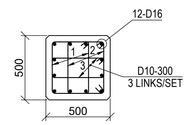


C4 REINF. PLAN
SCALE 1:25

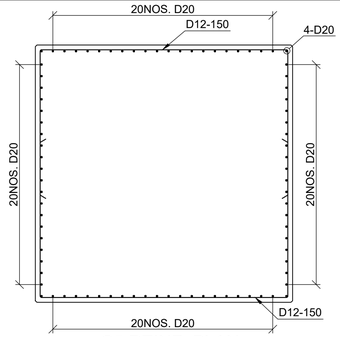


C5 REINF. PLAN
SCALE 1:50

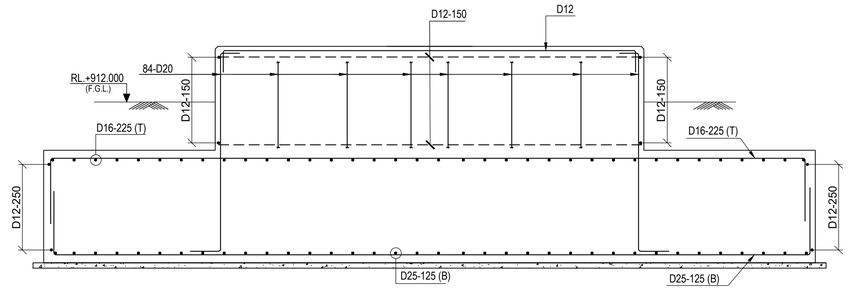


SECTION B-B
SCALE 1:30

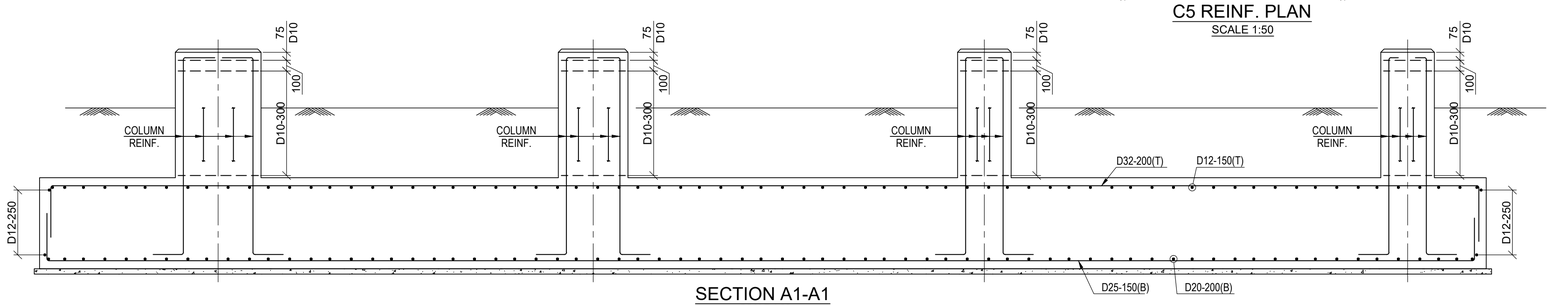


SECTION A1-A1
SCALE 1:30

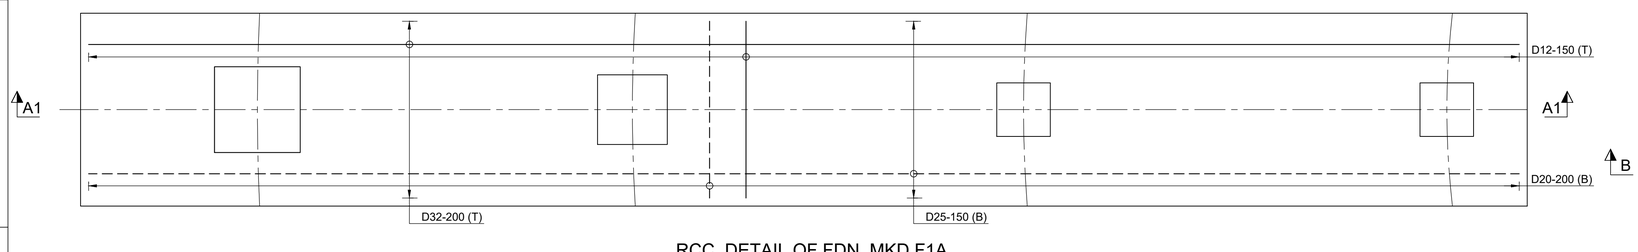


RCC. DETAIL OF FDN. MKD F1A
SCALE 1:30

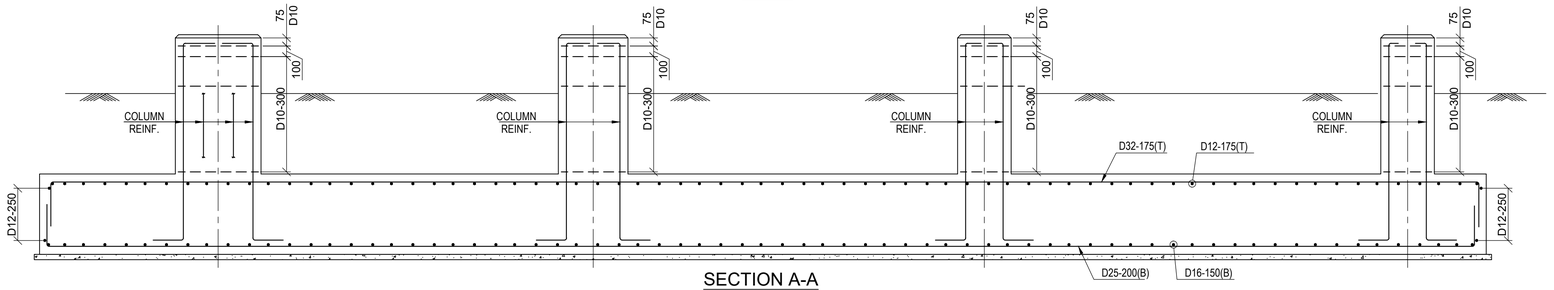

SECTION A-A
SCALE 1:30

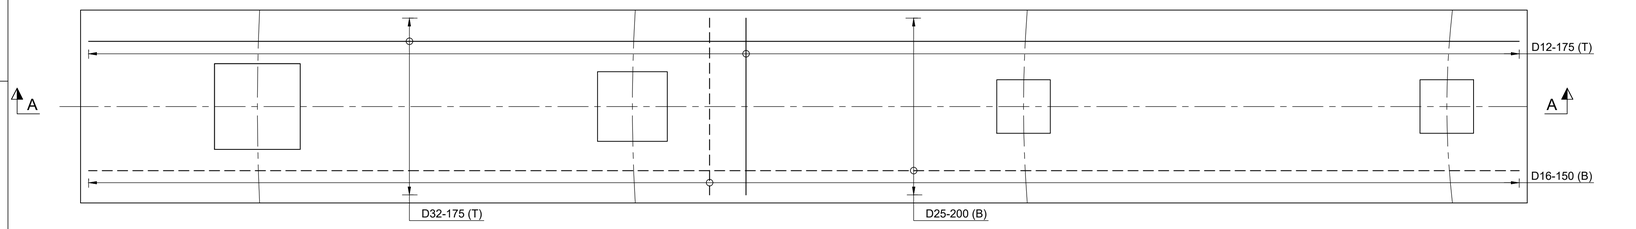

RCC. DETAIL OF FDN. MKD F1
SCALE 1:30

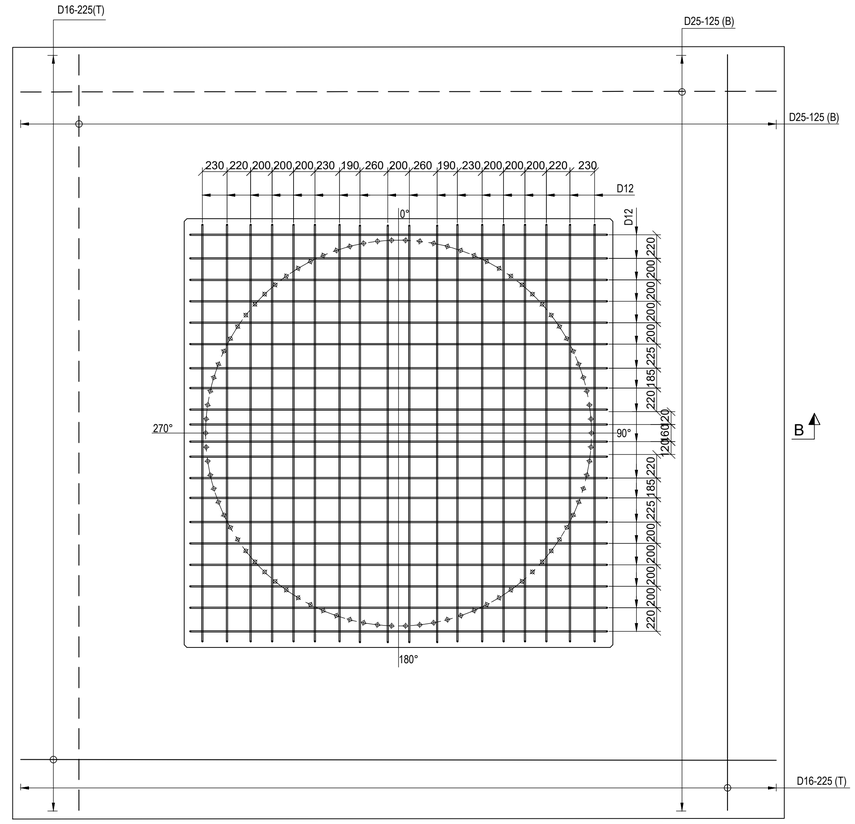

REINF. PLAN MKD. F2
SCALE 1:30

LEGEND :-
R.L. - REDUCED LEVEL
T.O.C. - TOP OF CONCRETE.
F.G.L. - FINISHED GROUND LEVEL.
B.O.F. - BOTTOM OF FOUNDATION
TYP. - TYPICAL.
P.C.D. - PITCH CIRCLE DIAMETER.
R.C.C - REINFORCED CEMENT CONCRETE
P.C.C - PLAIN CEMENT CONCRETE
BOTTOM REINF.(B) - - - - - - -
TOP REINF.(T) - ————————
MKD. - MARKED.
THK. - THICK
FDN. - FOUNDATION

NOTES:-
1. GRADE OF CONCRETE SHALL BE 35 MPa FOR RCC, 15 MPa FOR BLINDING CONCRETE.
2. GRADE OF REINFORCEMENT SHALL BE DEFORMED BAR 420 MPa (GRADE 60) - ASTM A615/A615M.
3. CLEAR COVER TO MAIN REINFORCEMENT SHALL BE COLUMN - 50MM., FOUNDATION - 50 MM.

DOCUMENT NUMBER	REFERENCE DOCUMENTS	REV	DATE	REVISION DESCRIPTION	DRN	CHK	ENG	APP	EMP
MD-216-3710-EG-CV-GAD-1378	LAYOUT & DETAIL OF FOUNDATION								
MD-216-1000-EG-ST-CRT-1001	CIVIL, STRUCTURAL & ARCHITECTURAL - DESIGN CRITERIA								
MD-216-3710-EG-ME-GAD-1002	FOUNDATION & LOAD PLAN	D01	22/02/2023	AS-BUILT	AUD	SJM	AVG	AG	
MD-216-3710-EG-ME-GAD-1001	3710-THK.-001 T10-TAILS PASTE THK, 40m	C01	07/03/2020	ISSUED FOR CONSTRUCTION	AUD	SJM	AVG	AG	
MD-216-3710-EG-CV-GAD-1377	LAYOUT & DETAIL OF FOUNDATION	A01	22/01/2020	ISSUED FOR REFERENCE	AUD	SJM	AVG	AG	

RESERVED FOR VENDOR LOGO AND DRAWING NUMBER

LARSEN & TOUBRO
This drawing is the property of LARSEN & TOUBRO and must not be passed on to any person or body not authorized by us to receive it nor be copied or otherwise made use either in full or in part by such person or body without our prior permission in writing.

Outotec
The content of these documents are the sole property of Outotec Oyj. Any rights not expressly granted herein are reserved. Reproduction, transfer or distribution of part or all of the contents in any form without prior written permission of Outotec is prohibited.

MA'ADEN معادن
Saudi Arabian Mining Company شركة التعدين العربية السعودية
This document and the information contained herein is Ma'aden proprietary know-how. This document or any part thereof should not be reproduced, stored in a retrieval system or transmitted by any means, electronic or otherwise, or divulged without prior written permission of Ma'aden.

LARSEN & TOUBRO DRAWING NUMBER	019045_450_C_D_24149_001		REVISION 2
OUTOTEC DRAWING NUMBER	900707__GAU01__ST03__CTB17__37111	DOCUMENT ID OU100665549	REVISION 2

DRAWN	AUD	01/10/2019
CHECKED	SJM	21/01/2020
ENGINEER	AVG	21/01/2020
APPROVED	AG	22/01/2020
EMPLOYER		
SCALE	1:50, 1:30, 1:25	A1

MANSOURAH - MASSARAH GOLD PROJECT
DETAIL DRAWING
TAILINGS PASTE THICKENING
RCC. DETAILS OF FOUNDATIONS

DRAWING NUMBER MD-216-3710-EG-CV-DED-1384 REV D01