


DRAWING NUMBER: MD-216-3710-EG-CV-DED-1385 REV D01

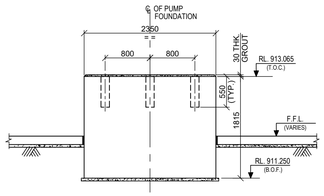


SECTION : A-A
SCALE 1:40

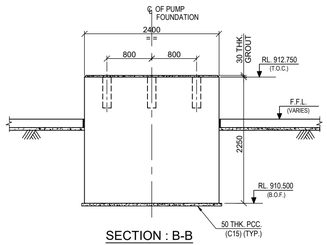


SECTION : B-B
SCALE 1:40

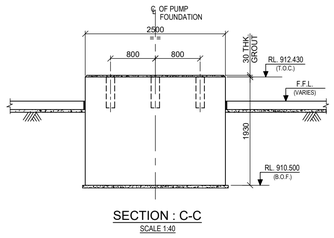


SECTION : C-C
SCALE 1:40

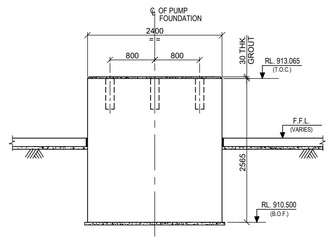


SECTION : D-D
SCALE 1:40

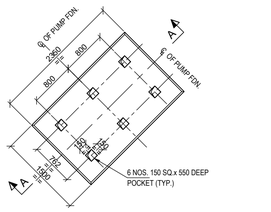


FDN. FOR PUMP MKD.
3710-PMP-001 & 002 (SIMILAR BUT OPPOSITE HAND)
SCALE 1:40

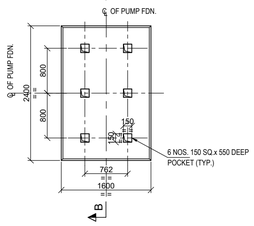


FDN. FOR PUMP MKD.
3710-PMP-003 & 004
SCALE 1:40

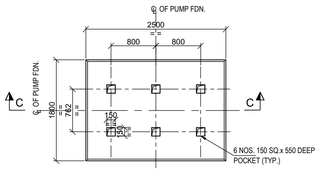


FDN. FOR PUMP MKD.
3710-PMP-005
SCALE 1:40

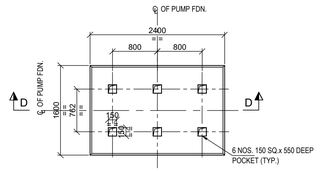


FDN. FOR PUMP MKD.
3710-PMP-006
SCALE 1:40

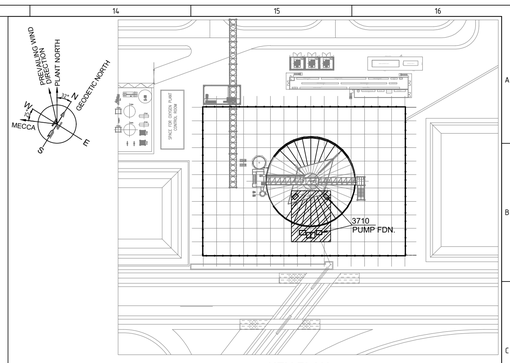


KEY PLAN
SCALE 1:1000

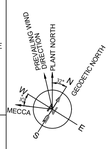


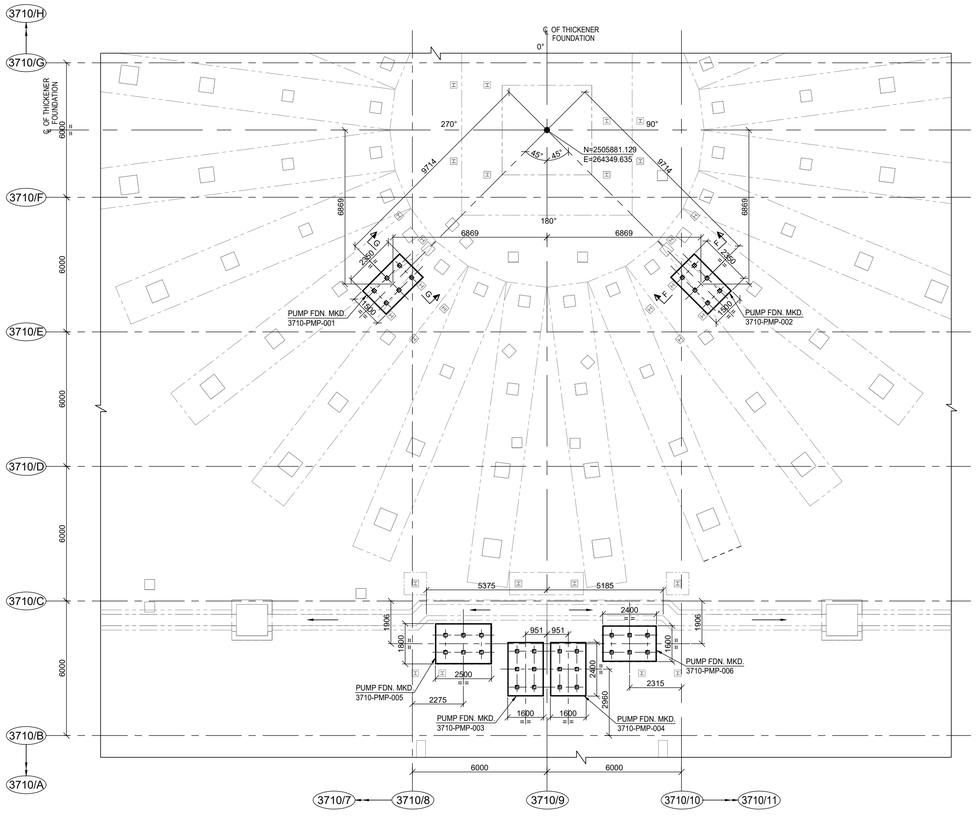


LAYOUT OF PUMP FOUNDATIONS FOR TAILINGS PASTE THICKENING
(FOR PUMP MKD. 3710-PMP-001, 002, 003, 004, 005 & 006)
SCALE 1:100

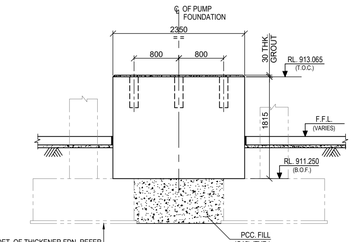


SECTION : G-G
SECTION : F-F (SIMILAR BUT OPPOSITE HAND)
SCALE 1:40

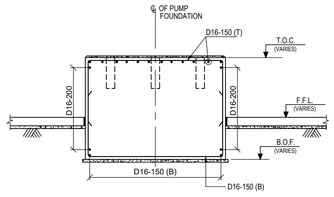

SECTION : E-E
SCALE 1:40

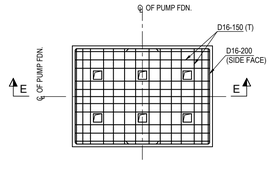

RC. DET. OF FDN. FOR PUMP MKD.
3710-PMP-001,002,003,004,005 & 006
(TOP VIEW)
SCALE 1:40

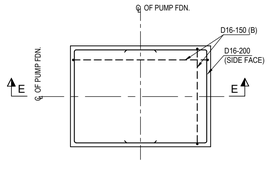

RC. DET. OF FDN. FOR PUMP MKD.
3710-PMP-001,002,003,004,005 & 006
(BOTTOM VIEW)
SCALE 1:40

LEGENDS :-

R.L - REDUCED LEVEL
℄ - CENTRE LINE
T.O.C. - TOP OF CONCRETE
TYP. - TYPICAL
T.O.G. - TOP OF GROUT
B.O.F. - BOTTOM OF FOUNDATION
F.G.L. - FINISHED GROUND LEVEL
F.F.L. - FINISHED FLOOR LEVEL
P.C.C - PLAIN CEMENT CONCRETE
DET. - DETAIL
FDN. - FOUNDATION
THK. - THICK
R.C. - REINFORCED CONCRETE
MKD. - MARKED
MIN. - MINIMUM
DIA. - DIAMETER
BOTTOM REINFORCEMENT (B) - - - - - -
TOP REINFORCEMENT (T) - ———
SQ. - SQUARE

NOTES:-

1. ALL DIMENSIONS ARE IN MILLIMETRES AND LEVELS AND CO-ORDINATES ARE IN METRES UNLESS OTHERWISE STAIETD.
2. NET SAFE BEARING CAPACITY OF SOIL AT BOTTOM OF FOUNDATION CONSIDERED AS 90KN/ SQ. M.
3. GRADE OF CONCRETE SHALL BE C35 (35MPa) FOR FOUNDATION & C15 (15MPa) FOR BLINDING CONCRETE.
4. GRADE OF REINFORCEMENT SHALL BE DEFORMED BAR 420 MPa (GRADE 60) - ASTM A615/A615M.
5. CLEAR COVER TO REINFORCEMENT SHALL BE
   a. FOUNDATIONS = 50 MM.
6. IF ANY PART OF FOUNDATION COMES ON BACKFILL ZONE OF ADJACENT FOUNDATION OR ANY LOOSE SOIL ARE ENCOUNTERED BELOW FOUNDATION LEVEL THE SAME SHALL BE REMOVED AND FILLED WITH PCC.
7. FOR STANDARD REINFORCEMENT DETAIL & GENERAL NOTES FOR CIVIL WORKS REFER DRAWING NO: MD-216-1000-EG-CV-DED-1005 & 1001.

DOCUMENT NUMBER	REFERENCE DOCUMENTS	REV	DATE	REVISION DESCRIPTION	DRN	CHK	ENG	APP	EMP
	MD-216-3710-EG-CV-GAD-1377	D01	22/02/2023	AS-BUILT	ABS	SJM	AVG	AG	
	MD-216-3710-EG-ME-GAD-1015	C01	03/09/2020	ISSUED FOR CONSTRUCTION	ABS	SJM	AVG	AG	
	MD-216-1000-EG-ST-CRT-1001	A01	07/08/2020	ISSUED FOR REFERENCE	ABS	SJM	AVG	AG	

RESERVED FOR VENDOR LOGO AND DRAWING NUMBER

This drawing is the property of LARSEN & TOUBRO and must not be passed on to any person or body not authorized by us to receive it nor be copied or otherwise made use either in full or in part by such person or body without our prior permission in writing.

The content of these documents are the sole property of Outotec Oyj. Any rights not expressly granted herein are reserved. Reproduction, transfer or distribution of part or all of the contents in any form without prior written permission of Outotec is prohibited.

This document and the information contained herein is Ma'aden proprietary know-how. This document or any part thereof should not be reproduced, stored in a retrieval system or transmitted by any means, electronic or otherwise, or divulged without prior written permission of Ma'aden.

LARSEN & TOUBRO DRAWING NUMBER	019045_450_C_D_24149_002	REVISION 2
OUTOTEC DRAWING NUMBER	900707__GAU01__ST03__CTB17__37112	DOCUMENT ID OU100665550 REVISION 2

DRAWN	ABS	31/07/2020	MANSOURAH - MASSARAH GOLD PROJECT
CHECKED	SJM	03/08/2020	DETAIL DRAWING
ENGINEER	AVG	01/08/2020	TAILINGS PASTE THICKENING
APPROVED	AG	07/08/2020	LAYOUT & DETAIL OF PUMP FOUNDATIONS
EMPLOYER			
SCALE	1:100, 1:40	A0	DRAWING NUMBER: MD-216-3710-EG-CV-DED-1385 REV D01