


DRAWING NUMBER MD 216 3710 -EG-CV-DED - 1386 REV D01

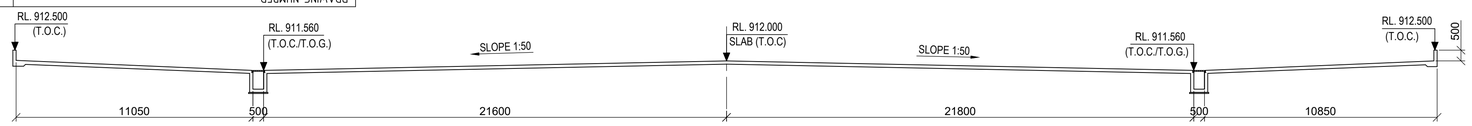


SECTION B-B
SCALE 1:150

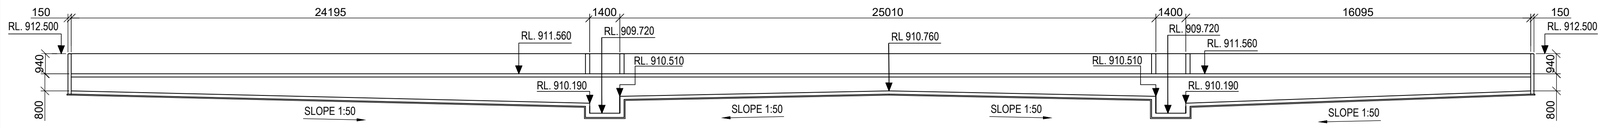


SECTION A-A
SCALE 1:150

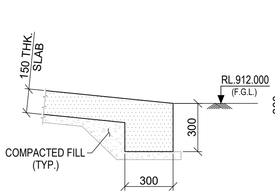


DETAIL - A
(SCALE 1:20)

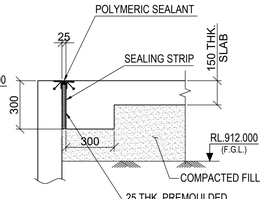


DETAIL - B
(SCALE 1:20)

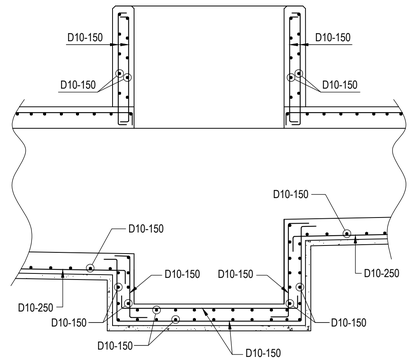


SECTION F-F
(R.C DETAIL)
SCALE 1:30

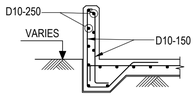


SECTION C-C
SECTION C'-C' (OPP. HAND)
(R.C DETAIL)
SCALE 1:30

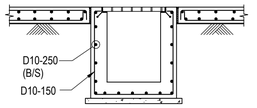


SECTION D-D
(R.C DETAIL)
SCALE 1:30

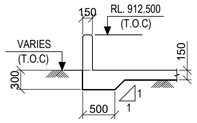


SECTION C-C
SECTION C'-C' (OPP. HAND)
SCALE 1:50

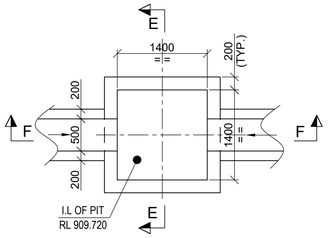


DETAIL-D1
DETAIL-D2 (OPP. HAND)
SCALE 1:50

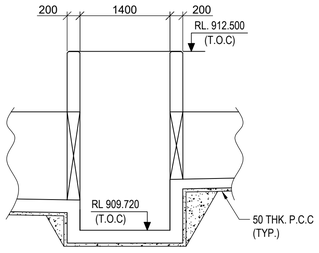


SECTION F-F
SCALE 1:50

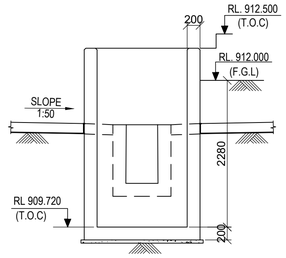


SECTION E-E
SCALE 1:50

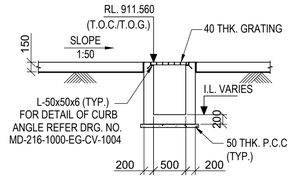


SECTION D-D
SCALE 1:50

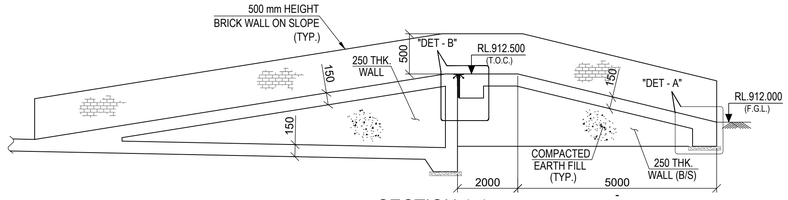


SECTION 1-1
(SCALE - 1:40)

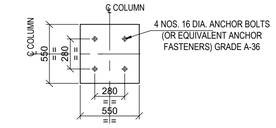


VIEW : G-G
SCALE 1:30

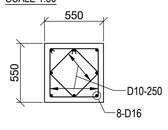


SECTION : H-H
SCALE 1:30

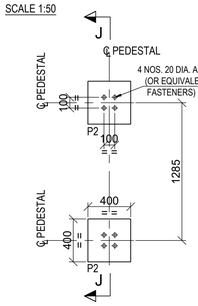


DETAIL OF P2
(SCALE 1:30)

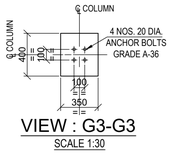


VIEW : G3-G3
SCALE 1:30

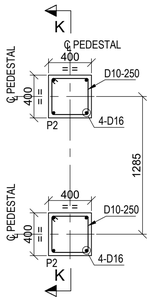


DETAIL OF P2
(RC DETAIL)
(SCALE 1:30)

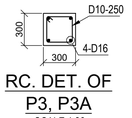


RC. DET. OF
P3, P3A
SCALE 1:30

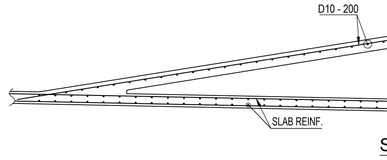


SECTION 1-1
(RC. DETAIL)
(SCALE - 1:40)

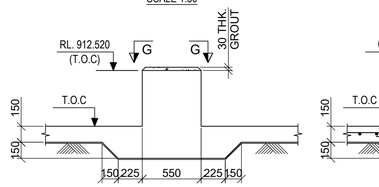


DETAIL OF P1
SCALE 1:30

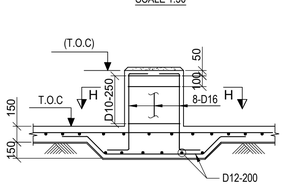


DETAIL OF P1,P4
(R.C DETAIL)
SCALE 1:30

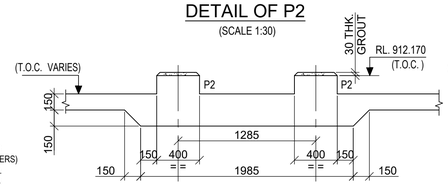

SECTION J-J
(SCALE 1:30)

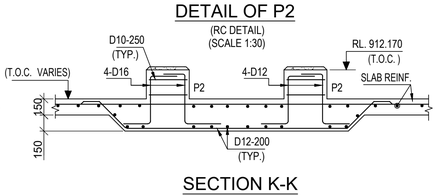


SECTION K-K
(SCALE 1:30)

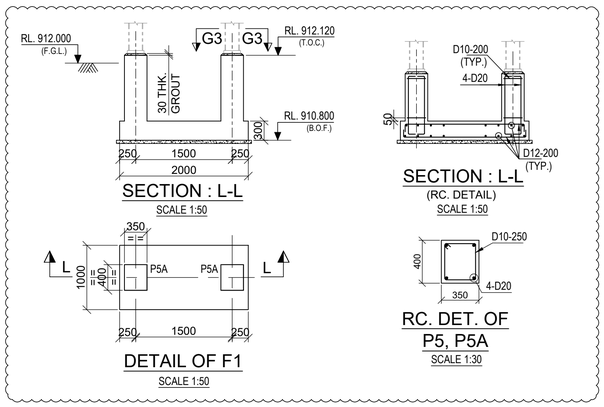


DETAIL OF F1
SCALE 1:50

SECTION : L-L
(RC. DETAIL)
SCALE 1:50


RC. DET. OF
P5, P5A
SCALE 1:30

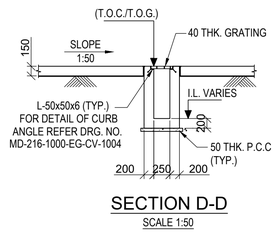


SECTION D-D
SCALE 1:50

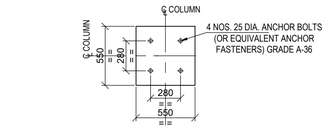


VIEW : G1-G1
SCALE 1:30

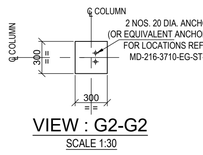


VIEW : G2-G2
SCALE 1:30

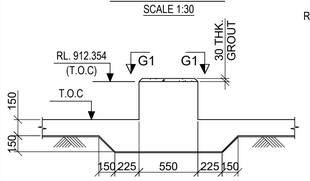


DETAIL OF P4
SCALE 1:30

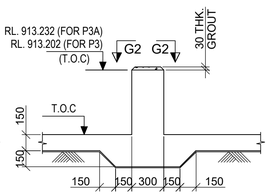


DETAIL OF P3 & P3A
SCALE 1:30

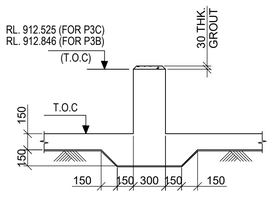


DETAIL OF P3B&P3C
SCALE 1:30

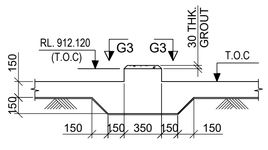


DETAIL OF P5
SCALE 1:30

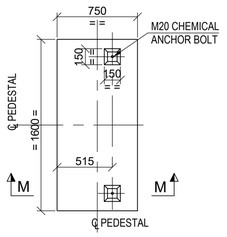


DETAIL OF PEDESTAL
MKD. P6 TO P12
(PEDESTAL ORIENTATION TREATED AS PER LAYOUT PLAN)
(SCALE - 1:30)

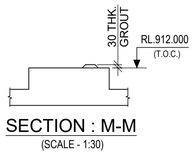

SECTION : M-M
(SCALE - 1:30)

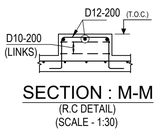

SECTION : M-M
(R.C DETAIL)
(SCALE - 1:30)

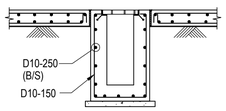

SECTION D-D
(R.C DETAIL)
SCALE 1:30

LEGEND :-

R.L. - REDUCED LEVEL
I.L. - INVERT LEVEL
F.G.L - FINISHED GROUND LEVEL
THK. - THICK
T.O.C - TOP OF CONCRETE
℄ - CENTRE LINE
TYP. - TYPICAL
OPP. - OPPOSITE
T.O.G - TOP OF GRATING
REINF. - REINFORCEMENT
DIA. - DIAMETER
P.C.C - PLAIN CEMENT CONCRETE
DRG. - DRAWING
R.C. - REINFORCED CONCRETE

NOTES:-

1. ALL DIMENSIONS ARE IN MILLIMETRES AND LEVELS AND CO-ORDINATES ARE IN METRES UNLESS OTHERWISE STATED.
2. FOR DETAILS OF GRADE SLAB REFER DRG. NO. MD-216-1000-EG-CV-DED-1002.
3. THE CONTENT OF THIS DRAWING SHALL CONFORM TO THE PROVISIONS OF CIVIL, STRUCTURAL AND ARCHITECTURAL DESIGN CRITERIA DOCUMENT NO. MD-216-1000-EG-ST-CRT-1001.
4. THIS DRAWING SHOULD BE READ IN CONJUNCTION WITH DRAWING NO. MD-216-3710-EG-CV-GAD-1381.

DOCUMENT NUMBER	REFERENCE DOCUMENTS	REV	DATE	REVISION DESCRIPTION	DRN	CHK	ENG	APP	EMP
MD-216-3710-EG-ME-GAD-1001	TAILINGS PASTE THICKENINGPLAN AT EL. +912.000								
MD-216-3750-EG-CV-GAD-1310	DETAIL OF TANK FOUNDATION 3750-TNK-001	D01	22/02/2023	AS-BUILT	ABS	SJM	AVG	AG	
MD-216-3710-EG-CV-GAD-1379	LAYOUT AND DETAIL OF STAIR FOUNDATION	C01	05/12/2020	ISSUED FOR CONSTRUCTION & REVISED AS MKD. C01	ABS	SJM	AVG	AG	
MD-216-3710-EG-CV-GAD-1377	LAYOUT & DETAIL OF FOUNDATION	A01	19/10/2020	ISSUED FOR REFERENCE	ABS	SJM	AVG	AG	

RESERVED FOR VENDOR LOGO AND DRAWING NUMBER

LARSEN & TOUBRO DRAWING NUMBER: 019045_450_C_D_24149_003 — REVISION: 2
OUTOTEC DRAWING NUMBER: 900707 __GAU01 __ST03__CTB17 __37101 — DOCUMENT ID: OU100665587 — REVISION: 2

DRAWN	ABS	12/10/2020	MANSOURAH - MASSARAH GOLD PROJECT
CHECKED	SJM	15/10/2020	DETAIL DRAWING
ENGINEER	AVG	13/10/2020	TAILINGS PASTE THICKENING
APPROVED	AG	19/10/2020	DETAILS OF GRADE SLAB
EMPLOYER			
SCALE	1:150, 1:50, 1:30	A1	DRAWING NUMBER: MD– 216 –3710 - EG- CV - DED - 1386 — REV: D01

LARSEN & TOUBRO
This drawing is the property of LARSEN & TOUBRO and must not be passed on to any person or body not authorized by us to receive it nor be copied or otherwise made use either in full or in part by such person or body without our prior permission in writing.

Outotec
The content of these documents are the sole property of Outotec Oyj. Any rights not expressly granted herein are reserved. Reproduction, transfer or distribution of part or all of the contents in any form without prior written permission of Outotec is prohibited.

MA'ADEN معادن
Saudi Arabian Mining Company شركة التعدين العربية السعودية
This document and the information contained herein is Ma'aden proprietary know-how. This document or any part thereof should not be reproduced, stored in a retrieval system or transmitted by any means, electronic or otherwise, or divulged without prior written permission of Ma'aden.