



DRAWING NUMBER MD-216-3710-EG-CV-GAD-1377 REV D01

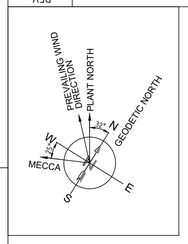

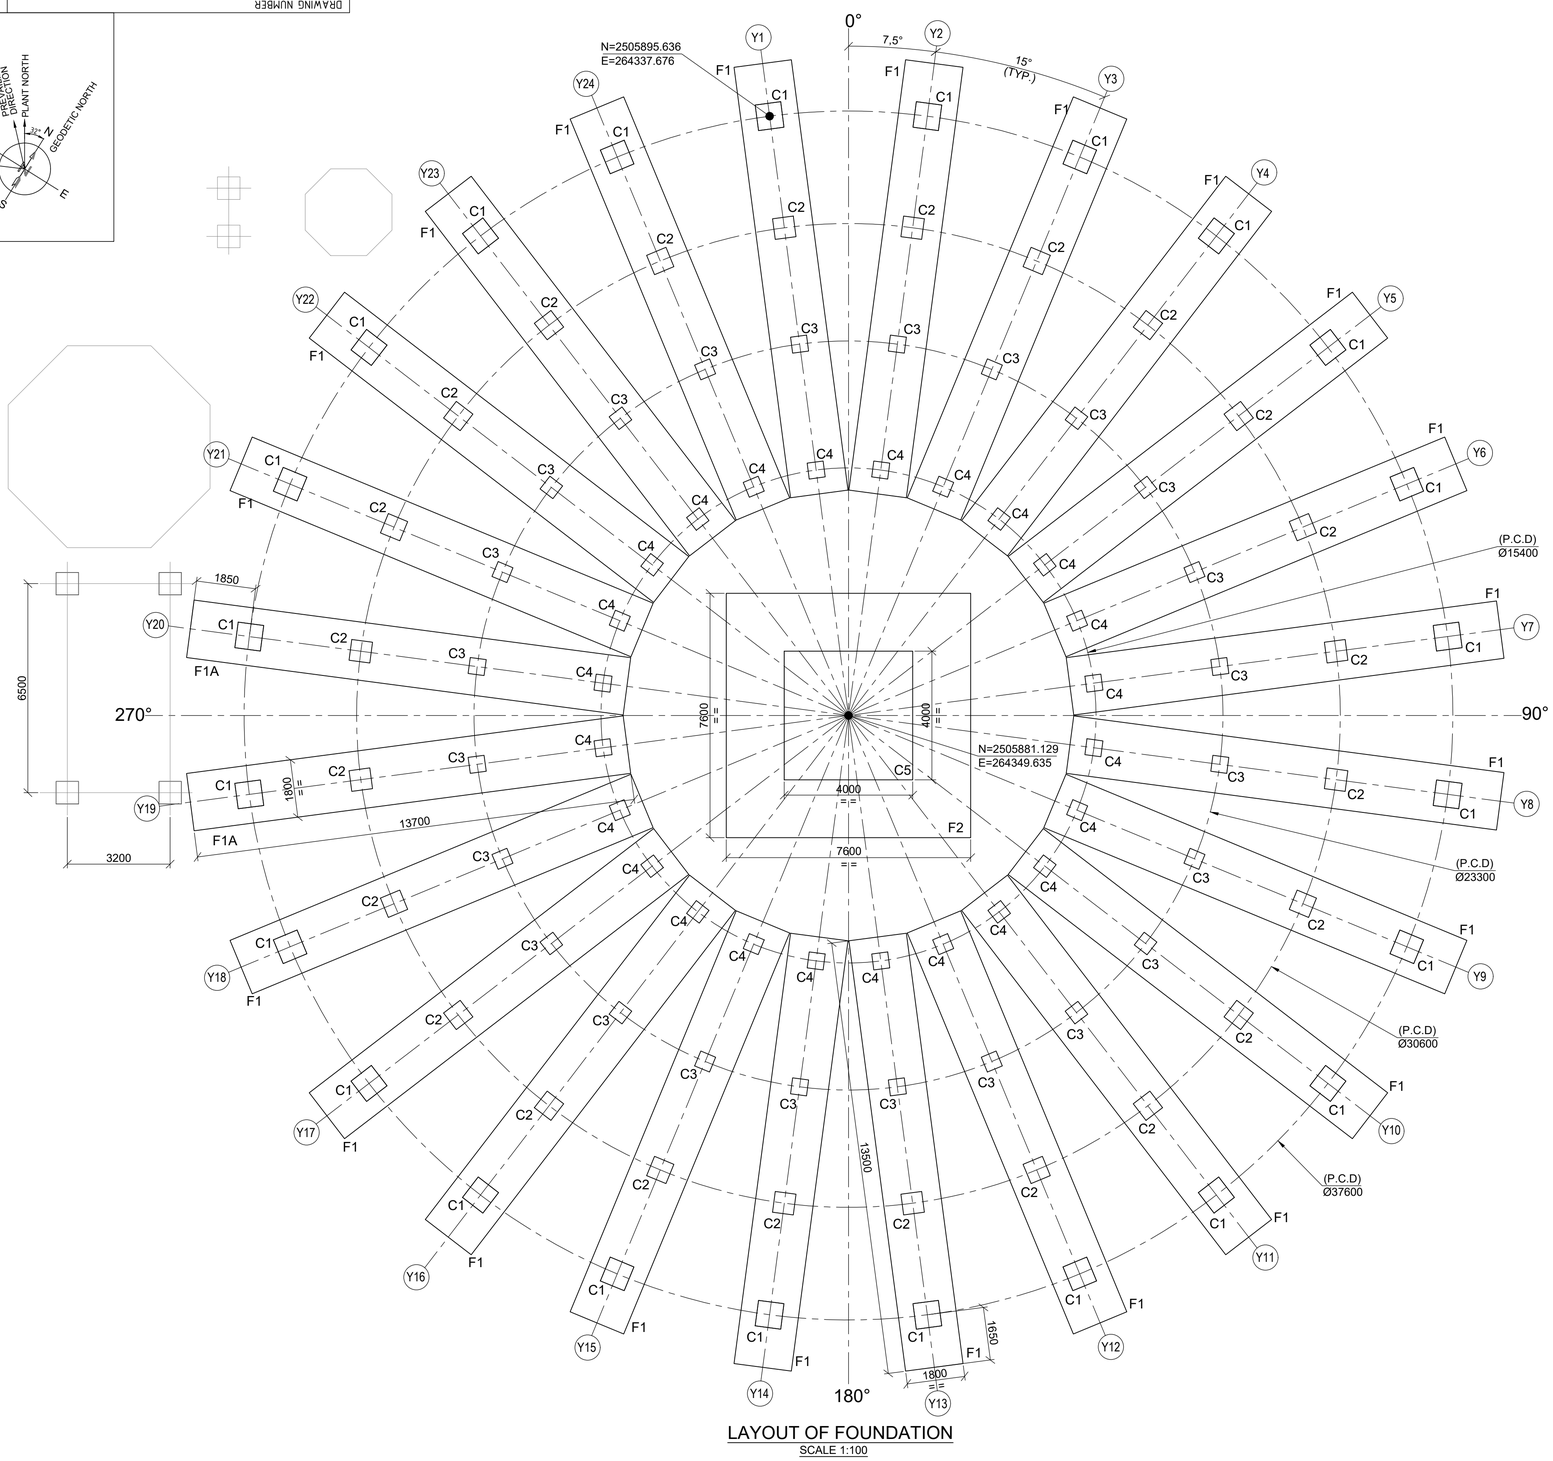

LAYOUT OF FOUNDATION
SCALE 1:100

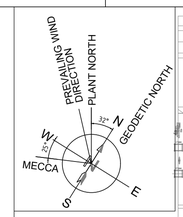

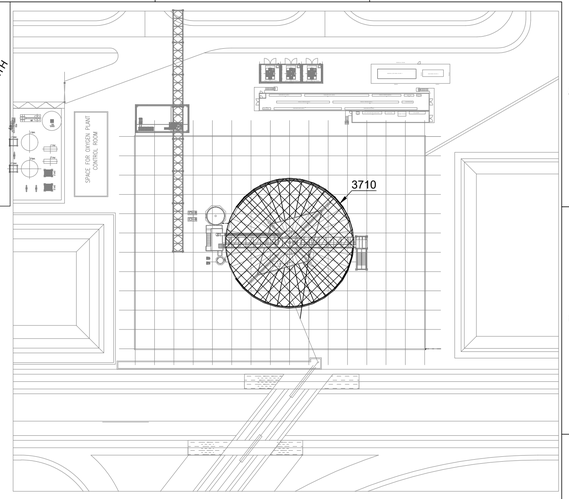

KEY PLAN
SCALE 1:1000

LEGEND :-

T.O.G - TOP OF GROUT
CJ - CONSTRUCTION JOINT
F.G.L - FINISHED GROUND LEVEL
P.C.D - PITCH CIRCLE DIAMETER
R.L. - REDUCED LEVEL
C.L. - CENTRE LINE
B.O.F. - BOTTOM OF FOUNDATION
P.C.C - PLAIN CEMENT CONCRETE

NOTES:-

1. ALL DIMENSIONS ARE IN MILLIMETRES AND LEVELS AND CO-ORDINATES ARE IN METRES UNLESS OTHERWISE STATED.
2. GRADE OF CONCRETE SHALL BE 35 MPa FOR FOUNDATION, 30 MPa FOR GRADE SLAB & 15 MPa FOR BLINDING CONCRETE.
3. GRADE OF REINFORCEMENT SHALL BE DEFORMED BAR 420 MPa (GRADE 60) - ASTM A615/A615M.
4. GRADE OF WELDED WIRE FABRIC - ASTM A185(PLAIN) / A497 (DEFORMED).
5. NET SAFE BEARING CAPACITY OF SOIL AT BOTTOM OF FOUNDATION CONSIDERED 500KN/ SQ. M
6. IF ANY PART OF FOUNDATION COMES ON BACKFILL ZONE OF ADJACENT FOUNDATION OR ANY LOOSE SOIL ARE ENCOUNTERED BELOW FOUNDATION LEVEL THE SAME SHALL BE REMOVED AND FILLED WITH PCC.
7. THE CONTENTS OF THIS DRAWING SHALL CONFORM TO THE PROVISIONS OF CIVIL, STRUCTURAL AND ARCHITECTURAL DESIGN CRITERIA DOC # MD-216-1000-EG-ST-CRT-1001

DOCUMENT NUMBER	REFERENCE DOCUMENTS	REV	DATE	REVISION DESCRIPTION	DRN	CHK	ENG	APP	EMP
MD-216-3710-EG-CV-DED-1384	RCC. DETAILS OF FOUNDATIONS								
MD-216-3710-EG-CV-GAD-1378	LAYOUT & DETAIL OF FOUNDATION								
MD-216-1000-EG-ST-CRT-1001	CIVIL, STRUCTURAL & ARCHITECTURAL - DESIGN CRITERIA	D01	22/02/2023	AS-BUILT	AUD	SJM	AVG	AG	
MD-216-3710-EG-ME-GAD-1002	FOUNDATION & LOAD PLAN	C01	07/03/2020	ISSUED FOR CONSTRUCTION	AUD	SJM	AVG	AG	
MD-216-3710-EG-ME-GAD-1001	3710-THK.-001 T10-TAILS PASTE THK, 40m	A01	22/01/2020	ISSUED FOR REFERENCE	AUD	SJM	AVG	AG	

RESERVED FOR VENDOR LOGO AND DRAWING NUMBER

LARSEN & TOUBRO

This drawing is the property of *LARSEN & TOUBRO* and must not be passed on to any person or body not authorized by us to receive it nor be copied or otherwise made use either in full or in part by such person or body without our prior permission in writing.

Outotec

The content of these documents are the sole property of Outotec Oyj. Any rights not expressly granted herein are reserved. Reproduction, transfer or distribution of part or all of the contents in any form without prior written permission of Outotec is prohibited.

MA'ADEN معادن
Saudi Arabian Mining Company شركة التعدين العربية السعودية

This document and the information contained herein is Ma'aden proprietary know-how. This document or any part thereof should not be reproduced, stored in a retrieval system or transmitted by any means, electronic or otherwise, or divulged without prior written permission of Ma'aden.

LARSEN & TOUBRO DRAWING NUMBER: 019045_450_C_G_24148_001 — REVISION: 2
OUTOTEC DRAWING NUMBER: 900707 _GAU01 _ST03_MTL01 _37107 — DOCUMENT ID: OU100665290 — REVISION: 2

DRAWN	AUD	21/12/2019
CHECKED	SJM	21/01/2020
ENGINEER	AVG	21/01/2020
APPROVED	AG	22/01/2020
EMPLOYER		
SCALE	1:100	A1

MANSOURAH - MASSARAH GOLD PROJECT
GENERAL ARRANGEMENT DRAWING
TAILINGS PASTE THICKENING
LAYOUT & DETAIL OF FOUNDATION

DRAWING NUMBER: MD-216-3710-EG-CV-GAD-1377 — REV: D01