


DRAWING NUMBER: MD-216-3710-EG-CV-GAD-1378
REV: D01

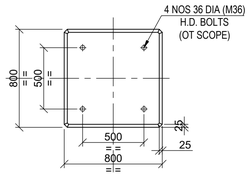


C1 PLAN
SCALE 1:25

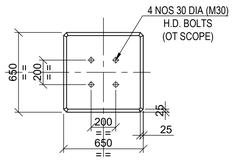


C2 PLAN
SCALE 1:25

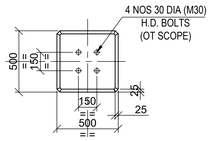


C3 PLAN
SCALE 1:25

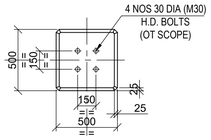


C4 PLAN
SCALE 1:25

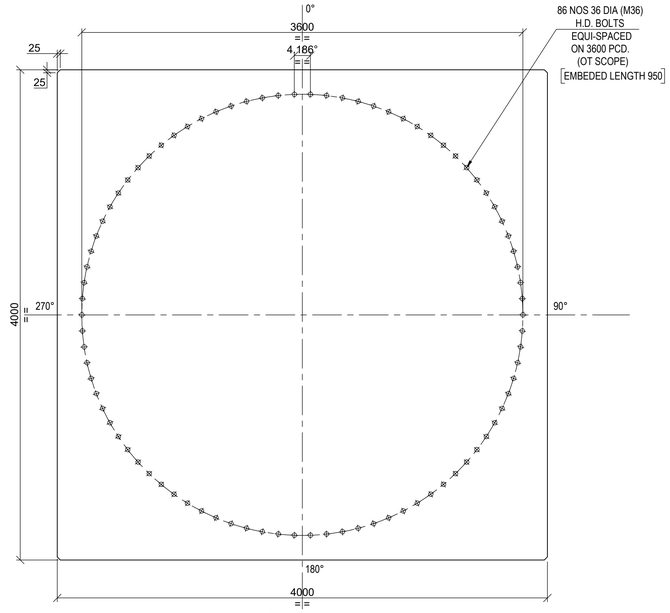


C4 PLAN
SCALE 1:25

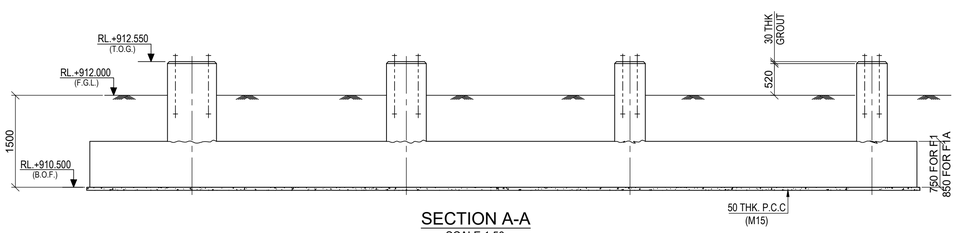


SECTION A-A
SCALE 1:50

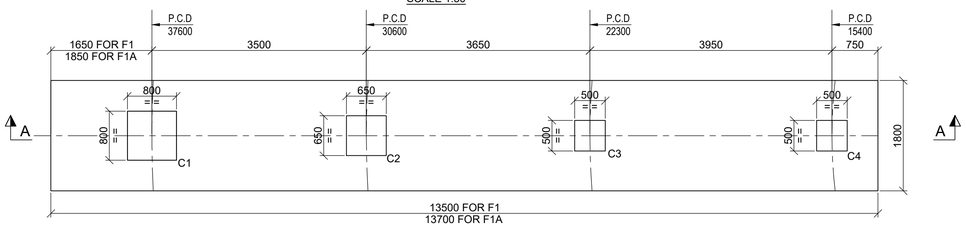

DETAILS OF FDN. MKD F1 & F1A
SCALE 1:50

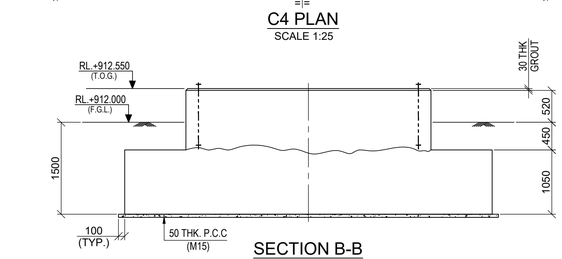

SECTION B-B
SCALE 1:50

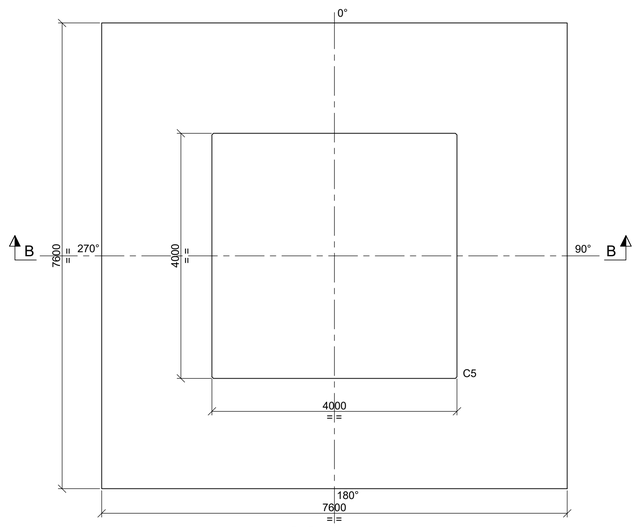

DETAILS OF FDN. MKD F2
SCALE 1:50

LEGEND :-

T.O.G - TOP OF GROUT
CJ - CONSTRUCTION JOINT
F.G.L - FINISHED GROUND LEVEL
R.L. - REDUCED LEVEL
P.C.D - PITCH CIRCLE DIAMETER
B.O.F. - BOTTOM OF FOUNDATION
P.C.C - PLAIN CEMENT CONCRETE

NOTES:-

1. ALL DIMENSIONS ARE IN MILLIMETRES AND LEVELS AND CO-ORDINATES ARE IN METRES UNLESS OTHERWISE STATED.
2. GRADE OF CONCRETE SHALL BE 35 MPa FOR FOUNDATION, 30 MPa FOR GRADE SLAB & 15 MPa FOR BLINDING CONCRETE.
3. GRADE OF REINFORCEMENT SHALL BE DEFORMED BAR 420 MPa (GRADE 60) - ASTM A615/A615M.
4. GRADE OF WELDED WIRE FABRIC - ASTM A185(PLAIN) / A497 (DEFORMED).
5. NET SAFE BEARING CAPACITY OF SOIL AT BOTTOM OF FOUNDATION CONSIDERED 500KN/ SQ. M
6. IF ANY PART OF FOUNDATION COMES ON BACKFILL ZONE OF ADJACENT FOUNDATION OR ANY LOOSE SOIL ARE ENCOUNTERED BELOW FOUNDATION LEVEL THE SAME SHALL BE REMOVED AND FILLED WITH PCC.
7. THE CONTENTS OF THIS DRAWING SHALL CONFORM TO THE PROVISIONS OF CIVIL, STRUCTURAL AND ARCHITECTURAL DESIGN CRITERIA DOC # MD-216-1000-EG-ST-CRT-1001

DOCUMENT NUMBER	REFERENCE DOCUMENTS	REV	DATE	REVISION DESCRIPTION	DRN	CHK	ENG	APP	EMP
MD-216-1000-EG-CV-DED-1003	ANCHOR BOLTS STANDARD DETAILS								
MD-216-3710-EG-CV-DED-1384	RCC. DETAILS OF FOUNDATIONS								
MD-216-1000-EG-ST-CRT-1001	CIVIL, STRUCTURAL & ARCHITECTURAL - DESIGN CRITERIA								
MD-216-3710-EG-ME-GAD-1002	FOUNDATION & LOAD PLAN	D01	22/02/2023	AS-BUILT	AUD	SJM	AVG	AG	
MD-216-3710-EG-ME-GAD-1001	3710-THK.-001 T10-TAILS PASTE THK, 40m	C01	07/03/2020	ISSUED FOR CONSTRUCTION & REVISED AS MKD, C01	AUD	SJM	AVG	AG	
MD-216-3710-EG-CV-GAD-1377	LAYOUT & DETAIL OF FOUNDATION	A01	22/01/2020	ISSUED FOR REFERENCE	AUD	SJM	AVG	AG	

RESERVED FOR VENDOR LOGO AND DRAWING NUMBER

LARSEN & TOUBRO DRAWING NUMBER: O19045_450_C_G_24148_002 — REVISION: 2

OUTOTEC DRAWING NUMBER: 900707__GAU01__ST03__MTL01__37108 — DOCUMENT ID: OU100665291 — REVISION: 2

LARSEN & TOUBRO

This drawing is the property of *LARSEN & TOUBRO* and must not be passed on to any person or body not authorized by us to receive it nor be copied or otherwise made use either in full or in part by such person or body without our prior permission in writing.

Outotec

The content of these documents are the sole property of Outotec Oyj. Any rights not expressly granted herein are reserved. Reproduction, transfer or distribution of part or all of the contents in any form without prior written permission of Outotec is prohibited.

MA'ADEN معادن
Saudi Arabian Mining Company شركة المعادن العربية السعودية

This document and the information contained herein is Ma'aden proprietary know-how. This document or any part thereof should not be reproduced, stored in a retrieval system or transmitted by any means, electronic or otherwise, or divulged without prior written permission of Ma'aden.

DRAWN	AUD	08/11/2019	MANSOURAH - MASSARAH GOLD PROJECT
CHECKED	SJM	21/01/2020	GENERAL ARRANGEMENT DRAWING
ENGINEER	AVG	21/01/2020	TAILINGS PASTE THICKENING
APPROVED	AG	22/01/2020	LAYOUT & DETAIL OF FOUNDATION
EMPLOYER			
SCALE	1:50, 1:25	A1	DRAWING NUMBER: MD-216-3710-EG-CV-GAD-1378 — REV: D01