


DRAWING NUMBER: MD-216-3710-EG-CV-GAD-1379 | REV: D01

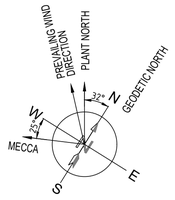


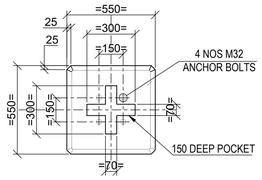


VIEW : B-B
(SCALE 1:20)

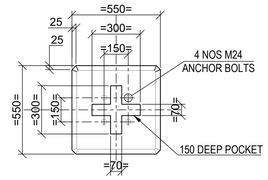


VIEW : C-C
(SCALE 1:20)

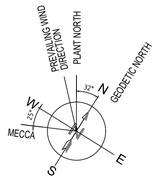


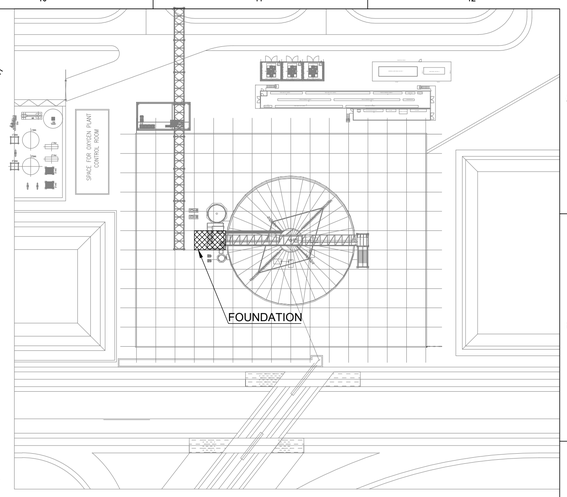


KEY PLAN
SCALE 1:1000

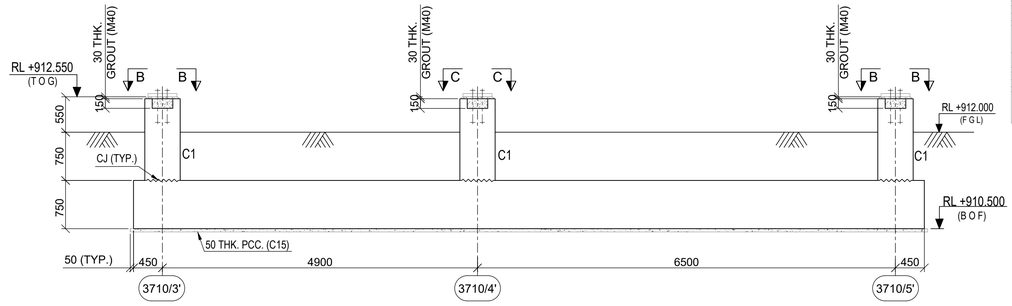

SECTION : A-A
(SCALE 1:50)

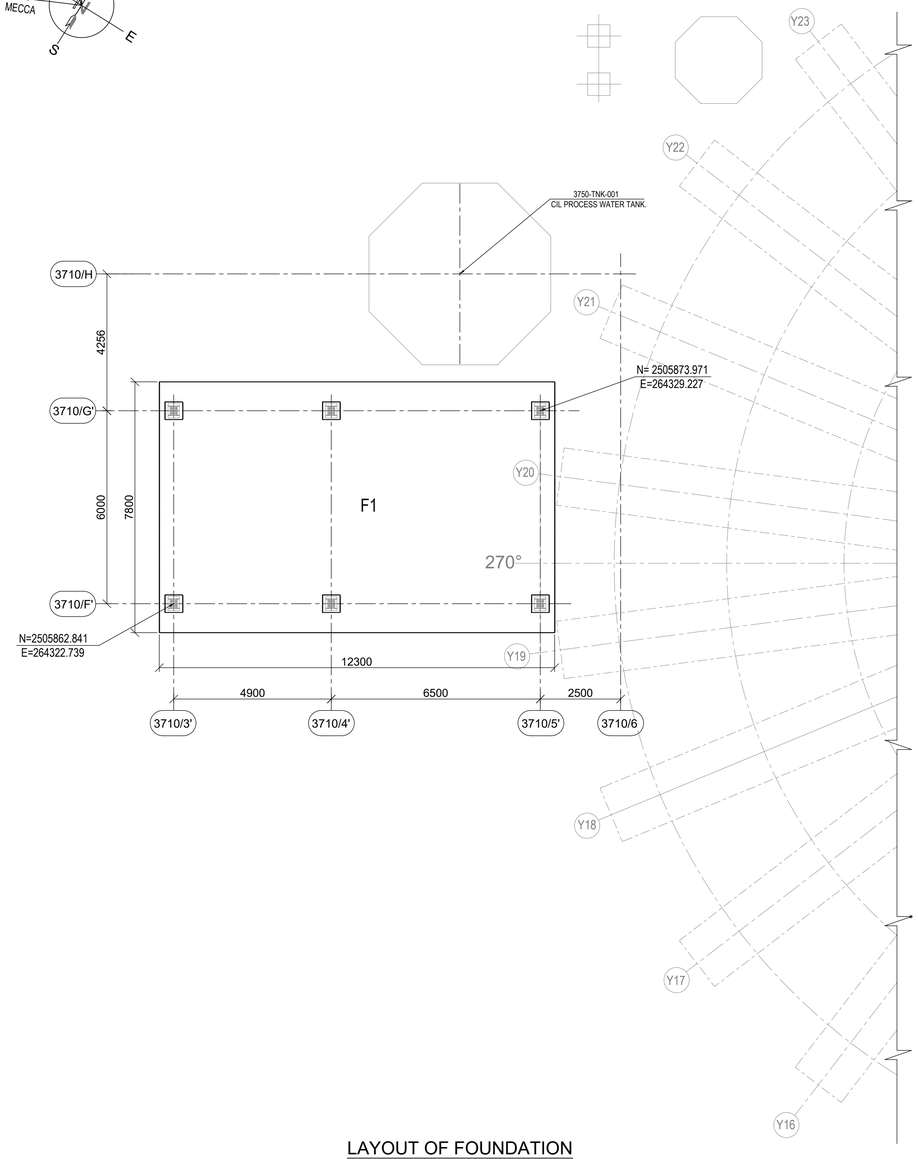

LAYOUT OF FOUNDATION
SCALE 1:100

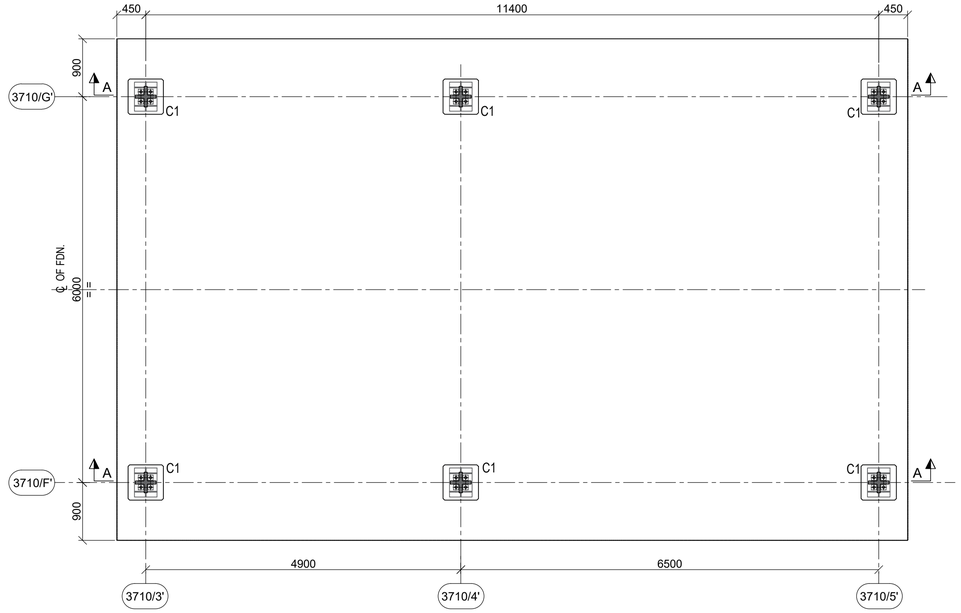

PLAN OF FOUNDATION MKD. F1
(1 NOS. REQD.)
(SCALE 1:50)

LEGEND :-

R.L. - REDUCED LEVEL
¢ - CENTRE LINE
T.O.C. - TOP OF CONCRETE
F.G.L. - FINISHED GROUND LEVEL
B.O.F. - BOTTOM OF FOUNDATION
TYP. - TYPICAL
THK. - THICK

NOTES:-

1. ALL DIMENSIONS ARE IN MILLIMETRES AND LEVELS AND CO-ORDINATES ARE IN METRES UNLESS OTHERWISE STATED.
2. GRADE OF CONCRETE SHALL BE 35 MPa FOR FOUNDATION, 30 MPa FOR GRADE SLAB & 15 MPa FOR BLINDING CONCRETE.
3. GRADE OF REINFORCEMENT SHALL BE DEFORMED BAR 420 MPa (GRADE 60) - ASTM A615/A615M.
4. NET SAFE BEARING CAPACITY OF SOIL AT BOTTOM OF FOUNDATION CONSIDERED 450KN/ SQ. M
5. IF ANY PART OF FOUNDATION COMES ON BACKFILL ZONE OF ADJACENT FOUNDATION OR ANY LOOSE SOIL ARE ENCOUNTERED BELOW FOUNDATION LEVEL THE SAME SHALL BE REMOVED AND FILLED WITH PCC.
6. FOR DETAIL OF ANCHOR BOLTS, REFER DRAWING NO. MD-216-1000-EG-CV-DED-1003.
7. THIS DRAWING SHALL BE READ IN CONJUNCTION WITH GENERAL NOTES DRG NO. MD-216-1000-EG-CV-DED-1001.
8. THIS DRAWING SHALL BE READ IN CONJUNCTION WITH STANDARD REINFORCEMENT DETAILS DRG NO. MD-216-1000-EG-CV-DED-1005.

DOCUMENT NUMBER	REFERENCE DOCUMENTS	REV	DATE	REVISION DESCRIPTION	DRN	CHK	ENG	APP	EMP
MD-216-3710-EG-ST-GAD-2325.	G.A DRAWING TELLING PASTE THICKNING PLAN, ELEVATION & DETAILS	A01	18/05/2020	ISSUED FOR REFERENCE	AUD	AVG	MMJ	AG	
		C01	11/06/2020	ISSUED FOR CONSTRUCTION	AUD	AVG	MMJ	AG	
		C02	15/01/2021	ISSUED FOR CONSTRUCTION & REVISED AS MKD. C02	AUD	SJM	AVG	AG	
		D01	22/02/2023	AS-BUILT	AUD	SJM	AVG	AG	

RESERVED FOR VENDOR LOGO AND DRAWING NUMBER

LARSEN & TOUBRO

This drawing is the property of LARSEN & TOUBRO and must not be passed on to any person or body not authorized by us to receive it nor be copied or otherwise made use either in full or in part by such person or body without our prior permission in writing.

Outotec

The content of these documents are the sole property of Outotec Oyj. Any rights not expressly granted herein are reserved. Reproduction, transfer or distribution of part or all of the contents in any form without prior written permission of Outotec is prohibited.

MA'ADEN معادن
Saudi Arabian Mining Company شركة التعدين العربية السعودية

This document and the information contained herein is Ma'aden proprietary know-how. This document or any part thereof should not be reproduced, stored in a retrieval system or transmitted by any means, electronic or otherwise, or divulged without prior written permission of Ma'aden.

LARSEN & TOUBRO DRAWING NUMBER: 019045_450_C_G_24148_003 | REVISION: 3
OUTOTEC DRAWING NUMBER: 900707__GAU01__ST03__MTL01__37109 | DOCUMENT ID: OU100665292 | REVISION: 3

DRAWN	AUD	12/05/2020
CHECKED	AVG	12/05/2020
ENGINEER	MMJ	10/05/2020
APPROVED	AG	14/05/2020
EMPLOYER		
SCALE	1:25, 1:50, 1:100	A1

MANSOURAH - MASSARAH GOLD PROJECT
GENERAL ARRANGEMENT DRAWING
TAILINGS PASTE THICKENING
LAYOUT AND DETAIL OF STAIR FOUNDATION

DRAWING NUMBER: MD-216-3710-EG-CV-GAD-1379 | REV: D01