


DRAWING NUMBER: MD-216-3710-EG-CV-GAD-1380 | REV: D01

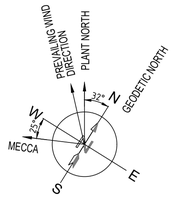


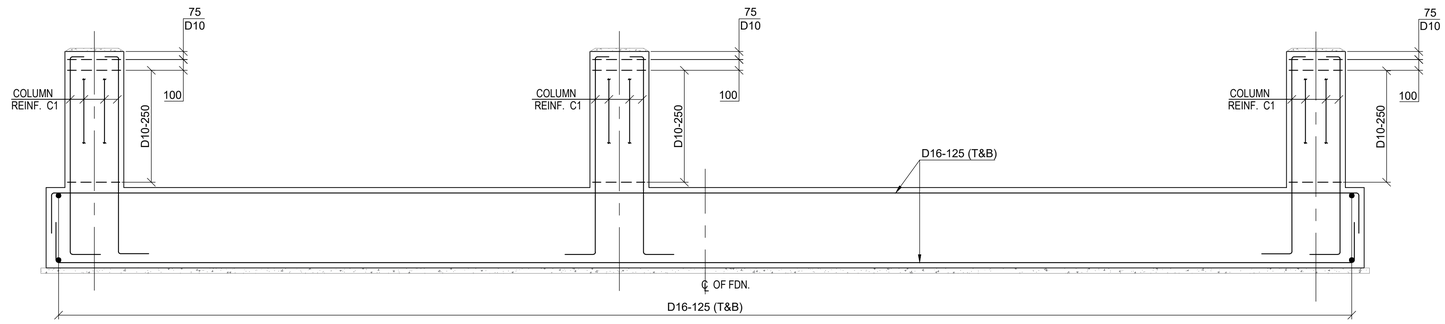

SECTION : D-D
(SCALE 1:30)

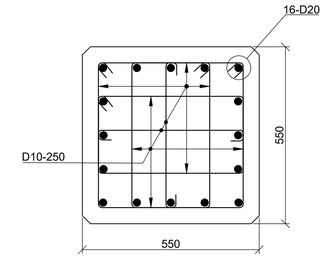

R.C DETAIL OF C1
(SCALE 1:10)

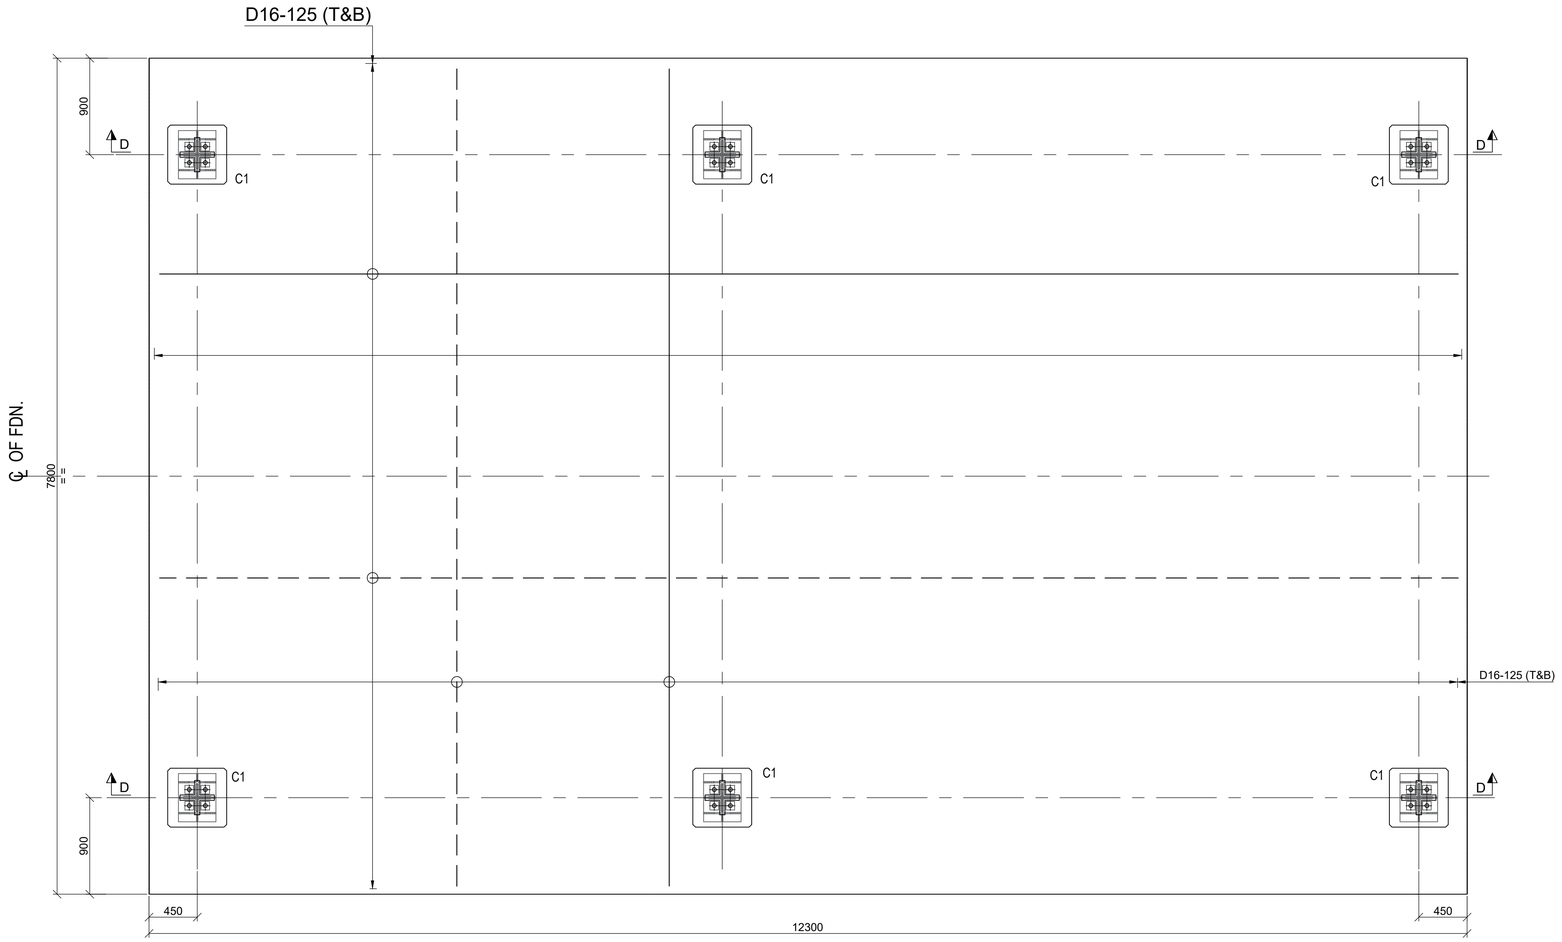

REINF. DETAIL OF FOUNDATION MKD. F1
(1 NOS. REQD.)
(SCALE 1:30)

LEGEND :-

℄ - CENTRE LINE
R.C.C - REINFORCED CEMENT CONCRETE
P.C.C - PLAIN CEMENT CONCRETE
BOTTOM REINF.(B) - - - - - - - -
TOP REINF.(T) - ————————
MKD. - MARKED
THK. - THICK

NOTES:-

1. GRADE OF CONCRETE SHALL BE 35 MPa FOR RCC, 15 MPa FOR BLINDING CONCRETE.
2. GRADE OF REINFORCEMENT SHALL BE DEFORMED BAR 420 MPa (GRADE 60) - ASTM A615/A615M.
3. CLEAR COVER TO MAIN REINFORCEMENT SHALL BE COLUMN - 50MM., FOUNDATION - 50 MM.

DOCUMENT NUMBER	REFERENCE DOCUMENTS	REV	DATE	REVISION DESCRIPTION	DRN	CHK	ENG	APP	EMP
		D01	22/02/2023	AS-BUILT	AUD	AVG	MMJ	AG	
		C01	11/06/2020	ISSUED FOR CONSTRUCTION	AUD	AVG	MMJ	AG	
MD-216-3710-EG-ST-GAD-2325.	TELLING PASTE THICKNING LAYOUT AND DETAIL OF STAIR FOUNDATION	A01	18/05/2020	ISSUED FOR REFERENCE	AUD	AVG	MMJ	AG	

RESERVED FOR VENDOR LOGO AND DRAWING NUMBER

LARSEN & TOUBRO

This drawing is the property of *LARSEN & TOUBRO* and must not be passed on to any person or body not authorized by us to receive it nor be copied or otherwise made use either in full or in part by such person or body without our prior permission in writing.

Outotec

The content of these documents are the sole property of Outotec Oyj. Any rights not expressly granted herein are reserved. Reproduction, transfer or distribution of part or all of the contents in any form without prior written permission of Outotec is prohibited.

MA'ADEN معادن
Saudi Arabian Mining Company شركة التعدين العربية السعودية

This document and the information contained herein is Ma'aden proprietary know-how. This document or any part thereof should not be reproduced, stored in a retrieval system or transmitted by any means, electronic or otherwise, or divulged without prior written permission of Ma'aden.

DRAWN	AUD	12/05/2020
CHECKED	AVG	12/05/2020
ENGINEER	MMJ	10/05/2020
APPROVED	AG	14/05/2020
EMPLOYER		
SCALE	1:25, 1:50, 1:100	A1

LARSEN & TOUBRO DRAWING NUMBER: 019045_450_C_G_24148_004 | REVISION: 2
OUTOTEC DRAWING NUMBER: 900707__GAU01__ST03__MTL01__37110 | DOCUMENT ID: OU100665293 | REVISION: 2

MANSOURAH - MASSARAH GOLD PROJECT
GENERAL ARRANGEMENT DRAWING
TAILINGS PASTE THICKENING
DETAIL OF STAIR FOUNDATION

DRAWING NUMBER: MD-216-3710-EG-CV-GAD-1380 | REV: D01