


DRAWING NUMBER MD-216-3710-EG-CV-GAD-1381 REV D01

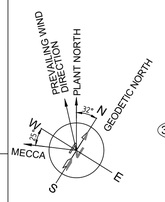


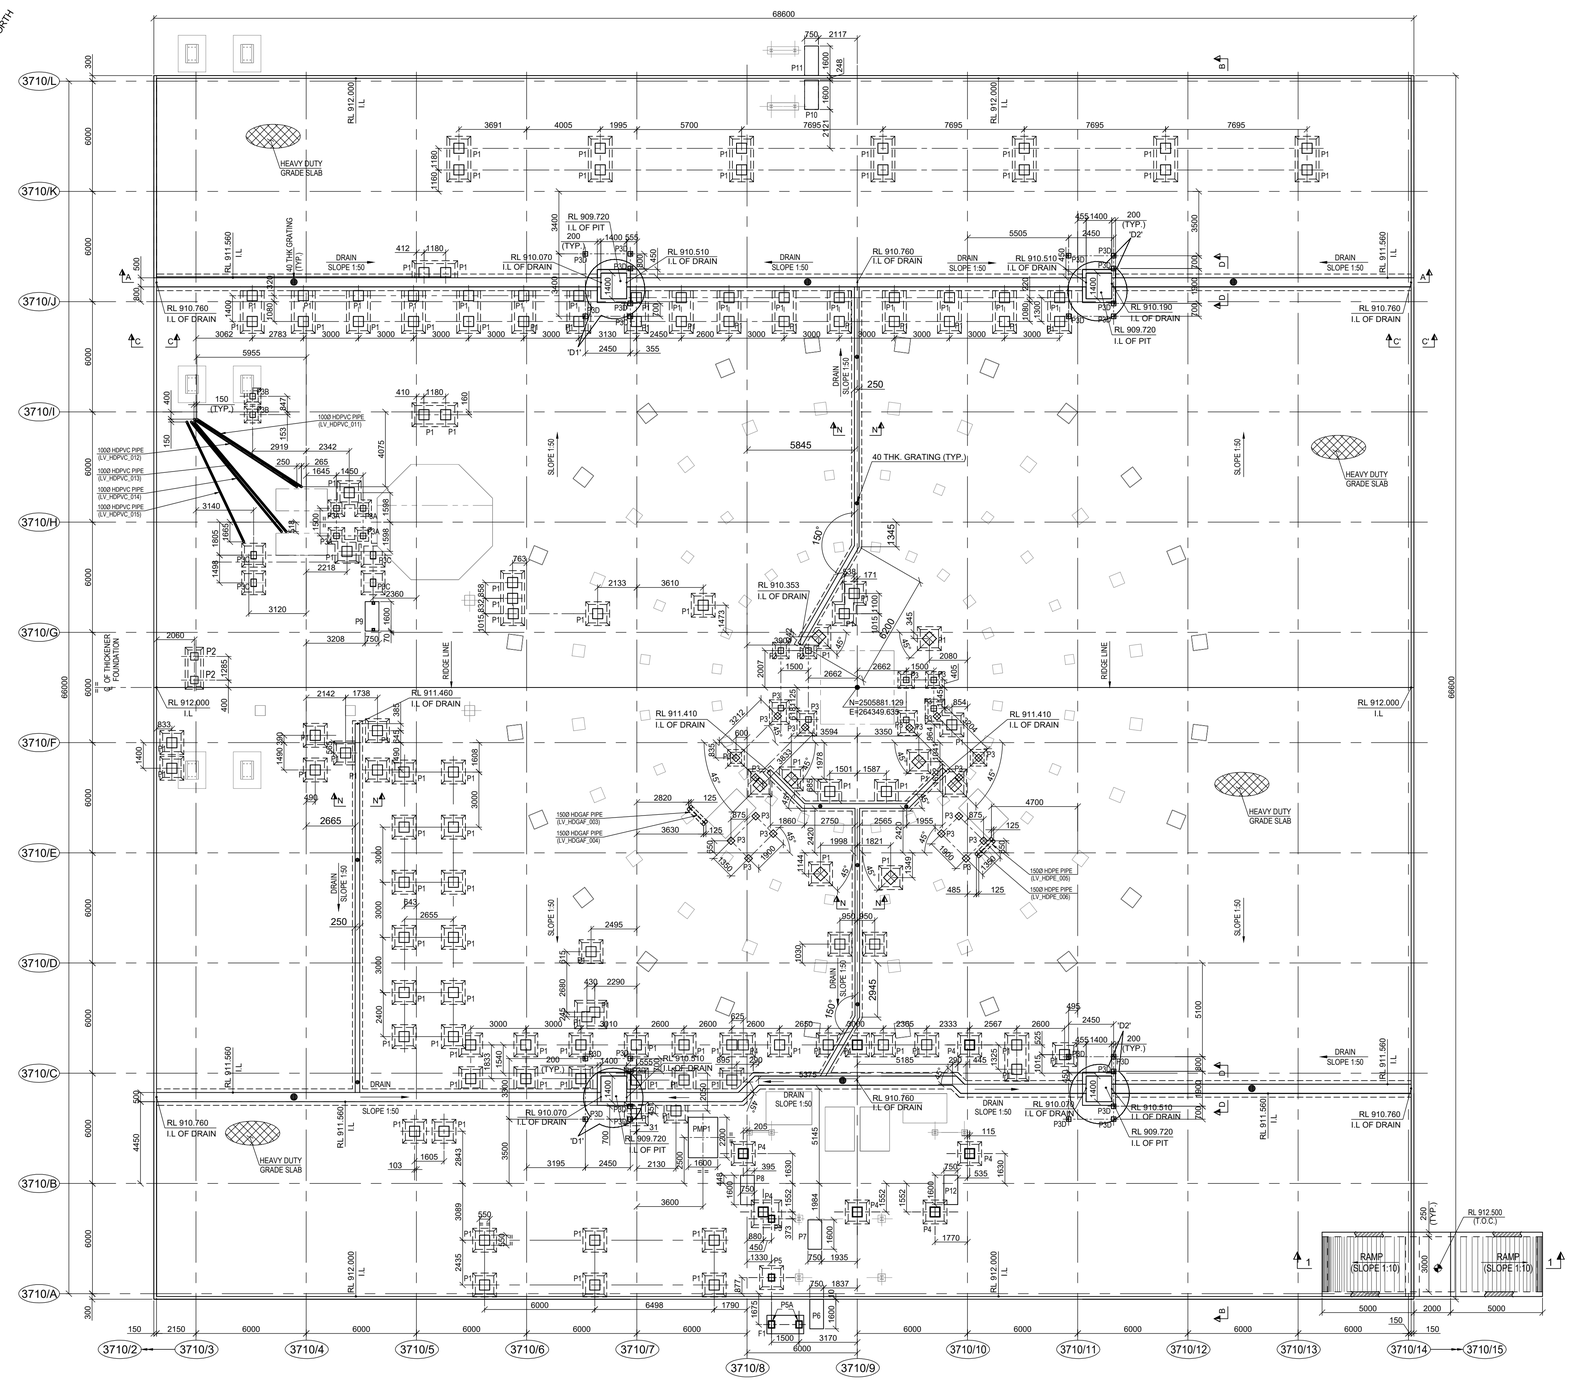


LAYOUT OF GRADE SLAB FOR TAILINGS PASTE THICKENING
SCALE 1:150

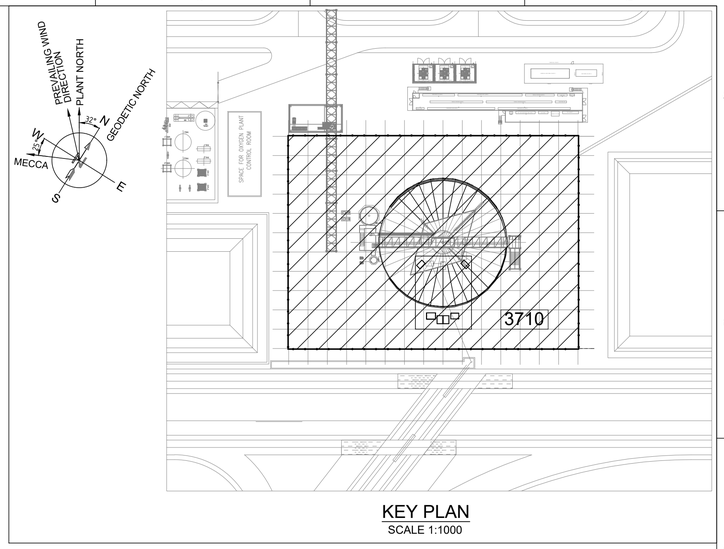


KEY PLAN
SCALE 1:1000

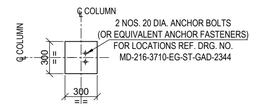


VIEW : Y-Y
SCALE 1:30

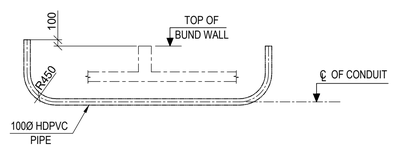

TYPICAL DETAIL OF CONDUIT
SCALE 1:50

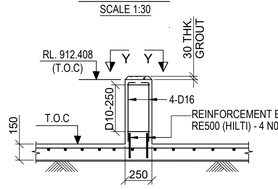


DETAIL OF P3D
SCALE 1:30

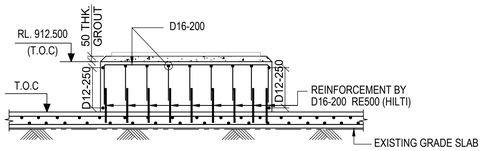

SECTION : X-X
SCALE 1:30

SCHEDULE OF CONDUIT

CONDUIT MKD.	ELEVATION AT ℄ OF CONDUIT
LV_HDGAF_003	RL 911.415
LV_HDGAF_004	RL 911.415
LV_HDPE_005	RL 911.415
LV_HDPE_005	RL 911.415
LV_HDPVC_011	RL 911.015
LV_HDPVC_012	RL 910.815
LV_HDPVC_013	RL 911.015
LV_HDPVC_014	RL 911.015
LV_HDPVC_015	RL 911.015

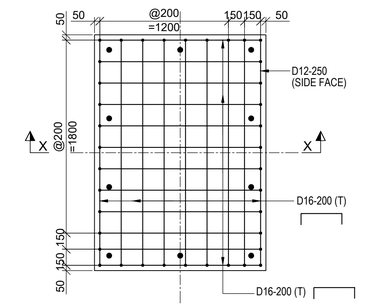

DETAIL OF PMP1
(R.C DETAIL)
SCALE 1:30

LEGEND :-

R.L. - REDUCED LEVEL
I.L - INVERT LEVEL
F.G.L - FINISHED GROUND LEVEL
THK. - THICK
T.O.C - TOP OF CONCRETE
℄ - CENTRE LINE
TYP. - TYPICAL
DRG. - DRAWING

NOTES:-

1. ALL DIMENSIONS ARE IN MILLIMETRES AND LEVELS AND CO-ORDINATES ARE IN METRES UNLESS OTHERWISE STATED.
2. FOR DETAILS OF GRADE SLAB REFER DRG. NO. MD-216-1000-EG-CV-DED-1002.
3. THE CONTENT OF THIS DRAWING SHALL CONFORM TO THE PROVISIONS OF CIVIL, STRUCTURAL AND ARCHITECTURAL DESIGN CRITERIA DOCUMENT NO. MD-216-1000-EG-ST-CRT-1001.
4. THIS DRAWING SHOULD BE READ IN CONJUNCTION WITH DRAWING NO. MD-216-3710-EG-CV-DED-1386.

DOCUMENT NUMBER	REFERENCE DOCUMENTS	REV	DATE	REVISION DESCRIPTION	DRN	CHK	ENG	APP	EMP
		D01	22/02/2023	AS-BUILT	SYA	SJM	AVG	AG	
MD-216-3710-EG-ME-GAD-1001	TAILINGS PASTE THICKENINGPLAN AT EL. +912.000	C03	28/09/2021	ISSUED FOR CONSTRUCTION & REVISED AS MKD. △C03	SYA	SJM	AVG	AG	
MD-216-3750-EG-CV-GAD-1310	DETAIL OF TANK FOUNDATION 3750-TNK-001	C02	13/04/2021	ISSUED FOR CONSTRUCTION & REVISED AS MKD. △C02	SYA	SJM	AVG	AG	
MD-216-3710-EG-CV-GAD-1379	LAYOUT AND DETAIL OF STAIR FOUNDATION	C01	05/12/2020	ISSUED FOR CONSTRUCTION & REVISED AS MKD. △C01	ABS	SJM	AVG	AG	
MD-216-3710-EG-CV-GAD-1377	LAYOUT & DETAIL OF FOUNDATION	A01	16/10/2020	ISSUED FOR REFERENCE	ABS	SJM	AVG	AG	

RESERVED FOR VENDOR LOGO AND DRAWING NUMBER

LARSEN & TOUBRO DRAWING NUMBER: O19045_450_C_G_24148_005 — REVISION: 4
OUTOTEC DRAWING NUMBER: 900707__GAU01__ST03__MTL01__37124 — DOCUMENT ID: OU100688100 — REVISION: 4

LARSEN & TOUBRO
This drawing is the property of LARSEN & TOUBRO and must not be passed on to any person or body not authorized by us to receive it nor be copied or otherwise made use either in full or in part by such person or body without our prior permission in writing.

Outotec
The content of these documents are the sole property of Outotec Oyj. Any rights not expressly granted herein are reserved. Reproduction, transfer or distribution of part or all of the contents in any form without prior written permission of Outotec is prohibited.

MA'ADEN معادن
Saudi Arabian Mining Company شركة التعدين العربية السعودية
This document and the information contained herein is Ma'aden proprietary know-how. This document or any part thereof should not be reproduced, stored in a retrieval system or transmitted by any means, electronic or otherwise, or divulged without prior written permission of Ma'aden.

DRAWN	ABS	12/10/2020	MANSOURAH - MASSARAH GOLD PROJECT
CHECKED	SJM	15/10/2020	GENERAL ARRANGEMENT DRAWING
ENGINEER	AVG	13/10/2020	TAILINGS PASTE THICKENING
APPROVED	AG	16/10/2020	LAYOUT OF GRADE SLAB
EMPLOYER			
SCALE 1:150		A1	DRAWING NUMBER: MD-216-3710-EG-CV-GAD-1381 — REV: D01