
PLAN 1:100

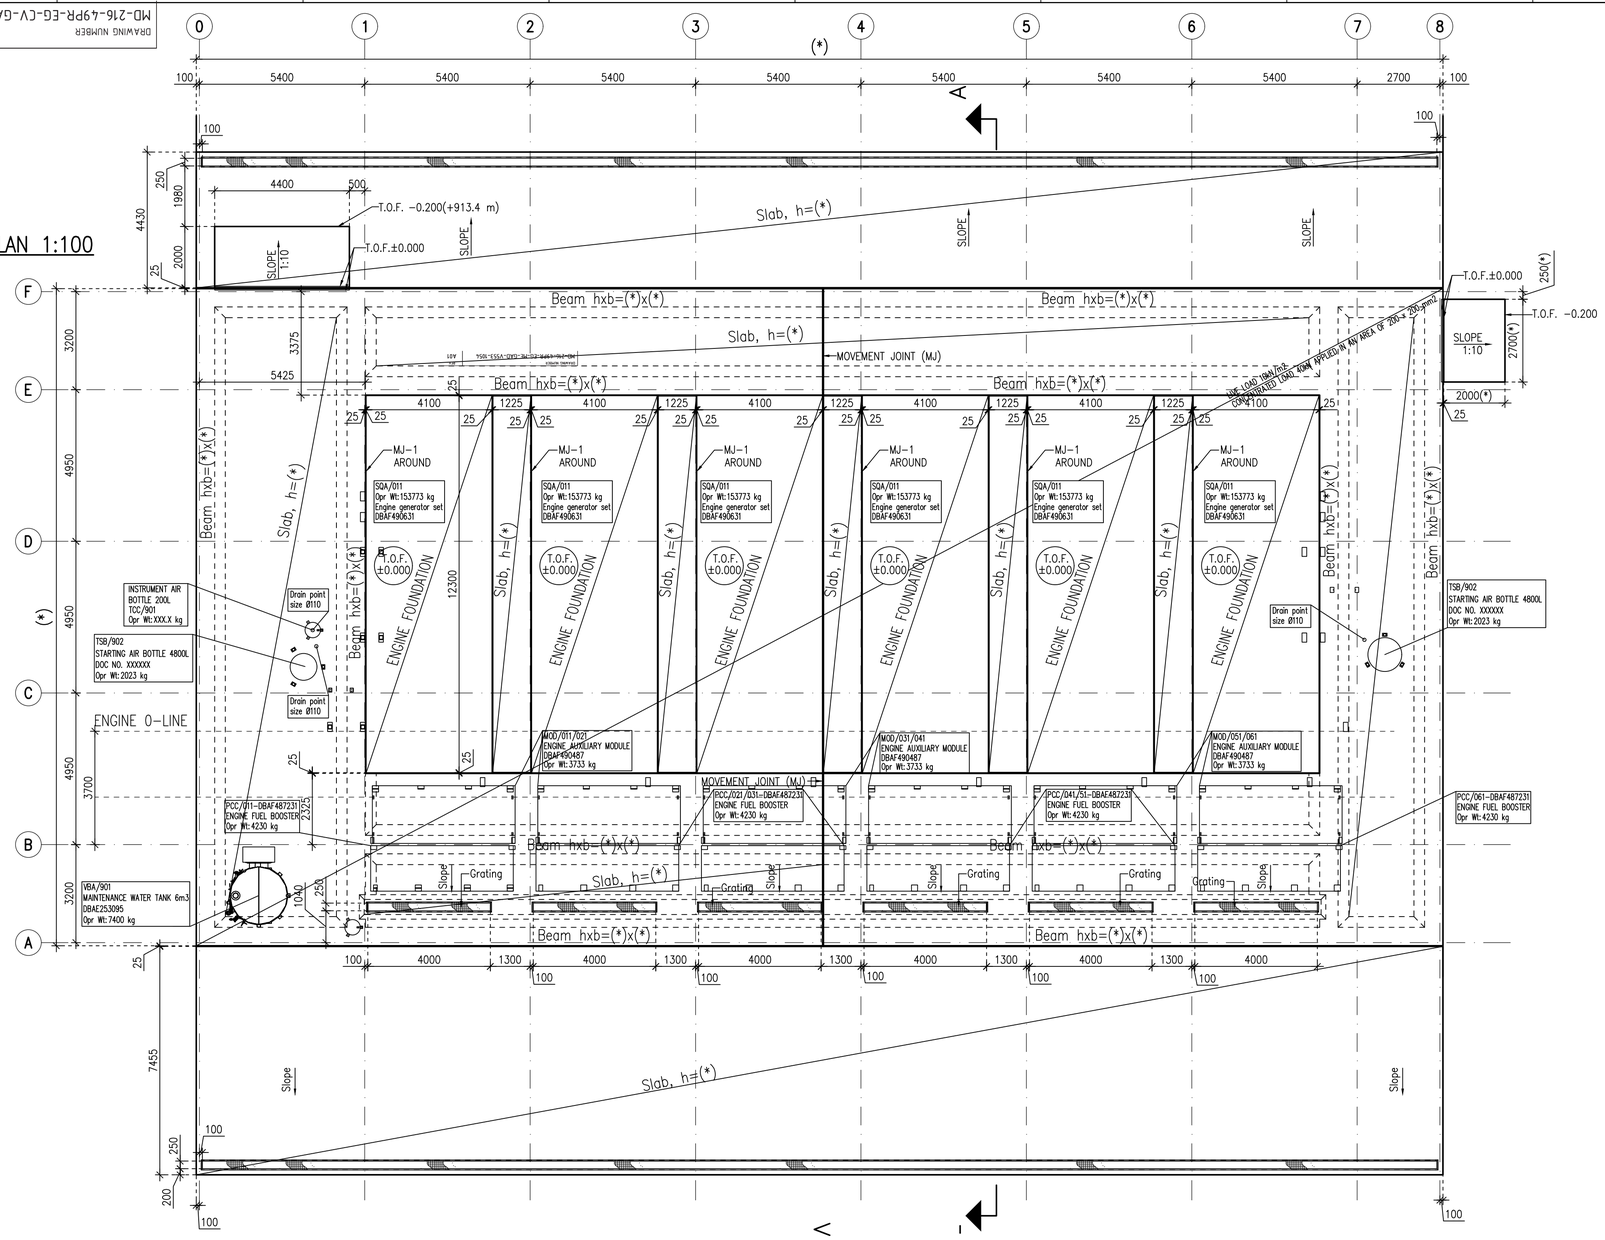


NOTE:
1) This drawing shall be mainly used for dimensional information purposes. Final construction drawing which concerns reinforcing and possible piling of the foundation to be done by the civil designer in accordance with the soil investigations at site. However below are given some points made by Wärtsilä.
2) Beam size and location according to final design
3) MJ location according to final design
4) Conduit locations according to Cable Conduit design.
5) Drain points according to Unit Location drawing
6) Location and size of the drain channels to be checked according to final design


NOTE! LOCATION AND TOP OF FOUNDATION LEVEL T.O.F. ACCORDING TO FOUNDATION LOCATION AND LOAD PLAN

* MARKED DIMENSIONS TO BE FINALISED AS PER FINAL DESIGN BY L&T

MJ-1 1:20

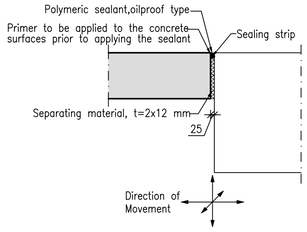

A-A 1:50

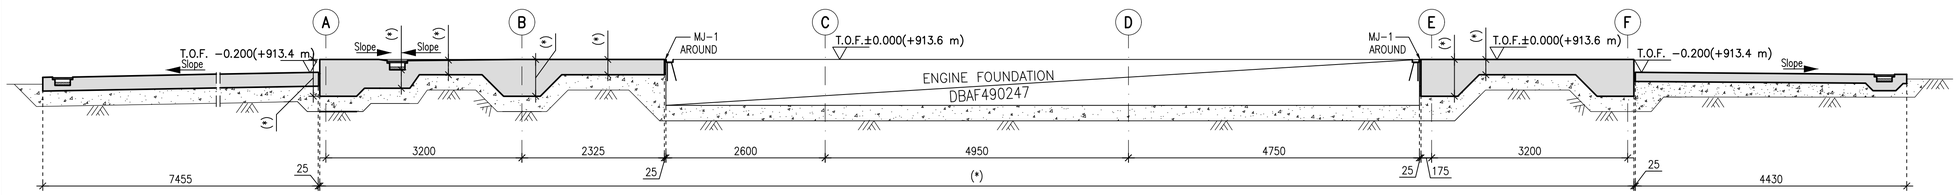

DOCUMENT NUMBER	REFERENCE DOCUMENTS	REV	DATE	REVISION DESCRIPTION	DRN	CHK	ENG	APP	EMP
		D01	17/05/2023	AS-BUILT	--	SJK	--	NBR	
		C01	20/06/2020	ISSUED FOR CONSTRUCTION. REVISED BASED ON EMPLYOER	--	SJK	--	NBR	
				COMMENTS DATED 10/06/2020					
		A01	20/05/2020	ISSUED FOR REFERENCE	--	SJK	--	NBR	

WÄRTSILÄ

© Wärtsilä Finland Oy Energy Business

LARSEN & TOUBRO

This drawing is the property of LARSEN & TOUBRO and must not be passed on to any person or body not authorized by us to receive it nor be copied or otherwise made use either in full or in part by such person or body without our prior permission in writing.

Outotec

The content of these documents are the sole property of Outotec Oyj. Any rights not expressly granted herein are reserved. Reproduction, transfer or distribution of part or all of the contents in any form without prior written permission of Outotec is prohibited.

MA'ADEN معادن
Saudi Arabian Mining Company شركة المعادن العربية السعودية

This document and the information contained herein is Ma'aden proprietary know-how. This document or any part thereof should not be reproduced, stored in a retrieval system or transmitted by any means, electronic or otherwise, or divulged without prior written permission of Ma'aden.

DRAWING NUMBER	DBAF490248	REVISION	a
DATE	23.Mar.2020	DATE	25.Mar.2020	DATE	26.Mar.2020
DRAWN	VTAX01	CHECKED	NCHX03	APPROVED	AKRX06

LARSEN & TOUBRO DRAWING NUMBER		REVISION 2
OUTOTEC DRAWING NUMBER	DOCUMENT ID	REVISION 2
900707_GAU01_WG01_MTL01_45068	OU100686669	

DRAWN	--	--
CHECKED	SJK	18/05/2020
ENGINEER	--	--
APPROVED	NBR	20/05/2020
EMPLOYER		
SCALE	1:50, 100	A1

MANSOURAH – MASSARAH GOLD PROJECT
GENERAL ARRANGEMENT DRAWING POWER GENERATION
ENGINE HALL FOUNDATIONS

DRAWING NUMBER MD-216-49PR-EG-CV-GAD-V553-1052 REV D01

This drawing is the property of Wärtsilä and shall neither be copied, shown nor communicated to a third party without the consent of the owner.

Confidential

MA'ADEN معادن
Saudi Arabian Mining Company شركة التعدين العربية السعودية

BECHTEL

Mansourah Massarah Gold Project
Comment Resolution Log Sheet / Compliance Report

Outotec

LARSEN & TOUBRO

PROJECT: **MANSOURAH MASSARAH GOLD PROJECT** **PROJECT NO.: 216**

STAGE: **4 - PROJECT EXECUTION.** **REVIEW LOG DOC. NO. & REV.:**

ACONEX REFERENCE NO. & DATE: MAADEN-STRAN-000241, 10 June 2020

STATUS CODE: A - APPROVED, C - APPROVED WITH COMMENTS, R - REVISE & RESUBMIT & O - OTHERS (INFORMATION, REFERENCE, REVIEWED)

DOCUMENT NUMBER	Area / Title	Comment No.	PMC COMMENT	Comment by	EPC Response	Status	Remarks
			DATE: 10 June 2020		DATE: 20 June 2020		
MD-216-49PR-EG-ME-GAD-V553-1052-A01	49PR	1	Discipline code to be changed to "CV".	Bechtel / Ma'aden	Updated in revised drawing.	Closed	
MD-216-49PR-EG-ME-GAD-V553-1052-A01	49PR	2	Document title-4 to be changed to "ENGINE HALL FOUNDATIONS".	Bechtel / Ma'aden	Updated in revised drawing.	Closed	