
DRAWING NUMBER MD-216-49PR-EG-CV-GAD-V553-1055 REV D01


PLAN 1:50

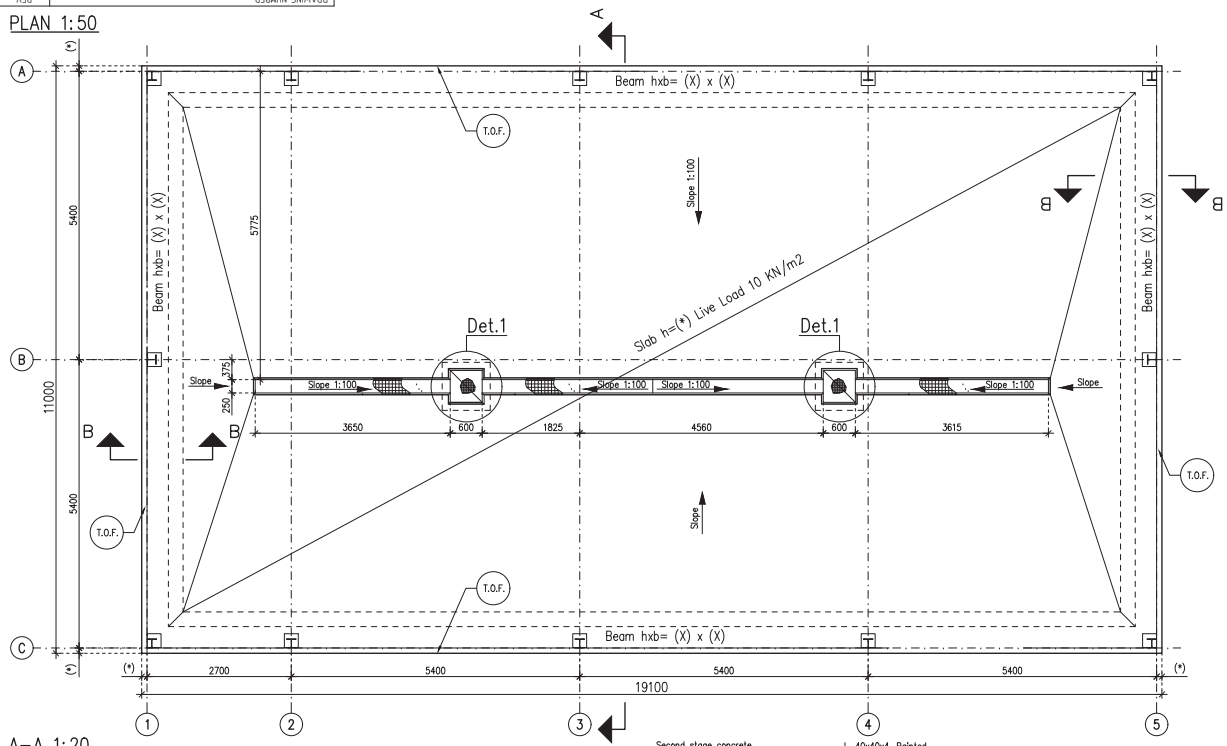


NOTE:
1) This drawing shall be mainly used for dimensional information purposes. Final construction drawing which concerns reinforcing and possible piling of the foundation to be done by the civil designer in accordance with the soil investigations at site. However below are given some points made by Wärtsilä.
2) Beam size and location according to final design
3) MJ location according to final design
4) Conduit locations according to Cable Conduit design.
5) Drain points according to Unit Location drawing
6) Location and size of the drain channels to be checked according to final design

NOTES:
1. LOCATION AND TOP OF FOUNDATION LEVEL T.O.F. ACCORDING TO FOUNDATION LOCATION DRAWING.
2. " * "FOUNDATION SIZE AND LOCATION ACCORDING TO FINAL DESIGN.


A–A 1:20

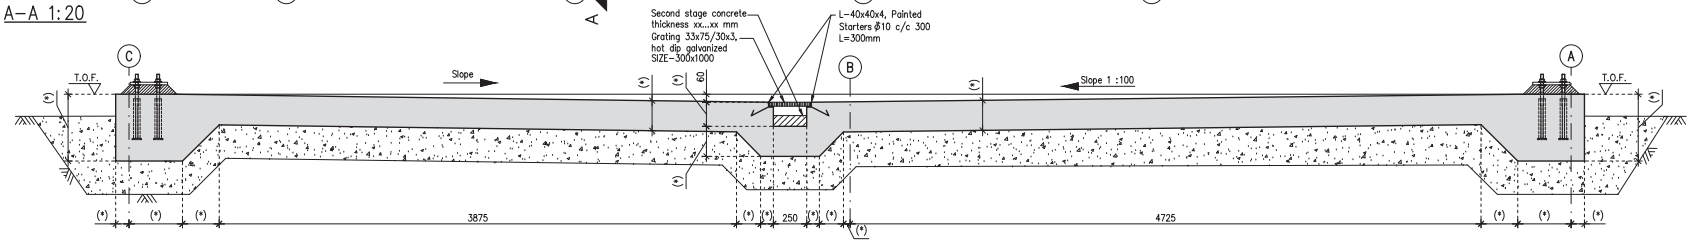


B–B 1:20

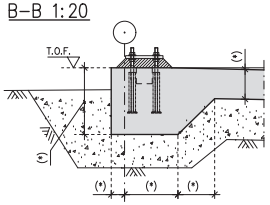


Det.1 1:20

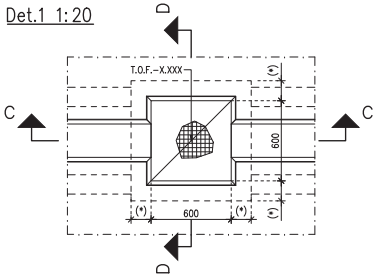

C–C 1:20

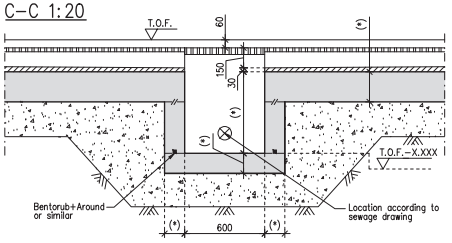

D–D 1:20

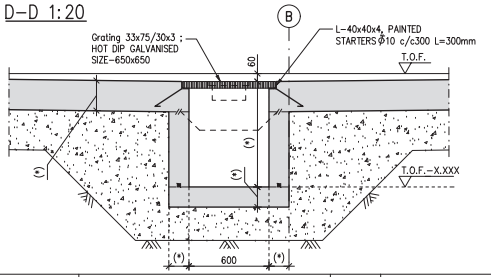

DOCUMENT NUMBER	REFERENCE DOCUMENTS	REV	DATE	REVISION DESCRIPTION	DRN	CHK	ENG	APP	EMP
		D01	17/05/2023	AS-BUILT					
		C01	04/07/2020	ISSUED FOR CONSTRUCTION	--	SJK	--	NBR	
		A01	20/05/2020	ISSUED FOR REFERENCE	--	SJK	--	NBR	

WÄRTSILÄ

© Wärtsilä Finland Oy Energy Business

DRAWING NUMBER DBAF507468 — REVISION XX

	DATE		DATE		DATE
DRAWN	14-Apr-2020	PMM	15-Apr-2020	APPROVED	15-Apr-2020
CHECKED					

LARSEN & TOUBRO DRAWING NUMBER 019045_008_M_V_12120_001 — REVISION 2

OUTOTEC DRAWING NUMBER 900707_GAU01_WG01_MTL01_45071 — DOCUMENT ID OU100686672 — REVISION 2

LARSEN & TOUBRO
This drawing is the property of LARSEN & TOUBRO and must not be passed on to any person or body not authorized by us to receive it nor be copied or otherwise made use either in full or in part by such person or body without our prior permission in writing.

Outotec
The content of these documents are the sole property of Outotec Oyj. Any rights not expressly granted herein are reserved. Reproduction, transfer or distribution of part or all of the contents in any form without prior written permission of Outotec is prohibited.

MA'ADEN
This document and the information contained herein is Ma'aden proprietary know-how. This document or any part thereof should not be reproduced, stored in a retrieval system or transmitted by any means, electronic or otherwise, or divulged without prior written permission of Ma'aden.

DRAWN	--	--
CHECKED	SJK	18/05/2020
ENGINEER	--	--
APPROVED	NBR	20/05/2020
EMPLOYER		
SCALE	1:50	A1

MANSOURAH – MASSARAH GOLD PROJECT
GENERAL ARRANGEMENT DRAWING
POWER GENERATION
FUEL TREATMENT HOUSE-FOUNDATION

DRAWING NUMBER MD-216-49PR-EG-CV-GAD-V553-1055 — REV D01