
DRAWING NUMBER
MD-216-49PR-EG-CV-LAD-V553-1011

REV
D01

Name	Description
OS	Oily water drainage pipe
— — — —	Pipe under floor level

Oily water drainage to be adjusted according to site conditions.

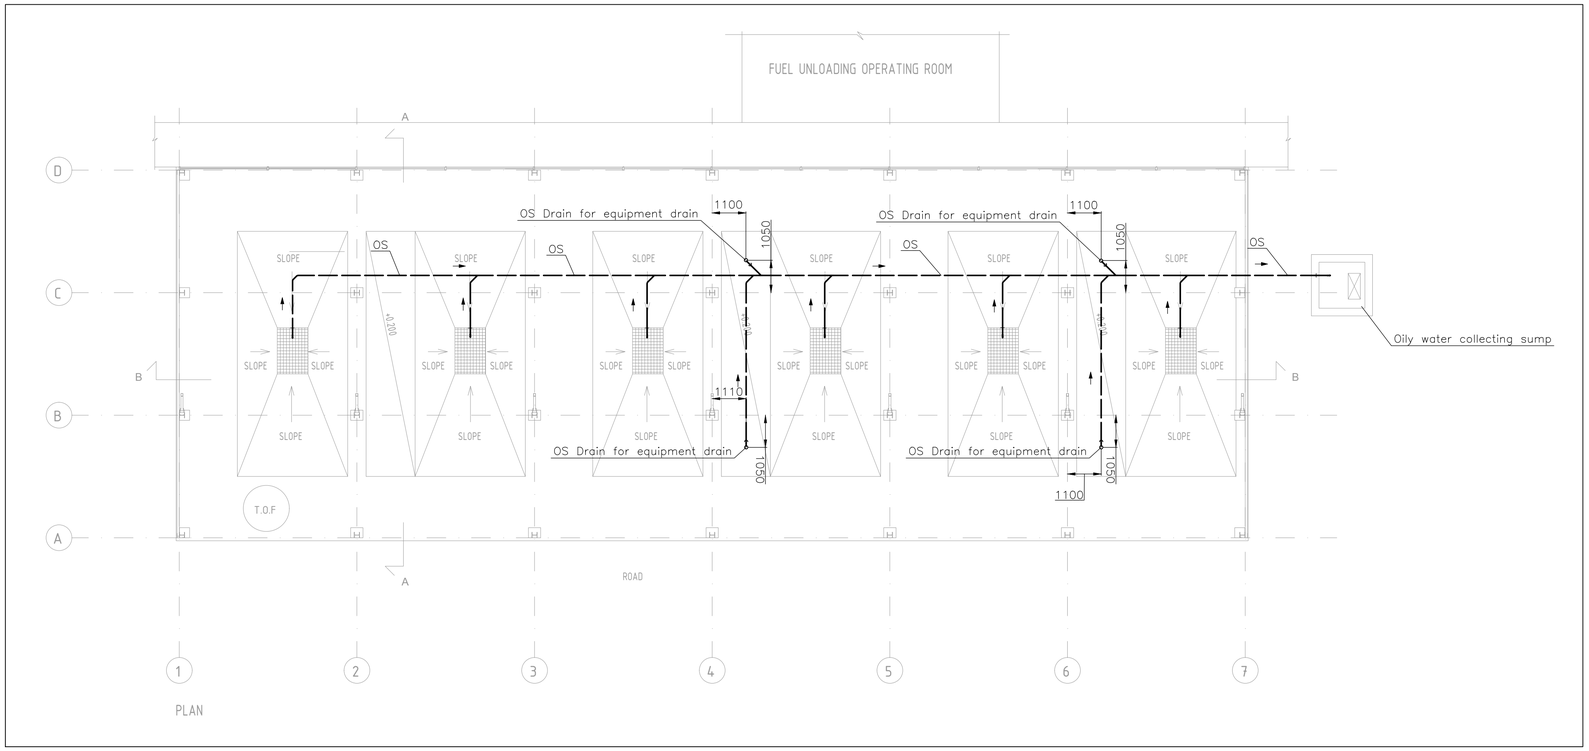

DOCUMENT NUMBER	REFERENCE DOCUMENTS	REV	DATE	REVISION DESCRIPTION	DRN	CHK	ENG	APP	EMP
		D01	23/12/2023	AS-BUILT	NAEW	SJK	--	NBR	
		C01	04/07/2020	ISSUED FOR CONSTRUCTION	--	SJK	--	NBR	
		A01	20/05/2020	ISSUED FOR REFERENCE	--	SJK	--	NBR	

WÄRTSILÄ

© Wärtsilä Finland Oy
Energy Business

LARSEN & TOUBRO

This drawing is the property of LARSEN & TOUBRO and must not be passed on to any person or body not authorized by us to receive it nor be copied or otherwise made use either in full or in part by such person or body without our prior permission in writing.

Outotec

The content of these documents are the sole property of Outotec Oyj. Any rights not expressly granted herein are reserved. Reproduction, transfer or distribution of part or all of the contents in any form without prior written permission of Outotec is prohibited.

MA'ADEN معادن
Saudi Arabian Mining Company شركة معادن العربية السعودية

This document and the information contained herein is Ma'aden proprietary know-how. This document or any part thereof should not be reproduced, stored in a retrieval system or transmitted by any means, electronic or otherwise, or divulged without prior written permission of Ma'aden.

DRAWN	--	--
CHECKED	SJK	18/05/2020
ENGINEER	--	--
APPROVED	NBR	20/05/2020
EMPLOYER		
SCALE	1:100	A1

DRAWING NUMBER	DBAF508453	REVISION -
DATE / DRAWN	29-Apr-2020 / rkax31	DATE / CHECKED 29-Apr-2020 / sojx01
DATE / APPROVED	30-Apr-2020 / akrx06	

LARSEN & TOUBRO DRAWING NUMBER	019045_008_M_V_12028_008	REVISION 2
OUTOTEC DRAWING NUMBER	900707_GAU01_WG01_EQS03_45004	DOCUMENT ID OU100686680 / REVISION 2

MANSOURAH – MASSARAH GOLD PROJECT
LAYOUT
POWER GENERATION
FUEL UNLOADING AREA-OILY WATER DRAINAGE

DRAWING NUMBER MD-216-49PR-EG-CV-LAD-V553-1011
REV D01