


DRAWING NUMBER: MD-216-39LA-EG-CV-DED-1450 | REV: D01

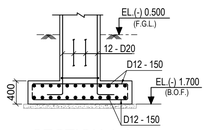


SECTION 1-1
(SCALE-1:50)

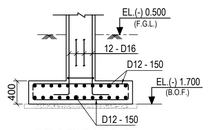


SECTION 2-2
(SCALE-1:50)

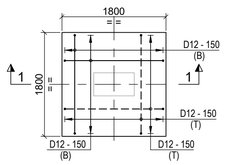


R.C DETAIL OF FOUNDATION - F1
(SCALE 1:50)

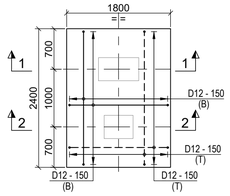


R.C DETAIL OF FOUNDATION - F2
(SCALE 1:50)

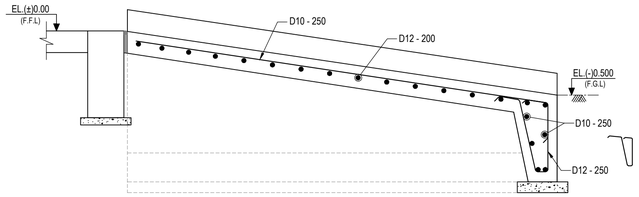


SECTION D-D
(REF. DRG. NO : MD-216-39LA-EG-CV-GAD-1450)
(SCALE 1:20)

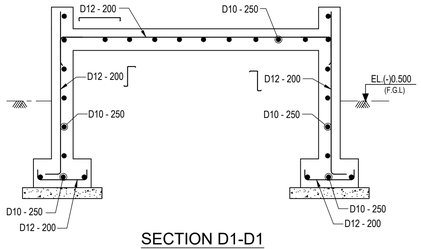


SECTION D1-D1
(REF. DRG. NO : MD-216-39LA-EG-CV-GAD-1450)
(SCALE 1:20)

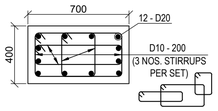


R.C DETAIL OF COLUMN MKD. - C1 & C2
(SCALE 1:20)

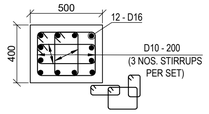


R.C DETAIL OF COLUMN MKD. - C3
(SCALE 1:20)

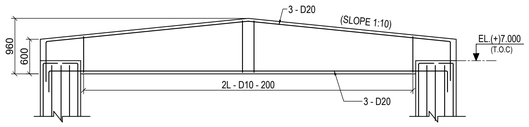


LONGITUDINAL VIEW OF BEAM MKD. -RB1
(SCALE 1:50)

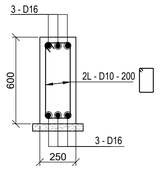


R.C DETAIL OF BEAM MKD. - GB1
(SCALE 1:20)

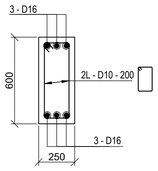


R.C DETAIL OF BEAM MKD. - LB1
(SCALE 1:20)

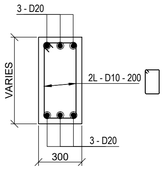


R.C DETAIL OF BEAM MKD. - RB1
(SCALE 1:20)

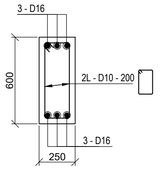


R.C DETAIL OF BEAM MKD. - RB2
(SCALE 1:20)

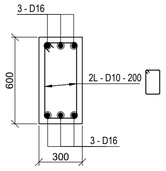


R.C DETAIL OF BEAM MKD. - RB2A
(SCALE 1:20)

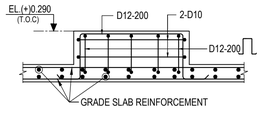


RC DETAILS OF PEDESTAL MKD. P1 & P2
(SCALE 1:25)

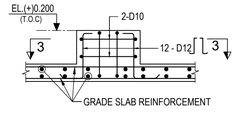


RC DETAILS OF PEDESTAL MKD. P3
(SCALE 1:25)

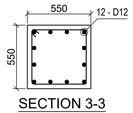


SECTION 3-3
(SCALE 1:25)

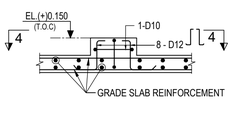

RC DETAILS OF PEDESTAL MKD. P4
(SCALE 1:25)

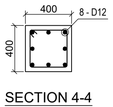

SECTION 4-4
(SCALE 1:25)

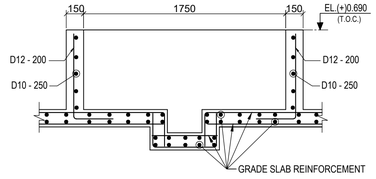

SECTION : A-A
(REF. DRG. NO : MD-216-39LA-EG-CV-GAD-1450)
SCALE 1:25

LEGEND :-

RL. - REDUCED LEVEL
EL. - ELEVATION LEVEL
T.O.C. - TOP OF CONCRETE.
F.F.L. - FINISHED FLOOR LEVEL.
F.G.L. - FINISHED GROUND LEVEL.
B.O.F. - BOTTOM OF FOUNDATION
TYP. - TYPICAL.
MKD. - MARKED.
REF. - REFER.
DRG. - DRAWING.
BOTTOM REINFORCEMENT (B) - ———
TOP REINFORCEMENT (T) - – – – – –
RC. - REINFORCED CONCRETE
GA - GENERAL ARRANGEMENT

NOTES:-

1. ALL DIMENSIONS ARE IN MILLIMETRES AND LEVELS AND CO-ORDINATES ARE IN METRES. UNLESS OTHERWISE STATED.
2. EL.(±)0.00 CORRESPONDS TO FINISHED FLOOR LEVEL RL(+)913.350 LEVEL.
3. GRADE OF CONCRETE SHALL BE C35.
4. GRADE OF REINFORCEMENT SHALL BE DEFORMED BAR ASTM A615 - GRADE 60 (fy = 420 MPa).
5. CLEAR COVER TO MAIN REINFORCEMENT SHALL BE AS FOLLOWS:
   a) FOUNDATION : 50 mm.
   b) COLUMN : 50 mm.
   c) BEAM : 50 mm.
   c) WALL : 50 mm.
6. REINFORCEMENT MAY BE SLIGHTLY ADJUSTED AT SITE TO ACCOMMODATE EMBEDDED PARTS.
7. FOR GA DRAWING REF. DRG. NO. MD-216-39LA-EG-CV-GAD-1450.
8. FOR GENERAL NOTE FOR CIVIL WORK REF. DRG. NO : MD-216-1000-EG-CV-DED-1001.
9. FOR STANDARD REINFORCEMENT DETAIL REFER DRG. NO : MD-216-1000-EG-CV-DED-1005.
10. FOR GRADE SLAB RC DETAIL REF. DRG. NO : MD-216-1000-EG-CV-DED-1002.

DOCUMENT NUMBER	REFERENCE DOCUMENTS	REV	DATE	REVISION DESCRIPTION	DRN	CHK	ENG	APP	EMP
		D01	10-03-2023	AS-BUILT	AMT	BDA	SML	AG	
		C04	18/03/2021	ISSUED FOR CONSTRUCTION & REVISED AS MKD. C04	AMT	BDA	SML	AG	
		C03	17/02/2021	ISSUED FOR CONSTRUCTION & REVISED AS MKD. C03	AMT	BDA	SML	AG	
		C02	15/01/2021	ISSUED FOR CONSTRUCTION & REVISED AS MKD. C02	AMT	BDA	SML	AG	
		C01	28/11/2020	ISSUED FOR CONSTRUCTION & REVISED AS MKD. C01	AMT	BDA	SML	AG	
MD-216-39WL-EG-FG-LAD-V513-2009	PROCESS PLANT- FIRE PUMP HOUSE	A01	20/10/2020	ISSUED FOR REFERENCE	AMT	BDA	SML	AG	

RESERVED FOR VENDOR LOGO AND DRAWING NUMBER

LARSEN & TOUBRO

This drawing is the property of LARSEN & TOUBRO and must not be passed on to any person or body not authorized by us to receive it nor be copied or otherwise made use either in full or in part by such person or body without our prior permission in writing.

Outotec

The content of these documents are the sole property of Outotec Oyj. Any rights not expressly granted herein are reserved. Reproduction, transfer or distribution of part or all of the contents in any form without prior written permission of Outotec is prohibited.

MA'ADEN معادن
Saudi Arabian Mining Company شركة معادن العربية السعودية

This document and the information contained herein is Ma'aden proprietary know-how. This document or any part thereof should not be reproduced, stored in a retrieval system or transmitted by any means, electronic or otherwise, or divulged without prior written permission of Ma'aden.

LARSEN & TOUBRO DRAWING NUMBER: 019045_080_C_D_24494_001 | REVISION: 5
OUTOTEC DRAWING NUMBER: 900707 _GAU01 _AE01 _CTB17 _39101 | DOCUMENT ID: 0U100704150 | REVISION: 5

DRAWN	AMT	17/10/2020
CHECKED	BDA	19/10/2020
ENGINEER	SML	17/10/2020
APPROVED	AG	20/10/2020
EMPLOYER		
SCALE	1:50 1:25 1:20	A1

MANSOURAH - MASSARAH GOLD PROJECT
DETAIL DRAWING
FIRE WATER PUMP HOUSE
RC DETAILS

DRAWING NUMBER: MD-216-39LA-EG-CV-DED-1450 | REV: D01