


DRAWING NUMBER: MD-216-39LA-EG-CV-GAD-1450 | REV: D01

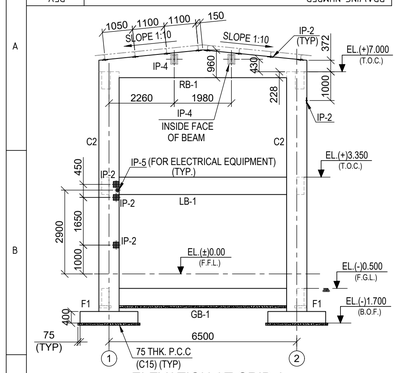


ELEVATION AT GRID A
SCALE 1:100

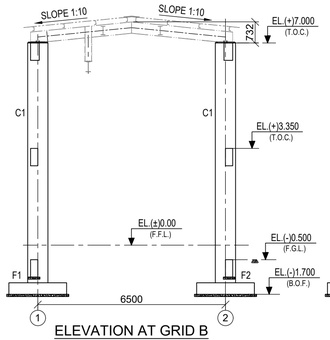


ELEVATION AT GRID B
SCALE 1:100

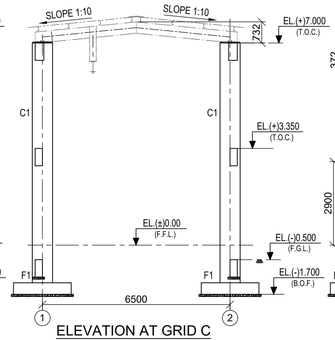


ELEVATION AT GRID C
SCALE 1:100

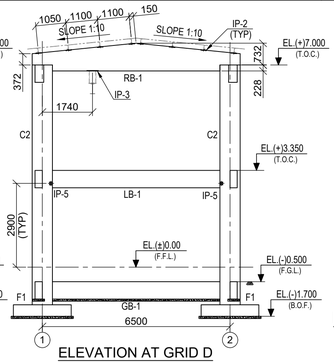


ELEVATION AT GRID D
SCALE 1:100

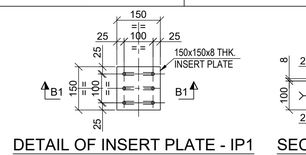


DETAIL OF INSERT PLATE - IP1
(SCALE 1:10)

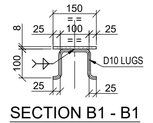


SECTION B1 - B1
(SCALE 1:10)

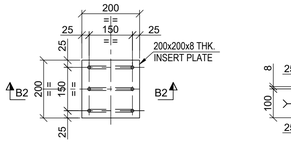


DETAIL OF INSERT PLATE - IP2
(SCALE 1:10)

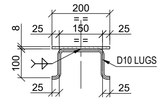


SECTION B2 - B2
(SCALE 1:10)

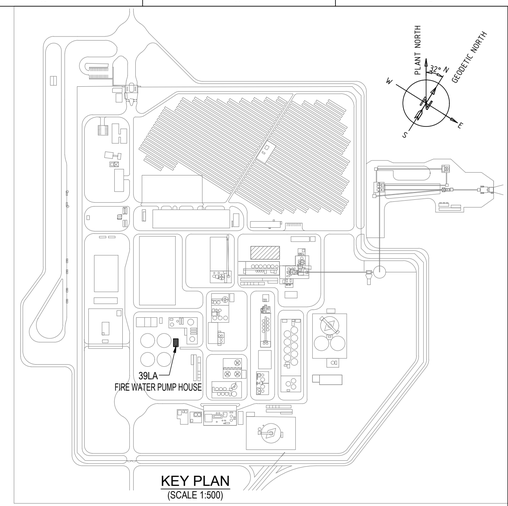


KEY PLAN
(SCALE 1:500)

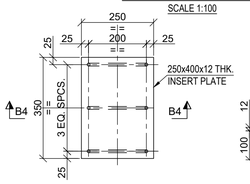


DETAIL OF INSERT PLATE - IP4
(SCALE 1:10)

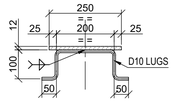


SECTION B4 - B4
(SCALE 1:10)

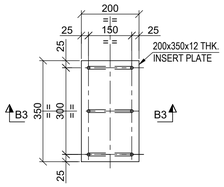

DETAIL OF INSERT PLATE - IP3
(SCALE 1:10)

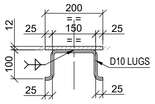


SECTION B3 - B3
(SCALE 1:10)

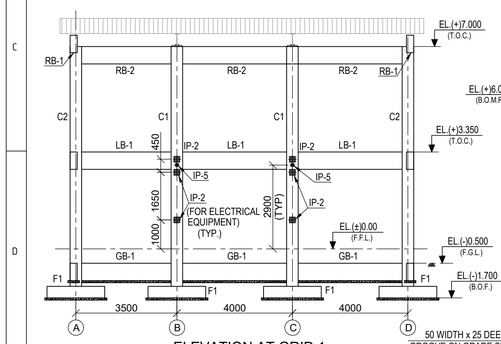

ELEVATION AT GRID 1
SCALE 1:100


ELEVATION AT GRID 2
SCALE 1:100

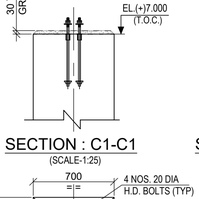


SECTION : C1-C1
(SCALE-1:25)

SECTION : C2-C2
(SCALE-1:25)

SECTION : C3-C3
(SCALE-1:25)

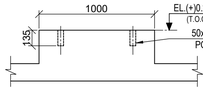


DETAILS OF PEDESTAL
(MKD. P1 & P2)
SCALE 1:25

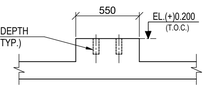

DETAILS OF PEDESTAL
(MKD. P3)
SCALE 1:25


DETAILS OF PEDESTAL
(MKD. P4)
SCALE 1:25

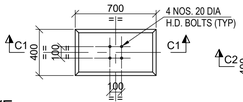


DETAIL OF COLUMN MKD. - C1
(SCALE-1:25)

DETAIL OF COLUMN MKD. - C2
(SCALE-1:25)


DETAIL OF COLUMN MKD. - C3
(SCALE-1:25)

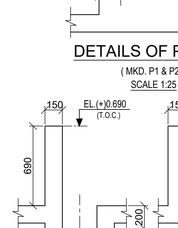


SECTION : A1-A1
SCALE 1:25

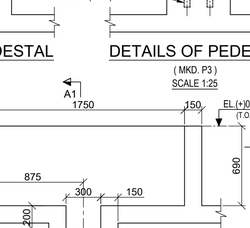


SECTION : A-A
SCALE 1:25

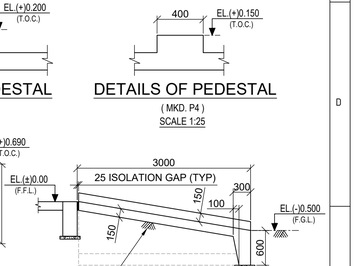


SECTION : D-D
SCALE 1:50

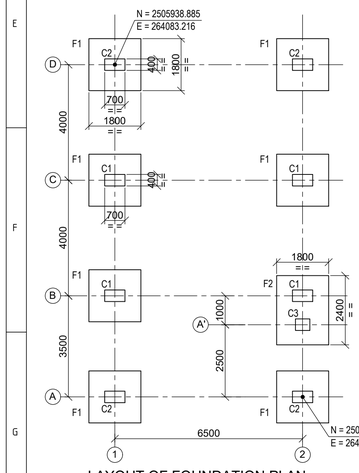


LAYOUT OF FOUNDATION PLAN
AT LEVEL EL. (-)1.700 (B.O.F)
SCALE 1:100

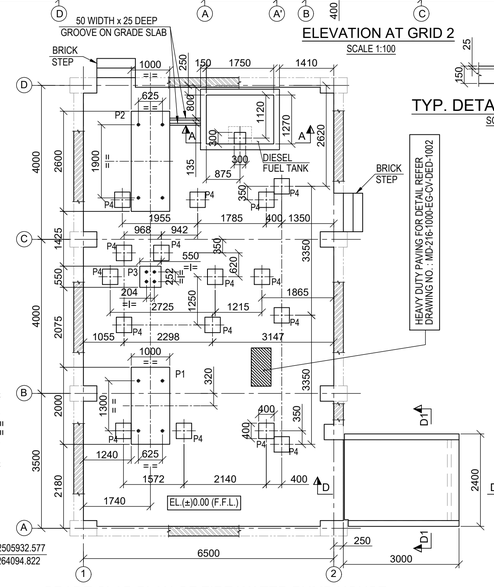


GRADE SLAB PLAN OF FIRE WATER PUMP HOUSE
SCALE 1:75

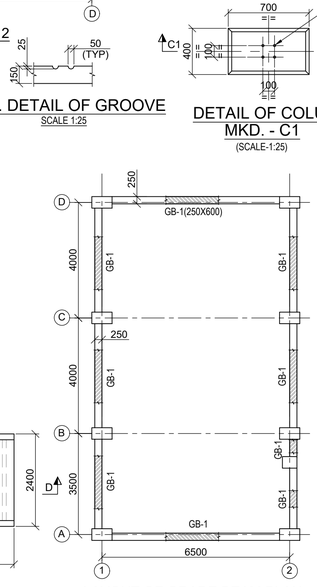


LAYOUT OF GRADE BEAM PLAN
AT LEVEL EL. (-)0.500 (F.G.L)
SCALE 1:100

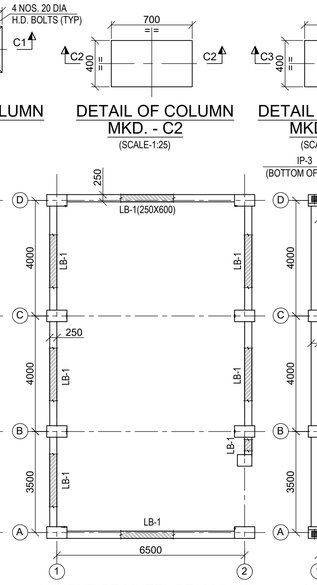


LAYOUT OF LINTEL BEAM PLAN
AT LEVEL EL. (+)3.350 (T.O.C)
SCALE 1:100

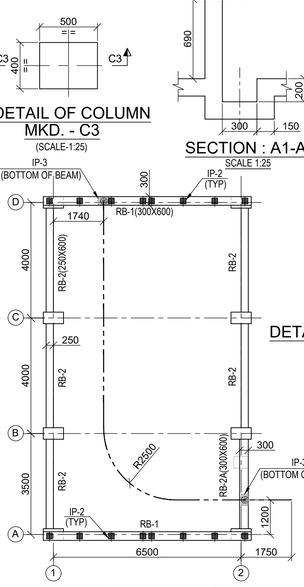

LAYOUT OF ROOF BEAM PLAN
AT LEVEL EL. (+)7.000 (T.O.C)
SCALE 1:100

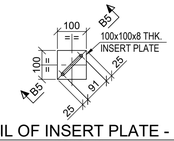

DETAIL OF INSERT PLATE - IP5
(SCALE 1:10)

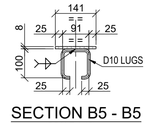

SECTION B5 - B5
(SCALE 1:10)

LEGEND :-

R.L. - REDUCED LEVEL
EL. - ELEVATION LEVEL
T.O.C. - TOP OF CONCRETE.
B.O.F. - BOTTOM OF FOOTING.
F.G.L. - FINISHED GROUND LEVEL.
F.F.L. - FINISHED FLOOR LEVEL.
TYP. - TYPICAL.
P.C.C - PLAIN CEMENT CONCRETE
MKD. - MARKED.
THK. - THICK
HP. - HIGHEST POINT
LP. - LOWEST POINT
℄ - CENTRE LINE
REF. - REFER.
DRG. - DRAWING.
Ø - DIAMETER
B.O.M.R. - BOTTOM OF MONORAIL
DIA - DIAMETER

NOTES:-

1. ALL DIMENSIONS ARE IN MILLIMETRES AND LEVELS ARE IN METRES UNLESS OTHERWISE STATED.
2. EL.(±)0.00 CORRESPONDS TO FINISHED FLOOR LEVEL RL(+)913.350 LEVEL.
3. GRADE OF CONCRETE SHALL BE C35 UNLESS NOTED OTHERWISE.
4. GRADE OF REINFORCEMENT SHALL BE DEFORMED BAR ASTM A615-GRADE 60 (fy=420 MPa)
5. IF ANY PART OF FOUNDATION COMES ON BACKFILL ZONE OF ADJACENT FOUNDATION OR ANY LOOSE POCKETS ARE ENCOUNTERED BELOW FOUNDATION LEVEL THE SAME SHALL BE REMOVED AND FILLED WITH PCC.
6. FOR REINFORCEMENTS DETAIL REF. DRG. NO. MD - 216 - 39LA - EG - CV - DED - 1450.
7. FOR STANDARD DETAILS FOR PAVING REF. DRG. NO : MD-216-1000-EG-CV-DED-1002.
8. FOR FOUNDATION BOLT DETAILS REF. DRG. NO : MD-216-1000-EG-CV-DED-1003.
9. FOR GENERAL NOTE FOR CIVIL WORK REF. DRG. NO : MD-216-1000-EG-CV-DED-1001.
10. FOR GRADE SLAB DETAIL REF. DRG. NO : MD-216-1000-EG-CV-DED-1002.
11. FOR POCKET DETAIL REF. DRG. NO : MD-216-39WL-EG-FG-GAD-V513-2001.

DOCUMENT NUMBER	REFERENCE DOCUMENTS	REV	DATE	REVISION DESCRIPTION	DRN	CHK	ENG	APP	EMP
		D01	10-03-2023	AS-BUILT	AMT	BDA	SML	AG	
		C05	18/03/2021	ISSUED FOR CONSTRUCTION & REVISED AS MKD. C05	AMT	BDA	SML	AG	
		C04	17/02/2021	ISSUED FOR CONSTRUCTION & REVISED AS MKD. C04	AMT	BDA	SML	AG	
		C03	14/01/2021	ISSUED FOR CONSTRUCTION & REVISED AS MKD. C03	AMT	BDA	SML	AG	
		C02	09/12/2020	ISSUED FOR CONSTRUCTION & REVISED AS MKD. C02	AMT	BDA	SML	AG	
		C01	28/11/2020	ISSUED FOR CONSTRUCTION & REVISED AS MKD. C01	AMT	BDA	SML	AG	
MD-216-39WL-EG-FG-LAD-V513-2009	PROCESS PLANT- FIRE PUMP HOUSE	A01	20/10/2020	ISSUED FOR REFERENCE	AMT	BDA	SML	AG	

RESERVED FOR VENDOR LOGO AND DRAWING NUMBER

LARSEN & TOUBRO DRAWING NUMBER: 019045_080_C_G_24493_001 | REVISION: 6
OUTOTEC DRAWING NUMBER: 900707__GAU01__AE01__MTL01__39121 | DOCUMENT ID: OU100704148 | REVISION: 6

LARSEN & TOUBRO
This drawing is the property of LARSEN & TOUBRO and must not be passed on to any person or body not authorized by us to receive it nor be copied or otherwise made use either in full or in part by such person or body without our prior permission in writing.

Outotec
The content of these documents are the sole property of Outotec Oyj. Any rights not expressly granted herein are reserved. Reproduction, transfer or distribution of part or all of the contents in any form without prior written permission of Outotec is prohibited.

MA'ADEN معادن
Saudi Arabian Mining Company شركة معادن العربية السعودية
This document and the information contained herein is Ma'aden proprietary know-how. This document or any part thereof should not be reproduced, stored in a retrieval system or transmitted by any means, electronic or otherwise, or divulged without prior written permission of Ma'aden.

DRAWN	AMT	18/10/2020	MANSOURAH - MASSARAH GOLD PROJECT
CHECKED	BDA	19/10/2020	GENERAL ARRANGEMENT
ENGINEER	SML	18/10/2020	FIRE WATER PUMP HOUSE
APPROVED	AG	20/10/2020	PLAN & SECTIONS
EMPLOYER			
SCALE 1:100,1:50,1:20	A1		DRAWING NUMBER: MD - 216 - 39LA - EG - CV - GAD - 1450 | REV: D01