


DRAWING NUMBER: MD-216-3000-EG-CV-DED-1014 | REV: D01

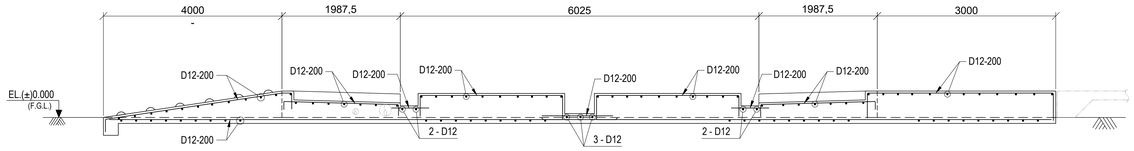


SECTION : B-B
(RC. DETAIL)
SCALE 1:50

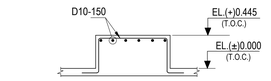


TYP. RC. DETAIL OF PLATFORMS
(FOR ELECTRICAL PANEL & MANUAL WASHING)
SCALE 1:40

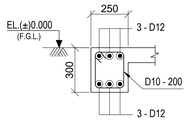


RC. DET. OF B1
SCALE 1:20

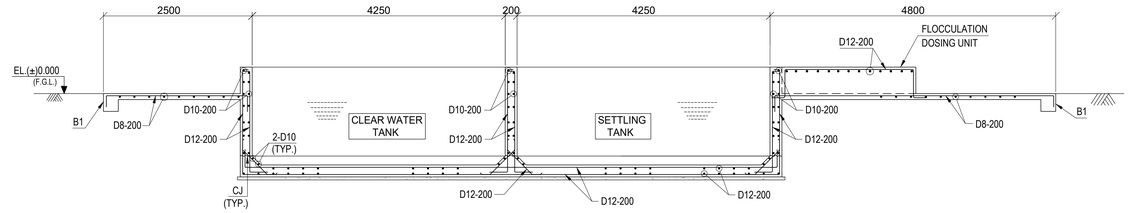


SECTION : C-C
(RC. DETAIL)
SCALE 1:50

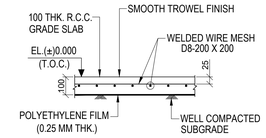


TYP. R.C. DETAIL OF 100 THK. GRADE SLAB
SCALE 1:25

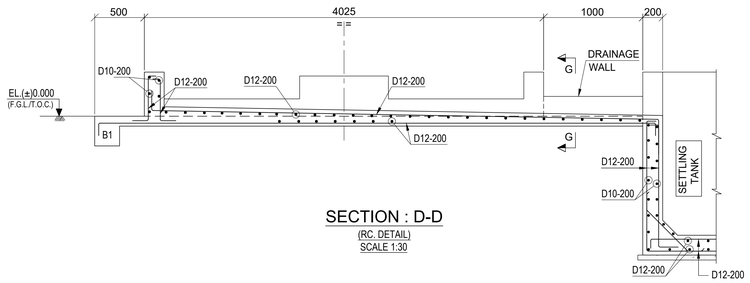


SECTION : D-D
(RC. DETAIL)
SCALE 1:30

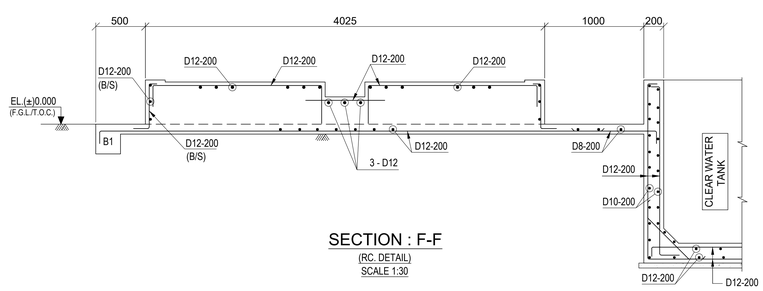

SECTION : F-F
(RC. DETAIL)
SCALE 1:30

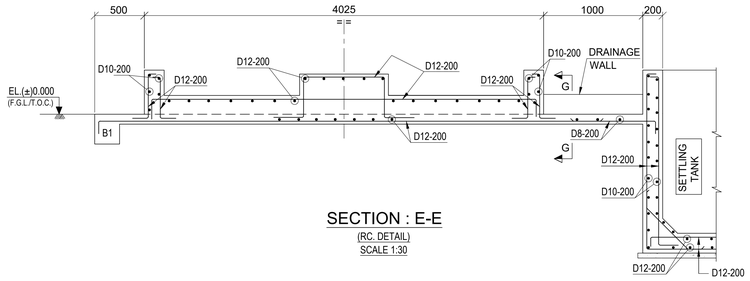

SECTION : E-E
(RC. DETAIL)
SCALE 1:30

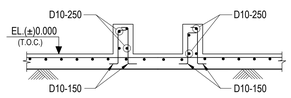

SECTION : G-G
(R.C DETAIL)
SCALE 1:30

LEGEND :-
RL. - REDUCED LEVEL
EL. - ELEVATION
℄ - CENTRE LINE
I.L - INVERT LEVEL
F.G.L - FINISHED GROUND LEVEL
T.O.C. - TOP OF CONCRETE
T.O.R. - TOP OF ROAD
P.C.C - PLAIN CEMENT CONCRETE
THK. - THICKNESS
DIA. - DIAMETRE
CJ - CONSTRUCTION JOINT
RC. - REINFORCED CONCRETE
TYP. - TYPICAL
R.C.C. - REINFORCED CEMENT CONCRETE

NOTES:-
1. ALL DIMENSIONS ARE IN MILLIMETRES AND LEVELS AND CO-ORDINATES ARE IN METRES UNLESS OTHERWISE STATED.
2. GRADE OF CONCRETE SHALL BE C35 (35MPa) FOR GRADE SLAB & C15 (15MPa) FOR BLINDING CONCRETE.
3. GRADE OF REINFORCEMENT SHALL BE DEFORMED BAR 420 MPa (GRADE 60) - ASTM A615/A615M.
4. FOR STANDARD REINFORCEMENT DETAIL & GENERAL NOTES FOR CIVIL WORKS REFER DRAWING NO. MD-216-1000-EG-CV-DED-1005 & 1001.
5. FOR DETAILS OF SLAB RE-ENTRANT RE-BARS REFER DRAWING NO. MD-101-MD-101-SMEM-EG-ST-DST-0007.

THIS DRAWING SHOULD BE READ IN CONJUNCTION WITH DRAWING NO. MD-216-3000-EG-CV-GAD-1687.

DOCUMENT NUMBER	REFERENCE DOCUMENTS	REV	DATE	REVISION DESCRIPTION	DRN	CHK	ENG	APP	EMP
MD-216-3000-EG-CV-GAD-1687	TYRE WASHING STATION	D01	21/02/2023	AS-BUILT	ABS	SJM	AVG	AG	
MD-216-1000-EG-ST-CRT-1001	CIVIL, STRUCTURAL & ARCHITECTURAL - DESIGN CRITERIA	C01	23/03/2022	ISSUED FOR CONSTRUCTION & REVISED AS MARKED C01	ABS	SJM	AVG	AG	
MD-216-3000-EG-ME-GAD-V560-1001	GA, CROSS SECTION OF CAR WASHING STATION	A01	23/02/2022	ISSUED FOR APPROVAL	ABS	SJM	AVG	AG	

RESERVED FOR VENDOR LOGO AND DRAWING NUMBER

LARSEN & TOUBRO DRAWING NUMBER: 019045_501_C_D_24707_001 | REVISION: 2
OUTOTEC DRAWING NUMBER: 900707__GAU01__ZZ01__CTB17__30005 | DOCUMENT ID: OU100742123 | REVISION: 2

LARSEN & TOUBRO

This drawing is the property of *LARSEN & TOUBRO* and must not be passed on to any person or body not authorized by us to receive it nor be copied or otherwise made use either in full or in part by such person or body without our prior permission in writing.

Outotec

The content of these documents are the sole property of Outotec Oyj. Any rights not expressly granted herein are reserved. Reproduction, transfer or distribution of part or all of the contents in any form without prior written permission of Outotec is prohibited.

MA'ADEN معادن
Saudi Arabian Mining Company شركة معادن العربية السعودية

This document and the information contained herein is Ma'aden proprietary know-how. This document or any part thereof should not be reproduced, stored in a retrieval system or transmitted by any means, electronic or otherwise, or divulged without prior written permission of Ma'aden.

DRAWN	ABS	15/02/2022
CHECKED	SJM	17/02/2022
ENGINEER	AVG	15/02/2022
APPROVED	AG	23/02/2022
EMPLOYER		
SCALE	1:50, 1:20	A1

MANSOURAH - MASSARAH GOLD PROJECT
DETAIL DRAWING
TYRE WASHING STATION
REINFORCEMENT DETAILS OF FOUNDATION

DRAWING NUMBER: MD-216-3000-EG-CV-DED-1014 | REV: D01