


DRAWING NUMBER: MD-216-3000-EG-CV-DED-1015 | REV: D01

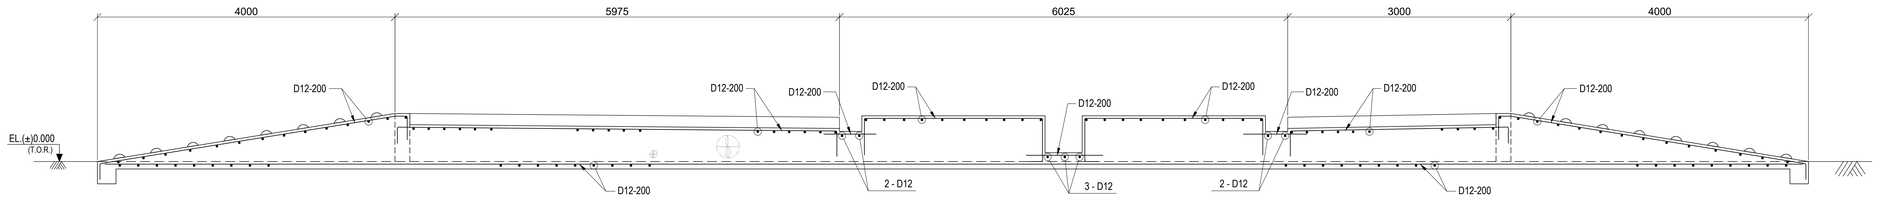


SECTION : B-B
(RC. DETAIL)
SCALE 1:30

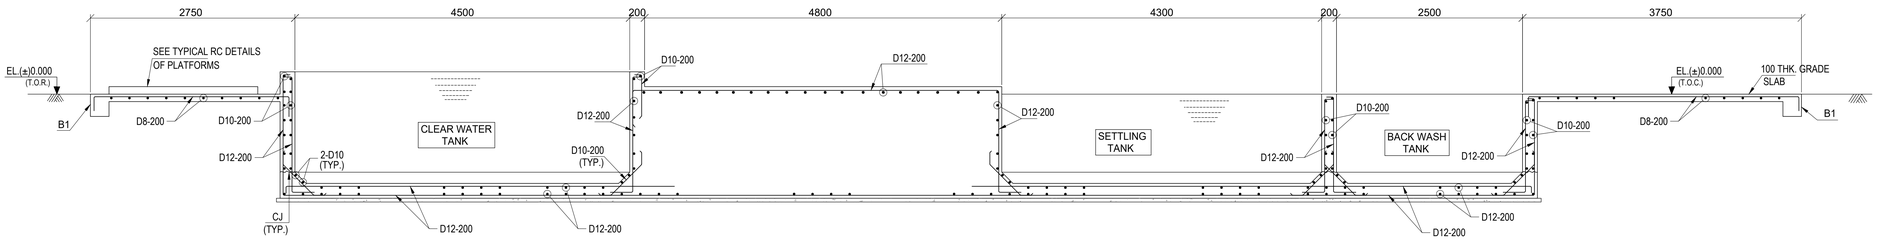


SECTION : C-C
(RC. DETAIL)
SCALE 1:30

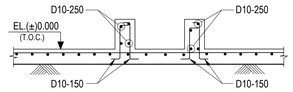


SECTION : G-G
(R.C DETAIL)
SCALE 1:30

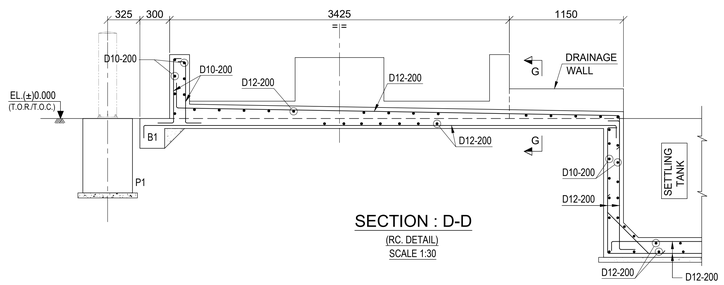


SECTION : D-D
(RC. DETAIL)
SCALE 1:30

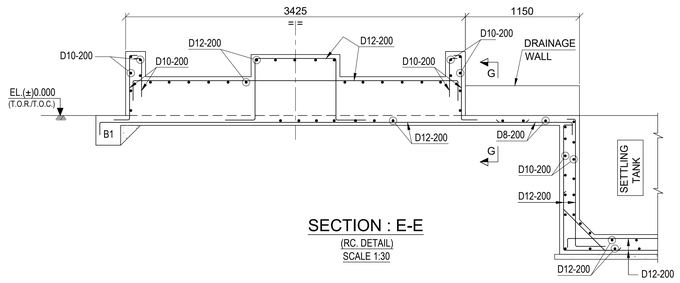


SECTION : E-E
(RC. DETAIL)
SCALE 1:30

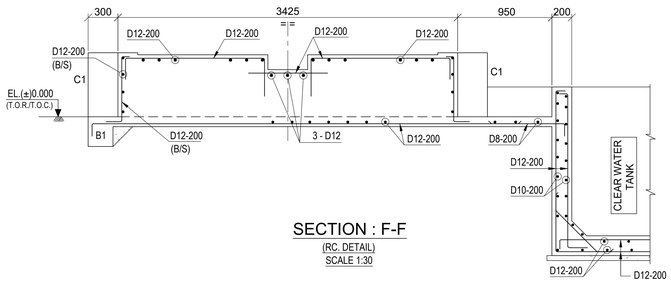


SECTION : F-F
(RC. DETAIL)
SCALE 1:30

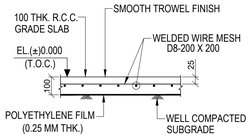


TYP. R.C. DETAIL OF 100 THK. GRADE SLAB
SCALE 1:25

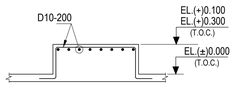


TYP. RC. DETAIL OF PLATFORMS
SCALE 1:40

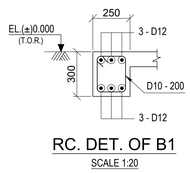

RC. DET. OF B1
SCALE 1:20

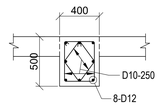

RC. DETAIL OF C1
SCALE 1:30

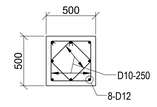

RC. DETAIL OF P1
DETAIL OF BOLLARD FOUNDATION
SCALE 1:30

THIS DRAWING SHOULD BE READ IN CONJUNCTION WITH DRAWING NO. MD-216-3000-EG-CV-GAD-1688.

LEGEND :-
RL. - REDUCED LEVEL
EL. - ELEVATION
℄ - CENTRE LINE
I.L - INVERT LEVEL
F.G.L - FINISHED GROUND LEVEL
T.O.C. - TOP OF CONCRETE
T.O.R. - TOP OF ROAD
P.C.C - PLAIN CEMENT CONCRETE
THK. - THICK
DIA. - DIAMETER
CJ - CONSTRUCTION JOINT
TYP. - TYPICAL
R.C. - REINFORCED CONCRETE

NOTES:-
1. ALL DIMENSIONS ARE IN MILLIMETRES AND LEVELS AND CO-ORDINATES ARE IN METRES UNLESS OTHERWISE STATED.
2. GRADE OF CONCRETE SHALL BE C35 (35MPa) & C15 (15MPa) FOR BLINDING CONCRETE.
3. GRADE OF REINFORCEMENT SHALL BE DEFORMED BAR 420 MPa (GRADE 60) - ASTM A615/A615M.
4. FOR STANDARD REINFORCEMENT DETAIL & GENERAL NOTES FOR CIVIL WORKS REFER DRAWING NO. MD-216-1000-EG-CV-DED-1005 & 1001.
5. FOR DETAILS OF SLAB RE-ENTRANT RE-BARS REFER DRAWING NO. MD-101-MD-101-SMEM-EG-ST-DST-007.

DOCUMENT NUMBER	REFERENCE DOCUMENTS	REV	DATE	REVISION DESCRIPTION	DRN	CHK	ENG	APP	EMP
MD-216-3000-EG-CV-GAD-1688	CAR WASHING STATION PLAN, SECTIONS & DETAILS	D01	21/02/2023	AS-BUILT	ABS	SJM	AVG	AG	
MD-216-1000-EG-ST-CRT-1001	CIVIL, STRUCTURAL & ARCHITECTURAL - DESIGN CRITERIA	C01	23/03/2022	ISSUED FOR CONSTRUCTION & REVISED AS MARKED_C01	ABS	SJM	AVG	AG	
MD-216-3000-EG-ME-GAD-V560-1001	GA, CROSS SECTION OF CAR WASHING STATION	A01	19/02/2022	ISSUED FOR APPROVAL	ABS	SJM	AVG	AG	

RESERVED FOR VENDOR LOGO AND DRAWING NUMBER

LARSEN & TOUBRO DRAWING NUMBER: 019045_501_C_D_24709_001 | REVISION: 2
OUTOTEC DRAWING NUMBER: 900707__GAU01__ZZ01__CTB17__30006 | DOCUMENT ID: OU100742124 | REVISION: 2

LARSEN & TOUBRO
This drawing is the property of LARSEN & TOUBRO and must not be passed on to any person or body not authorized by us to receive it nor be copied or otherwise made use either in full or in part by such person or body without our prior permission in writing.

Outotec
The content of these documents are the sole property of Outotec Oyj. Any rights not expressly granted herein are reserved. Reproduction, transfer or distribution of part or all of the contents in any form without prior written permission of Outotec is prohibited.

MA'ADEN معادن
Saudi Arabian Mining Company شركة معادن العربية السعودية
This document and the information contained herein is Ma'aden proprietary know-how. This document or any part thereof should not be reproduced, stored in a retrieval system or transmitted by any means, electronic or otherwise, or divulged without prior written permission of Ma'aden.

DRAWN	ABS	07/02/2022	MANSOURAH - MASSARAH GOLD PROJECT
CHECKED	SJM	11/02/2022	DETAIL DRAWING
ENGINEER	AVG	07/02/2022	CAR WASHING STATION
APPROVED	AG	19/02/2022	REINFORCEMENT DETAILS OF FOUNDATION
EMPLOYER			
SCALE	1:50, 1:20	A1	DRAWING NUMBER: MD-216-3000-EG-CV-DED-1015 | REV: D01