


DRAWING NUMBER MD - 216 - 3000 - EG - CV - GAD - 1050 REV D01

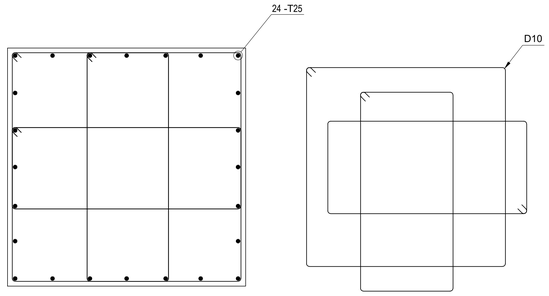


R.C.C DETAIL OF COLUMN MKD. C1 & C2
SCALE 1:15

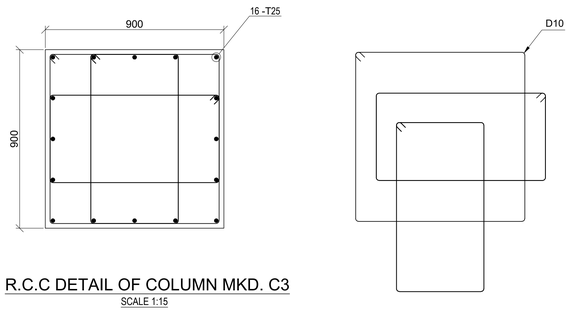


R.C.C DETAIL OF COLUMN MKD. C3
SCALE 1:15

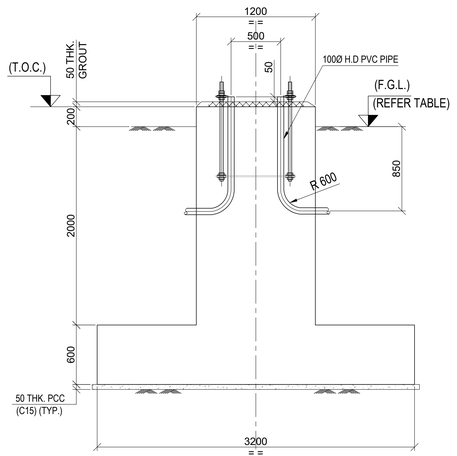


SECTION A-A
SCALE 1:30

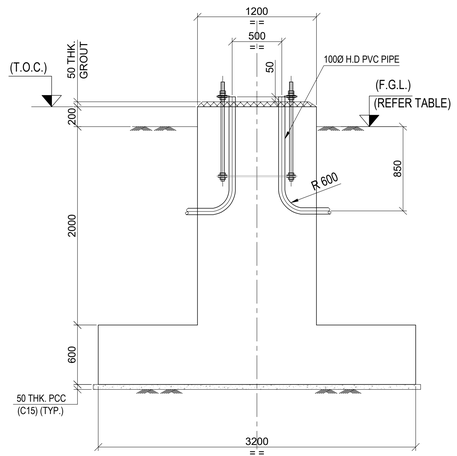

SECTION A'-A'
SCALE 1:30

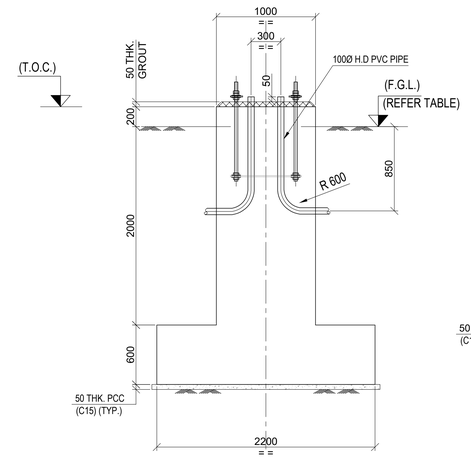


SECTION A"-A"
SCALE 1:30

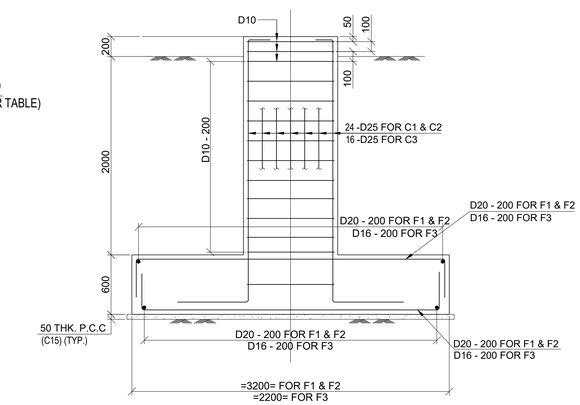


SECTION B-B
SCALE 1:30


LEVEL OF FOUNDATION	
HIGHMAST TOWER NAME	F.G.L (R.L)
HM-01	915.700
HM-02	915.400
HM-03	913.300
HM-04	914.200
HM-05	913.100
HM-06	912.800
HM-07	911.600
HM-08	911.800
HM-09	912.000
HM-10	912.200
HM-11	912.200
HM-12	913.350
HM-13	912.250

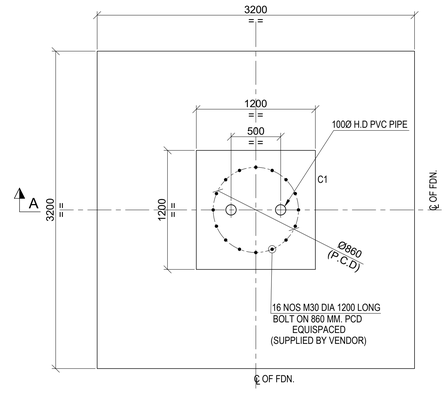


FOUNDATION PLAN MKD. F1
(FOR HM-10 & HM-11)
(2 NOS. REQUIRED)
SCALE 1:30

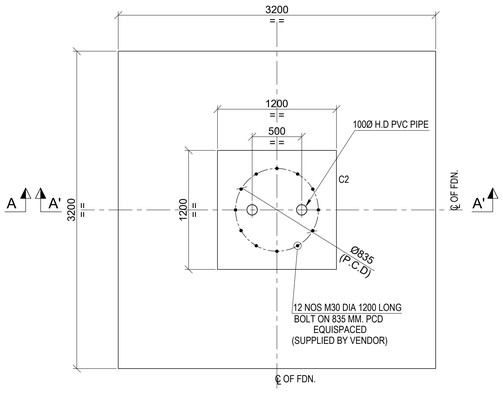

FOUNDATION PLAN MKD. F2
(FOR HM-01 TO 09 & HM-12)
(10 NOS. REQUIRED)
SCALE 1:30

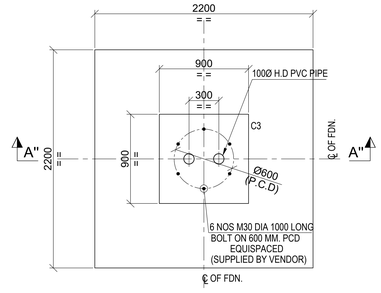

FOUNDATION PLAN MKD. F3
(FOR HM-13)
(1 NO. REQUIRED)
SCALE 1:30

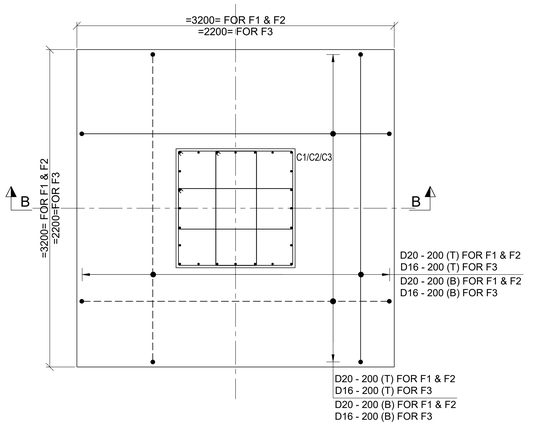

RCC DETAILS OF FOUNDATION PLAN MKD. F1, F2 & F3
SCALE 1:30

LEGEND :-
R.L. - REDUCED LEVEL
T.O.C. - TOP OF CONCRETE.
F.G.L. - FINISHED GROUND LEVEL.
TYP. - TYPICAL.
P.C.C - PLAIN CEMENT CONCRETE
BOTTOM REINFORCEMENT(B) - ————
TOP REINFORCEMENT(T) - – – – – –
MKD. - MARKED
℄ - CENTRE LINE
THK. - THICK
RCC - REINFORCED CEMENT CONCRETE
R-RADIUS
Ø - DIAMETER
P.V.C. - POLYVINYL CHLORIDE
DIA - DIAMETER
P.C.D - PITCH CIRCLE DIAMETER
H.D - HEAVY DUTY

NOTES :-
1. ALL DIMENSIONS ARE IN MILLIMETRES AND LEVELS AND CO-ORDINATES ARE IN METRES. UNLESS OTHERWISE STATED.
2. GRADE OF CONCRETE SHALL BE C35 (35MPa) FOR FOUNDATION & COLUMN.
3. GRADE OF REINFORCEMENT SHALL BE DEFORMED BAR ASTM A615 - GRADE 60 (fy = 420 MPa).
4. NET SAFE BEARING CAPACITY OF SOIL AT BOTTOM OF FOUNDATION IS CONSIDERED AS 350KN/SQ.M.
5. CLEAR COVER TO MAIN REINFORCEMENT SHALL BE AS
   a) FOUNDATION = 50 mm (BOTTOM, TOP & SIDE)
   b) COLUMN = 50mm
6. IF ANY PART OF FOUNDATION COMES ON BACKFILL ZONE OF ADJACENT FOUNDATION OR ANY LOOSE SOIL ARE ENCOUNTERED BELOW FOUNDATION LEVEL THE SAME SHALL BE REMOVED AND FILLED WITH PCC.
7. FOR STANDARD REINFORCEMENT DETAIL & GENERAL NOTES FOR CIVIL WORKS REFER DRAWING NO. MD-216-1000-EG-CV-DED-1005 &1001.
8. THIS DRAWING IS TO BE READ IN CONJUNCTION WITH DRAWING NO. MD-216-3000-EG-CV-GAD-1049.

DOCUMENT NUMBER	REFERENCE DOCUMENTS	REV	DATE	REVISION DESCRIPTION	DRN	CHK	ENG	APP	EMP
		D01	21/02/2023	AS-BUILT	SYA	SYA	AVG	AG	
		C03	18/02/2020	ISSUED FOR CONSTRUCTION & REVISED AS MARKED C03	SYA	SYA	AVG	AG	
		C02	23/12/2020	ISSUED FOR CONSTRUCTION & REVISED AS MARKED C02	SYA	SJM	AVG	AG	
		C01	31/08/2020	ISSUED FOR CONSTRUCTION	SYA	SJM	AVG	AG	
		A01	03/08/2020	ISSUED FOR REFERENCE	SYA	SJM	AVG	AG	

RESERVED FOR VENDOR LOGO AND DRAWING NUMBER

LARSEN & TOUBRO DRAWING NUMBER: 019045_950_C_D_24016_001 — REVISION: 4

OUTOTEC DRAWING NUMBER: 900707 __GAU01 __ZZ01 __MTL01 __30121 — DOCUMENT ID: OU100692573 — REVISION: 4

LARSEN & TOUBRO
This drawing is the property of LARSEN & TOUBRO and must not be passed on to any person or body not authorized by us to receive it nor be copied or otherwise made use either in full or in part by such person or body without our prior permission in writing.

Outotec
The content of these documents are the sole property of Outotec Oyj. Any rights not expressly granted herein are reserved. Reproduction, transfer or distribution of part or all of the contents in any form without prior written permission of Outotec is prohibited.

MA'ADEN معادن
Saudi Arabian Mining Company شركة التعدين العربية السعودية
This document and the information contained herein is Ma'aden proprietary know-how. This document or any part thereof should not be reproduced, stored in a retrieval system or transmitted by any means, electronic or otherwise, or divulged without prior written permission of Ma'aden.

DRAWN	SYA	28/07/2020	MANSOURAH - MASSARAH GOLD PROJECT
CHECKED	SJM	29/07/2020	GENERAL ARRANGEMENT DRAWING
ENGINEER	AVG	28/07/2020	PROCESS PLANT LIGHTING
APPROVED	AG	03/08/2020	DETAILS OF FOUNDATION FOR HIGHMAST TOWER
EMPLOYER			
SCALE 1:50, 1:10		A1	DRAWING NUMBER: MD - 216 - 3000 - EG - CV - GAD - 1050 — REV: D01