

DRAWING NUMBER: MD-216-3000-EG-CV-GAD-1052 REV D01

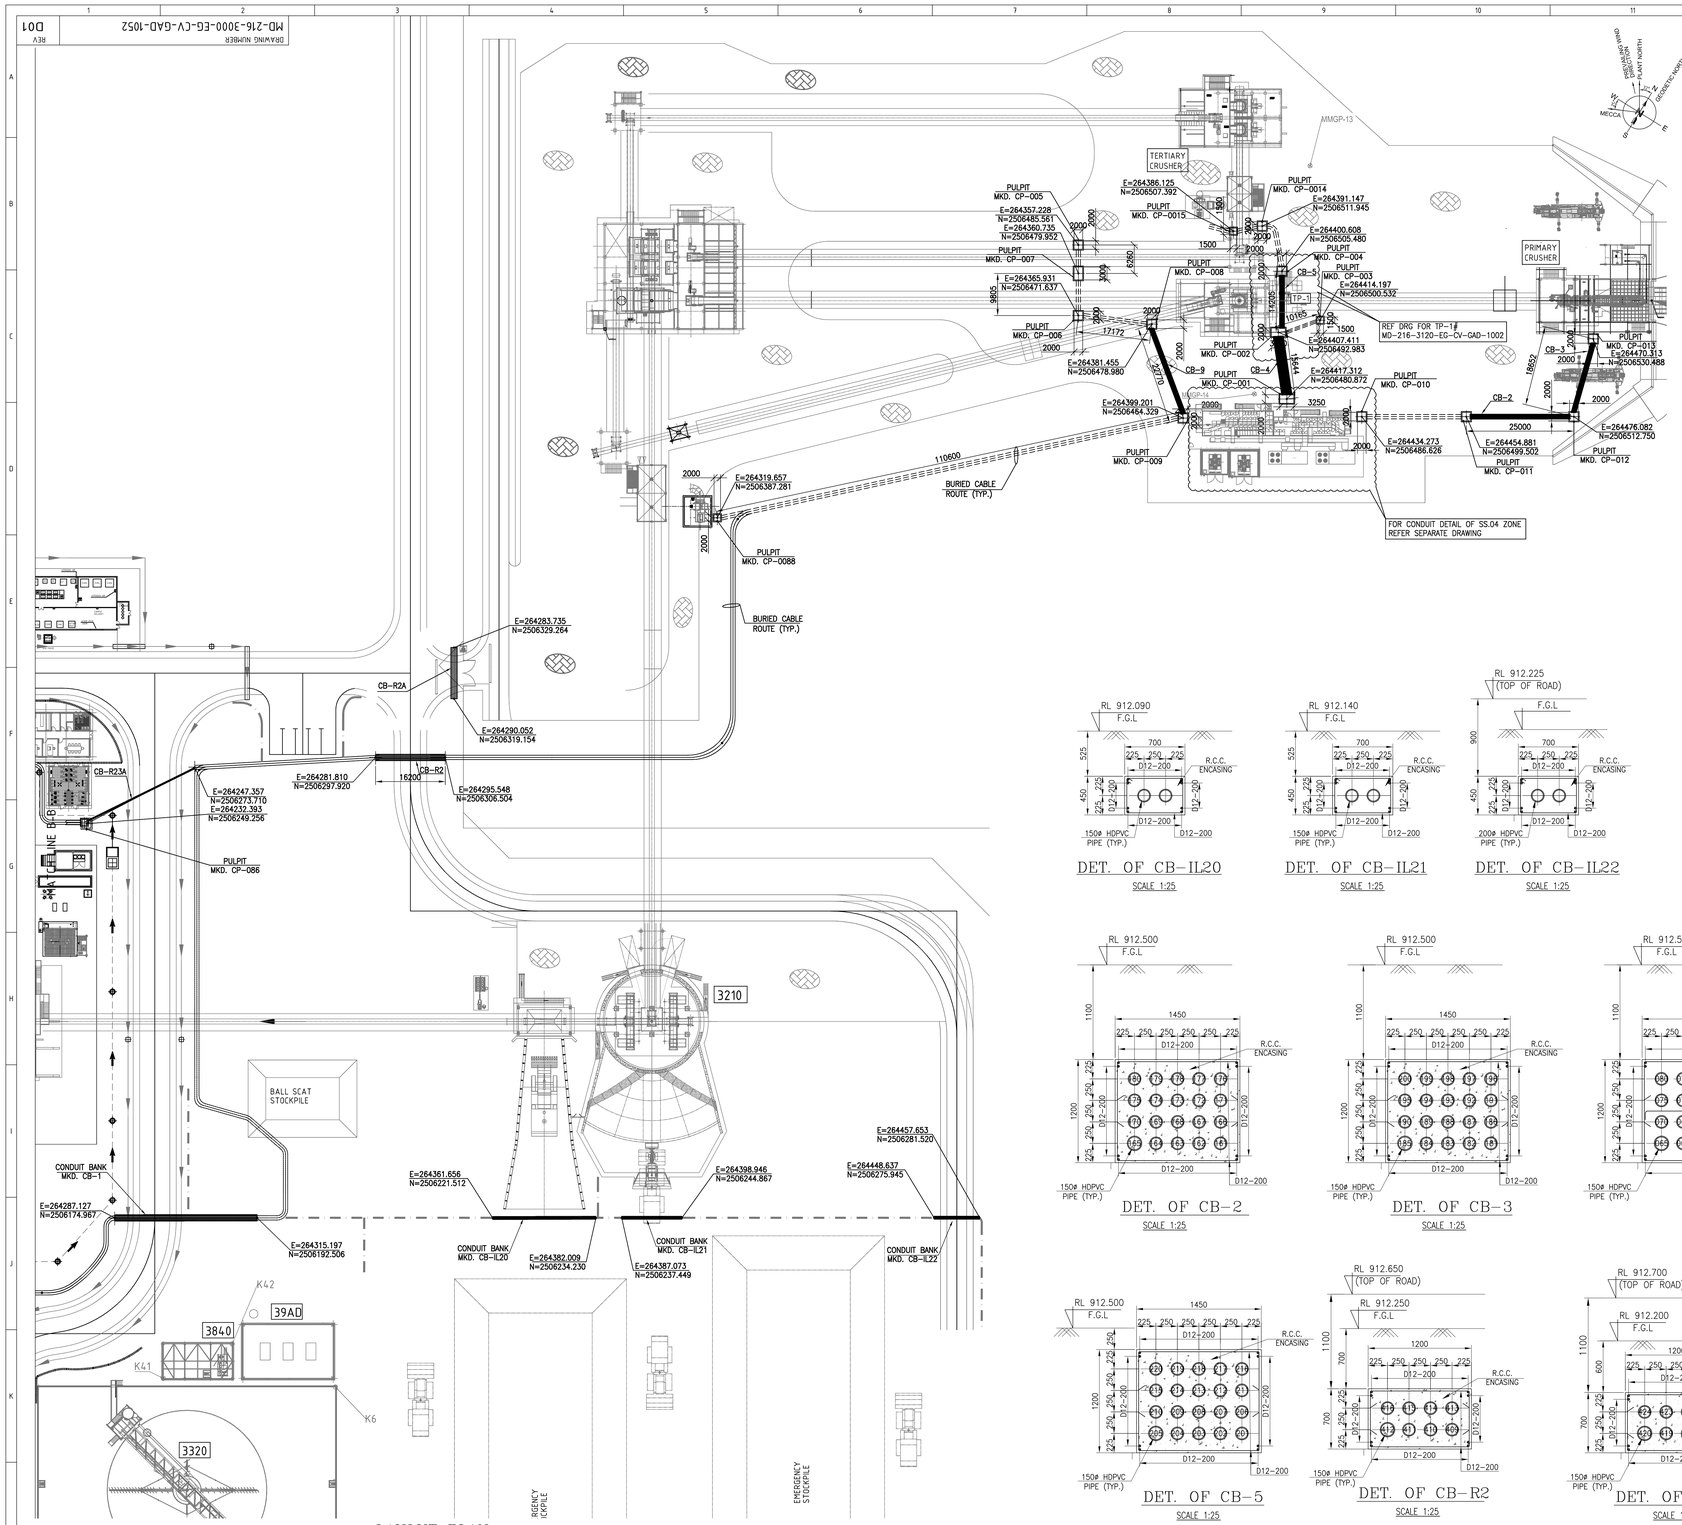


LAYOUT PLAN

SCALE 1:500


KEY PLAN

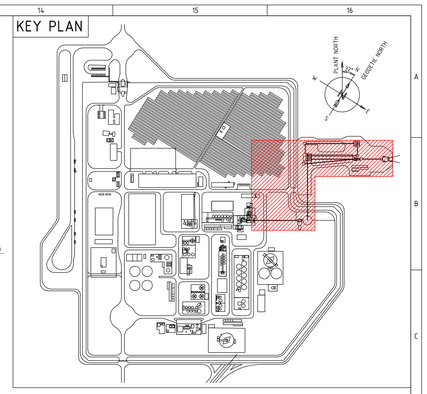

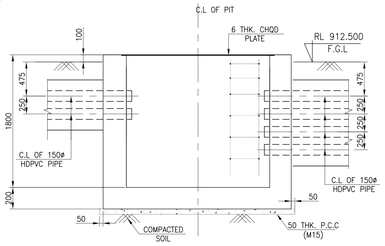


G.A. SECTION D2-D2

SCALE 1:30

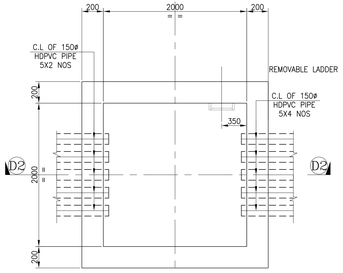

G.A. PLAN FOR PULLPIT MKD. CP-014

SCALE 1:30

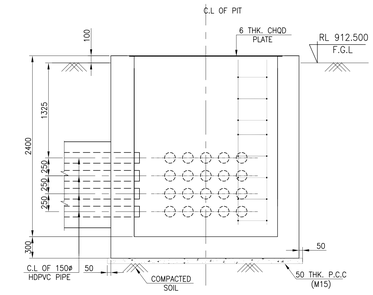

G.A. SECTION D1-D1

SCALE 1:30

DET. OF CB-IL20


SCALE 1:25

DET. OF CB-IL21

SCALE 1:25

DET. OF CB-IL22

SCALE 1:25

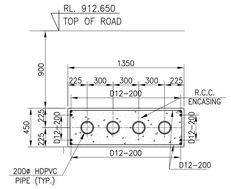

DETAIL OF CB-R2A


SCALE 1:25

DET. OF CB-2

SCALE 1:25


DET. OF CB-3

SCALE 1:25

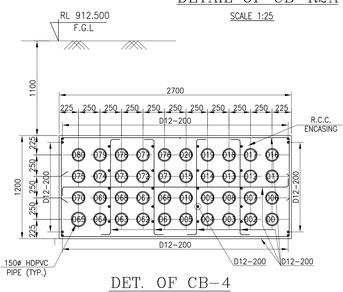


DET. OF CB-4

SCALE 1:25

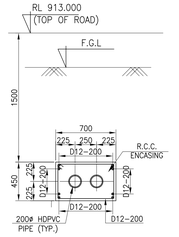

DET. OF CB-R23A

SCALE 1:25

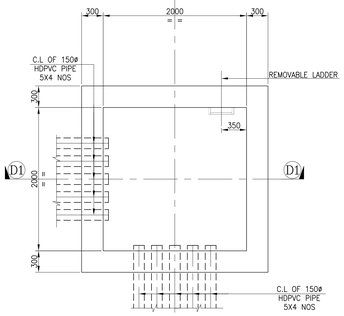

G.A. PLAN FOR PULLPIT MKD. CP-008


SCALE 1:30

DET. OF CB-5

SCALE 1:25


DET. OF CB-R2

SCALE 1:25

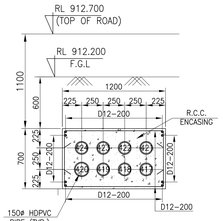

DET. OF CB-1

SCALE 1:25

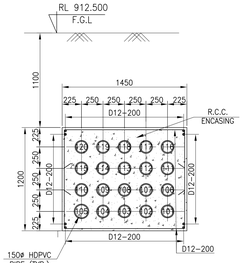

DET. OF CB-9

SCALE 1:25

LEGEND:

TYP.	TYPICAL
U.N.O	UNLESS NOTED OTHERWISE
G.A.	GENERAL ARRANGEMENT
R.C.	REINFORCED CONCRETE
DET.	DETAIL
CB	CONDUIT BANK
F.G.L	FINISHED GROUND LEVEL
P.C.C	PLANE CEMENT CONCRETE
R.C.C	REINFORCED CEMENT CONCRETE
M.S.	MILD STEEL
HDPVC	HIGH-DENSITY POLYVINYL CHLORIDE
C.L	CENTRE LINE
DIA	DIAMETER
ø	DIAMETER
THK	THICK
MKD	MARKED
CHQD.	CHEQUERED

NOTES:

1. ALL DIMENSIONS ARE IN MILLIMETRES
2. CO-ORDINATES AND LEVELS ARE IN METRES
3. GRADE OF REINFORCED CEMENT CONCRETE (R.C.C) SHALL BE M35.
4. REINFORCEMENT BARS SHALL CONFORM TO ASTM A615 GRADE 60 (FY=420 N/SQ.MM)
5. CLEAR COVER TO MAIN REINFORCEMENT SHALL BE 25MM UNLESS NOTED OTHERWISE.
6. MD-216-3000-EG-CV-DED-1001, 1002 & MD-216-1000-EG-ST-DED-1001.
7. FOR DETAILS OF CHEQUERED PLATE COVER REFER DRG. NO. MD-216-3000-EG-CV-GAD-1054.

DOCUMENT NUMBER	REFERENCE DOCUMENTS	REV	DATE	REVISION DESCRIPTION	DRN	CHK	ENG	APP	EMP
		001	25/3/2023	AS BUILT	PML	SNM	APEX	SJM	
		C07	05/07/2021	ISSUED FOR CONSTRUCTION AND REVISED AS MARKED 7	PML	SNM	APEX	SJM	
		C06	08/04/2021	ISSUED FOR CONSTRUCTION AND REVISED AS MARKED 6	PML	SNM	APEX	SJM	
		C05	24/03/2021	ISSUED FOR CONSTRUCTION AND REVISED AS MARKED 5	PML	SNM	APEX	SJM	
		C04	23/02/2021	ISSUED FOR CONSTRUCTION AND REVISED AS MARKED 4	PML	SNM	APEX	SJM	
		C03	03/02/2021	ISSUED FOR CONSTRUCTION	APEX	SNM	APEX	SJM	
		C02	24/01/2021	ISSUED FOR CONSTRUCTION	APEX	SNM	APEX	SJM	
MD-216-1000-EG-GE-PPD-1002	PROCESS PLANT LAYOUT	C01	31/10/2020	ISSUED FOR CONSTRUCTION	APEX	SNM	APEX	SJM	
MD-216-3000-EG-EL-LAD-1023	LAYOUT PLAN & DETAIL OF CONDUITS BANK	A01	09/10/2020	ISSUED FOR REFERENCE	APEX	SNM	APEX	SJM	

RESERVED FOR VENDOR LOGO AND DRAWING NUMBER

LARSEN & TOUBRO

This drawing is the property of LARSEN & TOUBRO and must not be passed on to any person or body not authorized by us to receive it nor be copied or otherwise made use either in full or in part by such person or body without our prior permission in writing.

Outotec

The content of these documents are the sole property of Outotec Oy. Any rights not expressly granted herein are reserved. Reproduction, transfer or distribution of part or all of the contents in any form without prior written permission of Outotec is prohibited.

MA'ADEN معادن Saudi Arabian Mining Company شركة معادن العربية السعودية

This document and the information contained herein is Ma'aden proprietary know-how. This document or any part thereof should not be reproduced, stored in a retrieval system or transmitted by any means, electronic or otherwise, or divulged without prior written permission of Ma'aden.

LARSEN & TOUBRO DRAWING NUMBER			REVISION
019045_950_C_G_24428_001			8
OUTOTEC DRAWING NUMBER		DOCUMENT ID	REVISION
900707_GAU01_ZZ01_MTL01_30122		OU100703595	8
DRAWN	APEX	03/10/2020	MANSOURAH - MASSARAH GOLD PROJECT
CHECKED	SNM	05/10/2020	GENERAL ARRANGEMENT DRAWING
ENGINEER	APEX	01/10/2020	CRUSHER AREA PULL PIT LAYOUT
APPROVED	SJM	09/10/2020	LAYOUT & DETAILS
EMPLOYER			
SCALE	1:500, 1:50, 1:20	A0	DRAWING NUMBER: MD-216-3000-EG-CV-GAD-1052 REV D01