

REV	DRAWING NUMBER
D01	MD - 216 - 49EE -EG - ME - GAD - V561-2001

Pump Tag - 49EE-PMP-101
49EE-PMP-102
49EE-PMP-103
49EE-PMP-104
49EE-PMP-105
49EE-PMP-106

NOT in KSB scope of supply

DIN 2440
DIN 2448
NF A 49-00440
NF A 49-005
NF A 49-117

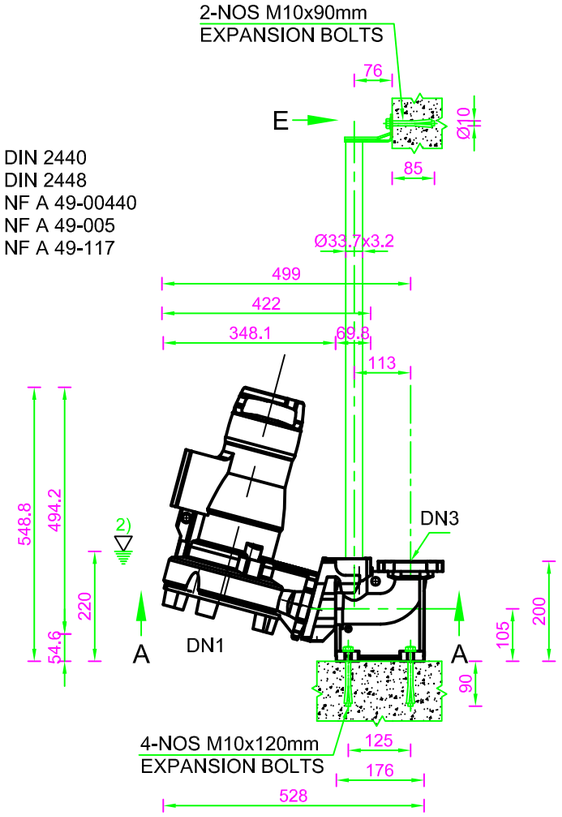

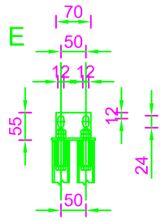

Drawing is not to scale


Pump

Pump Flow Rate	4 m3/h
Pump Head	15 mwc


Motor

Motor manufacturer	KSB
Motor size	01L
Motor power	1.90 kW
Number of poles	2
Speed of rotation	3317 rpm

A-A

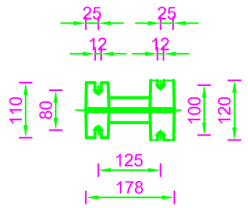

D

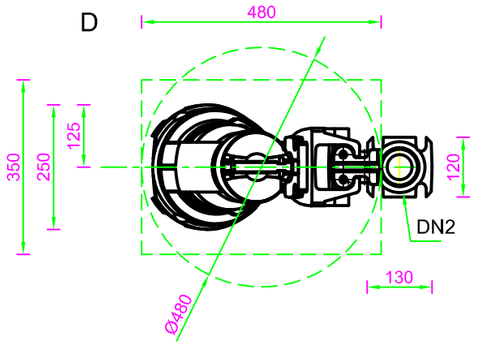

1 Lowest switch-off point for automatic operation
2 Minimum submergence for continuous operation

Connect pipes without stress or strain!
Dimensional tolerances for shaft axis height
Dimensions without tolerances, middle tolerance to:
Connection dimensions for pumps:
Dimensions without tolerances - welded parts:

Connections

Suction nominal size DN1	DN50 / DIN2501/ISO7005
Discharge nominal size DN2	DN50 / DIN2501/ISO7005
Nominal size DN3	DN50 / ASME
Nominal pressure suction	unmachined
Rated pressure discharge	PN16

Static weight

Pump motor, cable	43 kg
Claw / foot	7 kg
Total	50 kg

For auxilliary connection see separate drawing

DIN 747
ISO 2768-m
EN 735
ISO 13920-B
ISO 8062-CT9

Dimension in millimeters

REV	DATE	REVISION DESCRIPTION	DRN	CHK	ENG	APP	EMP
D01	29/02/2024	AS-BUILT	NAEW	SHH	--	JPD	--
C02	02/05/2023	ISSUED FOR CONSTRUCTION	--	SHH	--	JPD	--
C01	26/06/2020	ISSUED FOR CONSTRUCTION & REVISED AS PER EMPLOYER COMMENTS DATED 08/05/2020	--	SHH	--	JPD	--
A01	28/05/2020	ISSUED FOR REFERENCE	--	SHH	--	JPD	--

KSB Pumps Arabia Ltd.

Outotec
The content of these documents are the sole property of Outotec Oyj. Any rights not expressly granted herein are reserved. Reproduction, transfer or distribution of part or all of the contents in any form without prior written permission of Outotec is prohibited.

LARSEN & TOUBRO
This drawing is the property of LARSEN & TOUBRO and must not be passed on to any person or body not authorised by us to receive it nor be copied or otherwise made use either in full or in part by such person or body without our prior permission in writing.

MA'ADEN معادن
Saudi Arabian Mining Company شركة التعدين العربية السعودية
This document and the information contained herein is Ma'aden proprietary know-how. This document or any part thereof should not be reproduced, stored in a retrieval system or transmitted by any means, electronic or otherwise, or divulged without prior written permission of Ma'aden.

	DRAWING NUMBER	REVISION
	AMAREX NS 50-170/12ULG-100	1

DATE	21/05/2020	DATE	21/05/2020	DATE	21/05/2020
DRAWN	ECF	CHECKED	MKA	APPROVED	JAD

LARSEN & TOUBRO DRAWING NUMBER	019045_045_U_V_20970_001	REV 1
OUTOTEC DRAWING NUMBER	900707 _GAU01 _AG90_MTL01 _50017	DOCUMENT ID OU100684303 REV 2

DRAWN	---	---
CHECKED	SHH	27/05/2020
ENGINEER	---	---
APPROVED	JPD	28/05/2020
EMPLOYER		
SCALE	NTS	A3


MANSOURAH - MASSARAH GOLD PROJECT
GENERAL ARRANGEMENT
SITE DOMESTIC WASTE WATER (SEWAGE) SYSTEM
SEWAGE LIFTING PUMP PACKAGE

DRAWING NUMBER	REV
MD - 216 - 49EE -EG - ME - GAD - V561 - 2001	D01

1 2 3 4 5 6

DRAWING NUMBER
MD - 216 - 49EE -EG - ME - GAD - V561-2001

REV
D01

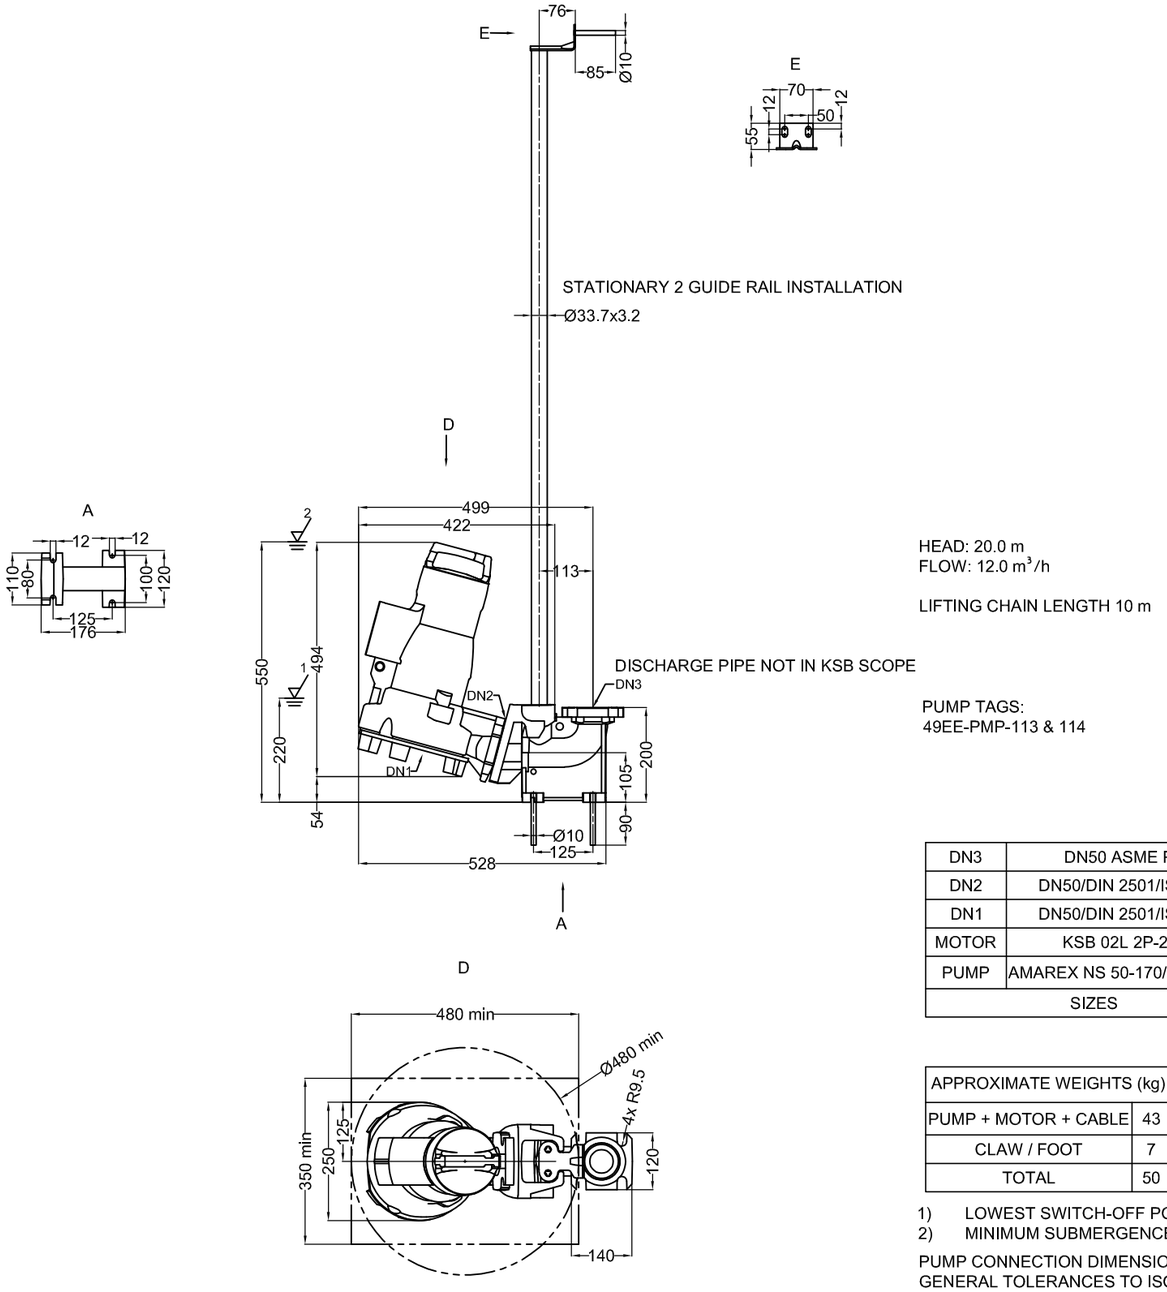

DISCHARGE PIPE NOT IN KSB SCOPE

HEAD: 20.0 m
FLOW: 12.0 m^3/h

LIFTING CHAIN LENGTH 10 m

PUMP TAGS:
49EE-PMP-113 & 114

DN3	DN50 ASME PN16
DN2	DN50/DIN 2501/ISO 7005
DN1	DN50/DIN 2501/ISO 7005
MOTOR	KSB 02L 2P-2.3kW
PUMP	AMAREX NS 50-170/022ULG-130
SIZES	

APPROXIMATE WEIGHTS (kg)	
PUMP + MOTOR + CABLE	43
CLAW / FOOT	7
TOTAL	50

1) LOWEST SWITCH-OFF POINT FOR AUTOMATIC OPERATION
2) MINIMUM SUBMERGENCE FOR CONTINUOUS OPERATION

PUMP CONNECTION DIMENSIONS TO EN 735
GENERAL TOLERANCES TO ISO 2768-m

DIMENSIONS IN mm

REV	DATE	REVISION DESCRIPTION	DRN	CHK	ENG	APP	EMP
D01	29/02/2024	AS-BUILT	NAEW	SHH	ENG	JPD	EMP
C02	02/05/2023	ISSUED FOR CONSTRUCTION	--	SHH	--	JPD	--
C01	26/06/2020	ISSUED FOR CONSTRUCTION & REVISED AS PER EMPLOYER COMMENTS DATED 08/05/2020	--	SHH	--	JPD	--
A01	28/05/2020	ISSUED FOR REFERENCE	--	SHH	--	JPD	--

KSB

DRAWING NUMBER: AC0000256
REVISION: 01

DATE	12/08/2021	DATE	12/08/2021	DATE	12/08/2021
DRAWN	FSHAH	CHECKED	FSHAH	APPROVED	ISHTIAQA

LARSEN & TOUBRO DRAWING NUMBER: 019045_045_U_V_20970_001 — REV: 1

OUTOTEC DRAWING NUMBER: 900707 _GAU01 _AG90_MTL01 _50017 — DOCUMENT ID: OU100684303 — REV: 2

Outotec
The content of these documents are the sole property of Outotec Oyj. Any rights not expressly granted herein are reserved. Reproduction, transfer or distribution of part or all of the contents in any form without prior written permission of Outotec is prohibited.

LARSEN & TOUBRO
This drawing is the property of LARSEN & TOUBRO and must not be passed on to any person or body not authorized by us to receive it nor be copied or otherwise made use either in full or in part by such person or body without our prior permission in writing.

MA'ADEN معادن
Saudi Arabian Mining Company شركة التعدين العربية السعودية
This document and the information contained herein is Ma'aden proprietary know-how. This document or any part thereof should not be reproduced, stored in a retrieval system or transmitted by any means, electronic or otherwise, or divulged without prior written permission of Ma'aden.

DRAWN	---	---
CHECKED	SHH	27-05-2020
ENGINEER	---	---
APPROVED	JPD	28-05-2020
EMPLOYER		
SCALE	NTS	A3

MANSOURAH - MASSARAH GOLD PROJECT
GENERAL ARRANGEMENT
SITE DOMESTIC WASTE WATER (SEWAGE) SYSTEM
SEWAGE LIFTING PUMP PACKAGE

DRAWING NUMBER: MD - 216 - 49EE -EG - ME - GAD - V561-2001 — REV: D01