


DRAWING NUMBER: MD - 216 - 3650 - EG - CV - GAD - 1329 | REV: D01

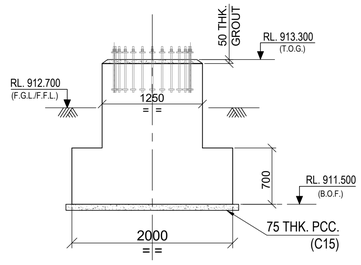


SECTION : F-F
SCALE 1:40

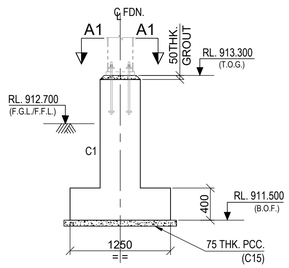


SECTION : A-A
SCALE 1:40

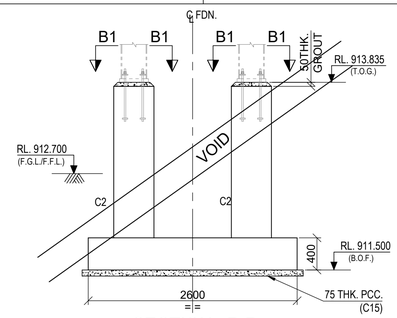


SECTION : B-B
SCALE 1:40

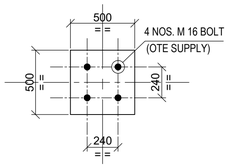


VIEW : A1-A1
SCALE 1:25

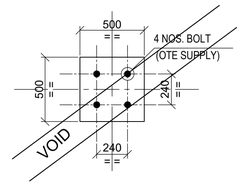


VIEW : B1-B1
SCALE 1:25

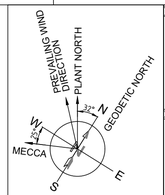


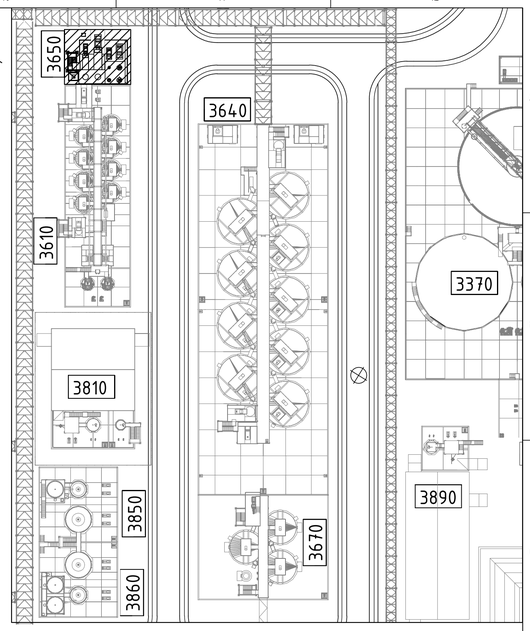


KEY PLAN
SCALE 1:1000

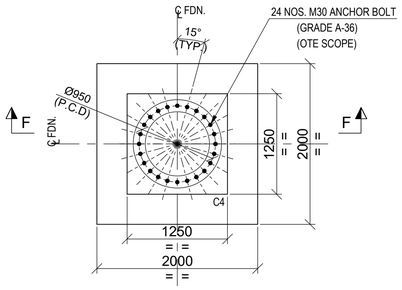


DETAIL OF FOUNDATION MKD. F4
(FOR 3650-THK-001)

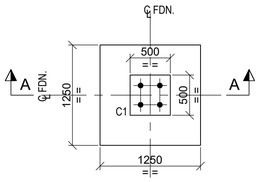


DETAIL OF FOUNDATION MKD. F1
(FOR 3650-THK-001)
SCALE 1:40

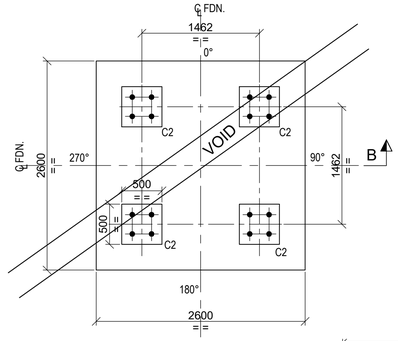


DETAIL OF FOUNDATION MKD. F2
(FOR 3650-REA-001)
SCALE 1:40

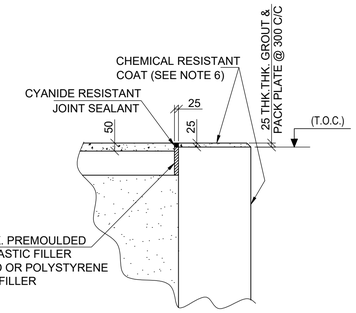


DETAIL - 'X'
SCALE 1:20

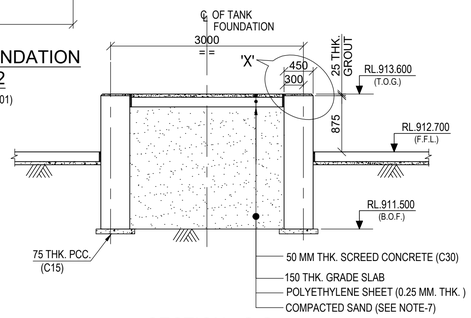


SECTION : C-C
SCALE 1:50

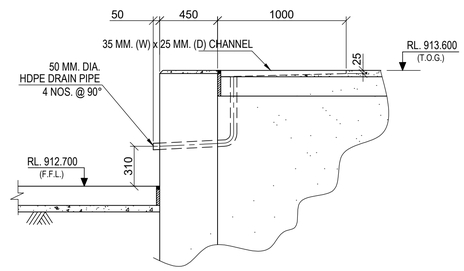


SECTION : D-D
SCALE 1:25

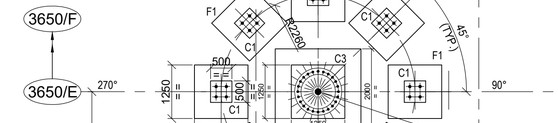

LAYOUT OF FOUNDATION
SCALE 1:75

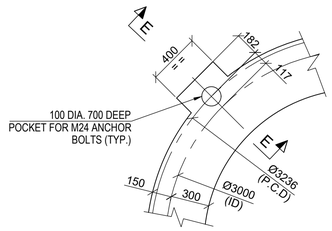

DETAIL : 'Y'
SCALE 1:25

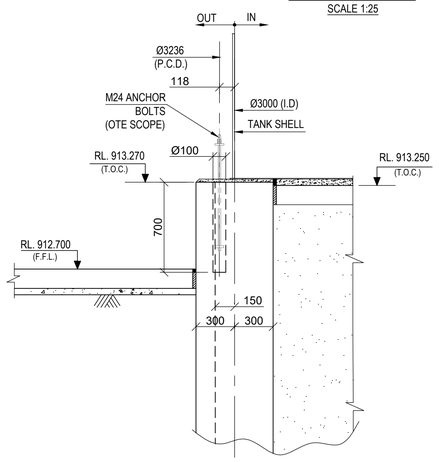

SECTION : E-E
SCALE 1:25

LEGEND :-

R.L. - REDUCED LEVEL
℄ - CENTRE LINE
T.O.C. - TOP OF CONCRETE
TYP. - TYPICAL
I.D. - INTERNAL DIAMETER
T.O.G. - TOP OF GROUT
B.O.F. - BOTTOM OF FOUNDATION
F.G.L. - FINISHED GROUND LEVEL.
EQV. - EQUIVALENT
F.F.L. - FINISHED FLOOR LEVEL
P.C.C - PLAIN CEMENT CONCRETE
DET. - DETAIL
FDN. - FOUNDATION
R - RADIUS
DIA. - DIAMETER
THK. - THICKNESS
R.C.C - REINFORCED CEMENT CONCRETE
P.C.D - PITCH CIRCLE DIAMETER

NOTES:-

1. ALL DIMENSIONS ARE IN MILLIMETRES AND LEVELS AND CO-ORDINATES ARE IN METRES UNLESS OTHERWISE STATED.
2. NET SAFE BEARING CAPACITY OF SOIL AT BOTTOM OF FOUNDATION IS CONSIDERED AS 350KN/ SQ. M.
3. GRADE OF CONCRETE SHALL BE C35 (35Mpa) FOR FOUNDATION, C30 (30Mpa) FOR GRADE SLAB & C15 (15Mpa) FOR BLINDING CONCRETE.
4. SAND SHALL BE COMPACTED TO A MINIMUM DEPTH OF 300MM TO ACHIEVE 98% MODIFIED MAXIMUM DRY DENSITY AS MEASURED BY ASTM D1557.
5. IF ANY PART OF FOUNDATION COMES ON BACKFILL ZONE OF ADJACENT FOUNDATION OR ANY LOOSE SOIL ARE ENCOUNTERED BELOW FOUNDATION LEVEL THE SAME SHALL BE REMOVED AND FILLED WITH PCC.
6. PRIMING COAT SIKAFLOOR 161 + BASE & SEALER COAT OF SIKAGUARD PW OR EQUIVALENT AS PER MANUFACTURER'S SPECIFICATION SHALL BE APPLIED FOR PROTECTING CONCRETE AGAINST CYANIDE, ACID AND ALKALI.
7. SAND SHALL BE COMPACTED TO A MAXIMUM DEPTH OF 300MM AND SHALL BE COMPACTED TO 80% RELATIVE DENSITY AS DETERMINED BY ASTM D4253 AND ASTM D4254.

DOCUMENT NUMBER	REFERENCE DOCUMENTS	REV	DATE	REVISION DESCRIPTION	DRN	CHK	ENG	APP	EMP
MD-216-3650-EG-ME-GAD-1030	3650-REA-001 CARBON ATTRITIONING TANK	D01	22/02/2023	AS-BUILT	SYA	SJM	SOR	AG	
MD-216-3650-EG-ME-GAD-1025	POX ELUTION 3650-TNK-002 POX ELUTION TANK	C05	11/02/2021	ISSUED FOR CONSTRUCTION & REVISED AS MARKED C05	SYA	SJM	SOR	AG	
MD-216-3650-EG-ME-GAD-1013	3650-THK-001 COMBINED CARBON SETTLER	C04	23/12/2020	ISSUED FOR CONSTRUCTION & REVISED AS MARKED C04	SYA	SJM	SOR	AG	
MD-216-3650-EG-GV-DED-1336	RCC. DET. OF 3650-THK-001,3650-TNK-002,3650-REA-001	C03	17/11/2020	ISSUED FOR CONSTRUCTION & REVISED AS MARKED C03	SYA	SJM	SOR	AG	
MD-216-1000-EG-ST-CRT-1001	CIVIL, STRUCTURAL & ARCHITECTURAL - DESIGN CRITERIA	C02	16/10/2020	ISSUED FOR CONSTRUCTION & REVISED AS MARKED C02	SYA	SJM	SOR	AG	
MD-216-3650-EG-ME-GAD-1015	POX ACID WASH/ELUTION/CARBON REGENERATION, PLAN AT EL. +912.700	C01	26/06/2020	ISSUED FOR CONSTRUCTION	ABS	SJM	SOR	AG	
MD-216-3650-EG-CV-GAD-1001	POX ACID WASH-ELUTION AND CARBON REGENERATION, PLAN AT EL. +912.700	A01	30/05/2020	ISSUED FOR REFERENCE	ABS	SJM	SOR	AG	

RESERVED FOR VENDOR LOGO AND DRAWING NUMBER

LARSEN & TOUBRO

This drawing is the property of LARSEN & TOUBRO and must not be passed on to any person or body not authorized by us to receive it nor be copied or otherwise made use either in full or in part by such person or body without our prior permission in writing.

Outotec

The content of these documents are the sole property of Outotec Oyj. Any rights not expressly granted herein are reserved. Reproduction, transfer or distribution of part or all of the contents in any form without prior written permission of Outotec is prohibited.

MA'ADEN معادن
Saudi Arabian Mining Company شركة التعدين العربية السعودية

This document and the information contained herein is Ma'aden proprietary know-how. This document or any part thereof should not be reproduced, stored in a retrieval system or transmitted by any means, electronic or otherwise, or divulged without prior written permission of Ma'aden.

LARSEN & TOUBRO DRAWING NUMBER: 019045_450_C_G_24139_003 | REVISION: 6
OUTOTEC DRAWING NUMBER: 900707 _GAU01 _EE12 _MTL01 _36514 | DOCUMENT ID: OU100685993 | REVISION: 6

DRAWN	ABS	15/05/2020
CHECKED	SJM	19/05/2020
ENGINEER	SOR	15/05/2020
APPROVED	AG	30/05/2020
EMPLOYER		
SCALE	1:75, 1:50, 1:20	A1

MANSOURAH - MASSARAH GOLD PROJECT
GENERAL ARRANGEMENT DRAWING
POX ACID WASH,ELUTION AND CARBON REGENERATION
FDN. DET. FOR 3650-THK-001,3650-TNK-002,3650-REA-001

DRAWING NUMBER: MD - 216 - 3650 - EG - CV - GAD - 1329 | REV: D01