


DRAWING NUMBER: MD - 216 - 3650 - EG - CV - GAD - 1334 | REV: D01

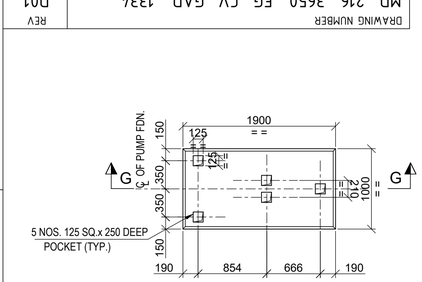


FDN. FOR PUMP MKD.
3650-PMP-007 & 008
SCALE 1:40

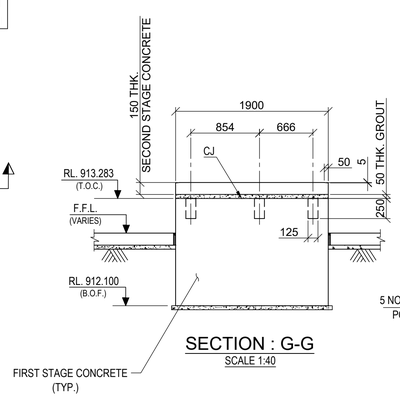


SECTION : G-G
SCALE 1:40

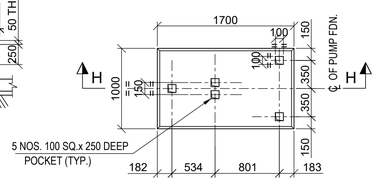


FDN. FOR PUMP MKD.
3650-PMP-011 & 012
SCALE 1:40

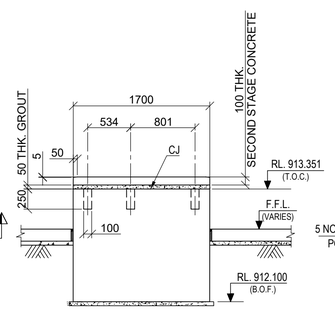


SECTION : H-H
SCALE 1:40

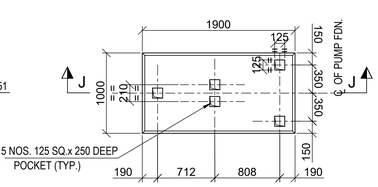


FDN. FOR PUMP MKD.
3650-PMP-001 & 002
SCALE 1:40

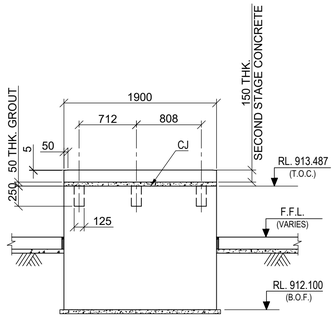


SECTION : J-J
SCALE 1:40

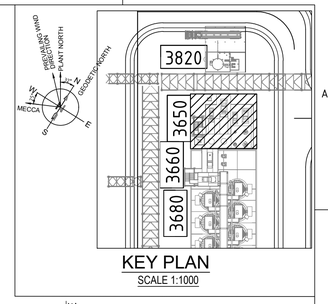


KEY PLAN
SCALE 1:1000

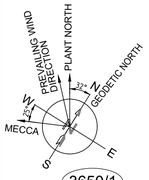


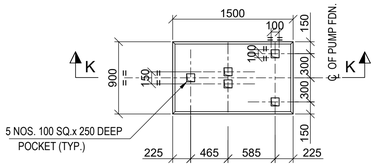


FDN. FOR PUMP MKD.
3650-PMP-005 & 006
SCALE 1:40

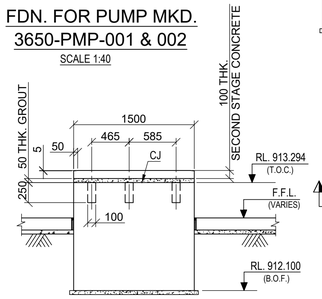


SECTION : K-K
SCALE 1:40

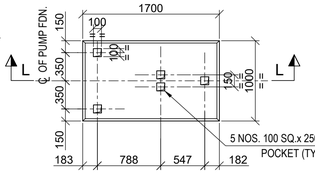


FDN. FOR PUMP MKD.
3650-PMP-009 & 010
SCALE 1:40

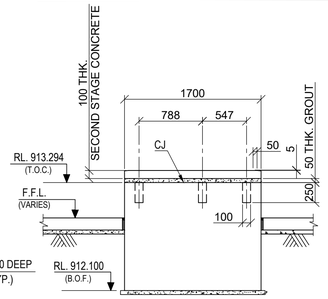


SECTION : L-L
SCALE 1:40

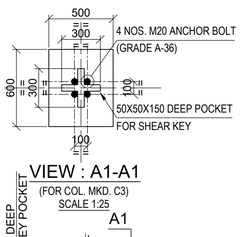


VIEW : A1-A1
(FOR COL. MKD. C3)
SCALE 1:25

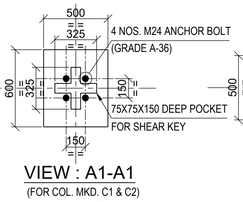


VIEW : A1-A1
(FOR COL. MKD. C1 & C2)
SCALE 1:25

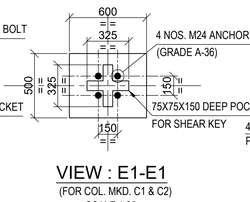

VIEW : E1-E1
(FOR COL. MKD. C1 & C2)
SCALE 1:25

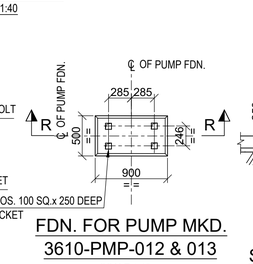

FDN. FOR PUMP MKD.
3610-PMP-012 & 013
SCALE 1:40

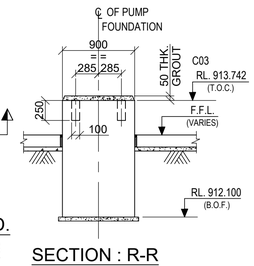


SECTION : R-R
SCALE 1:40


SECTION : A-A
SCALE 1:50

SECTION : C-C
SCALE 1:50


SECTION : E-E
SCALE 1:50

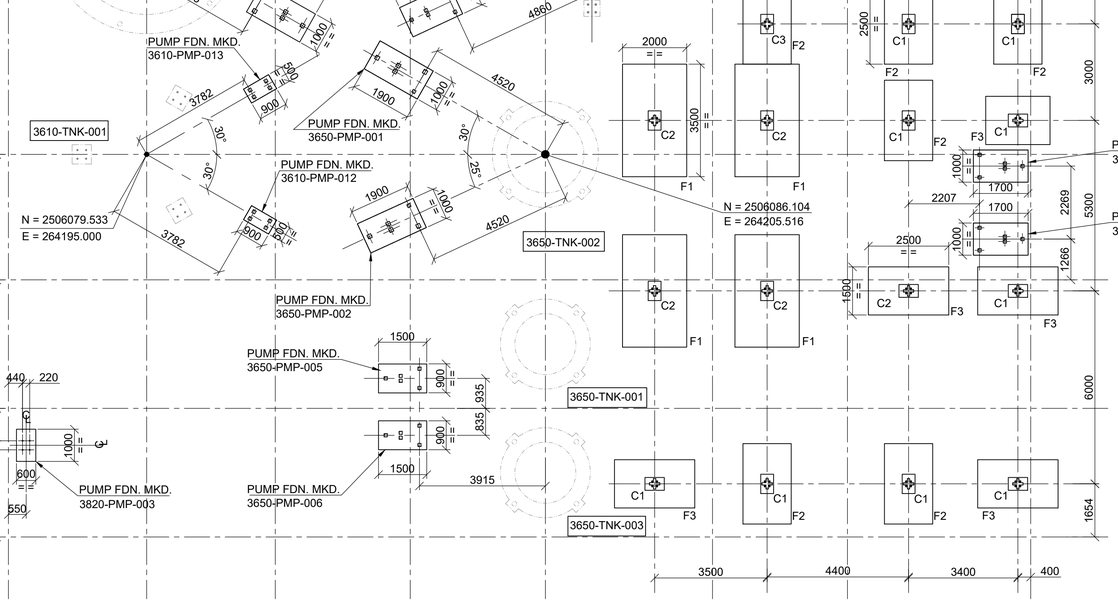


LAYOUT OF BUILDING AND PUMP FOUNDATION
SCALE 1:100

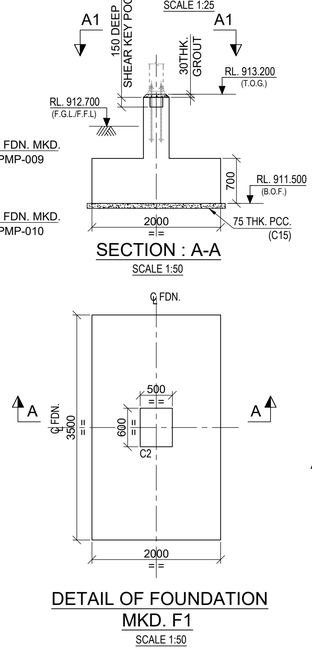


DETAIL OF FOUNDATION
MKD. F1
SCALE 1:50

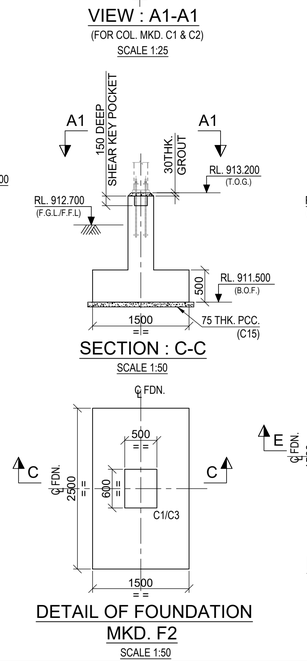

DETAIL OF FOUNDATION
MKD. F2
SCALE 1:50

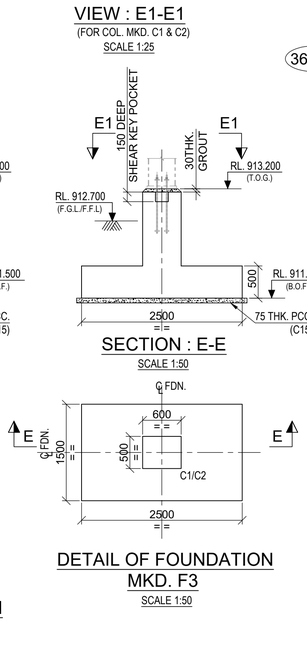

DETAIL OF FOUNDATION
MKD. F3
SCALE 1:50

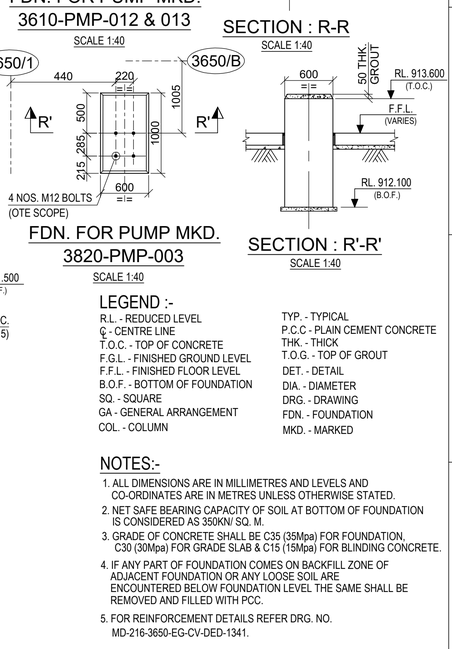

FDN. FOR PUMP MKD.
3820-PMP-003
SCALE 1:40

SECTION : R'-R'
SCALE 1:40

LEGEND :-

R.L. - REDUCED LEVEL	TYP. - TYPICAL
℄ - CENTRE LINE	P.C.C - PLAIN CEMENT CONCRETE
T.O.C. - TOP OF CONCRETE	THK. - THICK
F.G.L. - FINISHED GROUND LEVEL	T.O.G. - TOP OF GROUT
F.F.L. - FINISHED FLOOR LEVEL	DET. - DETAIL
B.O.F. - BOTTOM OF FOUNDATION	DIA. - DIAMETER
SQ. - SQUARE	DRG. - DRAWING
GA - GENERAL ARRANGEMENT	FDN. - FOUNDATION
COL. - COLUMN	MKD. - MARKED

NOTES:-

1. ALL DIMENSIONS ARE IN MILLIMETRES AND LEVELS AND CO-ORDINATES ARE IN METRES UNLESS OTHERWISE STATED.
2. NET SAFE BEARING CAPACITY OF SOIL AT BOTTOM OF FOUNDATION IS CONSIDERED AS 350KN/ SQ. M.
3. GRADE OF CONCRETE SHALL BE C35 (35Mpa) FOR FOUNDATION, C30 (30Mpa) FOR GRADE SLAB & C15 (15Mpa) FOR BLINDING CONCRETE.
4. IF ANY PART OF FOUNDATION COMES ON BACKFILL ZONE OF ADJACENT FOUNDATION OR ANY LOOSE SOIL ARE ENCOUNTERED BELOW FOUNDATION LEVEL THE SAME SHALL BE REMOVED AND FILLED WITH PCC.
5. FOR REINFORCEMENT DETAILS REFER DRG. NO. MD-216-3650-EG-CV-DED-1341.

DOCUMENT NUMBER	REFERENCE DOCUMENTS	REV	DATE	REVISION DESCRIPTION	DRN	CHK	ENG	APP	EMP
		D01	22/02/2023	AS-BUILT	SYA	SJM	SOR	AG	
MD-216-3650-EG-ST-GAD-2287	POX ACID WASH, ELUTN. AND CARBON REGN. PLAN, ELEVATIONS AND DETAILS	C03	15/01/2021	ISSUED FOR CONSTRUCTION & REVISED AS MARKED C03	SYA	SJM	SOR	AG	
MD-216-1000-EG-ST-CRT-1001	CIVIL, STRUCTURAL & ARCHITECTURAL - DESIGN CRITERIA	C02	18/12/2020	ISSUED FOR CONSTRUCTION & REVISED AS MARKED C02	SYA	SJM	SOR	AG	
MD-216-3650-EG-ME-GAD-1015	POX ACID WASH/ELUTION/CARBON REGENERATION, PLAN AT EL. +912.700	C01	24/11/2020	ISSUED FOR CONSTRUCTION & REVISED AS MARKED C01	SYA	SJM	SOR	AG	
MD-216-3650-EG-CV-GAD-1001	POX ACID WASH-ELUTION AND CARBON REGENERATION, PLAN AT EL. +912.700	A01	19/10/2020	ISSUED FOR REFERENCE	SYA	SJM	SOR	AG	

RESERVED FOR VENDOR LOGO AND DRAWING NUMBER

LARSEN & TOUBRO DRAWING NUMBER: 019045_450_C_G_24559_001 | REVISION: 4

OUTOTEC DRAWING NUMBER: 900707 _GAU01 _EE12 _MTL01 _36543 | DOCUMENT ID: OU100704152 | REVISION: 4

LARSEN & TOUBRO
This drawing is the property of LARSEN & TOUBRO and must not be passed on to any person or body not authorized by us to receive it nor be copied or otherwise made use either in full or in part by such person or body without our prior permission in writing.

Outotec
The content of these documents are the sole property of Outotec Oyj. Any rights not expressly granted herein are reserved. Reproduction, transfer or distribution of part or all of the contents in any form without prior written permission of Outotec is prohibited.

MA'ADEN معادن
Saudi Arabian Mining Company شركة التعدين العربية السعودية
This document and the information contained herein is Ma'aden proprietary know-how. This document or any part thereof should not be reproduced, stored in a retrieval system or transmitted by any means, electronic or otherwise, or divulged without prior written permission of Ma'aden.

DRAWN	SYA	15/10/2020	
CHECKED	SJM	17/10/2020	
ENGINEER	SOR	15/10/2020	
APPROVED	AG	19/10/2020	
EMPLOYER			
SCALE	1:50, 1:25, 1:20		A1

MANSOURAH - MASSARAH GOLD PROJECT
GENERAL ARRANGEMENT DRAWING
POX ACID WASH, ELUTION & CARBON REGENERATION
GA & DETAILS OF FOUNDATION

DRAWING NUMBER: MD - 216 - 3650 - EG - CV - GAD - 1334 | REV: D01