


DRAWING NUMBER
MD - 216 - 3650 - EG - CV - GAD - 1335
REV D01

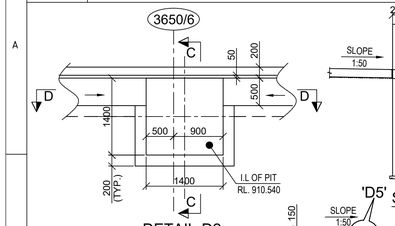


DETAIL-D2
SCALE 1:50

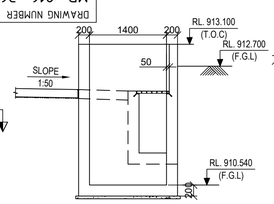


SECTION C-C
SCALE 1:50

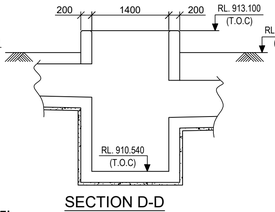


SECTION D-D
SCALE 1:50

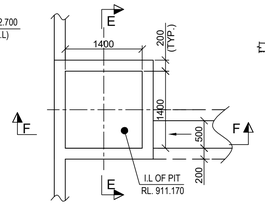


DETAIL-D3
SCALE 1:50

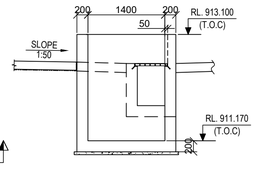


SECTION E-E
SCALE 1:50

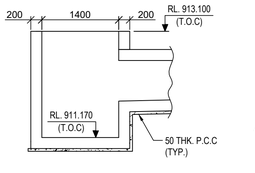


SECTION F-F
SCALE 1:50

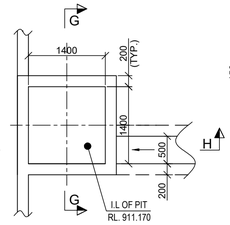


DETAIL-D4
SCALE 1:50

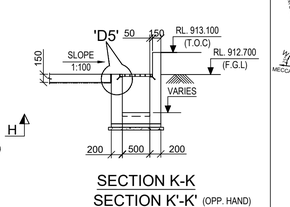


SECTION K-K
SECTION K'-K' (OPP. HAND)
SCALE 1:50

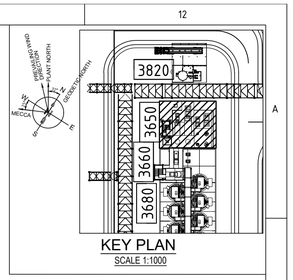


KEY PLAN
SCALE 1:1000

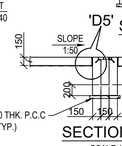


SECTION A-A
SCALE 1:50

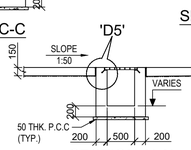


SECTION A'-A'
SCALE 1:50

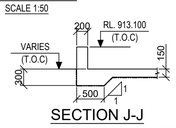


SECTION J-J
SECTION J'-J' (OPP. HAND)
SCALE 1:50

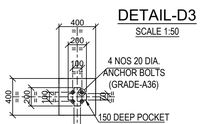


VIEW : K1-K1
SCALE 1:30

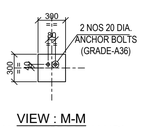


VIEW : M-M
VIEW : N-N (OPP. HAND)
SCALE 1:30

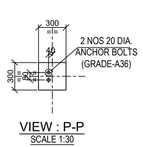


VIEW : P-P
SCALE 1:30

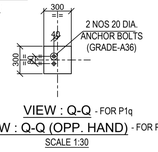


VIEW : Q-Q - FOR P1q
VIEW : Q-Q (OPP. HAND) - FOR P1r,P1f, P3, P2a, P2d & P2f
SCALE 1:30

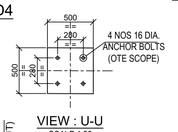


VIEW : U-U
SCALE 1:30

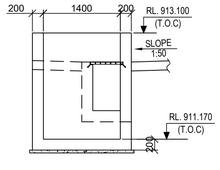


SECTION G-G
SCALE 1:50

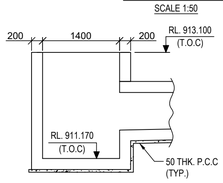


SECTION H-H
SCALE 1:50

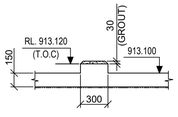


DETAIL - P1
SCALE 1:30

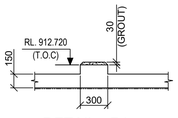


DETAIL - P1a
SCALE 1:30

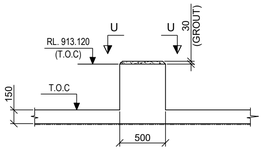


DETAIL - P4
SCALE 1:30

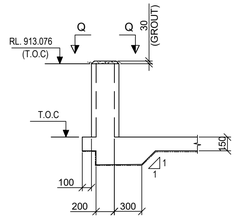


DETAIL - P2f
SCALE 1:30

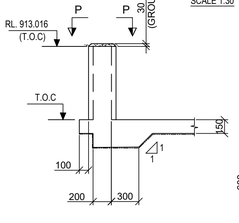


DETAIL - P2c
SCALE 1:30

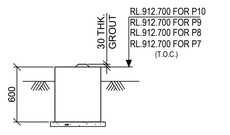


SECTION : U - U
(SCALE - 1:30)

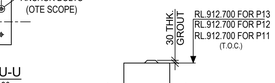


SECTION : U - U
(SCALE - 1:30)

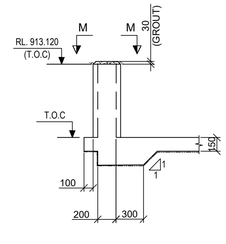


DETAIL - P1c
SCALE 1:30

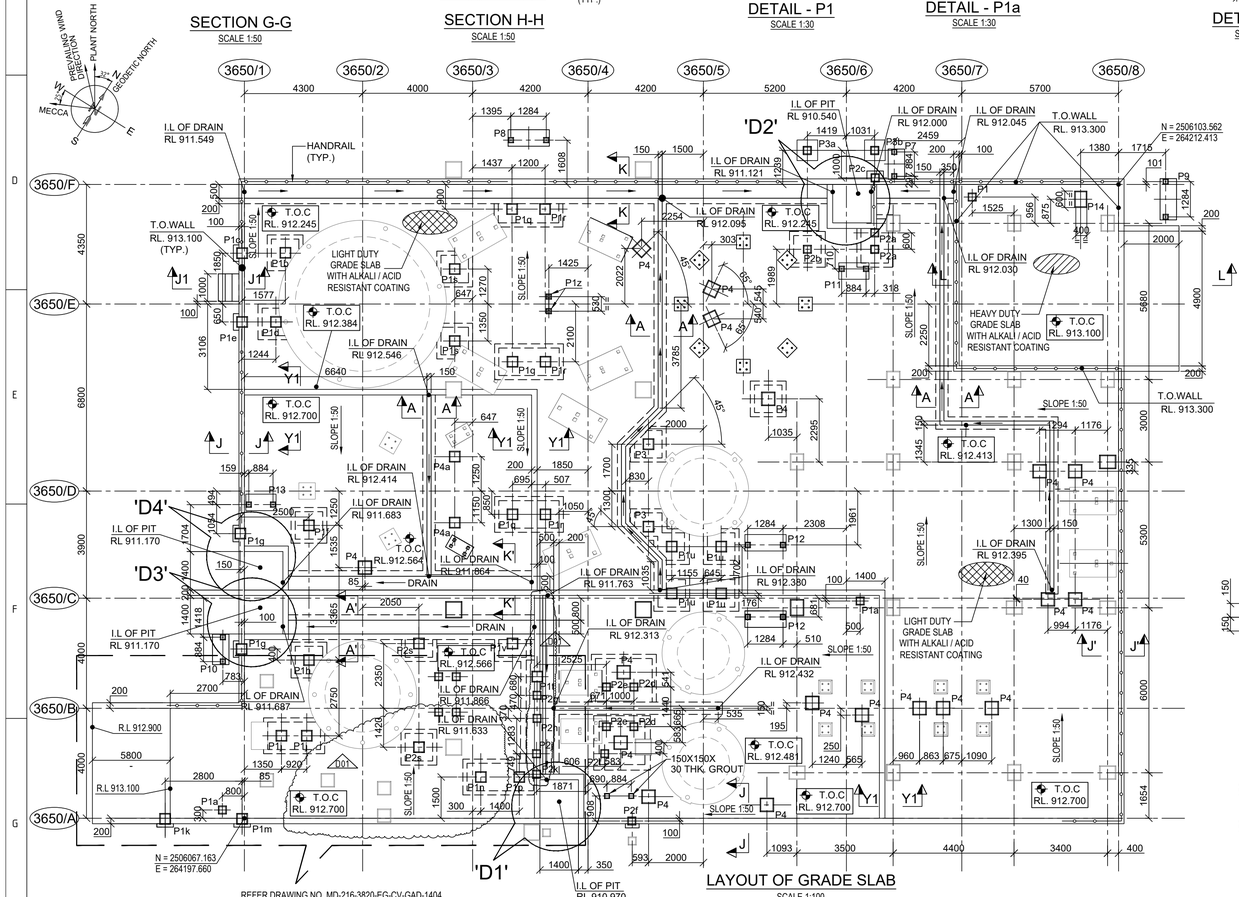


LAYOUT OF GRADE SLAB
SCALE 1:100

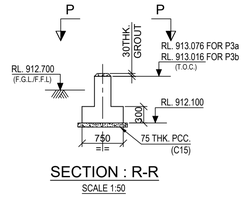


SECTION : R-R
SCALE 1:50

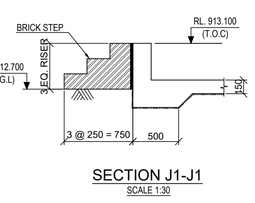


SECTION J1-J1
SCALE 1:30

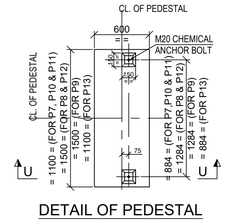


DETAIL OF PEDESTAL MKD. P7, P8, P9, P10, P11, P12 & P13
(PEDESTAL ORIENTATION TREATED AS PER LAYOUT PLAN)
(SCALE - 1:30)

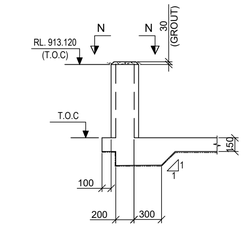


DETAIL - P1e
SCALE 1:30

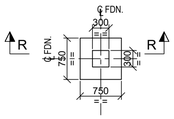


DETAIL OF FOUNDATION MKD. P3a & P3b
SCALE 1:50

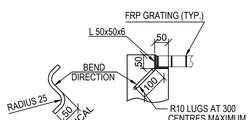


DETAIL - `D5'
(SCALE 1:10)
(TYPICAL)

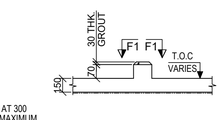


DETAIL OF P1z
SCALE 1:30

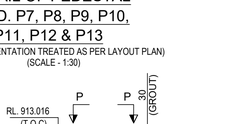


DETAIL - P2c
SCALE 1:30

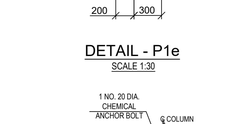


VIEW : F1-F1
SCALE 1:20

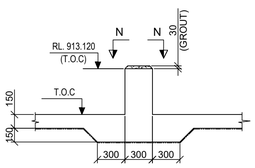


DETAIL - P1d
SCALE 1:30

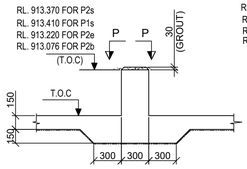


DETAIL - P2b, P2e, P1s & P2s
SCALE 1:30

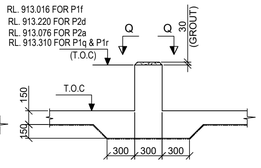


DETAIL - P1f, P1q, P1r, P2d, P2a & P3
SCALE 1:30

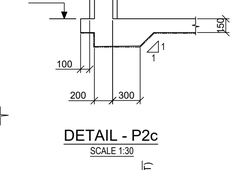


DETAIL - P2f
SCALE 1:30

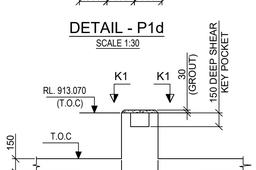

DETAIL - P1u
SCALE 1:30

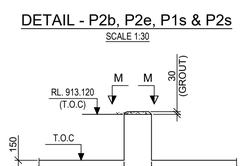

DETAIL - P1b
SCALE 1:30

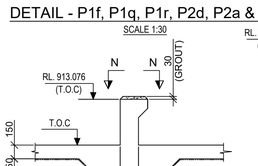

DETAIL - P2k
SCALE 1:30

LEGEND :-

CJ - CONSTRUCTION JOINT
F.G.L - FINISHED GROUND LEVEL
F.F.L - FINISHED FLOOR LEVEL
R.L - REDUCED LEVEL
I.L - INVERT LEVEL
THK. - THICK
T.O.C - TOP OF CONCRETE
DIA - DIAMETER
DRG. - DRAWING
CL. - CENTRE LINE
T.O.WALL - TOP OF WALL

NOTES:-

1. ALL DIMENSIONS ARE IN MILLIMETRES AND LEVELS AND CO-ORDINATES ARE IN METRES UNLESS OTHERWISE STATED.
2. FOR DETAILS OF GRADE SLAB REFER DRG. NO. MD-216-1000-EG-CV-DED-1002.
3. THIS DRAWING IS TO BE READ IN CONJUNCTION WITH DRAWING NO. MD-216-3820-EG-CV-GAD-1404. MD-216-3650-EG-CV-DED-1342.
4. FOR EMBEDED ELECTRICAL CONDUITS REFER SEPERATE DRAWING.

DOCUMENT NUMBER	REFERENCE DOCUMENTS	REV	DATE	REVISION DESCRIPTION	DRN	CHK	ENG	APP	EMP
MD-216-3650-EG-ST-GAD-2287	POX ACID WASH, ELUTN. AND CARBON REGN. PLAN, ELEVATION AND DETAILS								
MD-216-1000-EG-ST-CRT-1001	CIVIL, STRUCTURAL & ARCHITECTURAL - DESIGN CRITERIA	D01	18/02/2023	AS-BUILT	NAEW-SK	SJM	SOR	AG	
MD-216-3650-EG-ME-GAD-1015	POX ACID WASH/ELUTION/CARBON REGENERATION, PLAN AT EL. +912.700	C02	13/02/2021	ISSUED FOR CONSTRUCTION & REVISED AS MARKED C02	SYA	SJM	SOR	AG	
MD-216-3650-EG-CV-GAD-1001	POX ACID WASH-ELUTION AND CARBON REGENERATION, PLAN AT EL. +912.700	C01	22/12/2020	ISSUED FOR CONSTRUCTION & REVISED AS MARKED C01	SYA	SJM	SOR	AG	
		A01	19/10/2020	ISSUED FOR REFERENCE	SYA	SJM	SOR	AG	

RESERVED FOR VENDOR LOGO AND DRAWING NUMBER

LARSEN & TOUBRO

This drawing is the property of LARSEN & TOUBRO and must not be passed on to any person or body not authorized by us to receive it nor be copied or otherwise made use either in full or in part by such person or body without our prior permission in writing.

Outotec

The content of these documents are the sole property of Outotec Oyj. Any rights not expressly granted herein are reserved. Reproduction, transfer or distribution of part or all of the contents in any form without prior written permission of Outotec is prohibited.

MA'ADEN معادن
Saudi Arabian Mining Company شركة معادن العربية السعودية

This document and the information contained herein is Ma'aden proprietary know-how. This document or any part thereof should not be reproduced, stored in a retrieval system or transmitted by any means, electronic or otherwise, or divulged without prior written permission of Ma'aden.

LARSEN & TOUBRO DRAWING NUMBER			REVISION
019045_450_C_G_24559_002			3
OUTOTEC DRAWING NUMBER		DOCUMENT ID	REVISION
900707 __GAU01 __EE12 __MTL01 __36544		OU100704153	3
DRAWN	SYA	15/10/2020	MANSOURAH - MASSARAH GOLD PROJECT
CHECKED	SJM	17/10/2020	GENERAL ARRANGEMENT DRAWING
ENGINEER	SOR	15/10/2020	POX ACID WASH,ELUTION AND CARBON REGENERATION
APPROVED	AG	19/10/2020	DETAILS OF GRADE SLAB
EMPLOYER			
SCALE	1:50, 1:25, 1:20	A1	DRAWING NUMBER: MD - 216 - 3650 - EG - CV - GAD - 1335
			REV: D01