




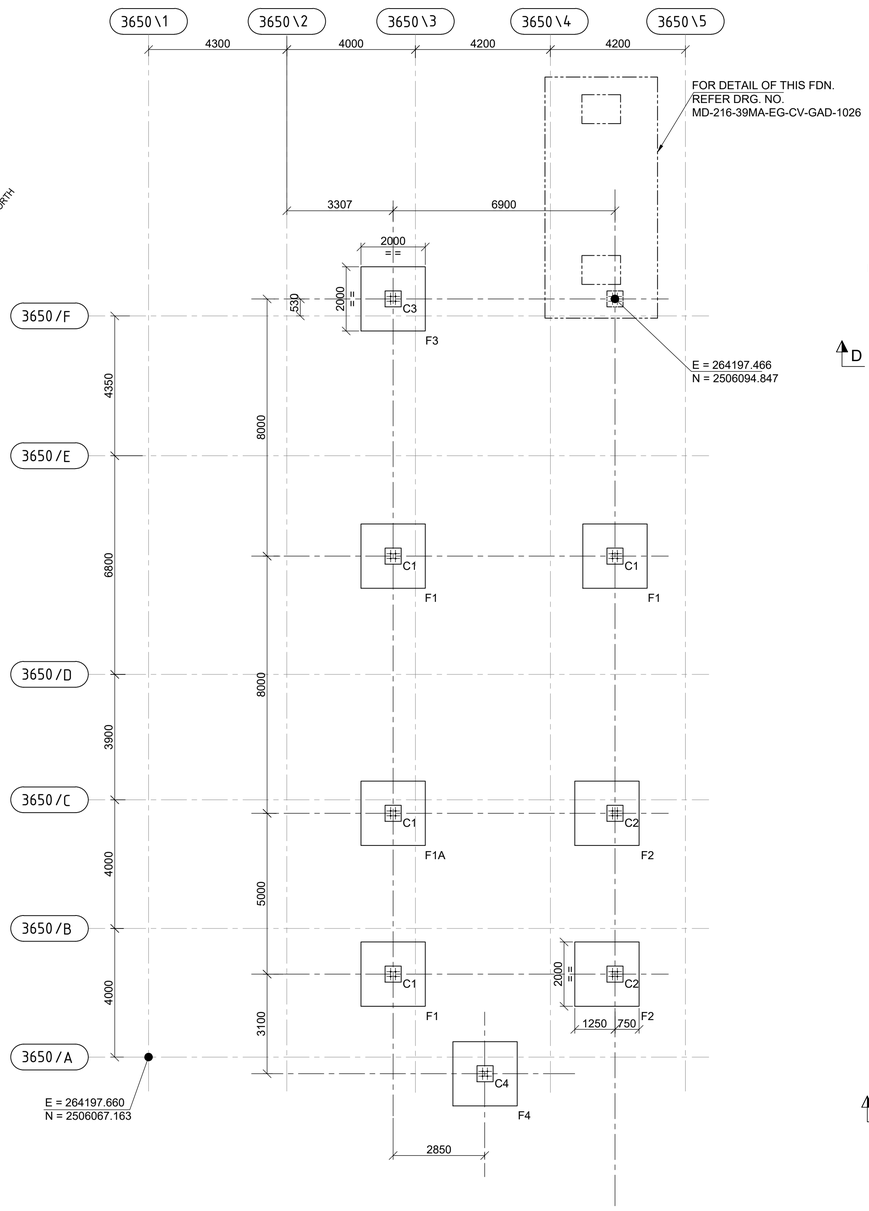


LAYOUT OF FOUNDATION
SCALE 1:100

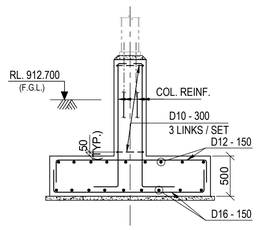


SECTION : D-D
SCALE 1:40

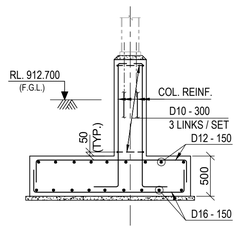


SECTION : E-E
SCALE 1:40

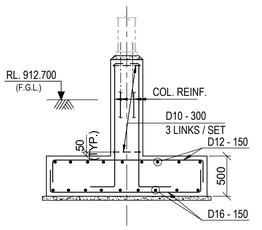


SECTION : F-F
SCALE 1:40

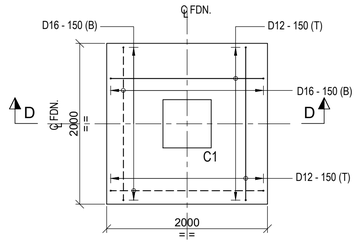


RCC. DETAIL OF
FOUNDATION MKD. F1 & F1A
SCALE 1:40

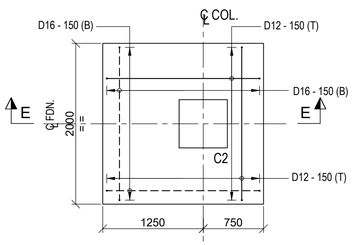


RCC. DETAIL OF
FOUNDATION MKD. F2
SCALE 1:40

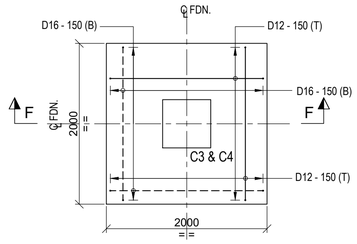


RCC. DETAIL OF
FOUNDATION MKD. F3 & F4
SCALE 1:40

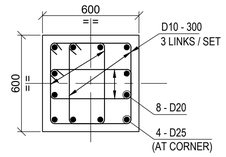


RCC. DET. OF C1, C2, C3 & C4
SCALE 1:20

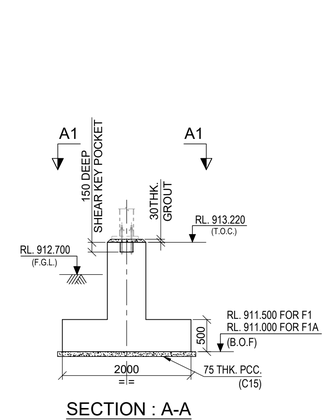


SECTION : A-A
SCALE 1:50

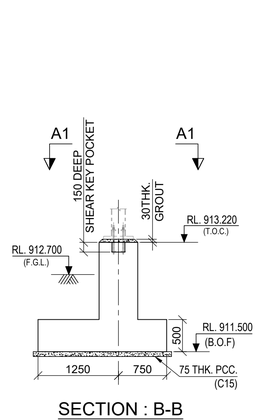


SECTION : B-B
SCALE 1:50

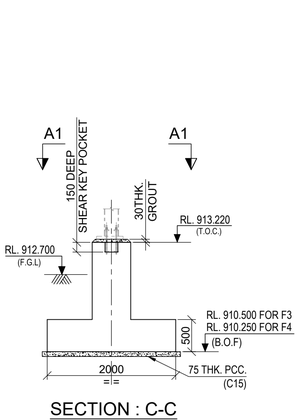


SECTION : C-C
SCALE 1:50

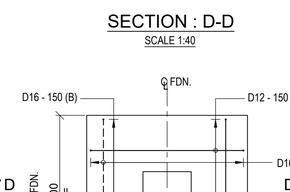


DETAIL OF FOUNDATION
MKD. F1 & F1A
SCALE 1:50

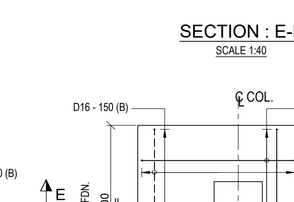

DETAIL OF FOUNDATION
MKD. F2
SCALE 1:50

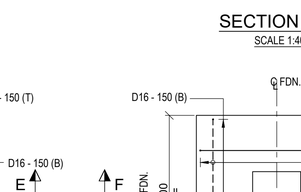

DETAIL OF FOUNDATION
MKD. F3 & F4
SCALE 1:50

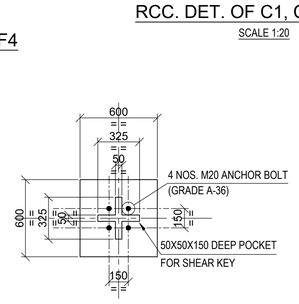


VIEW : A1-A1
SCALE 1:25

LEGEND :-

R.L. - REDUCED LEVEL
℄ - CENTRE LINE
T.O.C. - TOP OF CONCRETE
F.G.L. - FINISHED GROUND LEVEL
F.F.L. - FINISHED FLOOR LEVEL
B.O.F. - BOTTOM OF FOUNDATION
TYP. - TYPICAL
P.C.C - PLAIN CEMENT CONCRETE
THK. - THICK
T.O.G. - TOP OF GROUT
DET. - DETAIL
DRG. - DRAWING
FDN. - FOUNDATION
R.C.C - REINFORCED CEMENT CONCRETE
BOTTOM REINFORCEMENT (B) -
TOP REINFORCEMENT (T) -
COL. - COLUMN
REINF. - REINFORCEMENT
GA - GENERAL ARRANGEMENT

NOTES:-

1. ALL DIMENSIONS ARE IN MILLIMETRES AND LEVELS AND CO-ORDINATES ARE IN METRES UNLESS OTHERWISE STATED.
2. NET SAFE BEARING CAPACITY OF SOIL AT BOTTOM OF FOUNDATION IS CONSIDERED AS 350KN/ SQ. M.
3. GRADE OF CONCRETE SHALL BE C35 (35Mpa) FOR FOUNDATION, C30 (30Mpa) FOR GRADE SLAB & C15 (15Mpa) FOR BLINDING CONCRETE.
4. GRADE OF REINFORCEMENT SHALL BE DEFORMED BAR 420 MPa (GRADE 60) - ASTM A615/A615M.
5. CLEAR COVER TO REINFORCEMENT SHALL BE AS FOLLOWS
   a) FOUNDATION = 50 mm
   b) COLUMN = 50mm
6. IF ANY PART OF FOUNDATION COMES ON BACKFILL ZONE OF ADJACENT FOUNDATION OR ANY LOOSE SOIL ARE ENCOUNTERED BELOW FOUNDATION LEVEL THE SAME SHALL BE REMOVED AND FILLED WITH PCC.
7. FOR STANDARD REINFORCEMENT DETAIL & GENERAL NOTES FOR CIVIL WORKS REFER DRAWING NO. MD-216-1000-EG-CV-DED-1005 & 1001.

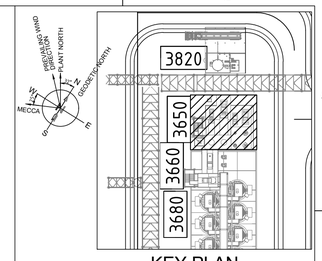

KEY PLAN
SCALE 1:1000

DOCUMENT NUMBER	REFERENCE DOCUMENTS	REV	DATE	REVISION DESCRIPTION	DRN	CHK	ENG	APP	EMP
		D01	22/02/2023	AS-BUILT	SYA	SJM	SOR	AG	
		C04	24/12/2020	ISSUED FOR CONSTRUCTION & REVISED AS MARKED C04	SYA	SJM	SOR	AG	
MD-216-3650-EG-ST-GAD-2290	POX ACID WASH, ELUTN. & CARBON REGN. PLAN, ELEVATION & DETAILS	C03	01/12/2020	ISSUED FOR CONSTRUCTION & REVISED AS MARKED C03	SYA	SJM	SOR	AG	
MD-216-1000-EG-ST-CRT-1001	CIVIL, STRUCTURAL & ARCHITECTURAL - DESIGN CRITERIA	C02	20/11/2020	ISSUED FOR CONSTRUCTION & REVISED AS MARKED C02	SYA	SJM	SOR	AG	
MD-216-3650-EG-ME-GAD-1015	POX ACID WASH/ELUTION/CARBON REGENERATION, PLAN AT EL. +912.700	C01	19/11/2020	ISSUED FOR CONSTRUCTION & REVISED AS MARKED C01	SYA	SJM	SOR	AG	
MD-216-3650-EG-CV-GAD-1001	POX ACID WASH-ELUTION AND CARBON REGENERATION, PLAN AT EL. +912.700	A01	19/10/2020	ISSUED FOR REFERENCE	SYA	SJM	SOR	AG	

RESERVED FOR VENDOR LOGO AND DRAWING NUMBER

LARSEN & TOUBRO
This drawing is the property of LARSEN & TOUBRO and must not be passed on to any person or body not authorized by us to receive it nor be copied or otherwise made use either in full or in part by such person or body without our prior permission in writing.

Outotec
The content of these documents are the sole property of Outotec Oyj. Any rights not expressly granted herein are reserved. Reproduction, transfer or distribution of part or all of the contents in any form without prior written permission of Outotec is prohibited.

MA'ADEN معادن
Saudi Arabian Mining Company شركة التعدين العربية السعودية
This document and the information contained herein is Ma'aden proprietary know-how. This document or any part thereof should not be reproduced, stored in a retrieval system or transmitted by any means, electronic or otherwise, or divulged without prior written permission of Ma'aden.

LARSEN & TOUBRO DRAWING NUMBER	019045_450_C_G_24559_004	REVISION 5
OUTOTEC DRAWING NUMBER	900707 __GAU01 __EE12 __MTL01 __36546	DOCUMENT ID OU100704155 / REVISION 5

DRAWN	SYA	15/10/2020
CHECKED	SJM	17/10/2020
ENGINEER	SOR	15/10/2020
APPROVED	AG	19/10/2020
EMPLOYER		
SCALE	1:50, 1:25, 1:20	A1

MANSOURAH - MASSARAH GOLD PROJECT
GENERAL ARRANGEMENT DRAWING
POX ACID WASH,ELUTION AND CARBON REGENERATION
G.A AND DETAILS OF FDN. FOR MONORAIL STRUCTURE

DRAWING NUMBER MD-216-3650-EG-CV-GAD-1337 REV D01