

DRAWING NUMBER: MD - 216 - 3650 - EG - CV - GAD - 1338 | REV: D01

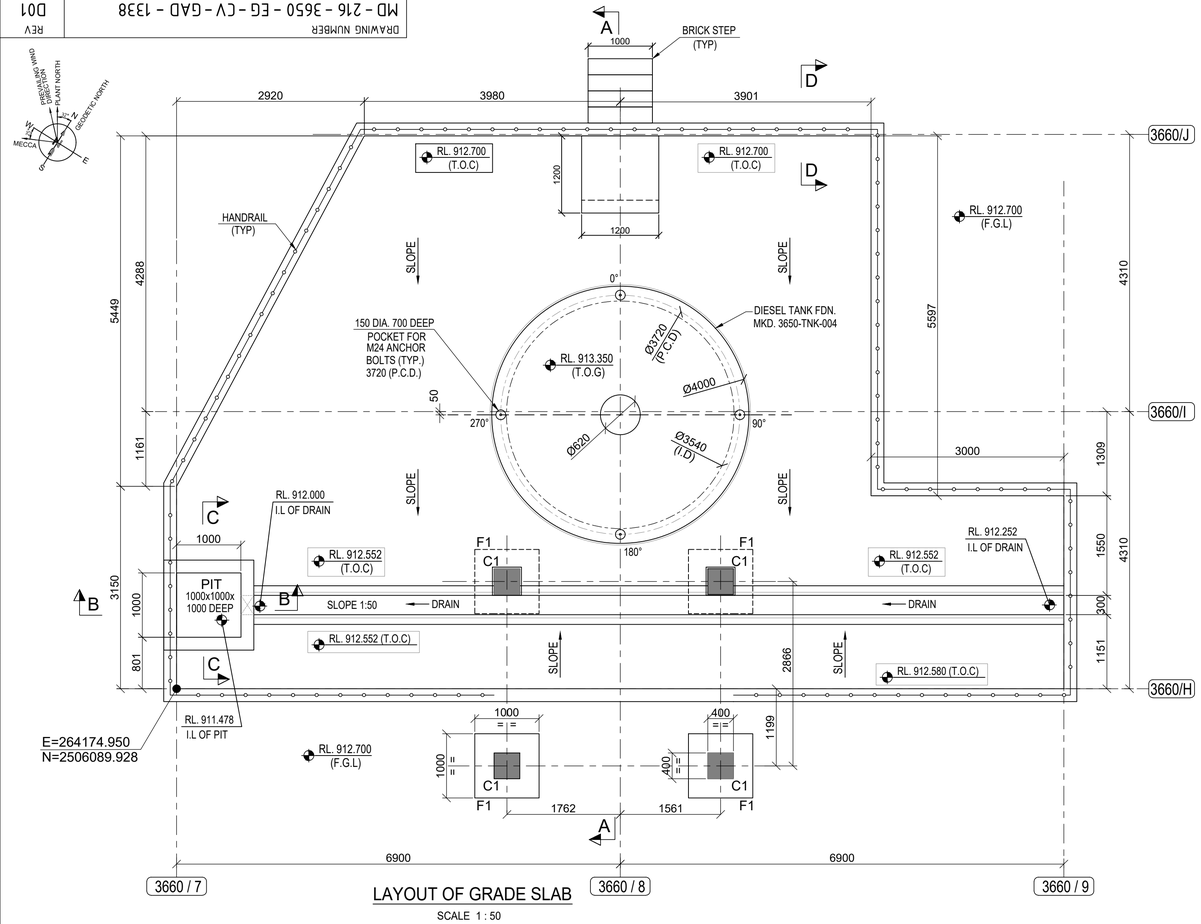


LAYOUT OF GRADE SLAB

SCALE 1 : 50

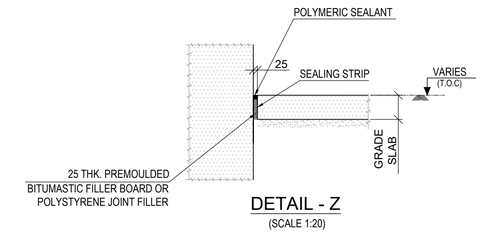


DETAIL - Z

(SCALE 1:20)

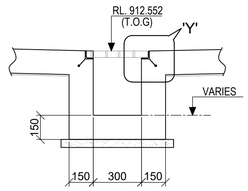


DETAIL - X

(SCALE 1:20)

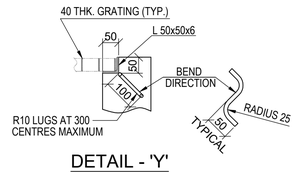


DETAIL - 'Y'

(SCALE 1:10)

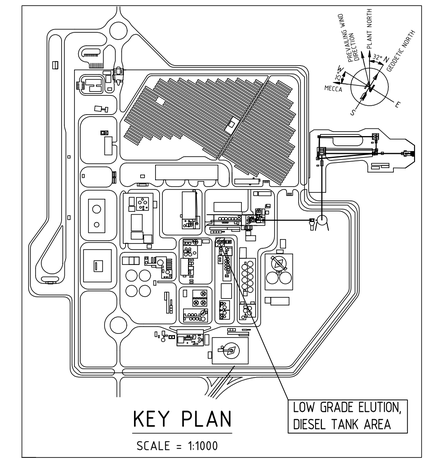


KEY PLAN

SCALE = 1:1000

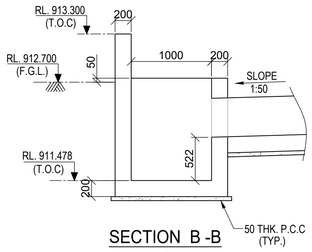


SECTION B -B

SCALE 1 : 40

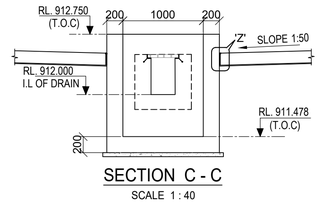


SECTION C - C

SCALE 1 : 40

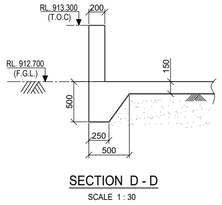

SECTION D - D

SCALE 1 : 30

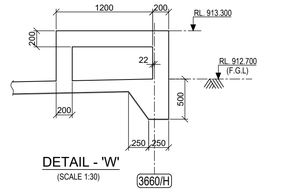

DETAIL - 'W'

(SCALE 1:30)


3660/H

LEGEND :-

CJ - CONSTRUCTION JOINT
F.G.L - FINISHED GROUND LEVEL
F.F.L - FINISHED FLOOR LEVEL
R.L. - REDUCED LEVEL
I.L - INVERT LEVEL
THK. - THICK
T.O.C - TOP OF CONCRETE
DIA - DIAMETER
DRG. - DRAWING
OPP - OPPOSITE
RC - REINFORCED CONCRETE
DET. - DETAIL
FDN. - FOUNDATION
MKD. - MARKED
TYP. - TYPICAL
℄ - CENTRE LINE
Ø - DIAMETER
R - RADIUS
T.O.G. - TOP OF GRATING


NOTES:-

1. ALL DIMENSIONS ARE IN MILLIMETRES AND LEVELS AND CO-ORDINATES ARE IN METRES UNLESS OTHERWISE STATED.
2. NET SAFE BEARING CAPACITY OF SOIL AT BOTTOM OF FOUNDATION IS CONSIDERED AS 250 KN/ SQM.
3. GRADE OF CONCRETE SHALL BE C35 (35Mpa) FOR FOUNDATION, C30 (30Mpa) FOR GRADE SLAB & C15 (15Mpa) FOR BLINDING CONCRETE.
4. GRADE OF REINFORCEMENT SHALL BE DEFORMED BAR 420 MPa (GRADE 60) - ASTM A615/A615M.
5. FOR STANDARD REINFORCEMENT DETAIL & GENERAL NOTES FOR CIVIL WORKS REFER DRAWING NO. MD-216-1000-EG-CV-DED-1005 & 1001.
6. CLEAR COVER TO MAIN REINFORCEMENT SHALL BE FOUNDATIONS = 50 MM., WALLS = 50 MM., GRADE SLAB = 25 MM.
7. IF ANY PART OF FOUNDATION COMES ON BACKFILL ZONE OF ADJACENT FOUNDATION OR ANY LOOSE SOIL ARE ENCOUNTERED BELOW FOUNDATION LEVEL THE SAME SHALL BE REMOVED AND FILLED WITH PCC.
8. BOLTS TO BE SUPPLIED BY EQUIPMENT SUPPLIER.
9. THIS DRG SHALL BE READ IN CONJUNCTION WITH DRG NO. MD-216-3650-EG-CV-DED-1345.
10. FOR DETAILS OF SLAB RE-ENTRANT REBARS REFER MD-101-SMEM-EG-ST-DST-0007 AND FOR SLAB JOINTS REFER MD-216-1000-EG-CV-DED-1002.

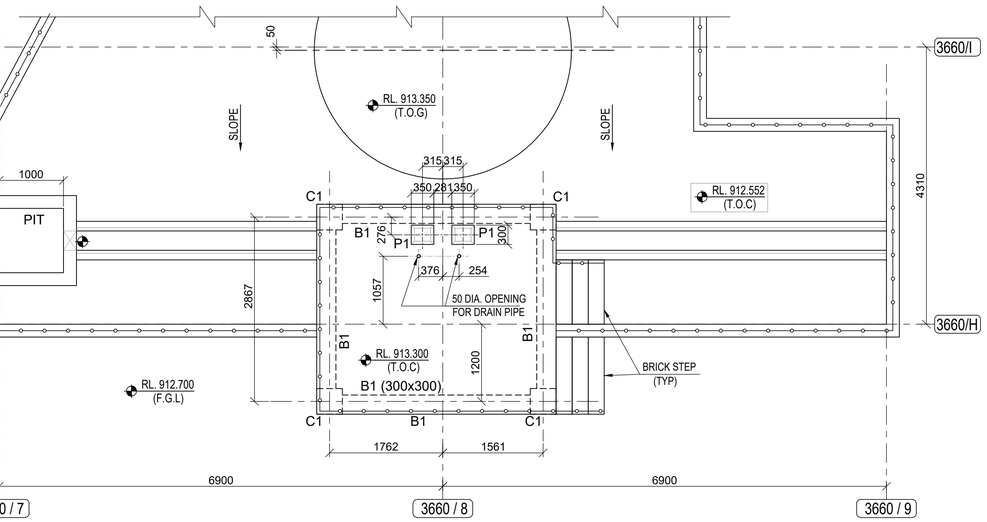

PLAN AT RL. 913.300 LEVEL

SCALE 1 : 50

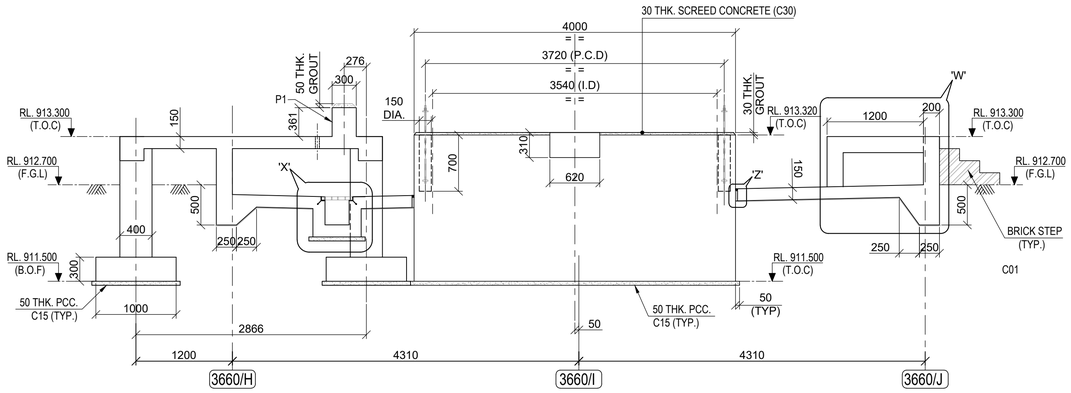

SECTION A - A

SCALE 1 : 40

DOCUMENT NUMBER	REFERENCE DOCUMENTS			REVISION DESCRIPTION	DRN	CHK	ENG	APP	EMP
MD-216-3650-EG-CV-GAD-1345	LOW GRADE ACID WASH, ELUTION, CARBON REGEN								
	RC DETAIL OF FOUNDATIONS AND GRADE SLAB								
MD-216-3650-EG-ME-GAD-V065-1001	GENERAL ARRANGEMENT DRAWING POX ACID WASH,								
	ELUTION AND CARBON REGENERATION DIESUL SUPPLY PUMPS 3650-PMP-003..004								
MD-216-3660-EG-ME-GAD-1066	LOW GRADE ACID WASH/ELUTION/CARBON REGEN.	D01	22/02/2023	AS-BUILT	AMJ	SJM	AVG	AG	
	HOT WATER BOILER HOUSE, PLAN EL.+ 913.200	C01	12/07/2021	ISSUED FOR CONSTUCTION & REVISED AS MKD. C01	AMJ	SJM	AVG	AG	
MD-216-1000-EG-ST-CRT-1001	CIVIL,STRUCTURAL AND ARCHITECTURAL DESIGN CRITERIA	A01	15/06/2021	ISSUED FOR REVIEW	AMJ	SJM	AVG	AG	

RESERVED FOR VENDOR LOGO AND DRAWING NUMBER

LARSEN & TOUBRO
This drawing is the property of LARSEN & TOUBRO and must not be passed on to any person or body not authorized by us to receive it nor be copied or otherwise made use either in full or in part by such person or body without our prior permission in writing.

Outotec
The content of these documents are the sole property of Outotec Oyj. Any rights not expressly granted herein are reserved. Reproduction, transfer or distribution of part or all of the contents in any form without prior written permission of Outotec is prohibited.

MA'ADEN معادن
Saudi Arabian Mining Company شركة التعدين العربية السعودية
This document and the information contained herein is Ma'aden proprietary know-how. This document or any part thereof should not be reproduced, stored in a retrieval system or transmitted by any means, electronic or otherwise, or divulged without prior written permission of Ma'aden.

LARSEN & TOUBRO DRAWING NUMBER: 019045_450_C_G_24559_005 | REVISION: 2
OUTOTEC DRAWING NUMBER: 900707 __GAU01 __EE12 __MTL01 __36556 | DOCUMENT ID: OU100723598 | REVISION: 2

DRAWN	AMJ	11/06/2021
CHECKED	SJM	13/06/2021
ENGINEER	AVG	11/06/2021
APPROVED	AG	15/06/2021
EMPLOYER		
SCALE	1:75, 1:25 & 1:15	A1

MANSOURAH - MASSARAH GOLD PROJECT
GENERAL ARRANGEMENT DRAWING
LOW GRADE ACID WASH, ELUTION, CARBON REGEN
LAYOUT & DETAILS OF FOUNDATIONS AND GRADE SLAB

DRAWING NUMBER: MD - 216 - 3650 - EG - CV - GAD - 1338 | REV: D01