


DRAWING NUMBER MD-216-49FE-EG-CV-DED-1631 REV D01

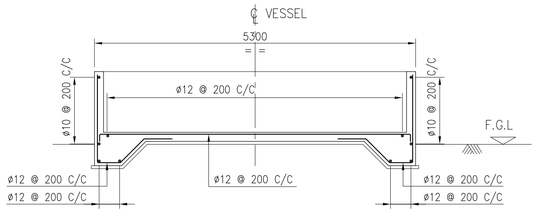


R.C. SECTION 3-3
(REFER SHEET #GAD-1638)
SCALE 1:50

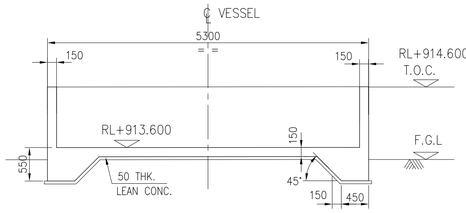


SECTION 3-3
(REFER SHEET #GAD-1638)
SCALE 1:50

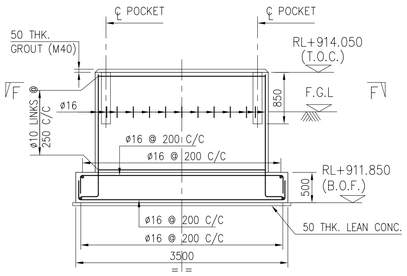


SECTION E-E
SCALE 1:50

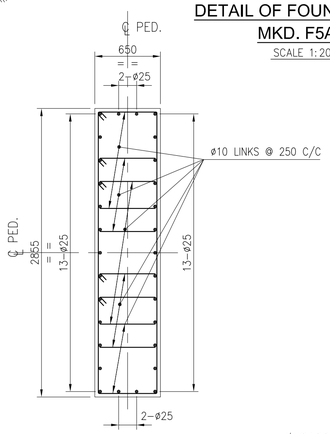


SECTION F-F
SCALE 1:30

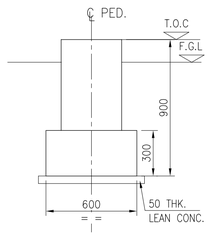


G.A. SECTION P-P
SCALE 1:20

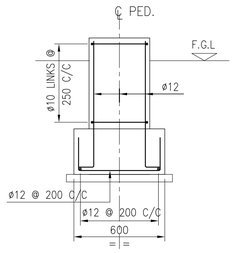


R.C. SECTION P-P
SCALE 1:20

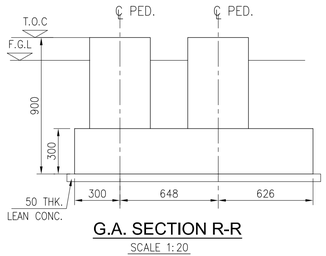


G.A. SECTION R-R
SCALE 1:20

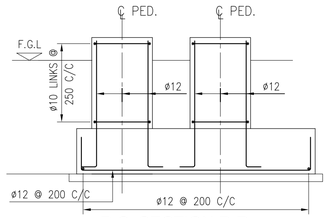


R.C. SECTION R-R
SCALE 1:20

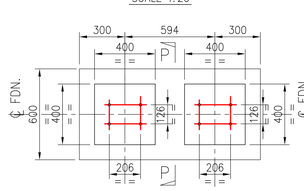


PLAN
DETAIL OF FOUNDATION
MKD. F5A
SCALE 1:20

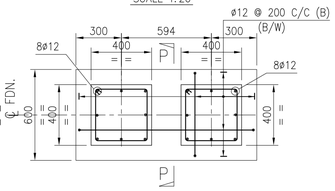


PLAN
R.C. DETAIL OF FOUNDATION
MKD. F5A
SCALE 1:20

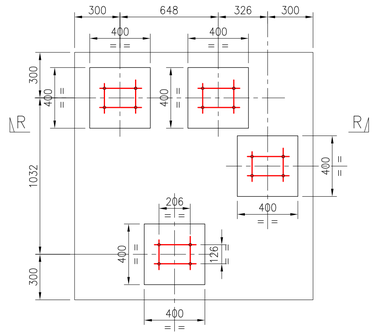


PLAN
DETAIL OF FOUNDATION
MKD. F8
SCALE 1:20

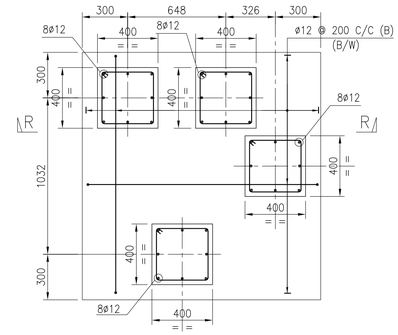


PLAN
DETAIL OF FOUNDATION
MKD. F8
SCALE 1:20

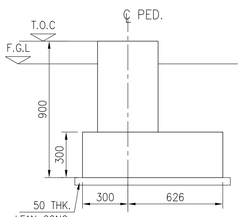


G.A. SECTION Q-Q
SCALE 1:20

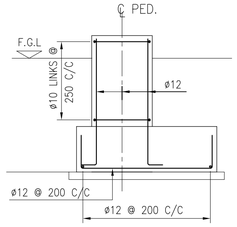


R.C. SECTION Q-Q
SCALE 1:20

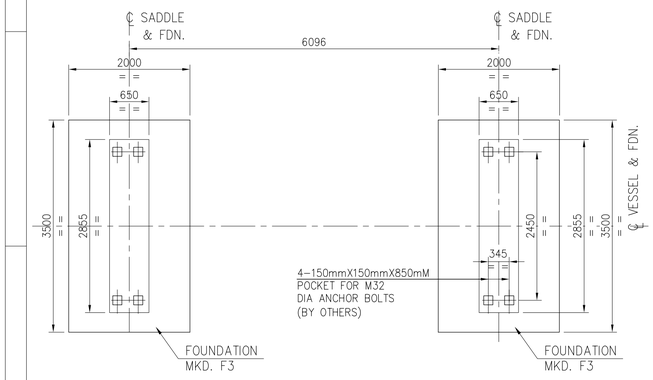


FOUNDATION LAYOUT PLAN F3
SCALE 1:50

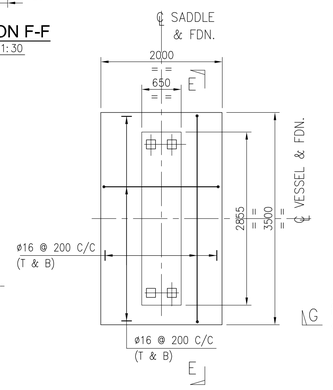


PLAN
R.C. DETAIL OF FOUNDATION MKD. F2
(2-NOS. REQUIRED)
SCALE 1:50

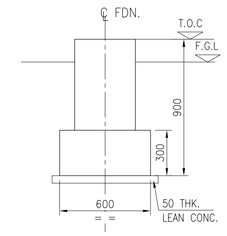


G.A. SECTION G-G
SCALE 1:20

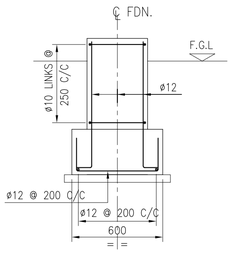


R.C. SECTION G-G
SCALE 1:20

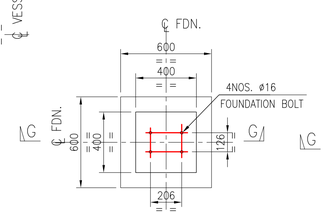


PLAN
DETAIL OF FOUNDATION
MKD. F4 TO F6, F10 TO F13
SCALE 1:20

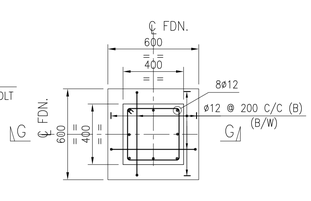

PLAN
R.C. DETAIL OF FOUNDATION
MKD. F4 TO F6, F10 TO F13
SCALE 1:20

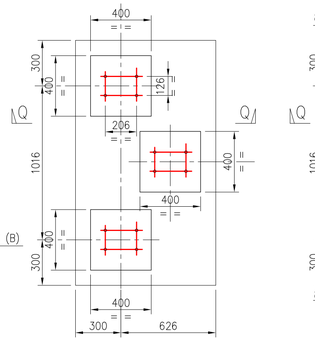

PLAN
DETAIL OF FOUNDATION
MKD. F7
SCALE 1:20

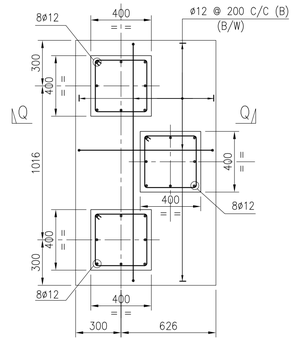

PLAN
DETAIL OF FOUNDATION
MKD. F7
SCALE 1:20

LEGENDS

F-FOUNDATION
FGL-FINISH GRADE LVL
REINF.-REINFORCEMENT
LVL.-LEVEL
MKD.-MARKED
ø- DIAMETER
TYP.-TYPICAL
THK.-THICK
T/O GROUT-TOP OF GROUT
C/C-CENTRE TO CENTRE
℄-CENTRE LINE
EL.-ELEVATION
R.C.-REINFORCED CONCRETE
T.O.C.-TOP OF CONCRETE
EQUIP.-EQUIPMENT
MISC.-MISCLLANEOUS
FDN.-FOUNDATION
B.O.F.-BOTTOM OF FOOTING
P.C.C.-PLAIN CEMENT CONCRETE
CONC.-CONCRETE
SPECS.-SPECIFICATION
F.F.L.-FINISHED FLOOR LEVEL

NOTES

1. ALL DIMENSIONS ARE GIVEN IN MILLIMETRES AND ELEVATIONS ARE IN METRES UNLESS OTHERWISE NOTED.
2. MINIMUM REINFORCED CONCRETE GRADE TO BE USED FOR SUPERSTRUCTURE & SUBSTRUCTURES IS M35(5000 PSI).
3. MINIMUM LEAN CONCRETE GRADE TO BE USED FOR THE SUB-STRUCTURES IS M15(2175 PSI).
4. ALL REINFORCING STEEL SHALL BE DEFORMED BILLET STEEL BARS CONFORMING TO ASTM-A615, WITH MINIMUM YIELD STRENGTH OF FY420 MPA .
5. THE NET SOIL BEARING CAPACITY CONSIDERED IN FOUNDATION DESIGN IS 350 KPA(REFER DOC 216-3000-EG-CV-CAL-1008-A02).
6. WATER PROOFING INSULATION SHALL BE AS PER PROJECT SPECS AND ITS MATERIAL TO BE APPROVED BY ENGINEER ON SITE.
7. THE MINIMUM CONCRETE COVER AS PER SBC-304-2018(TABLE 20.6.1.3.1) MEASURED FROM REBAR SHALL BE
   a) CONCRETE CAST AGAINST & PERMANENTLY EXPOSED TO EARTH (INCLUDING FOUNDATIONS OVER SUB-SLAB) FORMED CONCRETE EXPOSED TO EARTH OR WEATHER.....50MM
   b) CONCRETE NOT EXPOSED TO WEATHER NOR IN CONTACT WITH GROUND
      BEAMS, COLUMNS.....40MM
      SLABS, WALLS, JOISTS.....20MM
   c) CONCRETE SLAB OVER 50MM SUB-SLAB.....20MM
8. ALL DRAWINGS MUST BE READ IN CONJUNCTION WITH RELEVANT ARCHITECTURAL AND ENGINEERING DRAWINGS RELATED TO THE SAME SHEET AND ANY ITEM ON IT.
9. F.F.L +0.00 MENTIONED IS EQUIVALENT TO FINISH FLOOR LVL +913.50M AS PER THE CIVIL DRAWING CE-004A-OVERALL LAYOUT PLAN.

DOCUMENT NUMBER	REFERENCE DOCUMENT	REV	DATE	REVISION DESCRIPTION	DRN	CHK	ENG	APP	EMP
		D01	08/09/2023	AS-BUILT	TEC	AVG	TEC	SJM	
MD-216-49FE-EG-CV-GAD-1638	LAYOUT OF MISC. PIPE SUPPORTS OF EQUIP. FDN.	C01	01/03/2021	ISSUED FOR CONSTRUCTION	TEC	AVG	TEC	SJM	
MD-216-6000-EG-CV-STD-1001	REINFORCEMENT STANDARD	A01	14/01/2021	ISSUED FOR APPROVAL	TEC	AVG	TEC	SJM	

LARSEN & TOUBRO DRAWING NUMBER: O19045_080_C_D_24549_002 — REVISION: 2
OUTOTEC DRAWING NUMBER: 900707__GAU01__AG90__CTB05__50002 — DOCUMENT ID: OU100711127 — REVISION: 2

LARSEN & TOUBRO
This drawing is the property of LARSEN & TOUBRO and must not be passed on to any person or body not authorized by us to receive it nor be copied or otherwise made use either in full or in part by such person or body without our prior permission in writing.

Outotec
The content of these documents are the sole property of Outotec Oyj. Any rights not expressly granted herein are reserved. Reproduction, transfer or distribution of part or all of the contents in any form without prior written permission of Outotec is prohibited.

MA'ADEN معادن
Saudi Arabian Mining Company شركة التعدين العربية السعودية
This document and the information contained herein is Ma'aden proprietary know-how. This document or any part thereof should not be reproduced, stored in a retrieval system or transmitted by any means, electronic or otherwise, or divulged without prior written permission of Ma'aden.

DRAWN	TEC	12/01/2021	MANSOURAH - MASSARAH GOLD PROJECT
CHECKED	AVG	13/01/2021	DETAIL DRAWING
ENGINEER	TEC	12/01/2021	DISEL, PETROL & JET FUEL STORAGE AREA
APPROVED	SJM	14/01/2021	DETAILS OF MISC. PIPE SUPPORTS & EQUIP. FDN.
EMPLOYER			
SCALE 1:50,10	A1		DRAWING NUMBER: MD-216-49FE-EG-CV-DED-1631 — REV: D01