


DRAWING NUMBER MD-216-49FE-EG-CV-GAD-1628 REV D01

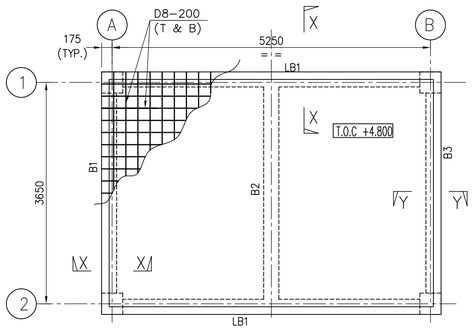


ROOF SLAB LAYOUT
SCALE 1:50

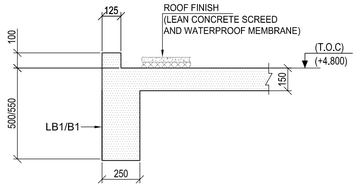


SECTION X-X
(SCALE 1:20)

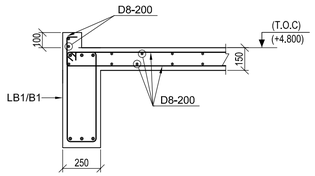


SECTION X-X
(SHOWING RC DETAIL)
(SCALE 1:20)

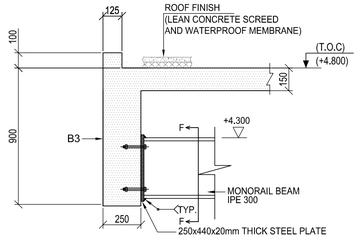

SECTION Y-Y
(SCALE 1:20)

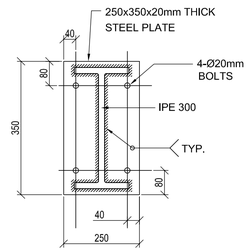


SECTION F-F
(SCALE 1:10)

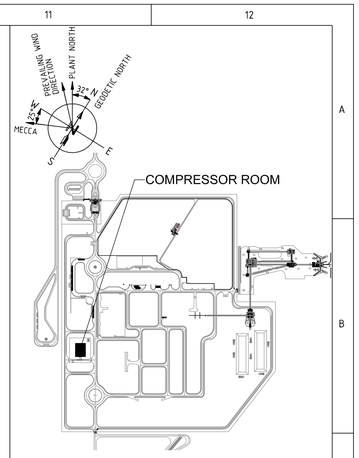

KEY PLAN


SCHEDULE OF ROOF BEAMS

BEAM MARK	DIMENSIONS		LEVEL	STEEL REINFORCEMENT				STIRRUPS	REMARKS
				BOTTOM		TOP			
	WIDTH	DEPTH	TOP OF BEAM	STRAIGHT	ADD.	STRAIGHT	ADD.		
LB1	250	550	EL (+) 4.800	3ø16	–	3ø16	–	PROVIDE ø10@200 BOTH IN THE END SPAN & MID SPAN	
B2	250	500	EL (+) 4.800	3ø16	–	2ø16	–	PROVIDE ø10@200 BOTH IN THE END SPAN & MID SPAN	
B1	250	500	EL (+) 4.800	3ø16	–	3ø16	–	PROVIDE ø10@200 BOTH IN THE END SPAN & MID SPAN	
B3	250	900	EL (+) 4.800	3ø16	–	3ø16	–	PROVIDE ø10@200 BOTH IN THE END SPAN & MID SPAN	

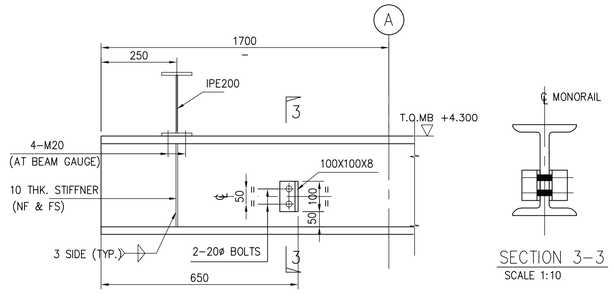


TYP. DETAIL OF MONORAIL STOPPER
SCALE 1:10


SECTION 3–3
SCALE 1:10

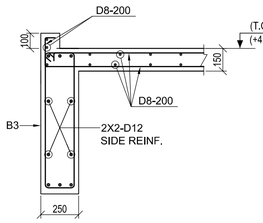


SECTION Y-Y
(SHOWING RC DETAIL)
(SCALE 1:20)

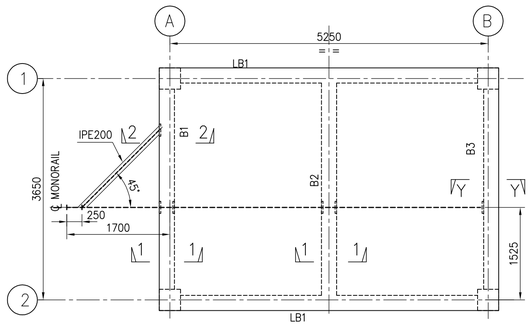


ROOF BEAM LAYOUT AT EL (+) 4.800
SCALE 1:50

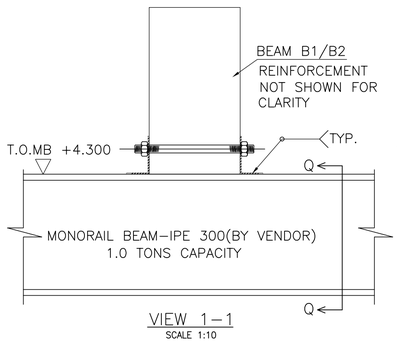


VIEW 1–1
SCALE 1:10

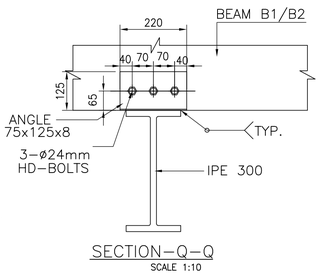

SECTION–Q–Q
SCALE 1:10

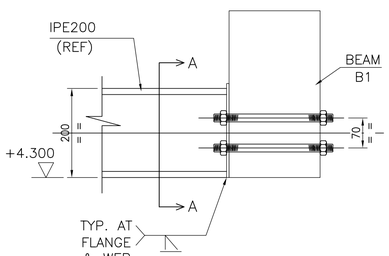

VIEW 2–2
SCALE 1:10

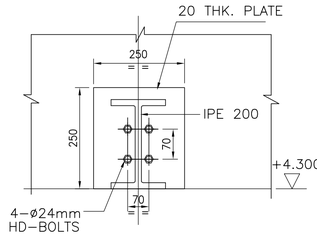

SECTION–A–A
SCALE 1:10

LEGENDS

F-FOUNDATION
CR-COLUMN NECK
C-COLUMN
FFL-FINISH FLOOR LVL
FGL-FINISH GRADE LVL
TOS-TOP OF SCREED
WWF-WELDED WIRE FABRIC
HCS-HOLLOW CORE SLAB
GB-GRADE BEAM
IJ-ISOLATION JOINT
CJ-CONTROL JOINT
GA-GALVANIZED
S.O.G-SLAB ON GRADE
ARCH-ARCHITECTURAL
HOR.-HORIZONTAL
REINF.-REINFORCEMENT
LVL.-LEVEL
MKD.-MARKED
ø- DIAMETER
TYP.-TYPICAL
THK.-THICK
T/O BEAM-TOP OF BEAM
C/C-CENTRE TO CENTRE
℄-CENTRE LINE
NF & FS -NEAR SIDE & FAR SIDE
HD BOLTS-HEAVY DUTY BOLTS
SPECS.-SPECIFICATION
DOC.-DOCUMENT

NOTES

1. ALL DIMENSIONS ARE GIVEN IN MILLIMETRES AND ELEVATIONS ARE IN METRES UNLESS OTHERWISE NOTED.
2. MINIMUM REINFORCED CONCRETE GRADE TO BE USED FOR SUPERSTRUCTURE & SUBSTRUCTURES IS M35(5000 PSI).
3. MINIMUM LEAN CONCRETE GRADE TO BE USED FOR THE SUB-STRUCTURES IS M15(2175 PSI).
4. ALL REINFORCING STEEL SHALL BE DEFORMED BILLET STEEL BARS CONFORMING TO ASTM-A615, WITH MINIMUM YIELD STRENGTH OF FY420 MPA .
5. THE NET SOIL BEARING CAPACITY CONSIDERED IN FOUNDATION DESIGN IS 350 KPA(REFER DOC 216-3000-EG-CV-CAL-1008-A02).
6. WATER PROOFING INSULATION SHALL BE AS PER PROJECT SPECS AND ITS MATERIAL TO BE APPROVED BY ENGINEER ON SITE.
7. THE MINIMUM CONCRETE COVER AS PER SBC-304-2018(TABLE 20.6.1.3.1) MEASURED FROM REBAR SHALL BE
   a) CONCRETE CAST AGAINST & PERMANENTLY EXPOSED TO EARTH (INCLUDING FOUNDATIONS OVER SUB-SLAB) FORMED CONCRETE EXPOSED TO EARTH OR WEATHER 50MM
   b) CONCRETE NOT EXPOSED TO WEATHER NOR IN CONTACT WITH GROUND BEAMS, COLUMNS.....40MM SLABS, WALLS, JOISTS.....20MM
   c) CONCRETE SLAB OVER 50MM SUB-SLAB.....20MM
8. ALL DRAWINGS MUST BE READ IN CONJUNCTION WITH RELEVANT ARCHITECTURAL AND ENGINEERING DRAWINGS RELATED TO THE SAME SHEET AND ANY ITEM ON IT.
9. F.F.L +0.00 MENTIONED IS EQUIVALENT TO FINISH FLOOR LVL +913.50M AS PER THE CIVIL DRAWING CE-004A-OVERALL LAYOUT PLAN.

DOCUMENT NUMBER	REFERENCE DOCUMENT	REV	DATE	REVISION DESCRIPTION	DRN	CHK	ENG	APP	EMP
		D01	21/7/2023	AS BUILT	SYA	SJM	AVG	AG	
		C02	17/02/2022	ISSUED FOR CONSTRUCTION & REVISED AS MARKED △C02	SYA	SJM	AVG	AG	
MD-216-49FE-EG-CV-GAD-1626	LAYOUT & DETAILS OF FDN, COL & GRADE BEAM	C01	27/11/2020	ISSUED FOR CONSTRUCTION	TEC	SJM	TEC	AG	
MD-216-6000-EG-CV-STD-1001	REINFORCEMENT STANDARD	A01	19/10/2020	ISSUED FOR APPROVAL	TEC	SJM	TEC	AG	

LARSEN & TOUBRO

This drawing is the property of LARSEN & TOUBRO and must not be passed on to any person or body not authorized by us to receive it nor be copied or otherwise made use either in full or in part by such person or body without our prior permission in writing.

Outotec

The content of these documents are the sole property of Outotec Oyj. Any rights not expressly granted herein are reserved. Reproduction, transfer or distribution of part or all of the contents in any form without prior written permission of Outotec is prohibited.

MA'ADEN معادن
Saudi Arabian Mining Company شركة التعدين العربية السعودية

This document and the information contained herein is Ma'aden proprietary know-how. This document or any part thereof should not be reproduced, stored in a retrieval system or transmitted by any means, electronic or otherwise, or divulged without prior written permission of Ma'aden.

LARSEN & TOUBRO DRAWING NUMBER		REVISION
019045_080_C_G_24313_001		3
OUTOTEC DRAWING NUMBER	DOCUMENT ID	REVISION
900707__GAU01__AG50__MTL01__49034	0U100703977	3

DRAWN	TEC	19/11/2020
CHECKED	SJM	20/11/2020
ENGINEER	TEC	19/11/2020
APPROVED	AG	20/11/2020
EMPLOYER		
SCALE	1:50,10	A1

MANSOURAH - MASSARAH GOLD PROJECT
GENERAL ARRANGEMENT DRAWING
FUEL STORAGE FACILITY-COMPRESSOR ROOM
LAYOUT & DETAILS OF ROOF

DRAWING NUMBER: MD-216-49FE-EG-CV-GAD-1628 REV: D01

D01 20/7/2023 AS BUILT