

DRAWING NUMBER MD-216-49FE-EG-CV-GAD-1629 REV D01

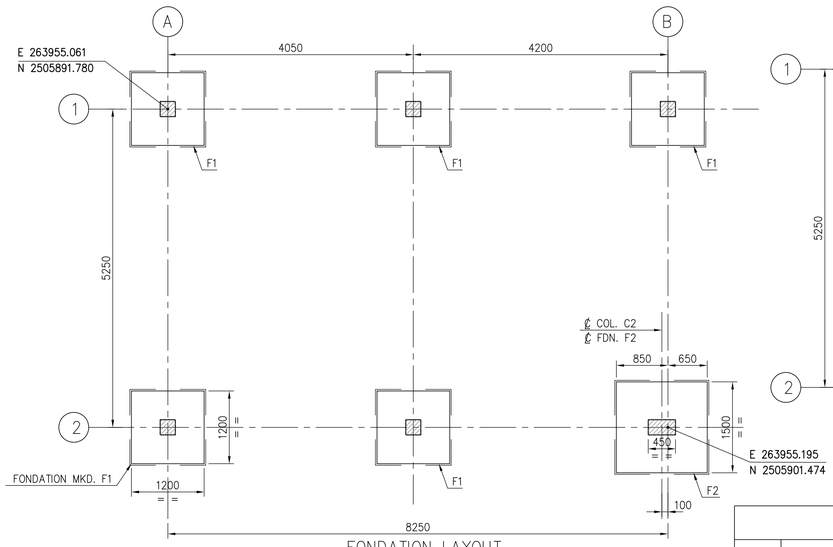

FONDATION LAYOUT

SCALE 1:50

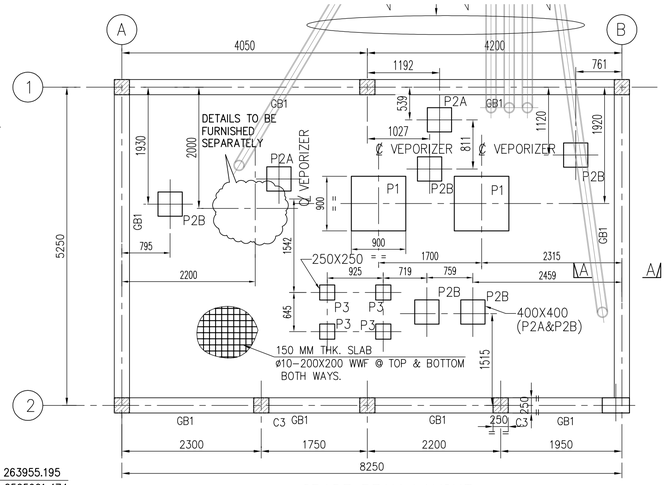


GRADE BEAM LAYOUT


SCALE 1:50

BEAM MARK	DIMENSIONS		STEEL REINFORCEMENT				STIRRUPS	REMARKS
			BOTTOM		TOP			
	WIDTH	DEPTH	STRAIGHT	ADD.	STRAIGHT	ADD.		
GB1	250	700	3ø16	–	3ø16	–	PROVIDE ø10@150	

FOOTING MARK	LEAN CONCRETE			REINFORCED CONCRETE			BOTTOM REINFORCEMENT		TOP REINFORCEMENT		Ha	REMARKS
	L	W	T	L	W	T	SHORT BARS	LONG BARS	SHORT BARS	LONG BARS		
F1	1400	1400	50	1200	1200	400	ø16@200	ø16@200	–	–	1200	
F2	1700	1700	50	1500	1500	400	ø16@200	ø16@200	–	–	1200	

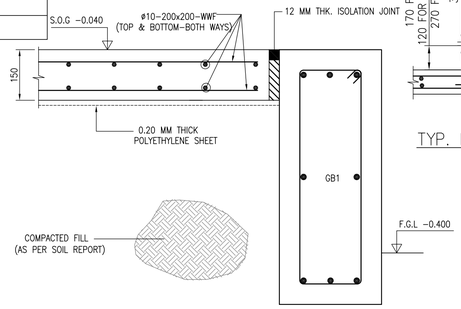


TYP SECTION FOR GRADE SLAB

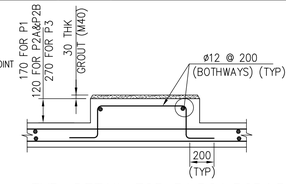


TYP. DETAIL FOR P1,P2A,P2B&P3

SCALE 1:25

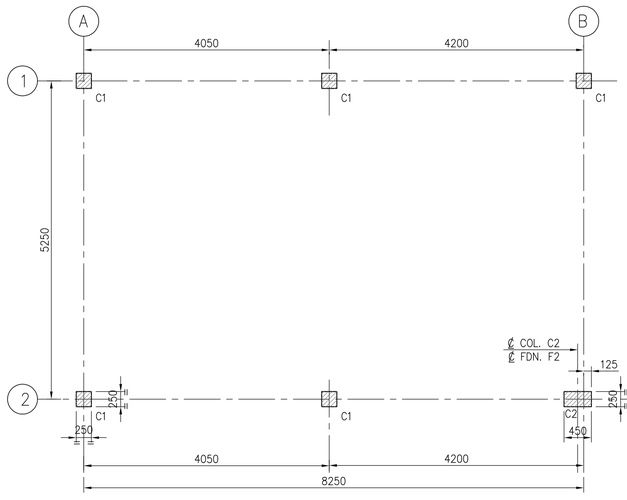


COLUMN LAYOUT

SCALE 1:50

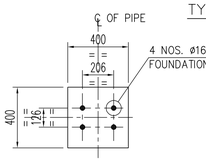


BOLT DETAIL FOR P2A

SCALE 1:20

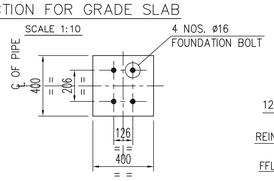


BOLT DETAIL FOR P2B

SCALE 1:20

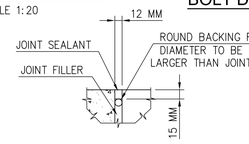


TYP. JOINT SEAL DETAIL-C

SCALE 1:5

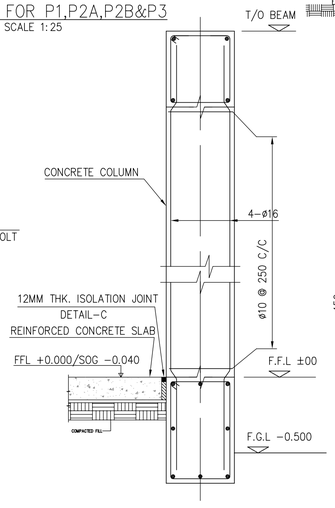


DETAIL OF COL. C3

SCALE 1:20

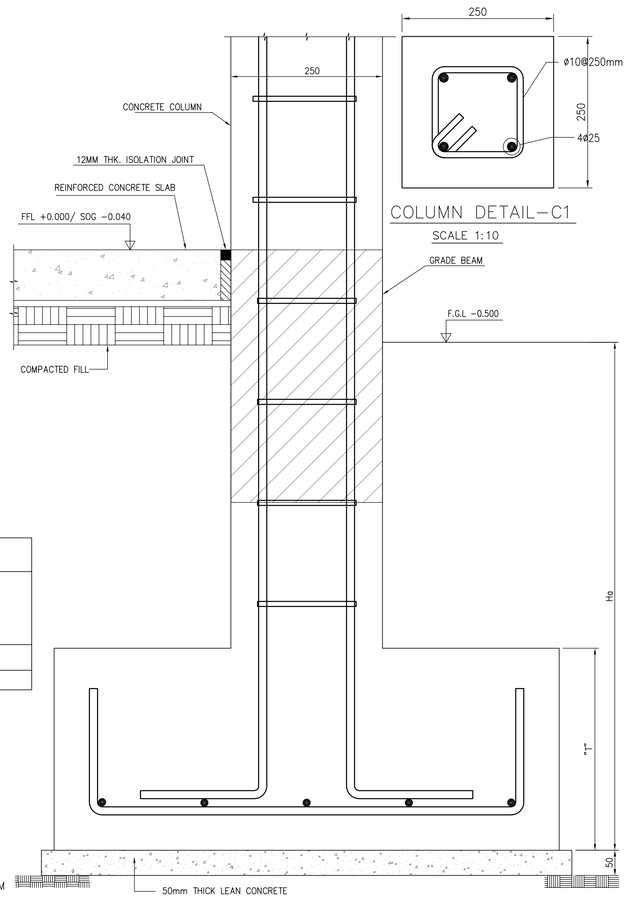


FOUNDATION SECTION

SCALE 1:10

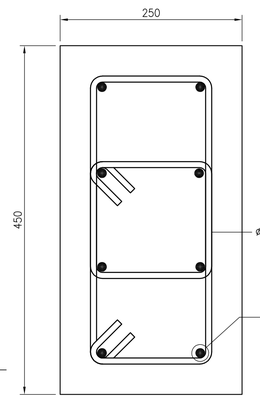


COLUMN DETAIL-C2

SCALE 1:10

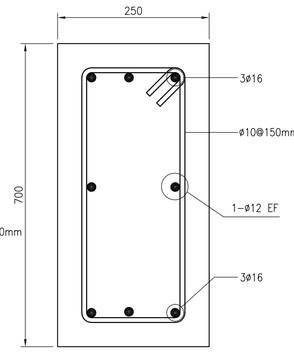

GRADE BEAM-GB1

SCALE 1:10

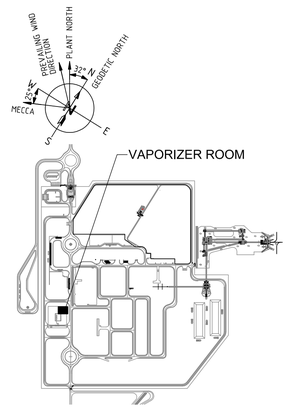

KEY PLAN

LEGENDS

F-FOUNDATION
CR-COLUMN NECK
C-COLUMN
FFL-FINISH FLOOR LVL
FGL-FINISH GRADE LVL
TOS-TOP OF SCREED
WWF-WELDED WIRE FABRIC
HCS-HOLLOW CORE SLAB
GB-GRADE BEAM
I.J-ISOLATION JOINT
C.J-CONTROL JOINT
GA-GALVANIZED
S.O.G-SLAB ON GRADE
ARCH-ARCHITECTURAL
HOR.-HORIZONTAL
REINF.-REINFORCEMENT
LVL.-LEVEL
MKD.-MARKED
ø- DIAMETER
TYP.-TYPICAL
THK.-THICK
T/O BEAM-TOP OF BEAM
C/C-CENTRE TO CENTRE
℄-CENTRE LINE
SPECS.-SPECIFICATION
DOC.-DOCUMENT
FDN.-FOUNDATION
COL.-COLUMN

NOTES

1. ALL DIMENSIONS ARE GIVEN IN MILLIMETRES AND ELEVATIONS ARE IN METRES UNLESS OTHERWISE NOTED.
2. MINIMUM REINFORCED CONCRETE GRADE TO BE USED FOR SUPERSTRUCTURE & SUBSTRUCTURES IS M35(5000 PSI).
3. MINIMUM LEAN CONCRETE GRADE TO BE USED FOR THE SUB-STRUCTURES IS M15(2175 PSI).
4. ALL REINFORCING STEEL SHALL BE DEFORMED BILLET STEEL BARS CONFORMING TO ASTM-A615, WITH MINIMUM YIELD STRENGTH OF FY420 MPA .
5. THE NET SOIL BEARING CAPACITY CONSIDERED IN FOUNDATION DESIGN IS 350 KPA(REFER DOC 216-3000-EG-CV-CAL-1008-A02).
6. WATER PROOFING INSULATION SHALL BE AS PER PROJECT SPECS AND ITS MATERIAL TO BE APPROVED BY ENGINEER AT SITE.
7. THE MINIMUM CONCRETE COVER AS PER SBC-304-2018(TABLE 20.6.1.3.1) MEASURED FROM REBAR SHALL BE
   a) CONCRETE CAST AGAINST & PERMANENTLY EXPOSED TO EARTH (INCLUDING FOUNDATIONS OVER SUB-SLAB) FORMED CONCRETE EXPOSED TO EARTH OR WEATHER.....50MM
   b) CONCRETE NOT EXPOSED TO WEATHER NOR IN CONTACT WITH GROUND BEAMS, COLUMNS.....40MM SLABS, WALLS, JOISTS.....20MM
   c) CONCRETE SLAB OVER 50MM SUB-SLAB.....20MM
8. ALL DRAWINGS MUST BE READ IN CONJUNCTION WITH RELEVANT ARCHITECTURAL AND ENGINEERING DRAWINGS RELATED TO THE SAME SHEET AND ANY ITEM ON IT.
9. F.F.L +0.00 MENTIONED IS EQUIVALENT TO FINISH FLOOR LVL +913.50M AS PER THE CIVIL DRAWING CE-004A-OVERALL LAYOUT PLAN.

DOCUMENT NUMBER	REFERENCE DOCUMENT	REV	DATE	REVISION DESCRIPTION	DRN	CHK	ENG	APP	EMP
		D01	06/09/2023	AS-BUILT	TEC	AVG	TEC	SJM	
		C02	14/04/2021	ISSUED FOR CONSTRUCTION & REVISED AS MARKED △C02	TEC	AVG	TEC	SJM	
MD-216-6000-EG-CV-STD-1002	HOLLOW CORE SLAB STANDARD	C01	27/11/2020	ISSUED FOR CONSTRUCTION	TEC	SJM	TEC	AG	
MD-216-6000-EG-CV-STD-1001	REINFORCEMENT STANDARD	A01	19/10/2020	ISSUED FOR APPROVAL	TEC	SJM	TEC	AG	

LARSEN & TOUBRO

This drawing is the property of *LARSEN & TOUBRO* and must not be passed on to any person or body not authorized by us to receive it nor be copied or otherwise made use either in full or in part by such person or body without our prior permission in writing.

Outotec

The content of these documents are the sole property of Outotec Oyj. Any rights not expressly granted herein are reserved. Reproduction, transfer or distribution of part or all of the contents in any form without prior written permission of Outotec is prohibited.

MA'ADEN معادن
Saudi Arabian Mining Company شركة التعدين العربية السعودية

This document and the information contained herein is Ma'aden proprietary know-how. This document or any part thereof should not be reproduced, stored in a retrieval system or transmitted by any means, electronic or otherwise, or divulged without prior written permission of Ma'aden.

DRAWN	TEC	19/11/2020
CHECKED	SJM	20/11/2020
ENGINEER	TEC	19/11/2020
APPROVED	AG	20/11/2020
EMPLOYER		
SCALE	1:50,10	A1

LARSEN & TOUBRO DRAWING NUMBER: 019045_080_C_G_24313_002 — REVISION: 3

OUTOTEC DRAWING NUMBER: 900707__GAU01__AG50__MTL01__49035 — DOCUMENT ID: OU100703978 — REVISION: 3

MANSOURAH - MASSARAH GOLD PROJECT
GENERAL ARRANGEMENT DRAWING
FUEL STORAGE FACILITY-VAPORIZER ROOM
LAYOUT & DETAILS OF FDN, COL & GRADE BEAM

DRAWING NUMBER: MD-216-49FE-EG-CV-GAD-1629 — REV: D01