


DRAWING NUMBER: MD-216-49FE-EG-CV-GAD-1630 | REV: D01

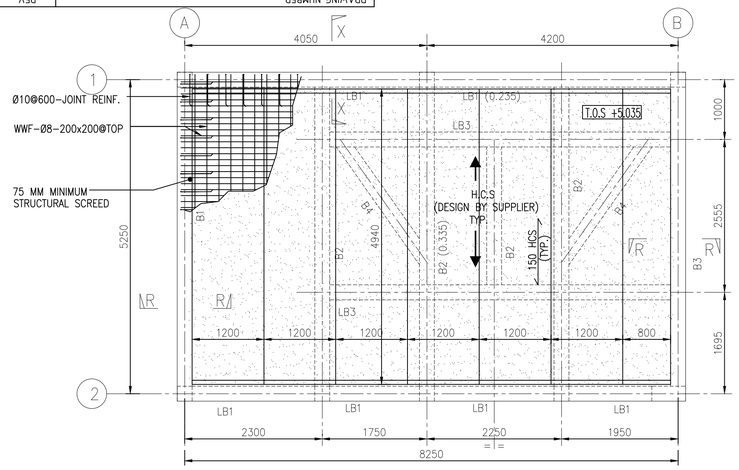


ROOF HOLLOW CORE SLAB LAYOUT
SCALE 1:50

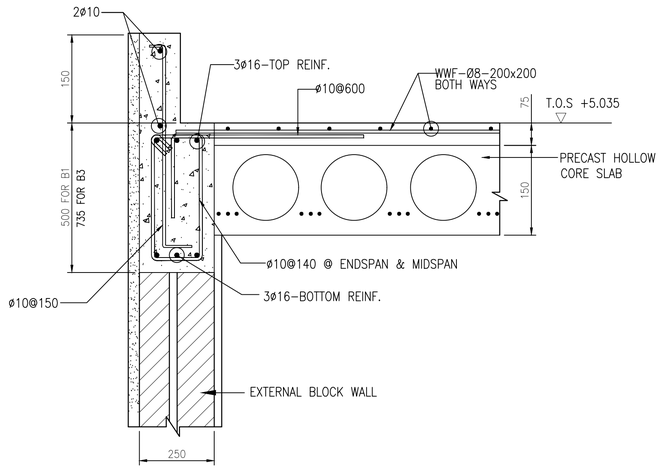

TYPICAL DETAIL FOR DROP BEAM (B1) (R / –)
SCALE 1:20

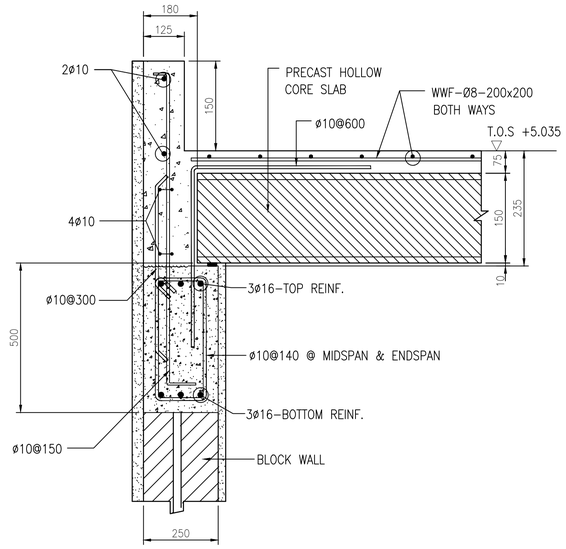


TYPICAL HCS CONNECTION WITH LEDGER BEAM(LB1) (X / –)
SCALE 1:20

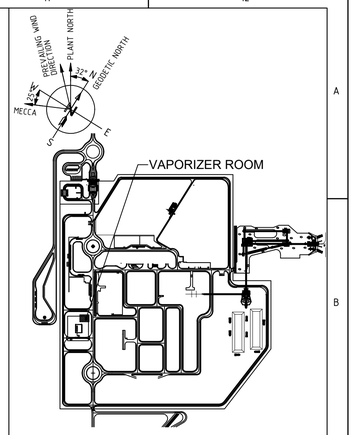


KEY PLAN

SCHEDULE OF ROOF BEAMS

BEAM MARK	DIMENSIONS		LEVEL	STEEL REINFORCEMENT				STIRRUPS	REMARKS
				BOTTOM		TOP			
	WIDTH	DEPTH	TOP OF BEAM	STRAIGHT	ADD.	STRAIGHT	ADD.		
LB1	250	500	EL (+) 4.800	3ø16	–	3ø16	–	PROVIDE ø10@140 BOTH IN THE END SPAN & MID SPAN	REFER DETAIL-X
LB3	250	400	EL (+) 4.700	3ø16	–	3ø16	–	PROVIDE ø10@140 BOTH IN THE END SPAN & MID SPAN	
B1	250	500	EL (+) 5.035	3ø16	–	3ø16	–	PROVIDE ø10@140 BOTH IN THE END SPAN & MID SPAN	REFER DETAIL-R
B2	250	400	EL (+) 4.700	3ø16	–	3ø16	–	PROVIDE ø10@140 BOTH IN THE END SPAN & MID SPAN	
B3	250	735	EL (+) 5.035	3ø16	–	3ø16	–	PROVIDE ø10@140 BOTH IN THE END SPAN & MID SPAN	REFER DETAIL-R
B4	250	400	EL (+) 4.700	3ø16	–	3ø16	–	PROVIDE ø10@140 BOTH IN THE END SPAN & MID SPAN	

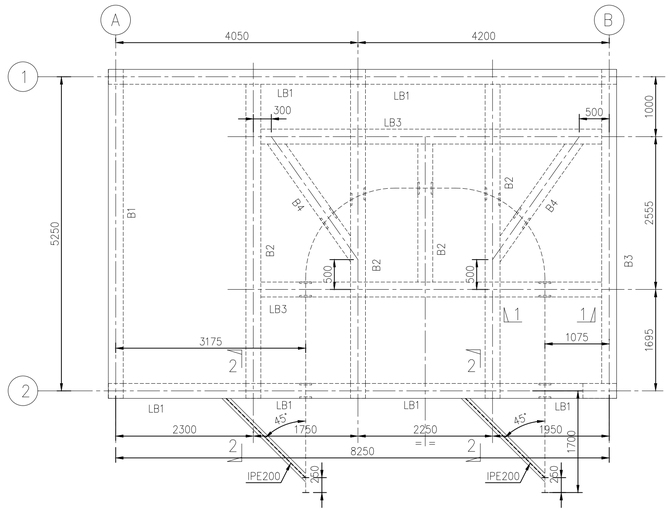


ROOF BEAM LAYOUT AT EL (+) 5.035
SCALE 1:50

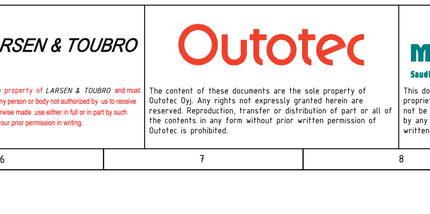


TYP. DETAIL OF MONORAIL STOPPER
SCALE 1:10

SECTION 3-3
SCALE 1:10


SECTION-A-A
SCALE 1:10

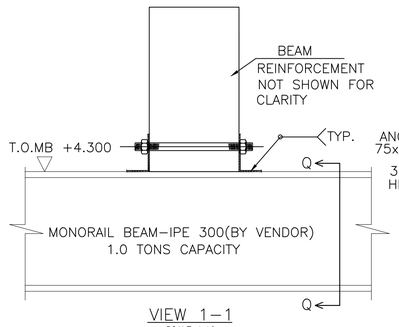

VIEW 1-1
SCALE 1:10

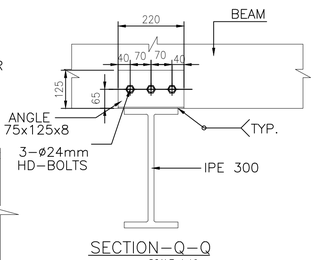

SECTION-Q-Q
SCALE 1:10

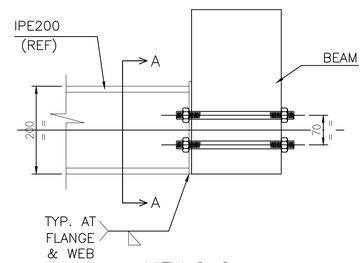

VIEW 2-2
SCALE 1:10

LEGENDS

F-FOUNDATION
CR-COLUMN NECK
C-COLUMN
FFL-FINISH FLOOR LVL
FGL-FINISH GRADE LVL
TOS-TOP OF SCREED
WWF-WELDED WIRE FABRIC
HCS-HOLLOW CORE SLAB
GB-GRADE BEAM
IJ-ISOLATION JOINT
CJ-CONTROL JOINT
GA-GALVANIZED
S.O.G-SLAB ON GRADE
ARCH-ARCHITECTURAL
HOR.-HORIZONTAL
REINF.-REINFORCEMENT
LVL.-LEVEL
MKD.-MARKED
Ø- DIAMETER
TYP.-TYPICAL
THK.-THICK
T/O BEAM-TOP OF BEAM
C/C-CENTRE TO CENTRE
℄-CENTRE LINE
SPECS.-SPECIFICATION
DOC.-DOCUMENT
HD BOLTS-HEAVY DUTY BOLTS
EL.-ELEVATION

NOTES

1. ALL DIMENSIONS ARE GIVEN IN MILLIMETRES AND ELEVATIONS ARE IN METRES UNLESS OTHERWISE NOTED.
2. MINIMUM REINFORCED CONCRETE GRADE TO BE USED FOR SUPERSTRUCTURE & SUBSTRUCTURES IS M35(5000 PSI).
3. MINIMUM LEAN CONCRETE GRADE TO BE USED FOR THE SUB-STRUCTURES IS M15(2175 PSI).
4. ALL REINFORCING STEEL SHALL BE DEFORMED BILLET STEEL BARS CONFORMING TO ASTM-A615, WITH MINIMUM YIELD STRENGTH OF FY420 MPA .
5. THE NET SOIL BEARING CAPACITY CONSIDERED IN FOUNDATION DESIGN IS 350 KPA(REFER DOC 216-3000-EG-CV-CAL-1008-A02).
6. WATER PROOFING INSULATION SHALL BE AS PER PROJECT SPECS AND ITS MATERIAL TO BE APPROVED BY ENGINEER ON SITE.
7. THE MINIMUM CONCRETE COVER AS PER SBC-304-2018(TABLE 20.6.1.3.1) MEASURED FROM REBAR SHALL BE
   a) CONCRETE CAST AGAINST & PERMANENTLY EXPOSED TO EARTH (INCLUDING FOUNDATIONS OVER SUB-SLAB) FORMED CONCRETE EXPOSED TO EARTH OR WEATHER.....50MM
   b) CONCRETE NOT EXPOSED TO WEATHER NOR IN CONTACT WITH GROUND
      BEAMS, COLUMNS.....40MM
      SLABS, WALLS, JOISTS.....20MM
   c) CONCRETE SLAB OVER 50MM SUB-SLAB.....20MM
8. ALL DRAWINGS MUST BE READ IN CONJUNCTION WITH RELEVANT ARCHITECTURAL AND ENGINEERING DRAWINGS RELATED TO THE SAME SHEET AND ANY ITEM ON IT.
9. F.F.L +0.00 MENTIONED IS EQUIVALENT TO FINISH FLOOR LVL +913.50M AS PER THE CIVIL DRAWING CE-004A-OVERALL LAYOUT PLAN.

DOCUMENT NUMBER	REFERENCE DOCUMENT	REV	DATE	REVISION DESCRIPTION	DRN	CHK	ENG	APP	EMP
		D01	06/09/2023	AS-BUILT	PML	SJM	AVG	AG	
		C03	06/07/2022	ISSUED FOR CONSTRUCTION	PML	SJM	AVG	AG	
		C02	14/09/2021	ISSUED FOR CONSTRUCTION & REVISED AS MARKED △C02	SYA	SJM	AVG	AG	
MD-216-6000-EG-CV-STD-1002	HOLLOW CORE SLAB STANDARD	C01	27/11/2020	ISSUED FOR CONSTRUCTION	TEC	SJM	TEC	AG	
MD-216-6000-EG-CV-STD-1001	REINFORCEMENT STANDARD	A01	19.10.2020	ISSUED FOR APPROVAL	TEC	SJM	TEC	AG	

LARSEN & TOUBRO

This drawing is the property of LARSEN & TOUBRO and must not be passed on to any person or body not authorized by us to receive it nor be copied or otherwise made use either in full or in part by such person or body without our prior permission in writing.

Outotec

The content of these documents are the sole property of Outotec Oyj. Any rights not expressly granted herein are reserved. Reproduction, transfer or distribution of part or all of the contents in any form without prior written permission of Outotec is prohibited.

MA'ADEN معادن
Saudi Arabian Mining Company شركة التعدين العربية السعودية

This document and the information contained herein is Ma'aden proprietary know-how. This document or any part thereof should not be reproduced, stored in a retrieval system or transmitted by any means, electronic or otherwise, or divulged without prior written permission of Ma'aden.

LARSEN & TOUBRO DRAWING NUMBER	019045_080_C_G_24313_003		REVISION 4
OUTOTEC DRAWING NUMBER	900707__GAU01__AG50__MTL01__49036	DOCUMENT ID OU100703979	REVISION 4
DRAWN	TEC	19/11/2020	MANSOURAH - MASSARAH GOLD PROJECT
CHECKED	SJM	20/11/2020	GENERAL ARRANGEMENT DRAWING
ENGINEER	TEC	19/11/2020	FUEL STORAGE FACILITY-VAPORIZER ROOM
APPROVED	AG	20/11/2020	LAYOUT & DETAILS OF ROOF
EMPLOYER			
SCALE	1:50,10	A1	DRAWING NUMBER MD-216-49FE-EG-CV-GAD-1630 REV D01