


DRAWING NUMBER MD-216-49FE-EG-CV-GAD-1635 REV D01

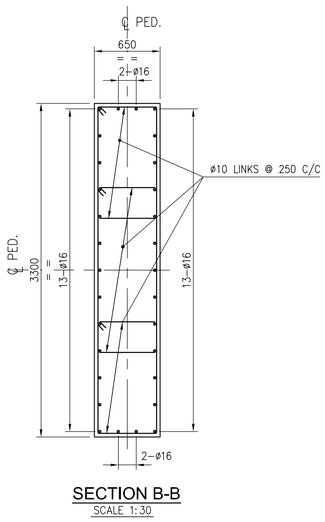


SECTION B-B
SCALE 1:30

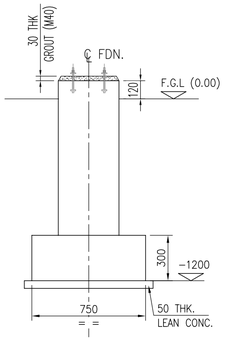


G.A. SECTION C-C
SCALE 1:20

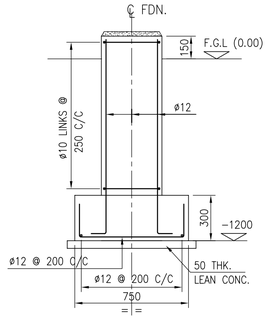


R.C. SECTION C-C
SCALE 1:20

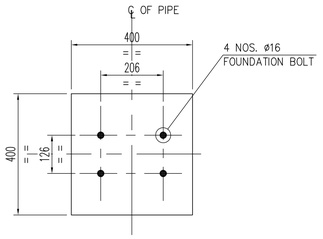


BOLT DETAIL FOR F2A
SCALE 1:10

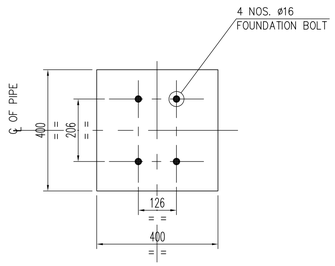


BOLT DETAIL FOR F2B
SCALE 1:10

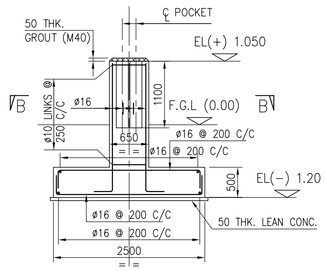


SECTION A-A
SCALE 1:50

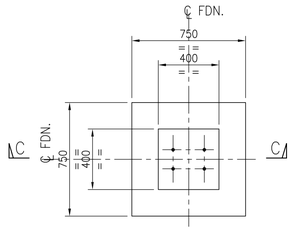


PLAN
DETAIL OF FOUNDATION MKD. F2A & F2B
(50-NOS. REQUIRED)
SCALE 1:20

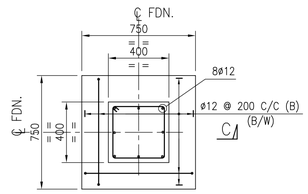

PLAN
R.C. DETAIL OF FOUNDATION MKD. F2
(50-NOS. REQUIRED)
SCALE 1:20

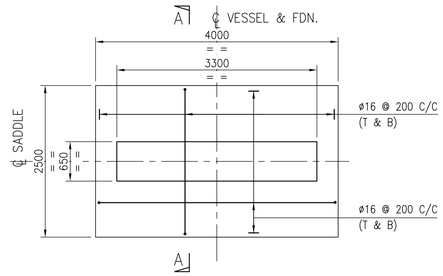

PLAN
R.C. DETAIL OF FOUNDATION MKD. F1
(2-NOS. REQUIRED)
SCALE 1:50

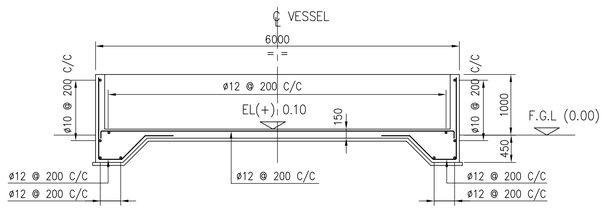

R.C. SECTION 1-1
TYP. CROSS SECTION OF DYKE WALL
SCALE 1:50

LEGENDS

F-FOUNDATION
CR-COLUMN NECK
C-COLUMN
FFL-FINISH FLOOR LVL
FGL-FINISH GRADE LVL
TOS-TOP OF SCREED
WWF-WELDED WIRE FABRIC
HCS-HOLLOW CORE SLAB
GB-GRADE BEAM
IJ-ISOLATION JOINT
CJ-CONTROL JOINT
GA-GALVANIZED
S.O.G-SLAB ON GRADE
ARCH-ARCHITECTURAL
HOR.-HORIZONTAL
REINF.-REINFORCEMENT
LVL.-LEVEL
MKD.-MARKED
Ø- DIAMETER
TYP.-TYPICAL
THK.-THICKNESS
T/O BEAM-TOP OF BEAM
C/C-CENTRE TO CENTRE
℄-CENTRE LINE
EL.-ELEVATION
SPECS.-SPECIFICATION
DOC.-DOCUMENT
CONC.-CONCRETE
FDN.-FOUNDATION
T & B-TOP & BOTTOM

NOTES

1. ALL DIMENSIONS ARE GIVEN IN MILLIMETRES AND ELEVATIONS ARE IN METRES UNLESS OTHERWISE NOTED.
2. MINIMUM REINFORCED CONCRETE GRADE TO BE USED FOR SUPERSTRUCTURE & SUBSTRUCTURES IS M35(5000 PSI).
3. MINIMUM LEAN CONCRETE GRADE TO BE USED FOR THE SUB-STRUCTURES IS M15(2175 PSI).
4. ALL REINFORCING STEEL SHALL BE DEFORMED BILLET STEEL BARS CONFORMING TO ASTM-A615, WITH MINIMUM YIELD STRENGTH OF FY420 MPA .
5. THE NET SOIL BEARING CAPACITY CONSIDERED IN FOUNDATION DESIGN IS 350 KPA(REFER DOC 216-3000-EG-CV-CAL-1008-A02).
6. WATER PROOFING INSULATION SHALL BE AS PER PROJECT SPECS AND ITS MATERIAL TO BE APPROVED BY ENGINEER AT SITE.
7. THE MINIMUM CONCRETE COVER AS PER SBC-304-2018(TABLE 20.6.1.3.1) MEASURED FROM REBAR SHALL BE
   a) CONCRETE CAST AGAINST & PERMANENTLY EXPOSED TO EARTH (INCLUDING FOUNDATIONS OVER SUB-SLAB) FORMED CONCRETE EXPOSED TO EARTH OR WEATHER.....50MM
   b) CONCRETE NOT EXPOSED TO WEATHER NOR IN CONTACT WITH GROUND
      BEAMS, COLUMNS.....40MM
      SLABS, WALLS, JOISTS.....20MM
   c) CONCRETE SLAB OVER 50MM SUB-SLAB.....20MM
8. ALL DRAWINGS MUST BE READ IN CONJUNCTION WITH RELEVANT ARCHITECTURAL AND ENGINEERING DRAWINGS RELATED TO THE SAME SHEET AND ANY ITEM ON IT.
9. F.F.L +0.00 MENTIONED IS EQUIVALENT TO FINISH FLOOR LVL +913.50M AS PER THE CIVIL DRAWING CE-004A-OVERALL LAYOUT PLAN.

DOCUMENT NUMBER	REFERENCE DOCUMENT	REV	DATE	REVISION DESCRIPTION	DRN	CHK	ENG	APP	EMP
MD-216-6000-EG-CV-STD-1002	HOLLOW CORE SLAB STANDARD	D01	06/09/2023	AS-BUILT	TEC	AVG	TEC	SJM	
MD-216-6000-EG-CV-STD-1001	REINFORCEMENT STANDARD	C02	14/04/2021	ISSUED FOR CONSTRUCTION & REVISED AS MARKED △C02	TEC	AVG	TEC	SJM	
MD-216-6000-EG-AR-GAD-3099	BUILDING PLANS	C01	27/11/2020	ISSUED FOR CONSTRUCTION	TEC	SJM	TEC	AG	
MD-216-6000-EG-CV-GAD-1535	OVERALL LAYOUT PLAN	A01	19.10.2020	ISSUED FOR APPROVAL	TEC	SJM	TEC	AG	

LARSEN & TOUBRO
This drawing is the property of LARSEN & TOUBRO and must not be passed on to any person or body not authorized by us to receive it nor be copied or otherwise made use either in full or in part by such person or body without our prior permission in writing.

Outotec
The content of these documents are the sole property of Outotec Oyj. Any rights not expressly granted herein are reserved. Reproduction, transfer or distribution of part or all of the contents in any form without prior written permission of Outotec is prohibited.

MA'ADEN معادن
Saudi Arabian Mining Company شركة معادن العربية السعودية
This document and the information contained herein is Ma'aden proprietary know-how. This document or any part thereof should not be reproduced, stored in a retrieval system or transmitted by any means, electronic or otherwise, or divulged without prior written permission of Ma'aden.

LARSEN & TOUBRO DRAWING NUMBER 019045_080_C_G_24439_001 REVISION 3
OUTOTEC DRAWING NUMBER 900707__GAU01__AG50__MTL01__49043 DOCUMENT ID OU100704417 REVISION 3

DRAWN	TEC	19/11/2020	MANSOURAH - MASSARAH GOLD PROJECT
CHECKED	SJM	20/11/2020	GENERAL ARRANGEMENT DRAWING
ENGINEER	TEC	19/11/2020	FUEL STORAGE FACILITY
APPROVED	AG	20/11/2020	EQUIPMENT ARGT. WITH PIPING FOR LPG SYSTEM
EMPLOYER			
SCALE 1:50,10	A1		DRAWING NUMBER MD-216-49FE-EG-CV-GAD-1635 REV D01