

DRAWING NUMBER MD-216-49FE-EG-CV-GAD-1636 REV D01

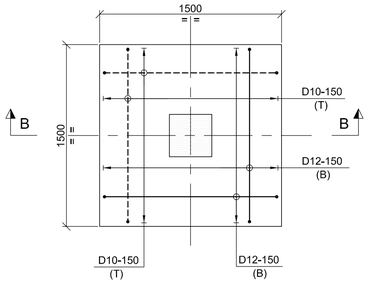


R.C. DETAIL OF FOUNDATION MKD. F1

(F1 - 4 NOS. REQUIRED)
(SCALE- 1:25)

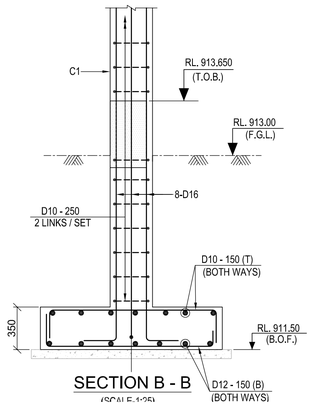

SECTION B - B




(SCALE 1:25)

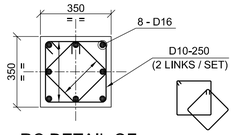



RC DETAIL OF COLUMN MKD. C1

(4 NOS. REQUIRED)
(SCALE- 1:15)

RCC SCHEDULE OF BEAM

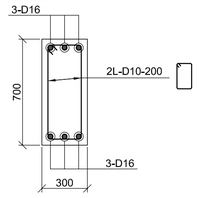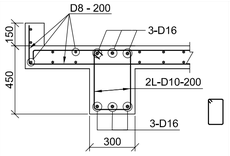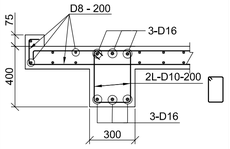
BEAM MKD.	SIZE	CROSS SECTION	TOP OF BEAM (T.O.B)
GB1	300 x 700		RL. 913.650
RB1	300X450		RL. 916.800
RB2	300 x 400		RL. 916.800

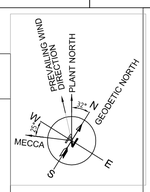

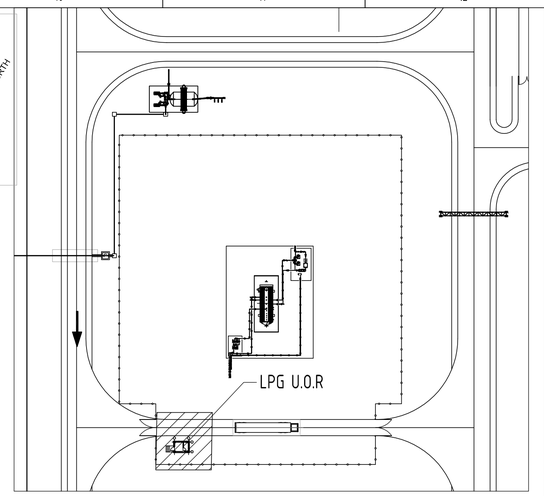


KEY PLAN

(SCALE : 1:750)

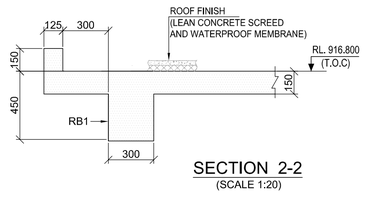


SECTION 2-2

(SCALE 1:20)

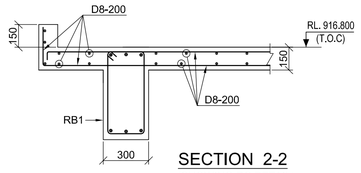


SECTION 2-2

(SHOWING RC DETAIL)
(SCALE 1:20)

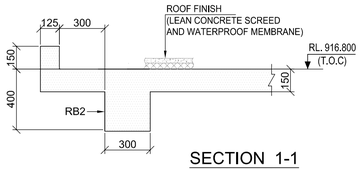

SECTION 1-1

(SCALE 1:20)

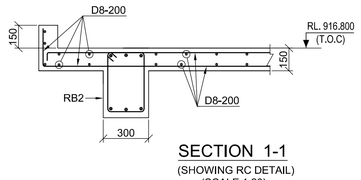

SECTION 1-1


(SHOWING RC DETAIL)
(SCALE 1:20)


LEGEND :-

RL. - REDUCED LEVEL.
T.O.C. - TOP OF CONCRETE.
T.O.B. - TOP OF BEAM.
F.G.L. - FINISHED GROUND LEVEL.
B.O.F. - BOTTOM OF FOOTING.
B.O.B. - BOTTOM OF BEAM.
HCS - HOLLOW CORE SLAB
SSL - STRUCTURAL SLAB LEVEL
CL - CENTRE LINE.
TYP. - TYPICAL.
THK. - THICK.
MKD. - MARKED.
G.A. - GENERAL ARRANGEMENT.
R.C.C. - REINFORCED CEMENT CONRETE.
WWF - WELDED WIRE FABRIC
U.N.O. - UNLESS NOTED OTHERWISE
U.O.R. - UNLOADING OPERATOR ROOM

NOTES :-


1. ALL DIMENSIONS ARE IN MILLIMETRES AND LEVELS AND CO-ORDINATES ARE IN METRES. UNLESS OTHERWISE STATED.
2. FGL CORRESPONDS TO RL. (+) 913.000 M LEVEL.
3. GRADE OF CONCRETE SHALL BE 35 MPa FOR FOUNDATION & 15 MPa FOR BLINDING CONCRETE.
4. GRADE OF REINFORCEMENT SHALL BE DEFORMED BAR 420 MPa (GRADE 60) - ASTM A615/A615M.
5. NET SAFE BEARING CAPACITY OF SOIL AT BOTTOM OF FOUNDATION CONSIDER 200KN/ SQ. M.
10. GENERAL NOTES FOR CIVIL WORKS & STANDARD REINFORCEMENT DETAIL REFER DRAWING NO. MD-216-1000-EG-CV-DED-1001 & 1005.

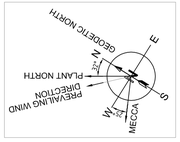

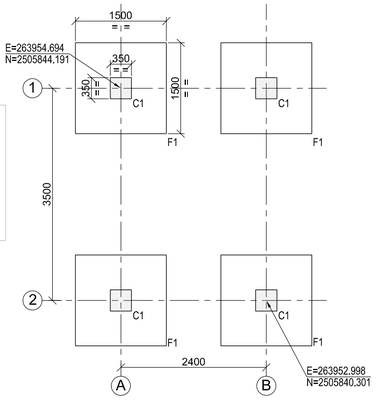


FOUNDATION PLAN

(SCALE 1:50)

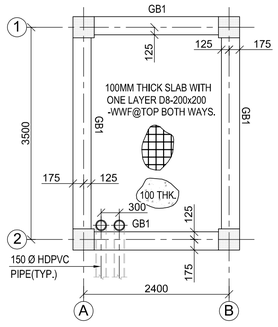


PLAN OF GRADE BEAM

(SCALE 1:50)

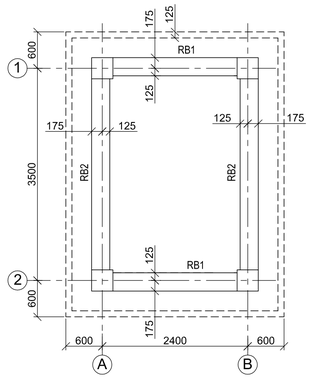

PLAN AT RL. 916.650

(SCALE 1:50)

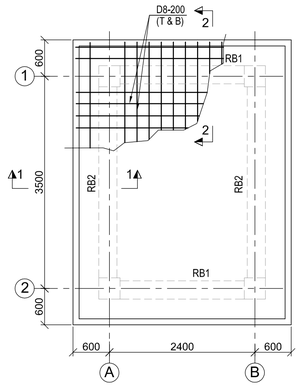

PLAN AT RL. 916.800 (U.N.O.)

SPAN OF HCS MKD. THUS
(SCALE 1:50)

		D01	21/7/2023	AS BUILT	SYA	SJM	AVG	AG	
		C02	20/11/2021	ISSUED FOR CONSTRUCTION & REVISED AS MARKED (C02)	SYA	SJM	AVG	AG	
MD-216-1000-EG-ST-CRT-1001	CIVIL, STRUCTURAL & ARCHITECTURAL-	C01	13/03/2021	ISSUED FOR CONSTRUCTION	MNS	SJM	AVG	AG	
	DESIGN CRITERIA	A01	13/01/2021	ISSUED FOR APPROVAL	MNS	SJM	AVG	AG	
DOCUMENT NUMBER	REFERENCE DOCUMENTS	REV	DATE	REVISION DESCRIPTION	DRN	CHK	ENG	APP	EMP

RESERVED FOR VENDOR LOGO AND DRAWING NUMBER

LARSEN & TOUBRO

This drawing is the property of LARSEN & TOUBRO and must not be passed on to any person or body not authorized by us to receive it nor be copied or otherwise made use either in full or in part by such person or body without our prior permission in writing.

Outotec

The content of these documents are the sole property of Outotec Oyj. Any rights not expressly granted herein are reserved. Reproduction, transfer or distribution of part or all of the contents in any form without prior written permission of Outotec is prohibited.

MA'ADEN معادن
Saudi Arabian Mining Company شركة التعدين العربية السعودية

This document and the information contained herein is Ma'aden proprietary know-how. This document or any part thereof should not be reproduced, stored in a retrieval system or transmitted by any means, electronic or otherwise, or divulged without prior written permission of Ma'aden.

LARSEN & TOUBROW DRAWING NUMBER: O19045_080_C_G_24546_001 — REVISION: 3
OUTOTEC DRAWING NUMBER: 900707__GAU01__AG90__MTL01__50038 — DOCUMENT ID: OU100710511 — REVISION: 3

DRAWN	MNS	24/12/2020
CHECKED	SJM	26/12/2020
ENGINEER	AVG	24/12/2020
APPROVED	AG	13/01/2021
EMPLOYER		
SCALE 1:175, 1:40 & 1:25		A1

MANSOURAH - MASSARAH GOLD PROJECT
GENERAL ARRANGEMENT DRAWING
FUEL STORAGE FACILITY : LPG U.O.R.
LAYOUT & DETAILS OF FDN, COL & GRADE BEAM

DRAWING NUMBER: MD-216-49FE-EG-CV-GAD-1636 — REV: D01