

DRAWING NUMBER: MD-216-49FE-EG-CV-GAD-1638 | REV: D01

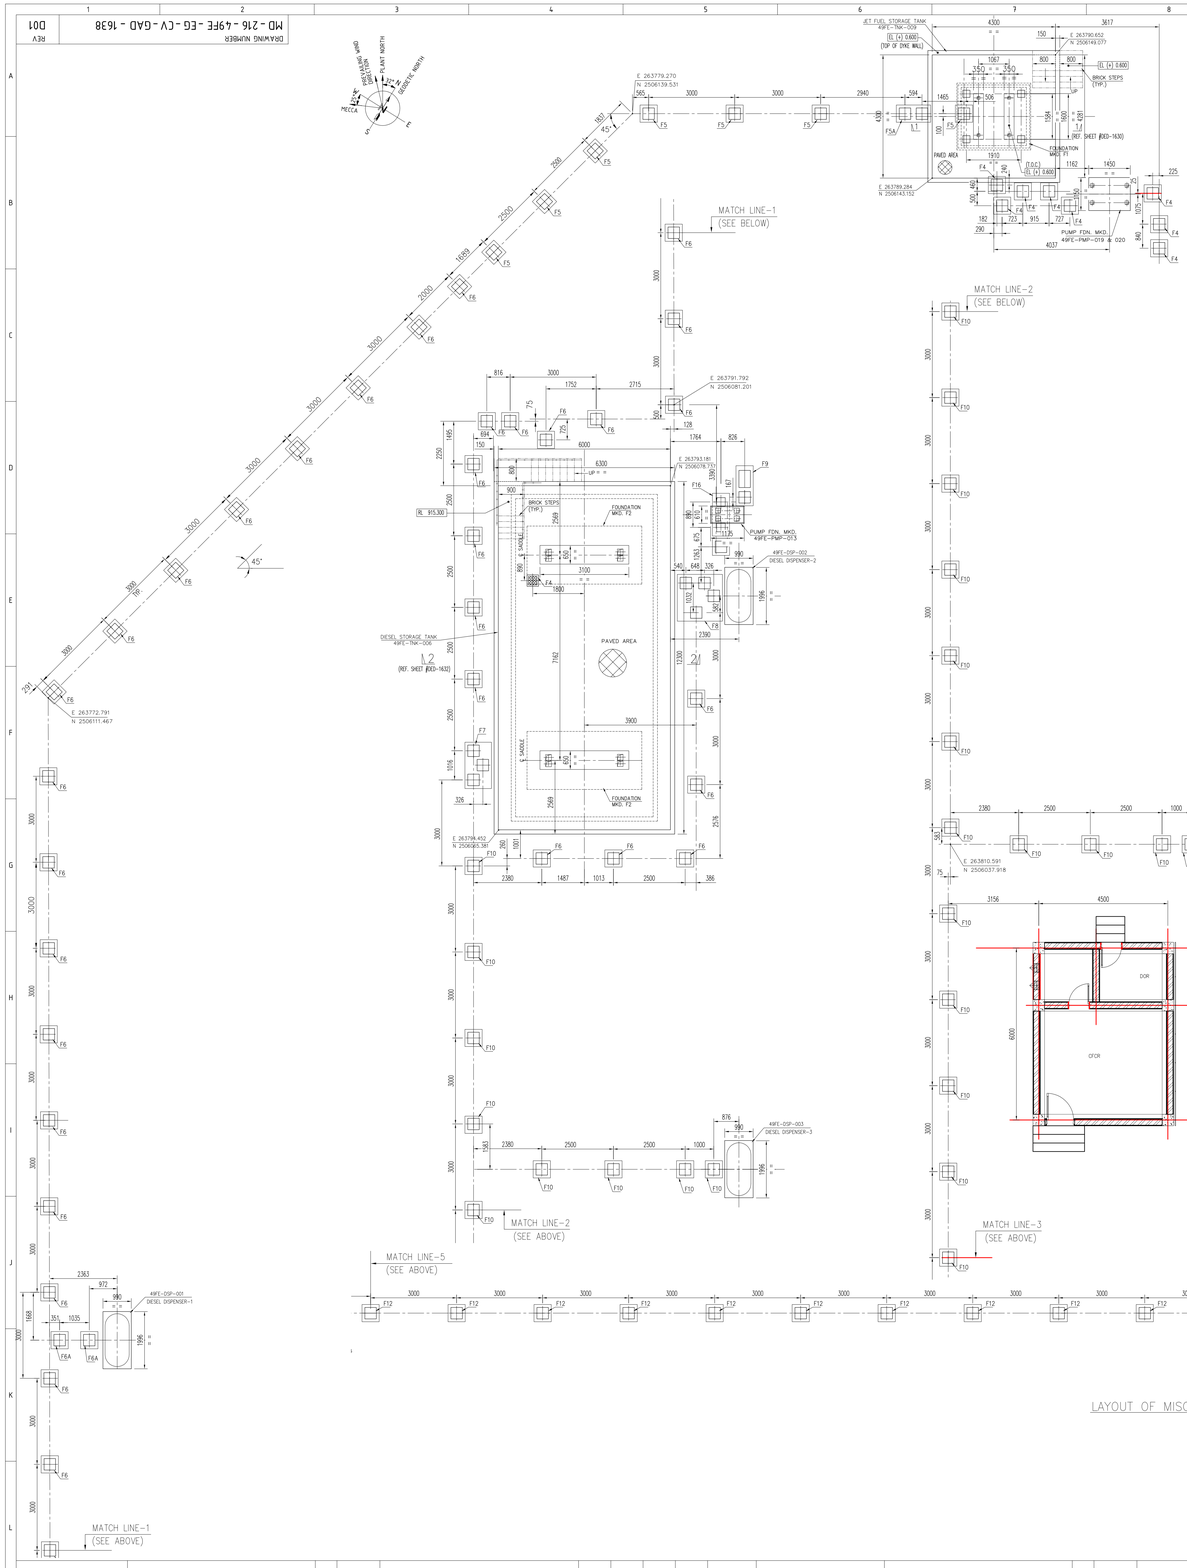

FDN. MKD.	T.O.C
F4	RL+914.950
F5/F5A	RL+914.950
F6	RL+914.150
F6A	RL+914.150
F7	RL+914.150
F8	RL+914.150
F9	RL+914.150
F10	RL+914.150
F11	RL+913.550
F12	RL+913.550
F13	RL+913.550
F14, F14A	RL+913.550
F15	RL+913.550
F16	RL+914.150

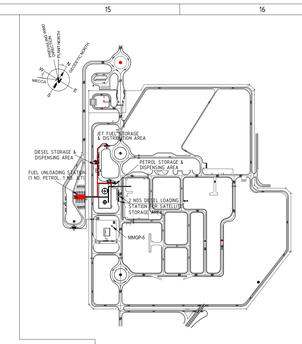

KEY PLAN

LEGENDS

F-FOUNDATION
FGL-FINISH GRADE LVL
REINF.-REINFORCEMENT
LVL.-LEVEL
MKD.-MARKED
Φ- DIAMETER
TYP.-TYPICAL
THK.-THICK
T/G GROUT-TOP OF GROUT
C/C-CENTRE TO CENTRE
℄-CENTRE LINE
EL.-ELEVATION
R.C.-REINFORCED CONCRETE
T.O.C.-TOP OF CONCRETE
EQUIP.-EQUIPMENT
MISC.-MISCELLANEOUS
FDN.-FOUNDATION
B.O.F.-BOTTOM OF FOOTING
P.C.C.-PLAIN CEMENT CONCRETE
CONC.-CONCRETE
SPEC.-SPECIFICATION
F.F.L.-FINISHED FLOOR LEVEL

NOTES

1. ALL DIMENSIONS ARE GIVEN IN MILLIMETRES AND ELEVATIONS ARE IN METRES UNLESS OTHERWISE NOTED.
2. MINIMUM REINFORCED CONCRETE GRADE TO BE USED FOR SUPERSTRUCTURE & SUBSTRUCTURES IS M35(5000 PSI).
3. MINIMUM LEAN CONCRETE GRADE TO BE USED FOR THE SUB-STRUCTURES IS M15(2175 PSI).
4. ALL REINFORCING STEEL SHALL BE DEFORMED BILLET STEEL BARS CONFORMING TO ASTM-A615, WITH MINIMUM YIELD STRENGTH OF FY-420 MPA .
5. THE NET SOIL BEARING CAPACITY CONSIDERED IN FOUNDATION DESIGN IS 350 KPA(REFER DOC.216-3000-EG-CV-CAL-1008-A02).
6. WATER PROOFING INSULATION SHALL BE AS PER PROJECT SPECS AND ITS MATERIAL TO BE APPROVED BY ENGINEER ON SITE.
7. THE MINIMUM CONCRETE COVER AS PER SBC-304-2018(TABLE 20.6.3.3.1) MEASURED FROM REBAR SHALL BE
   a) CONCRETE CAST AGAINST & PERMANENTLY EXPOSED TO EARTH (INCLUDING FOUNDATIONS OVER SUB-SLAB) FORMED CONCRETE EXPOSED TO EARTH OR WEATHER.....50MM
   b) CONCRETE NOT EXPOSED TO WEATHER NOR IN CONTACT WITH GROUND BEAMS, COLUMNS.....40MM SLABS, WALLS, JOISTS.....20MM
   c) CONCRETE SLAB OVER 50MM SUB-SLAB.....20MM
8. ALL DRAWINGS MUST BE READ IN CONJUNCTION WITH RELEVANT ARCHITECTURAL AND ENGINEERING DRAWINGS RELATED TO THE SAME SHEET AND ANY ITEM ON IT.
9. F.F.L +0.00 MENTIONED IS EQUIVALENT TO FINISH FLOOR LVL +913.50M AS PER THE CIVIL DRAWING CE-00A4-OVERALL LAYOUT PLAN.

LAYOUT OF MISC. PIPE SUPPORTS & EQUIP. FDN.

ALL CABLE CONDUITS SHALL BE LAID AS PER ELECTRICAL DRAWING NO. MD-216-49FE-EG-EL-LAD-1002.

DOCUMENT NUMBER	REFERENCE DOCUMENTS	REV	DATE	REVISION DESCRIPTION	DRN	CHK	ENG	APP	EMP
MD-216-49FE-EG-CV-DED-1632-A01	DETAILS OF MISC. PIPE SUPPORTS & EQUIP. FDN.								
MD-216-49FE-EG-CV-DED-1631-A01	DETAILS OF MISC. PIPE SUPPORTS & EQUIP. FDN.	D01	06/09/2023	AS-BUILT	TEC	AVG	TEC	SJM	
MD-216-49FE-EG-CV-DED-1630-A01	DETAILS OF MISC. PIPE SUPPORTS & EQUIP. FDN.	C01	01/03/2021	ISSUED FOR CONSTRUCTION & REVISED AS EMPLOYER'S	TEC	AVG	TEC	SJM	
MD-216-49FE-EG-ME-LAB-V558-1003	EQUIPMENT ARRANGEMENT WITH PIPING			COMMENTS DATED 13/02/2021 AND REVISED AS MARKED					
MD-216-6000-EG-CV-STD-1001	REINFORCEMENT STANDARD	A01	14/01/2021	ISSUED FOR APPROVAL	TEC	AVG	TEC	SJM	

LARSEN & TOUBRO
This drawing is the property of LARSEN & TOUBRO and must not be passed on to any person or body not authorised by us to receive it nor be copied or otherwise made use either in full or in part by such person or body without our prior permission in writing.

Outotec
The content of these documents are the sole property of Outotec Oy. Any rights not expressly granted herein are reserved. Reproduction, transfer or distribution of part or all of the contents in any form without prior written permission of Outotec is prohibited.

MA'ADEN معادن
Saudi Arabian Mining Company شركة معادن العربية السعودية
This document and the information contained herein is Ma'aden proprietary know-how. This document or any part thereof should not be reproduced, stored in a retrieval system or transmitted by any means, electronic or otherwise, or divulged without prior written permission of Ma'aden.

LARSEN & TOUBRO DRAWING NUMBER	019045_080_C_G_24548_001		REVISION 2
OUTOTEC DRAWING NUMBER	900707__GAU01__AG90_MTL01__50043	DOCUMENT ID OU100711124	REVISION 2
DRAWN	TEC	12/01/2021	MANSOURAH - MASSARAH GOLD PROJECT
CHECKED	AVG	13/01/2021	GENERAL ARRANGEMENT DRAWING
ENGINEER	TEC	12/01/2021	DISEL, PETROL & JET FUEL STORAGE AREA
APPROVED	SJM	14/01/2021	LAYOUT OF MISC. PIPE SUPPORTS & EQUIP. FDN.
EMPLOYER			
SCALE	AS SHOWN	A0	DRAWING NUMBER MD-216-49FE-EG-CV-GAD-1638 REV D01

Mansourah Massarah Gold Project
Comment Resolution Log Sheet / Compliance Report

PROJECT:	**MANSOURAH MASSARAH GOLD PROJECT**	**PROJECT NO.:**	**216**
STAGE:	**4 - PROJECT EXECUTION.**	**REVIEW LOG DOC. NO. & REV.:**	
ACONEX REF. NO. & DATE:	BECHTEL-WTRAN-008616, 13 February 2021		

STATUS CODE: A - APPROVED, C - APPROVED WITH COMMENTS, R - REVISE & RESUBMIT & O - OTHERS (INFORMATION, REFERENCE, REVIEWED)

DOCUMENT NUMBER	Area / Title	Comment No.	PMC/PMT COMMENT DATE:13 February 2021	Comment by	EPC Response DATE:01 March 2021	Status	Remarks
			General Comments (cc)				
MD-216-49FE-EG-CV-GAD-1638-A01	49FE	1	Please provide drawing numbers where all the foundation mentioned on this drw can be find.	Mr Klaus Grof Bechtel	Noted and indicated in Reference column.	Closed	