MA'ADEN معادن
Saudi Arabian Mining Company شركة التعدين العربية السعودية

Project Mansourah Massarah Gold Project
Customer: MA’ADEN GOLD AND BASE METALS (MA’ADEN)

Title: GENERAL ARRANGEMENT DRAWING
FUEL OIL STORAGE FACILITY
LAYOUT & DETAILS OF CABLE PULL PITS

Document Number: MD-216-49FE-EG-CV-GAD-1639
Revision: D01
Revision Date: 06.09.2023
Status: AS BUILT

Outotec Document Number:	900707	GAU01	AG50	MTL01	49056	OU100722079	3
L&T Document Number:	O19045	080	C	G	24550	001	3

REVISION HISTORY

Rev	Date	Revision Text	Prepared By	Reviewed By	Approved By	Employer
A01	25.05.2021	ISSUED FOR APPROVAL	SYA	SJM	AG	
A02	17.07.2021	REVISED AS PER EMPLOYER COMMENTS DATED 22.06.2021	SYA	SJM	AG	
C01	13.09.2021	ISSUED FOR CONSTRUCTION	SYA	SJM	AG	
D01	06.09.2023	AS - BUILT	SYA	SJM	AG	

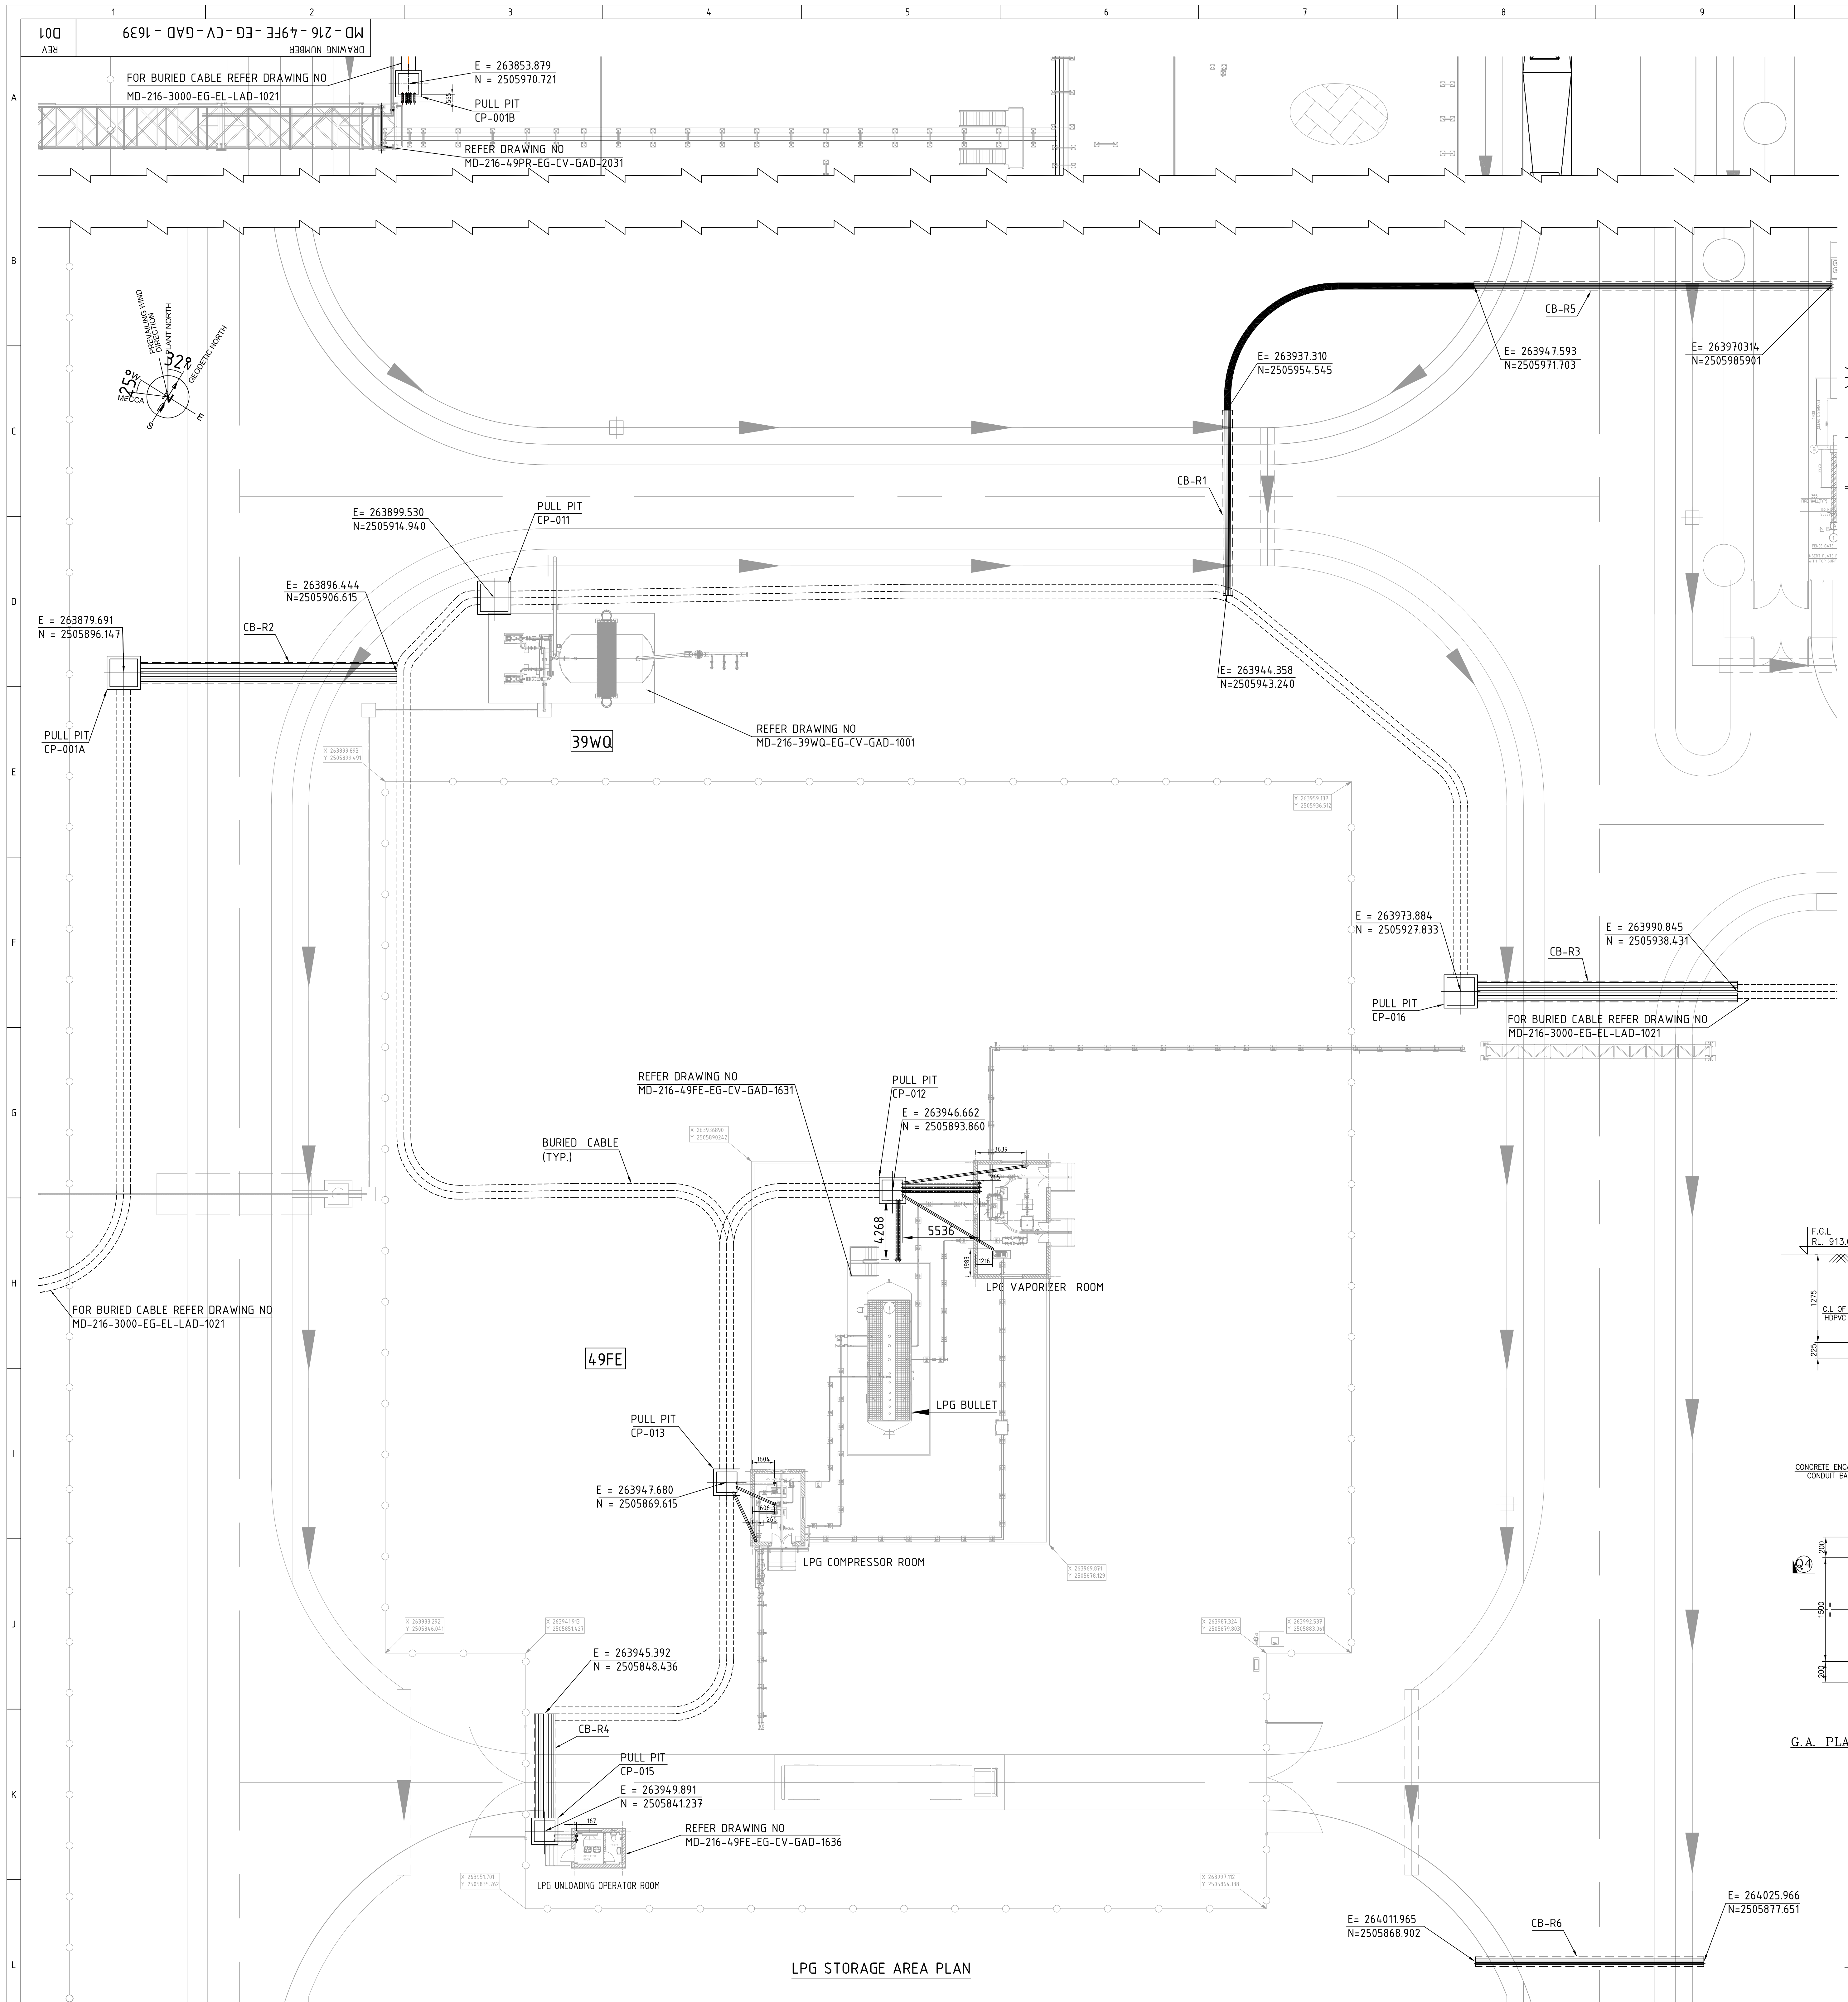
MD-216-49FE-EG-CV-GAD-1639
DRAWING NUMBER
REV
D01
FOR BURIED CABLE REFER DRAWING NO
MD-216-3000-EG-EL-LAD-1021
E = 263853.879
N = 2505970.721
PULL PIT
CP-001B
REFER DRAWING NO
MD-216-49PR-EG-CV-GAD-2031
E= 263937.310
N=2505954.545
CB-R5
E= 263947.593
N=2505971.703
E= 263970314
N=2505985901
CB-R1
E= 263899.530
N=2505914.940
PULL PIT
CP-011
E= 263896.444
N=2505906.615
E = 263879.691
N = 2505896.147
CB-R2
PULL PIT
CP-001A
E= 263944.358
N=2505943.240
39WQ
REFER DRAWING NO
MD-216-39WQ-EG-CV-GAD-1001
E = 263973.884
N = 2505927.833
E = 263990.845
N = 2505938.431
CB-R3
PULL PIT
CP-016
FOR BURIED CABLE REFER DRAWING NO
MD-216-3000-EG-EL-LAD-1021
REFER DRAWING NO
MD-216-49FE-EG-CV-GAD-1631
PULL PIT
CP-012
E = 263946.662
N = 2505893.860
BURIED CABLE
(TYP.)
4268
5536
LPG VAPORIZER ROOM
FOR BURIED CABLE REFER DRAWING NO
MD-216-3000-EG-EL-LAD-1021
49FE
LPG BULLET
PULL PIT
CP-013
E = 263947.680
N = 2505869.615
LPG COMPRESSOR ROOM
E = 263945.392
N = 2505848.436
CB-R4
PULL PIT
CP-015
E = 263949.891
N = 2505841.237
REFER DRAWING NO
MD-216-49FE-EG-CV-GAD-1636
LPG UNLOADING OPERATOR ROOM
E= 264011.965
N=2505868.902
CB-R6
E= 264025.966
N=2505877.651
PREVAILING WIND DIRECTION
PLANT NORTH
GEOGRAPHIC NORTH
MECCA
25°
32°

LPG STORAGE AREA PLAN

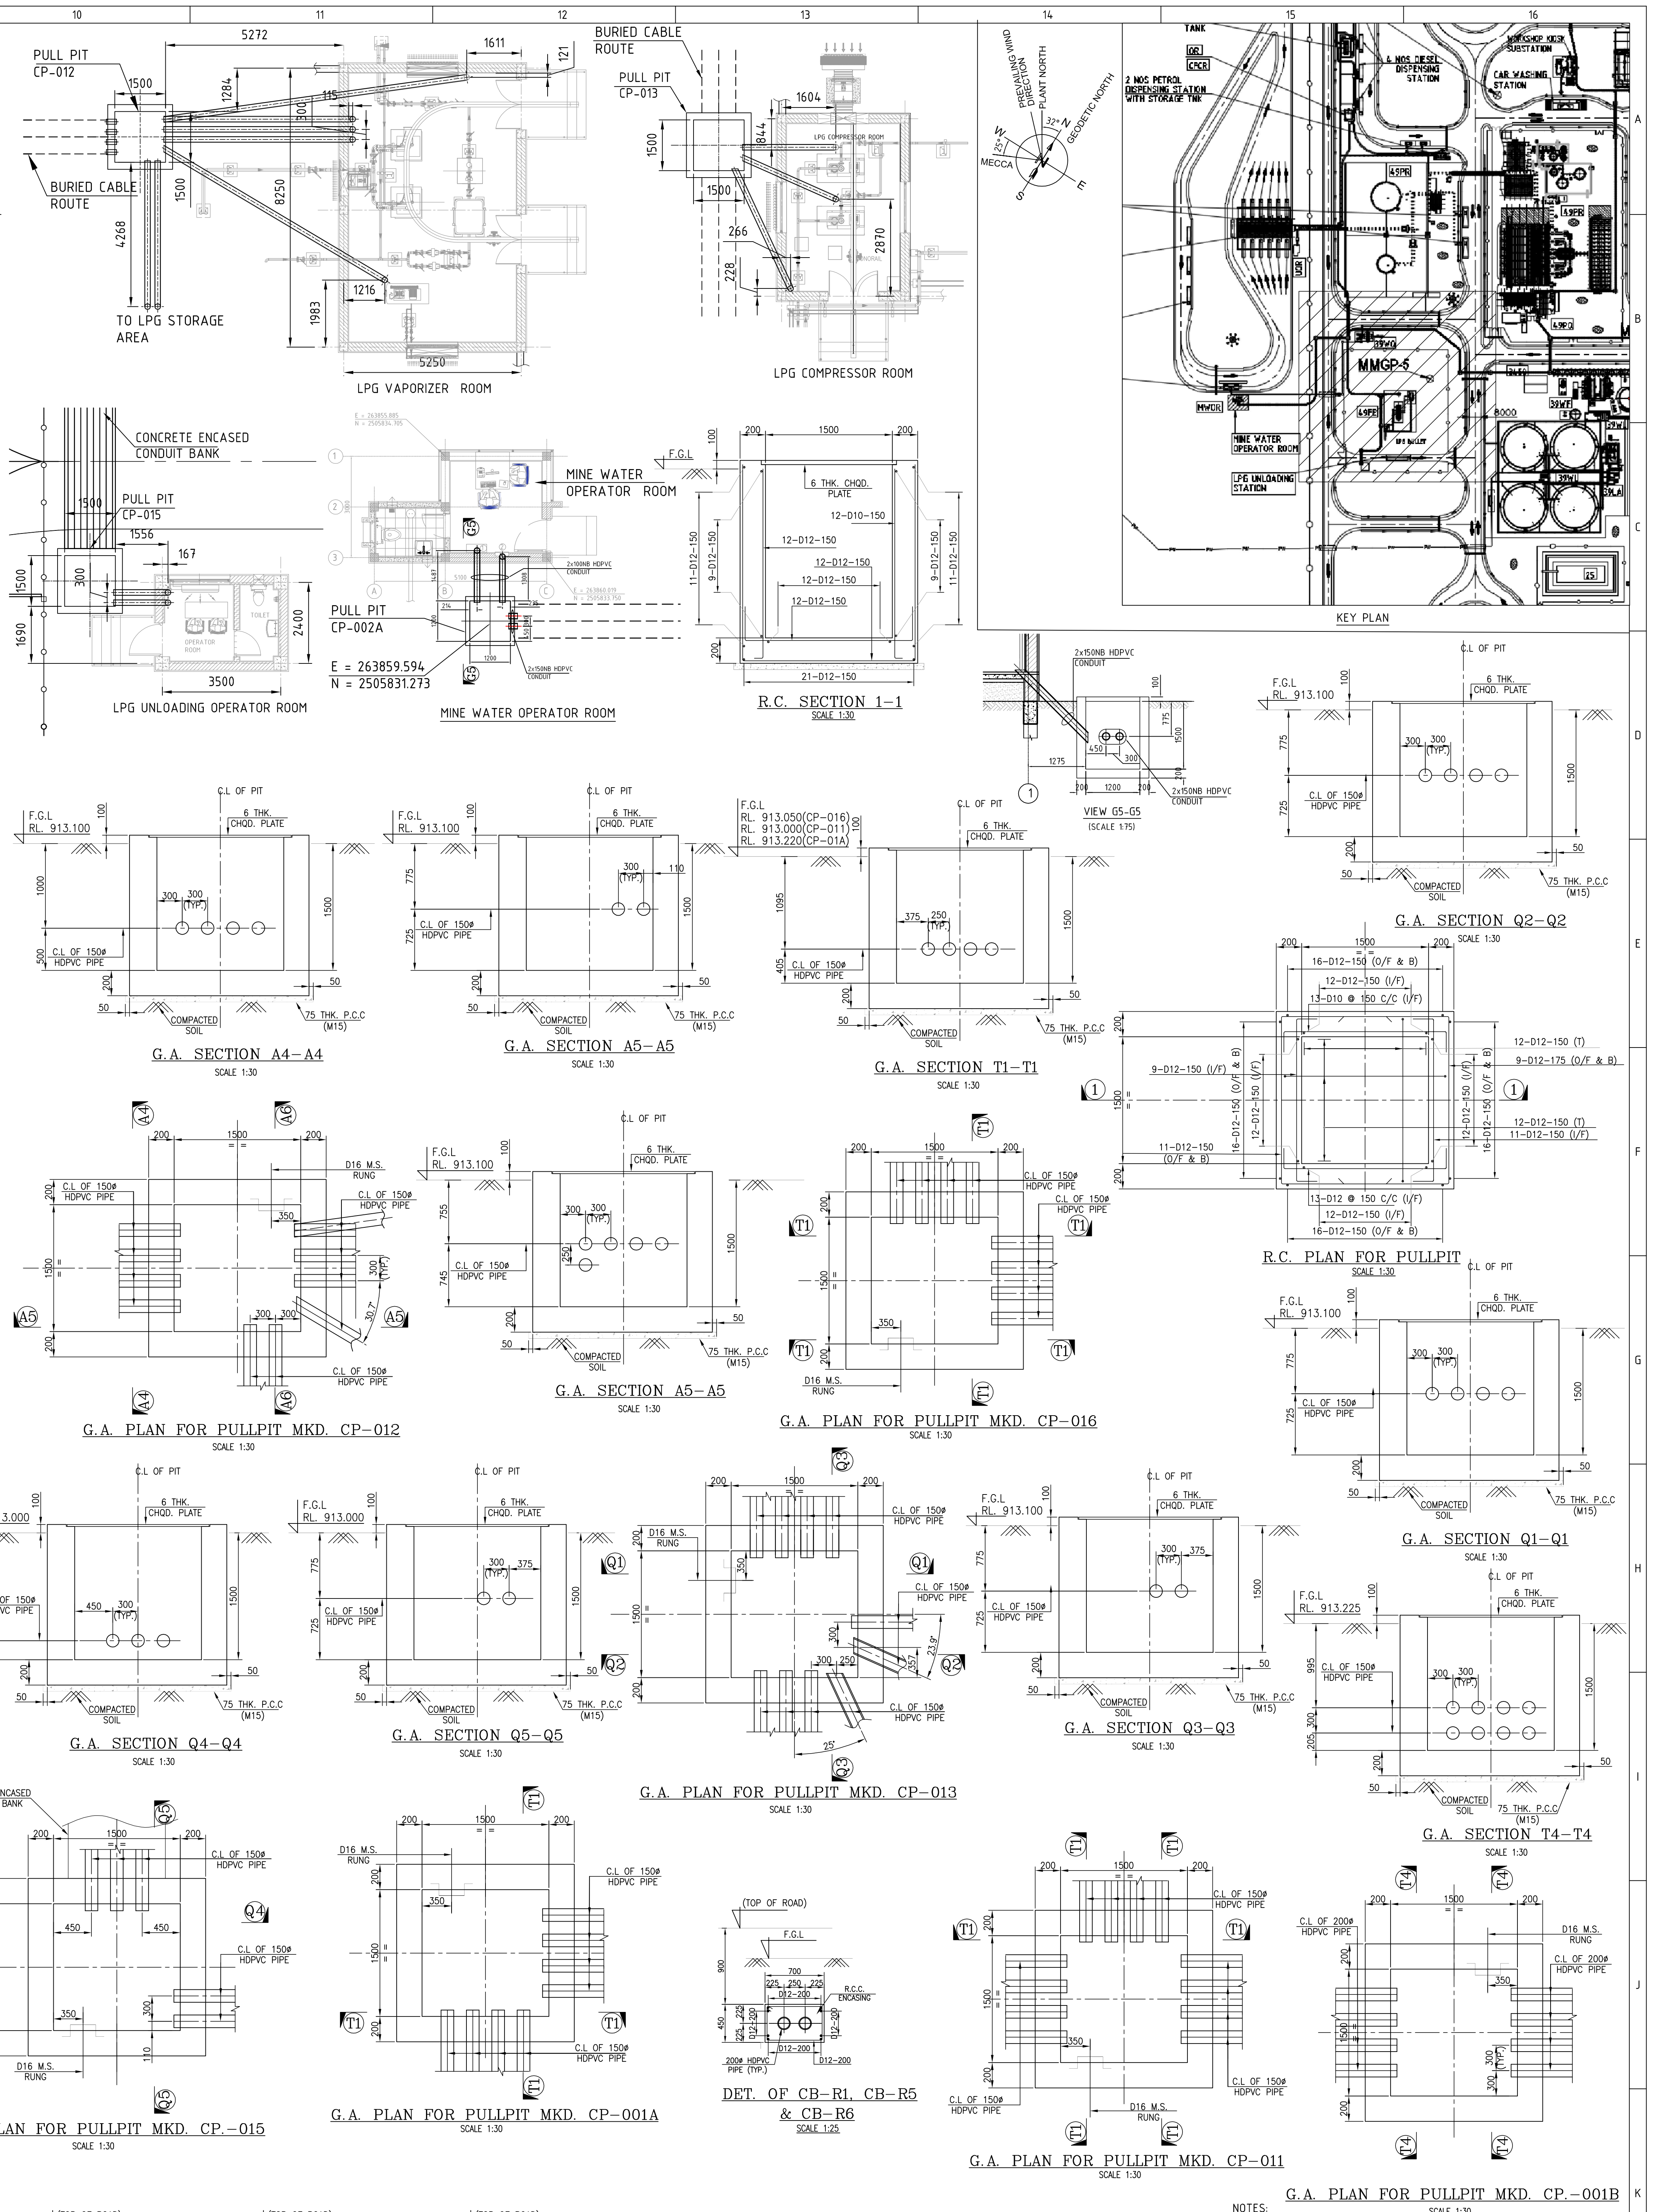
PULL PIT
CP-012
5272
1611
1500
BURIED CABLE ROUTE
TO LPG STORAGE AREA
LPG VAPORIZER ROOM
BURIED CABLE ROUTE
PULL PIT
CP-013
LPG COMPRESSOR ROOM
CONCRETE ENCASED CONDUIT BANK
PULL PIT
CP-015
LPG UNLOADING OPERATOR ROOM
MINE WATER OPERATOR ROOM
PULL PIT
CP-002A
E = 263859.594
N = 2505831.273
MINE WATER OPERATOR ROOM
R.C. SECTION 1-1
SCALE 1:30
VIEW 05-05
KEY PLAN
G.A. SECTION Q2-Q2
SCALE 1:30
G.A. SECTION A4-A4
SCALE 1:30
G.A. SECTION A5-A5
SCALE 1:30
G.A. SECTION T1-T1
SCALE 1:30
R.C. PLAN FOR PULLPIT
SCALE 1:30
G.A. PLAN FOR PULLPIT MKD. CP-012
SCALE 1:30
G.A. SECTION A5-A5
SCALE 1:30
G.A. PLAN FOR PULLPIT MKD. CP-016
SCALE 1:30
G.A. SECTION Q1-Q1
SCALE 1:30
G.A. SECTION Q4-Q4
SCALE 1:30
G.A. SECTION Q5-Q5
SCALE 1:30
G.A. PLAN FOR PULLPIT MKD. CP-013
SCALE 1:30
G.A. SECTION Q3-Q3
SCALE 1:30
G.A. SECTION T4-T4
SCALE 1:30
G.A. PLAN FOR PULLPIT MKD. CP.-015
SCALE 1:30
G.A. PLAN FOR PULLPIT MKD. CP-001A
SCALE 1:30
DET. OF CB-R1, CB-R5 & CB-R6
SCALE 1:25
G.A. PLAN FOR PULLPIT MKD. CP-011
SCALE 1:30
G.A. PLAN FOR PULLPIT MKD. CP.-001B
SCALE 1:30
F.G.L
RL. 913.100
C.L OF PIT
6 THK CHQD. PLATE
C.L OF 150ø HDPVC PIPE
COMPACTED SOIL
75 THK. P.C.C (M15)
D16 M.S. RUNG
200ø HDPVC PIPE (TYP.)
D12-200

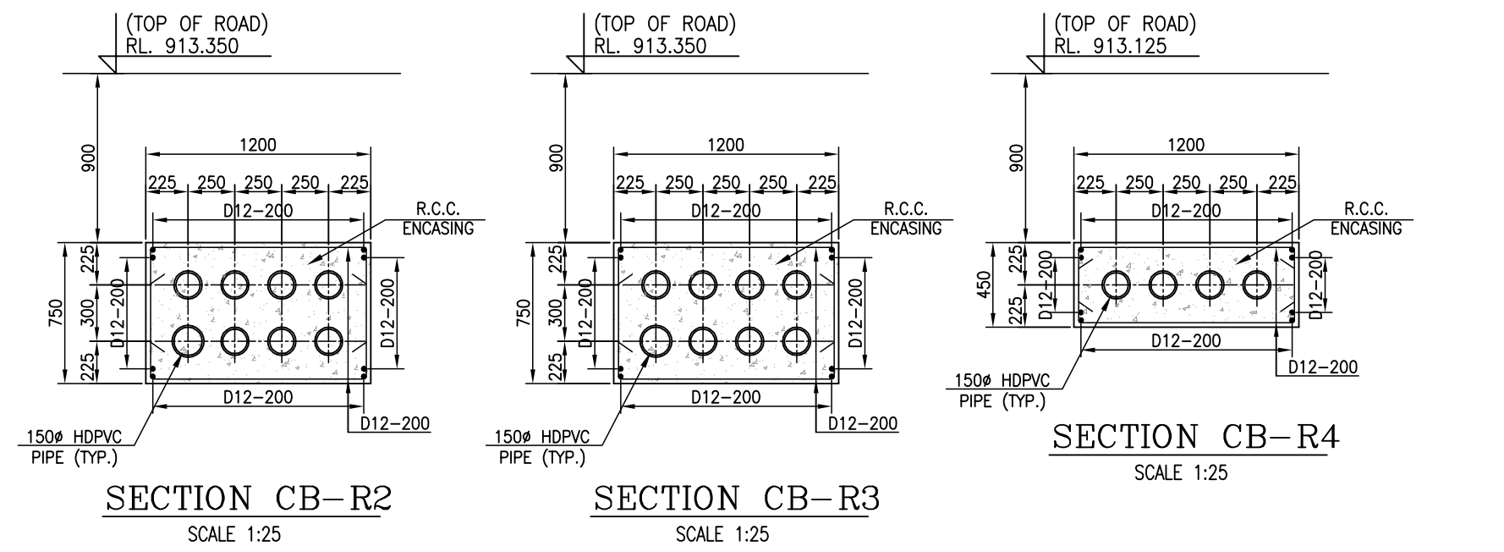
(TOP OF ROAD)
RL. 913.350
RL. 913.125
R.C.C. ENCASING
150ø HDPVC PIPE (TYP.)
D12-200
SECTION CB-R2
SCALE 1:25
SECTION CB-R3
SCALE 1:25
SECTION CB-R4
SCALE 1:25

LEGEND:

TYP.	TYPICAL		
U.N.O	UNLESS NOTED OTHERWISE	T	TOP
G.A.	GENERAL ARRANGEMENT	B	BOTTOM
R.C.	REINFORCED CONCRETE	MKD.	MARKED
F.G.L	FINISHED GROUND LEVEL	CHQD.	CHEQUERED
P.C.C	PLAIN CEMENT CONCRETE	THK.	THICK
R.C.C	REINFORCED CEMENT CONCRETE	PL.	PLATE
DIA	DIAMETER	C/C	CENTRE TO CENTRE
ø	DIAMETER		

NOTES:

1. ALL DIMENSIONS ARE IN MILLIMETRES
2. CO-ORDINATES AND LEVELS ARE IN METRES
3. CO-ORDINATES ARE ON WORLD GRID (FLAT PLANT/WORLD)
4. WORLD MAPPING GRID BASED ON UTM (WGS 84) Q38N
5. NET SAFE BEARING CAPACITY OF SOIL AT BOTTOM OF PITS IS CONSIDERED AS 10T/ SQ. M.
6. GRADE OF REINFORCED CEMENT CONCRETE (R.C.C) SHALL BE M35.
7. REINFORCEMENT BARS SHALL CONFORM TO ASTM A615 GRADE 60 (fy=420 N/sq.mm.)
8. CLEAR COVER TO MAIN REINFORCEMENT SHALL BE 25mm(MINIMUM) U.N.O.
9. THIS DRAWING IS TO BE READ IN CONJUNCTION WITH DRAWING NO. MD-216-49FE-EG-CV-GAD-1639 (SHEET 2 OF 3) & (SHEET 3 OF 3).
10. FOR CONCRETE GENERAL NOTES, REFER DRAWING NUMBER MD-216-1000-EG-CV-DED-1005.

SHEET 1 OF 3

DOCUMENT NUMBER	REFERENCE DOCUMENTS	REV	DATE	REVISION DESCRIPTION	DRN	CHK	ENG	APP	EMP
		D01	06/09/2023	AS-BUILT	SYA	SJM	AVG	AG	
		C01	13/09/2021	ISSUED FOR CONSTRUCTION	SYA	SJM	AVG	AG	
MD-216-3000-EG-EL-LAD-1021	PROCESS PLANT UNDER GROUND CABLE ROUTE DETAILS	A02	21/07/2021	REVISED AS PER EMPLOYER COMMENTS DATED 22/06/2021	SYA	SJM	AVG	AG	
MD-216-49FE-EG-EL-LAD-1005	FUEL OIL STORAGE LPG AREA CABLE ROUTE LAYOUT	A01	25/05/2021	ISSUED FOR APPROVAL	SYA	SJM	AVG	AG	

RESERVED FOR VENDOR LOGO AND DRAWING NUMBER

LARSEN & TOUBRO

This drawing is the property of LARSEN & TOUBRO and must not be passed on to any person or body not authorized by us to receive it nor be copied or otherwise made use either in full or in part by such person or body without our prior permission in writing.

Outotec

The content of these documents are the sole property of Outotec Oyj. Any rights not expressly granted herein are reserved. Reproduction, transfer or distribution of part or all of the contents in any form without prior written permission of Outotec is prohibited.

MA'ADEN معادن
Saudi Arabian Mining Company شركة التعدين العربية السعودية

This document and the information contained herein is Ma'aden proprietary know-how. This document or any part thereof should not be reproduced, stored in a retrieval system or transmitted by any means, electronic or otherwise, or divulged without prior written permission of Ma'aden.

LARSEN & TOUBRO DRAWING NUMBER	019045_080_C_G_24550_001	REVISION	3
OUTOTEC DRAWING NUMBER	900707 _GAU01 _AG50_MTL01 _49056	DOCUMENT ID	0U100722079
		REVISION	3

DRAWN	SYA	10/05/2021
CHECKED	SJM	11/05/2021
ENGINEER	AVG	10/05/2021
APPROVED	AG	25/05/2021
EMPLOYER		
SCALE	1:200	A0

MANSOURAH - MASSARAH GOLD PROJECT
GENERAL ARRANGEMENT DRAWING
FUEL OIL STORAGE FACILITY
LAYOUT & DETAILS OF CABLE PULL PITS

DRAWING NUMBER
MD - 216 - 49FE - EG - CV - GAD - 1639

REV
D01

DRAWING NUMBER
MD - 216 - 49FE - EG - CV - GAD - 1639
REV D01
FUEL STORAGE AREA PLAN
PULL PIT CP-001B
E = 263853.879
N = 2505970.721
SLOPE
PREVAILING WIND DIRECTION
PLANT NORTH
GEODETIC NORTH
MECCA
CENTRAL FUEL CONTROL ROOM
DOR
PULL PIT CP-009A
REFER DRAWING NO MD-216-49FE-EG-CV-GAD-1638
E = 263822.911
N = 2506030.329
DIESEL STORAGE & DISPENSING AREA
PULL PIT CP-008
E = 263793.605
N = 2506079.936
PULL PIT CP-007
E = 263786.662
N = 2506090.248
4000m3
19,2m
PULL PIT CP-002
E = 263866.016
N = 2506032.635
PULL PIT CP-003
E = 263879.550
N = 2506041.144
PETROL STORAGE & DISPENSING AREA
REFER DRG. NO. MD-216-3000-EG-CV-GAD-1058
JET FUEL STORAGE & DISTRIBUTION AREA
PULL PIT CP-009
E = 263792.924
N = 2506149.047
KEY PLAN
1 NO. JET FUEL LOADING STATION
JET FUEL TANK
FUEL UNLOADING STATION (1 NO. PETROL, 1 NO. JET)
G.A. PLAN FOR PULLPIT MKD. CP-007
SCALE 1:30
G.A. SECTION P7-P7
SCALE 1:30
G.A. SECTION P8-P8
SCALE 1:30
G.A. SECTION B2-B2
SCALE 1:30
G.A. PLAN FOR PULLPIT MKD. CP-009A
SCALE 1:30
G.A. SECTION B1-B1
SCALE 1:30
G.A. PLAN FOR PULLPIT MKD. CP-009
SCALE 1:30
G.A. SECTION P1-P1
SCALE 1:30
G.A. SECTION B3-B3
SCALE 1:30
G.A. PLAN FOR PULLPIT MKD. CP-008
SCALE 1:30
G.A. SECTION P11-P11
SCALE 1:30
G.A. PLAN FOR PULLPIT MKD. CP-003
SCALE 1:30
G.A. SECTION P6-P6
SCALE 1:30
G.A. PLAN FOR PULLPIT MKD. CP-002
SCALE 1:30
R.C. PLAN FOR PULLPIT
SCALE 1:30
R.C. SECTION 1-1
SCALE 1:30
G.A. SECTION P10-P10
SCALE 1:30
G.A. SECTION P9-P9
SCALE 1:30
G.A. SECTION P4-P4
SCALE 1:30
G.A. SECTION P5-P5
SCALE 1:30
G.A. SECTION P3-P3
SCALE 1:30
G.A. SECTION P2-P2
SCALE 1:30
F.G.L
RL. 913.400
RL. 914.000
C.L OF PIT
6 THK. CHQD. PLATE
C.L OF 150Ø HDPVC PIPE
COMPACTED SOIL
75 THK. P.C.C (M15)
16-D12-150 (O/F & B)
12-D12-150 (I/F)
13-D10 @ 150 C/C (I/F)
12-D12-150 (T)
9-D12-175 (O/F & B)
9-D12-150 (I/F)
11-D12-150 (O/F & B)
12-D12-150 (T)
11-D12-150 (I/F)
13-D12 @ 150 C/C (I/F)
21-D12-150

LEGEND:

TYP.	TYPICAL
U.N.O	UNLESS NOTED OTHERWISE
G.A.	GENERAL ARRANGEMENT
R.C.	REINFORCED CONCRETE
F.G.L	FINISHED GROUND LEVEL
P.C.C	PLAIN CEMENT CONCRETE
R.C.C	REINFORCED CEMENT CONCRETE
DIA	DIAMETER
Ø	DIAMETER
T	TOP
B	BOTTOM
MKD.	MARKED
CHQD.	CHEQUERED
THK.	THICK
PL.	PLATE
C/C	CENTRE TO CENTRE

NOTES:

1. ALL DIMENSIONS ARE IN MILLIMETRES
2. CO-ORDINATES AND LEVELS ARE IN METRES
3. CO-ORDINATES ARE ON WORLD GRID (FLAT PLANT/WORLD)
4. WORLD MAPPING GRID BASED ON UTM (WGS 84) Q38N
5. NET SAFE BEARING CAPACITY OF SOIL AT BOTTOM OF PITS IS CONSIDERED AS 10T/ SQ. M.
6. GRADE OF REINFORCED CEMENT CONCRETE (R.C.C) SHALL BE M35.
7. REINFORCEMENT BARS SHALL CONFORM TO ASTM A615 GRADE 60 (fy=420 N/sq.mm.)
8. CLEAR COVER TO MAIN REINFORCEMENT SHALL BE 25mm(MINIMUM) U.N.O.
9. THIS DRAWING IS TO BE READ IN CONJUNCTION WITH DRAWING NO. MD-216-49FE-EG-CV-GAD-1639 (SHEET 1 OF 3) & (SHEET 3 OF 3).
10. FOR CONCRETE GENERAL NOTES, REFER DRAWING NUMBER MD-216-1000-EG-CV-DED-1005.

SHEET 2 OF 3

DOCUMENT NUMBER	REFERENCE DOCUMENTS	REV	DATE	REVISION DESCRIPTION	DRN	CHK	ENG	APP	EMP

DOCUMENT NUMBER	REFERENCE DOCUMENTS	REV	DATE	REVISION DESCRIPTION	DRN	CHK	ENG	APP	EMP
		D01	06/09/2023	AS-BUILT					
		C01	13/09/2021	ISSUED FOR CONSTRUCTION	SYA	SJM	AVG	AG	
MD-216-3000-EG-EL-LAD-1021	PROCESS PLANT UNDER GROUND CABLE ROUTE DETAILS	A02	21/07/2021	REVISED AS PER EMPLOYER COMMENTS DATED 22/06/2021	SYA	SJM	AVG	AG	
MD-216-49FE-EG-EL-LAD-1002	FUEL OIL STORAGE CABLE ROUTE LAYOUT	A01	25/05/2021	ISSUED FOR APPROVAL	SYA	SJM	AVG	AG	

RESERVED FOR VENDOR LOGO AND DRAWING NUMBER

LARSEN & TOUBRO

This drawing is the property of *LARSEN & TOUBRO* and must not be passed on to any person or body not authorized by us to receive it nor be copied or otherwise made use either in full or in part by such person or body without our prior permission in writing.

Outotec

The content of these documents are the sole property of Outotec Oyj. Any rights not expressly granted herein are reserved. Reproduction, transfer or distribution of part or all of the contents in any form without prior written permission of Outotec is prohibited.

MA'ADEN معادن
Saudi Arabian Mining Company شركة التعدين العربية السعودية

This document and the information contained herein is Ma'aden proprietary know-how. This document or any part thereof should not be reproduced, stored in a retrieval system or transmitted by any means, electronic or otherwise, or divulged without prior written permission of Ma'aden.

LARSEN & TOUBRO DRAWING NUMBER
019045_080_C_G_24550_001
REVISION 3

OUTOTEC DRAWING NUMBER
900707 _ GAU01 _ AG50 _ MTL01 _ 49056
DOCUMENT ID
OU100722079
REVISION 3

DRAWN	SYA	10/05/2021
CHECKED	SJM	11/05/2021
ENGINEER	AVG	10/05/2021
APPROVED	AG	25/05/2021
EMPLOYER		
SCALE	1:200	A0

MANSOURAH - MASSARAH GOLD PROJECT
GENERAL ARRANGEMENT DRAWING
FUEL OIL STORAGE FACILITY
LAYOUT & DETAILS OF CABLE PULL PITS

DRAWING NUMBER
MD - 216 - 49FE - EG - CV - GAD - 1639
REV
D01

MD - 216 - 49FE - EG - CV - GAD - 1639
DRAWING NUMBER
REV D01

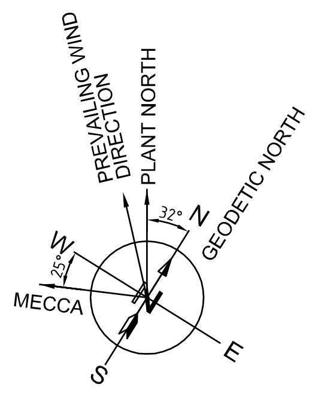
PREVAILING WIND DIRECTION
PLANT NORTH
GEODETIC NORTH
32°
25°
MECCA
N
W
S
E

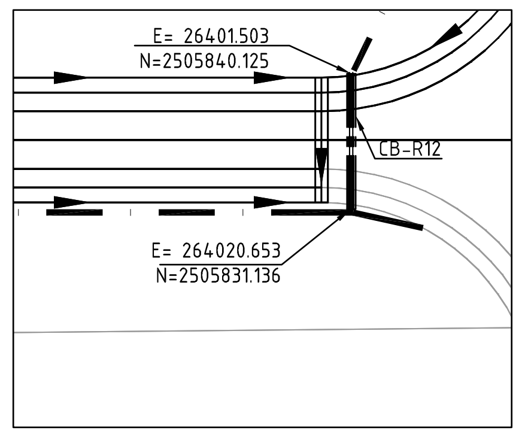
E= 26401.503
N=2505840.125
CB-R12
E= 264020.653
N=2505831.136

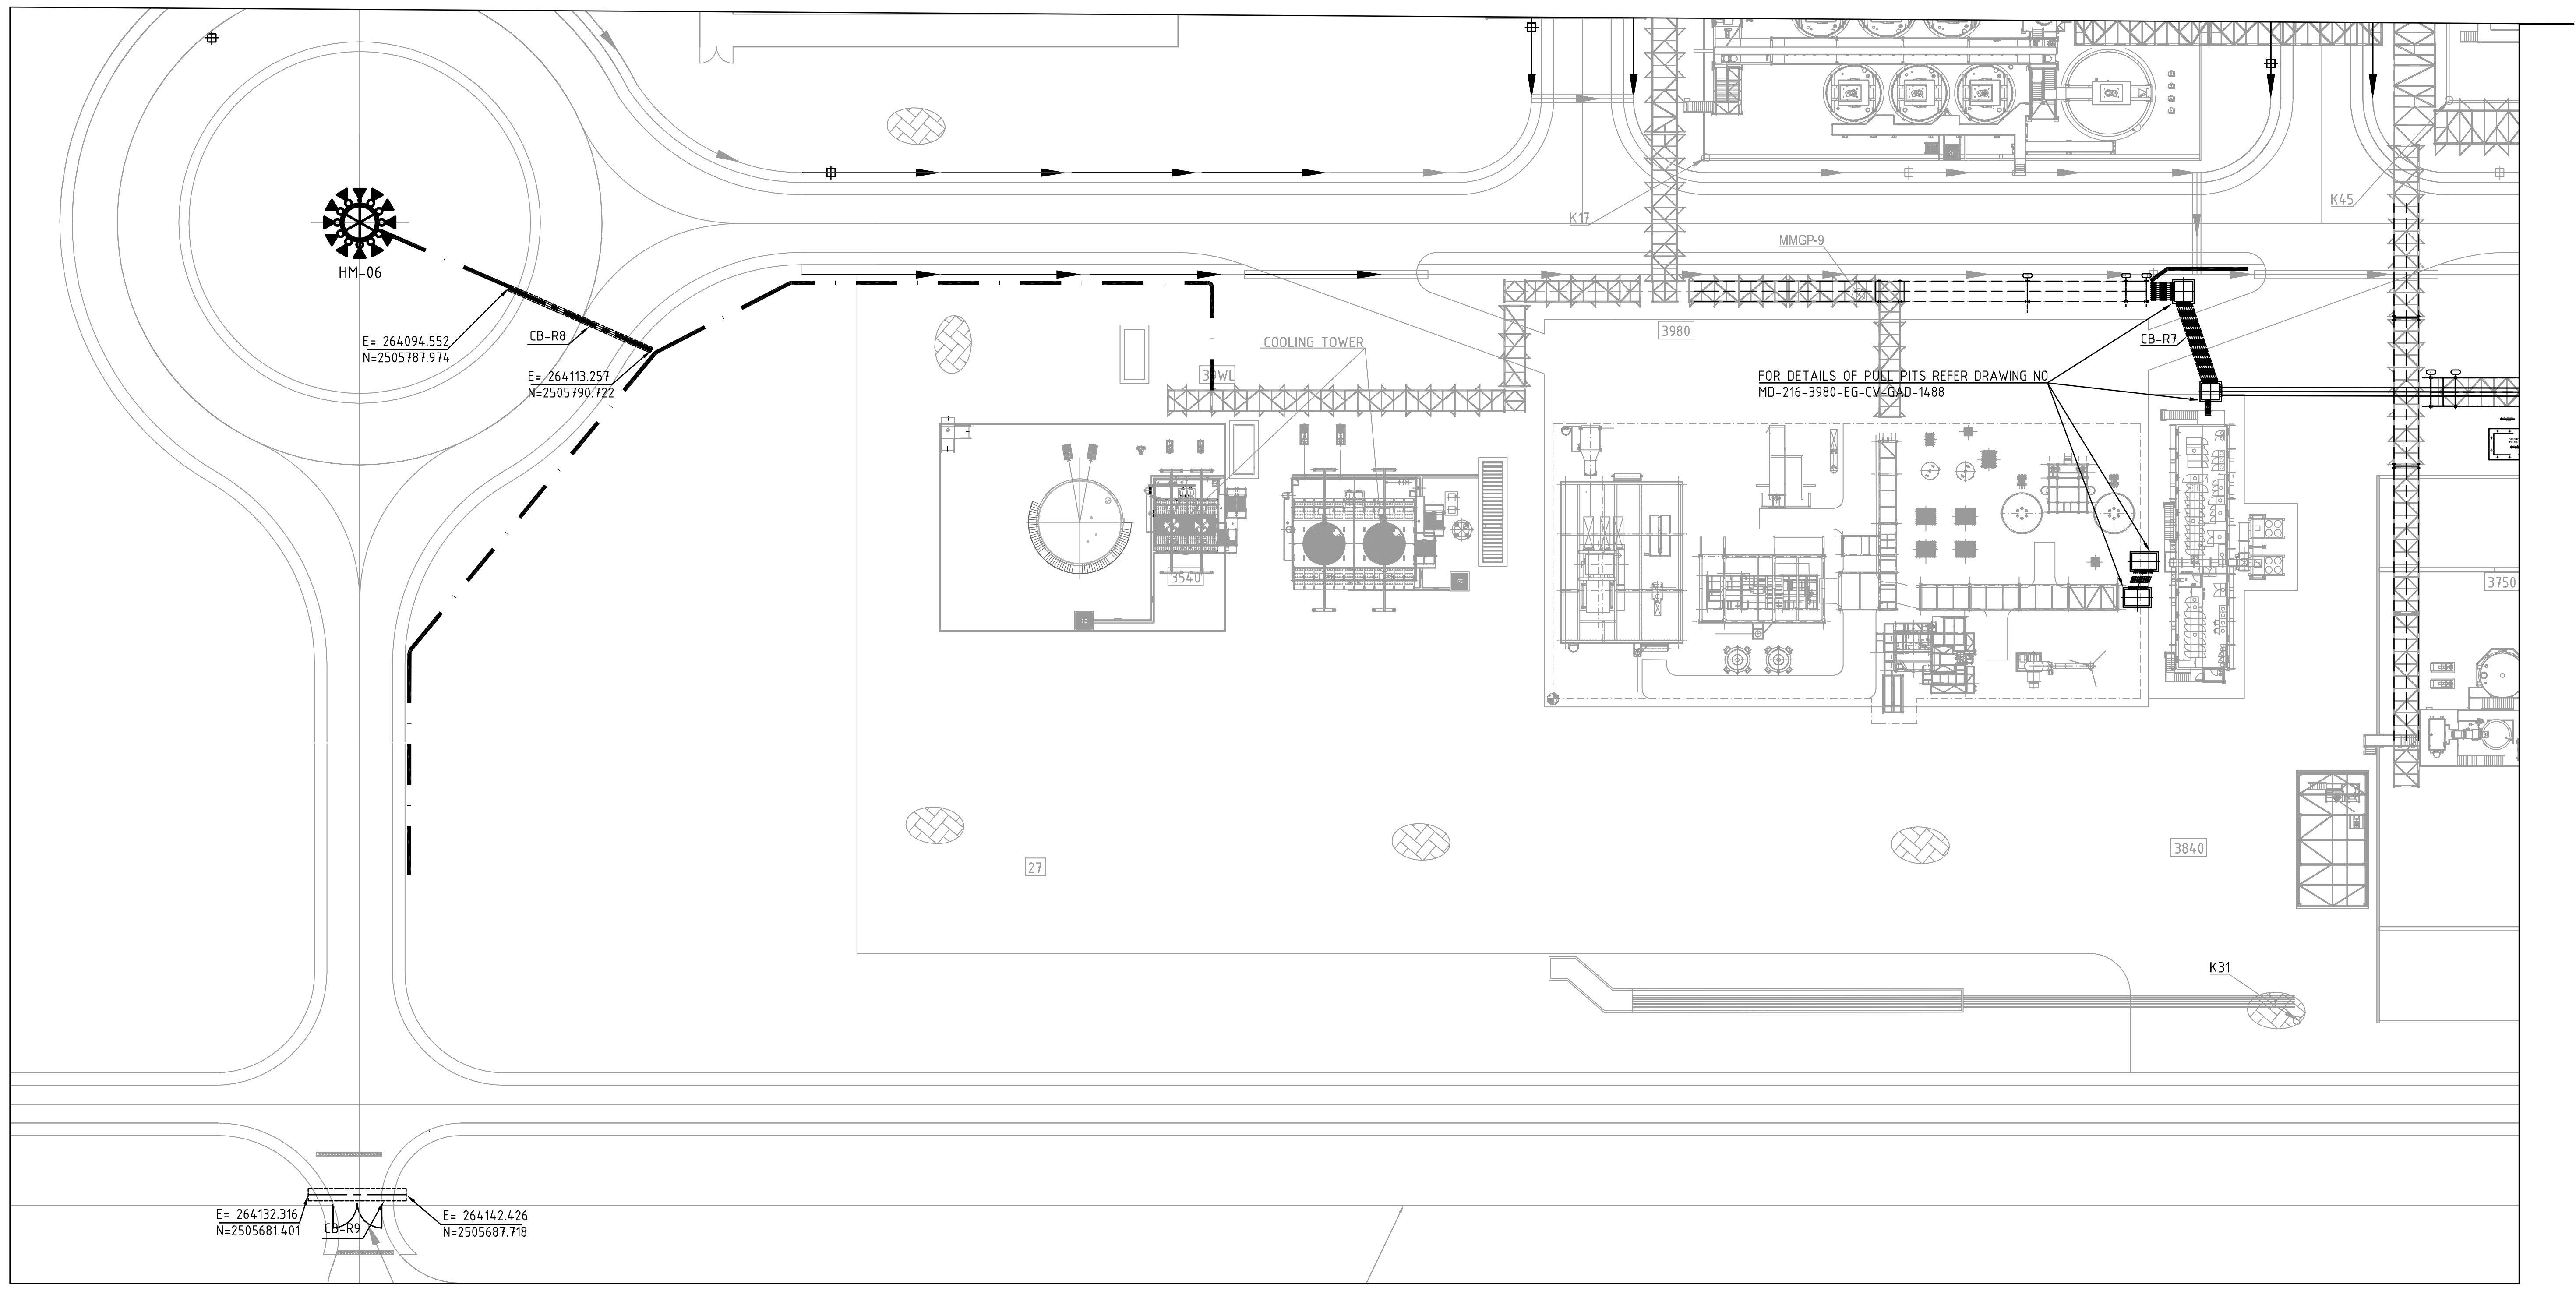
HM-06
E= 264094.552
N=2505787.974
CB-R8
E= 264113.257
N=2505790.722
COOLING TOWER
39WL
3540
27
K17
MMGP-9
3980
K45
CB-R7
FOR DETAILS OF PULL PITS REFER DRAWING NO
MD-216-3980-EG-CV-GAD-1488
3750
3840
K31
E= 264132.316
N=2505681.401
CB-R9
E= 264142.426
N=2505687.718

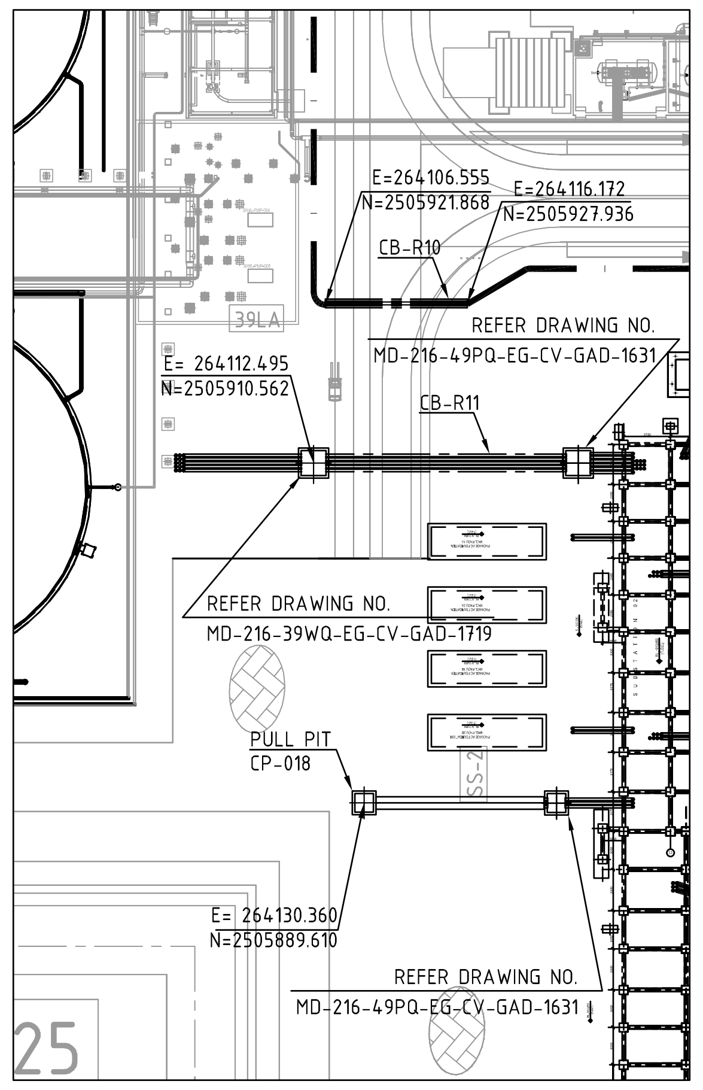
E=264106.555
N=2505921.868
E=264116.172
N=2505927.936
CB-R10
39LA
REFER DRAWING NO.
MD-216-49PQ-EG-CV-GAD-1631
E= 264112.495
N=2505910.562
CB-R11
REFER DRAWING NO.
MD-216-39WQ-EG-CV-GAD-1719
PULL PIT
CP-018
SS-2
E= 264130.360
N=2505889.610
REFER DRAWING NO.
MD-216-49PQ-EG-CV-GAD-1631
25

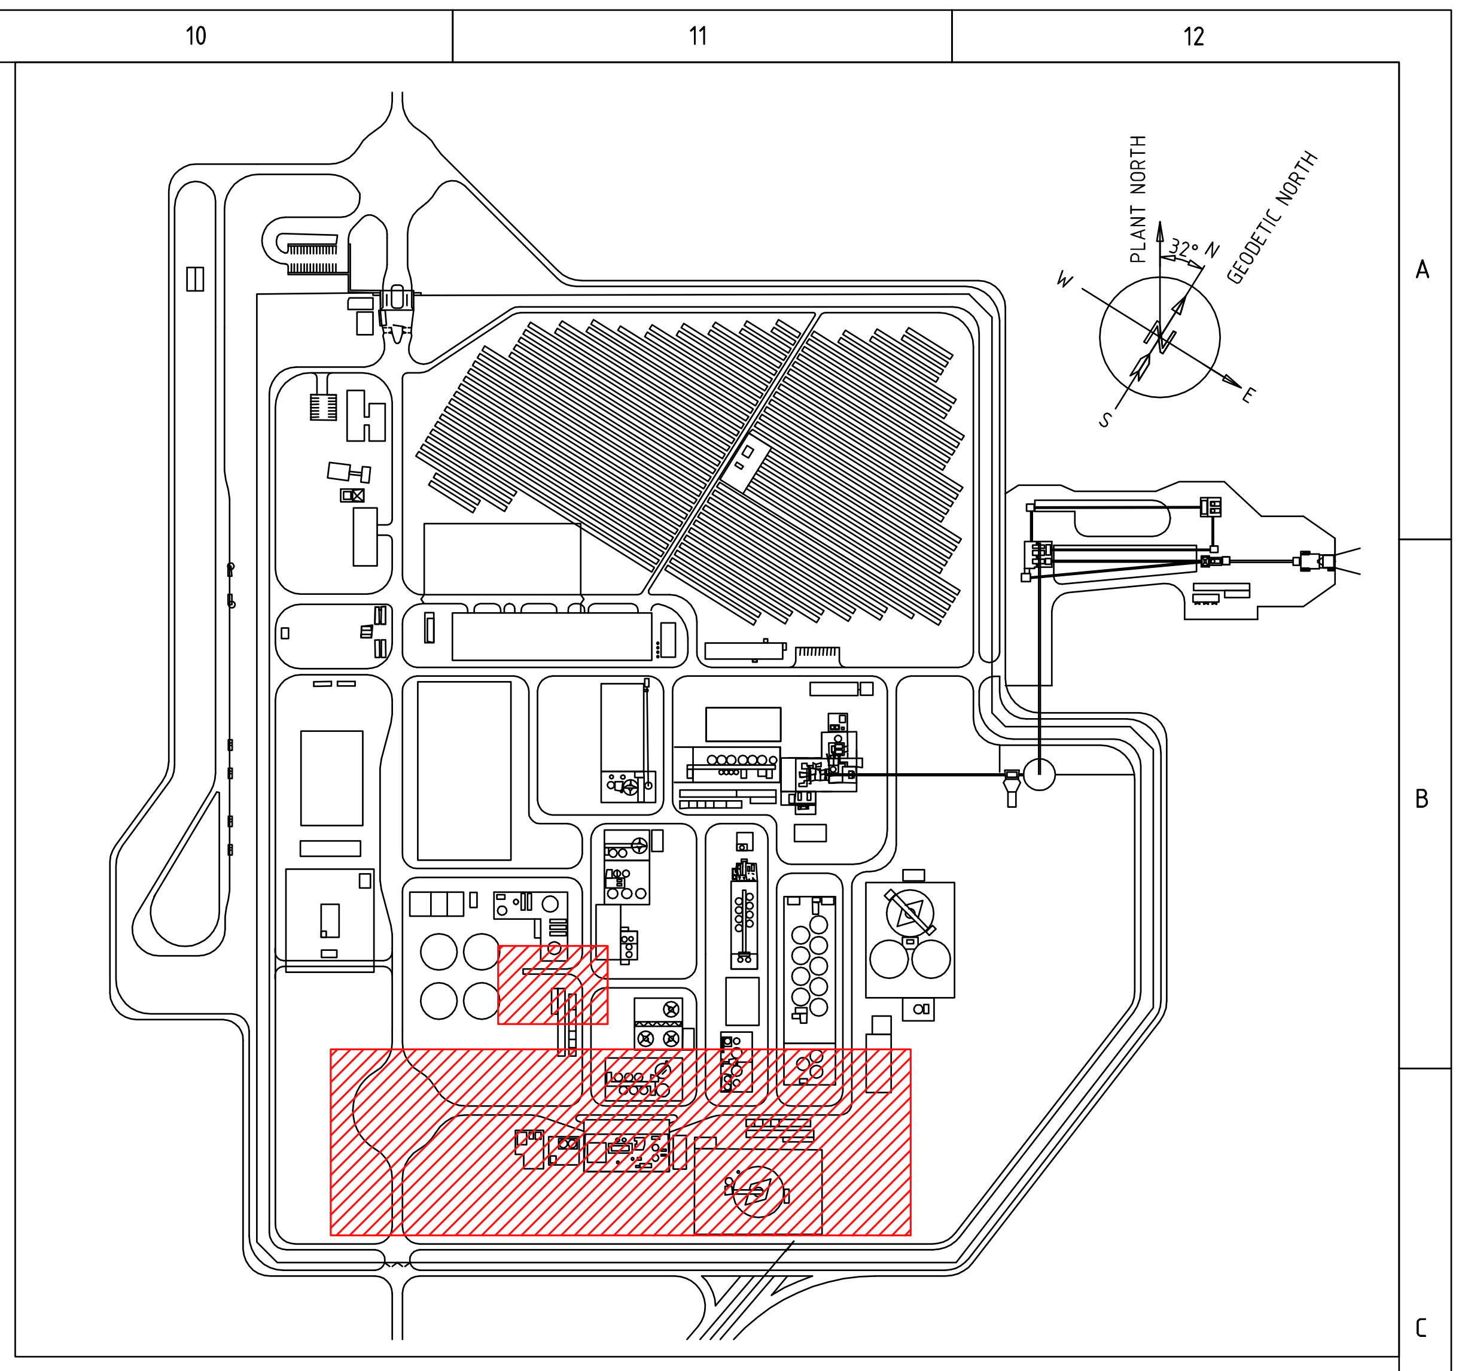
PLANT NORTH
GEODETIC NORTH
32°
N
W
S
E

KEY PLAN

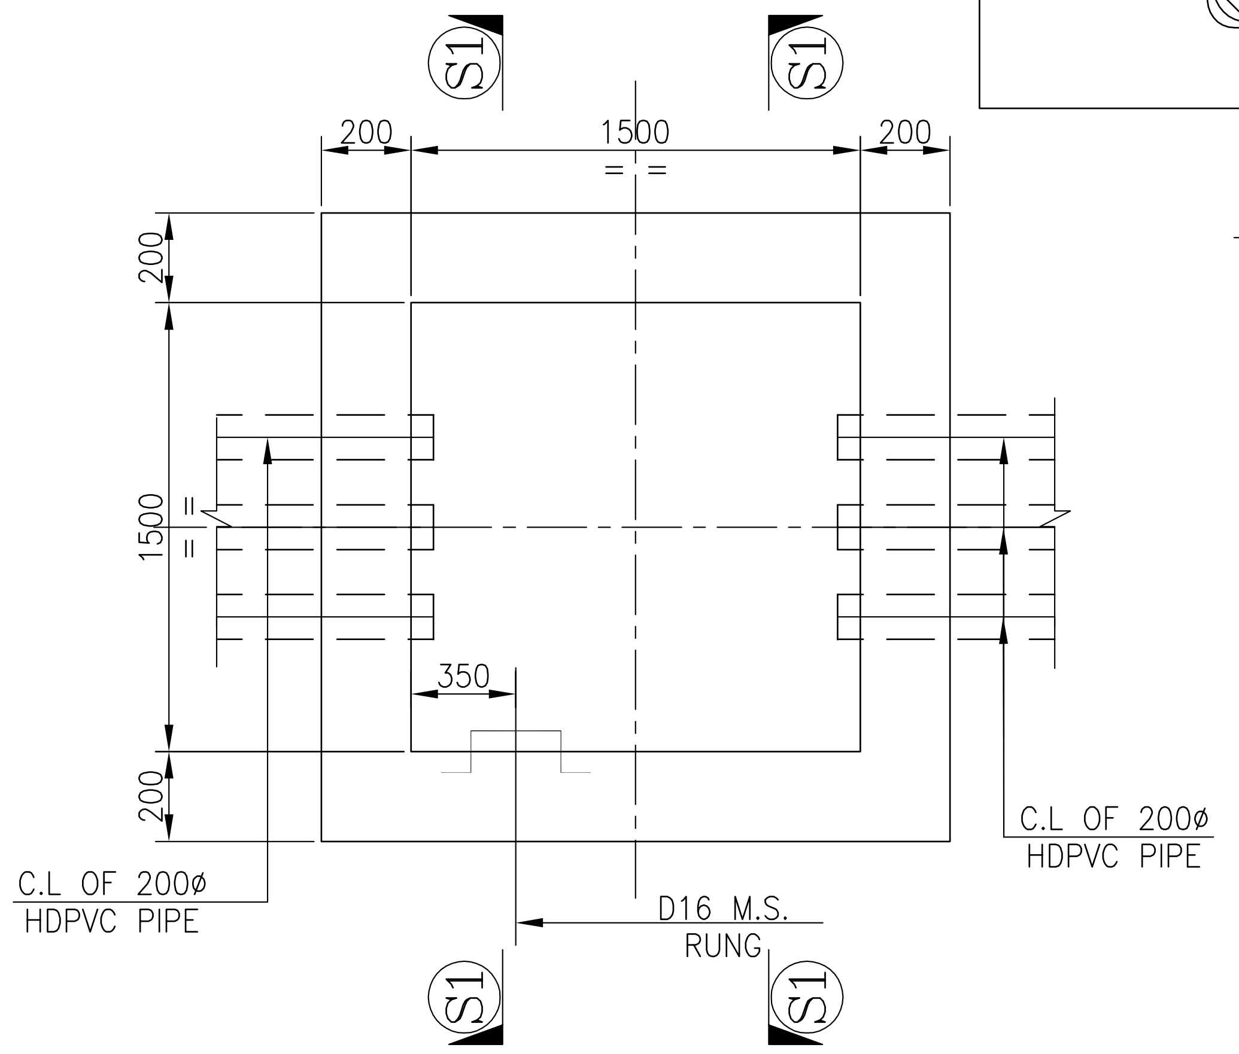
S1
S1
200
1500
200
200
1500
200
350
C.L OF 200ø HDPVC PIPE
C.L OF 200ø HDPVC PIPE
D16 M.S. RUNG
S1
S1

G.A. PLAN FOR PULLPIT MKD. CP–018

SCALE 1:30

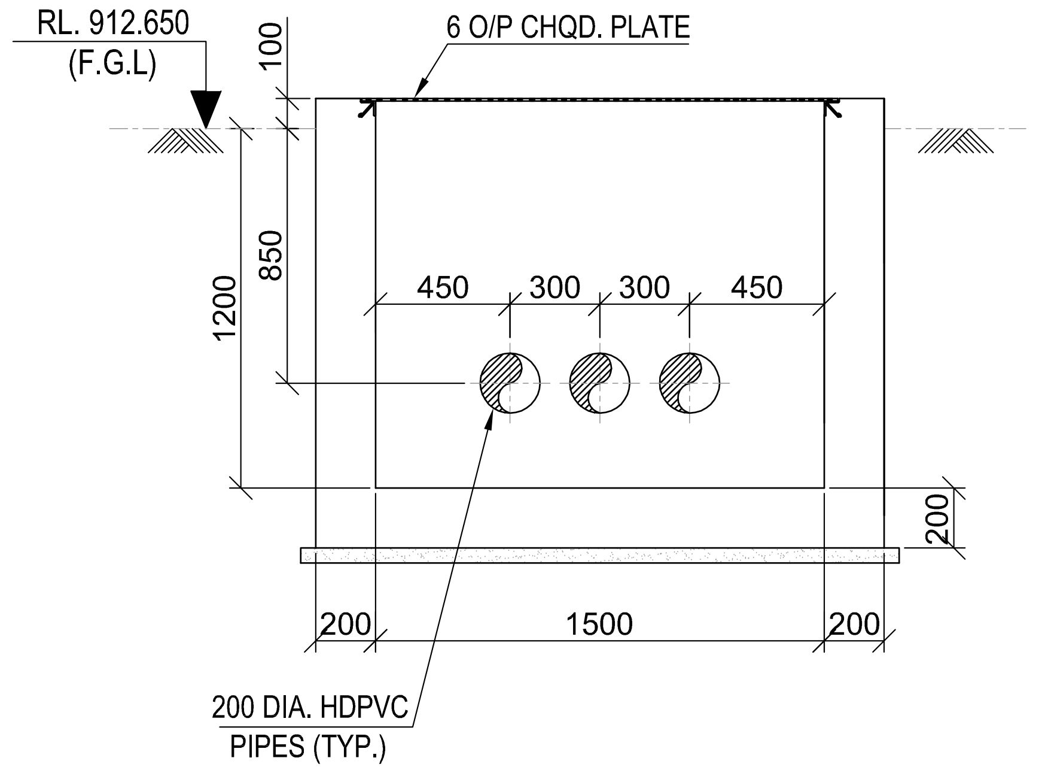
RL. 912.650
(F.G.L)
100
6 O/P CHQD. PLATE
850
1200
450
300
300
450
200
200
1500
200
200 DIA. HDPVC
PIPES (TYP.)

G.A. SECTION S1–S1

SCALE 1:30

LEGEND:

TYP.	TYPICAL
U.N.O	UNLESS NOTED OTHERWISE
G.A.	GENERAL ARRANGEMENT
R.C.	REINFORCED CONCRETE
F.G.L	FINISHED GROUND LEVEL
P.C.C	PLAIN CEMENT CONCRETE
R.C.C	REINFORCED CEMENT CONCRETE
DIA	DIAMETER
ø	DIAMETER
T	TOP
B	BOTTOM
MKD.	MARKED
CHQD.	CHEQUERED
THK.	THICK
PL.	PLATE
C/C	CENTRE TO CENTRE

NOTES:

1. ALL DIMENSIONS ARE IN MILLIMETRES
2. CO-ORDINATES AND LEVELS ARE IN METRES
3. CO-ORDINATES ARE ON WORLD GRID (FLAT PLANT/WORLD)
4. WORLD MAPPING GRID BASED ON UTM (WGS 84) Q38N
5. NET SAFE BEARING CAPACITY OF SOIL AT BOTTOM OF PITS IS CONSIDERED AS 10T/ SQ. M.
6. GRADE OF REINFORCED CEMENT CONCRETE (R.C.C) SHALL BE M35.
7. REINFORCEMENT BARS SHALL CONFORM TO ASTM A615 GRADE 60 (fy=420 N/sq.mm.)
8. CLEAR COVER TO MAIN REINFORCEMENT SHALL BE 25mm(MINIMUM) U.N.O.
9. THIS DRAWING IS TO BE READ IN CONJUNCTION WITH DRAWING NO. MD-216-49FE-EG-CV-GAD-1639 (SHEET 1 OF 3) & (SHEET 2 OF 3).
10. FOR CONCRETE GENERAL NOTES, REFER DRAWING NUMBER MD-216-1000-EG-CV-DED-1005.

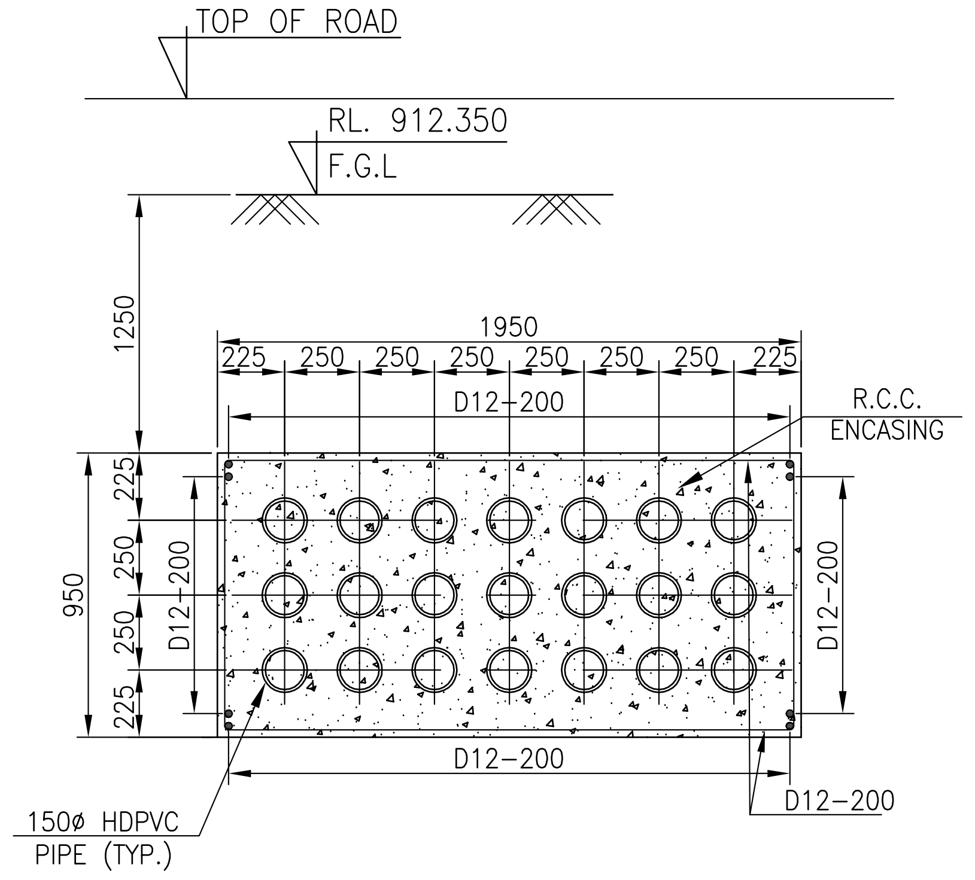
TOP OF ROAD
RL. 912.350
F.G.L
1250
1950
225
250
250
250
250
250
250
225
D12-200
R.C.C.
ENCASING
950
225
250
250
225
D12-200
D12-200
D12-200
D12-200
150ø HDPVC
PIPE (TYP.)

DETAIL OF CB–R7

SCALE 1:25

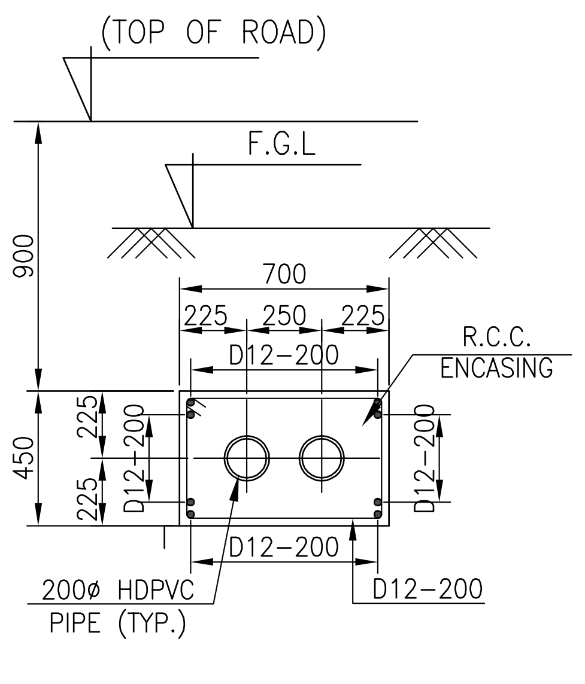
(TOP OF ROAD)
F.G.L
900
700
225
250
225
D12-200
R.C.C.
ENCASING
450
225
225
D12-200
D12-200
D12-200
D12-200
200ø HDPVC
PIPE (TYP.)

DET. OF CB–R8

SCALE 1:25

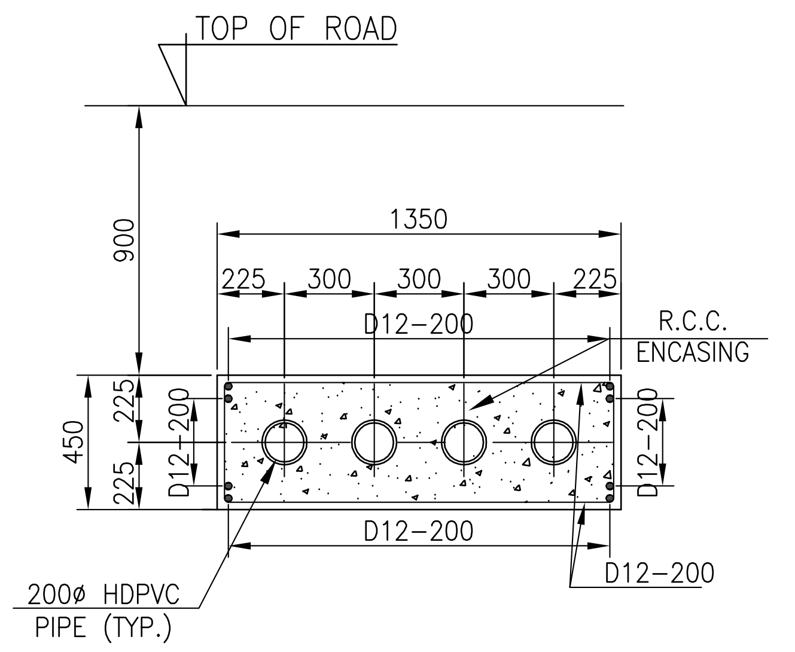
TOP OF ROAD
900
1350
225
300
300
300
225
D12-200
R.C.C.
ENCASING
450
225
225
D12-200
D12-200
D12-200
D12-200
200ø HDPVC
PIPE (TYP.)

DETAIL OF CB–R9

SCALE 1:25

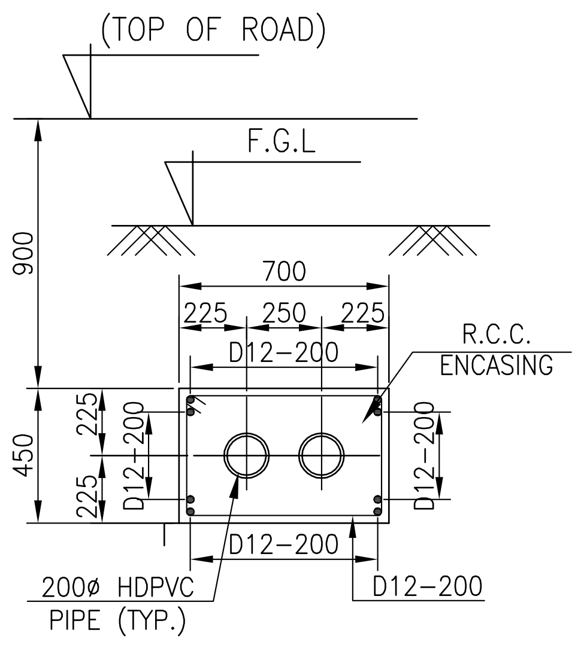
(TOP OF ROAD)
F.G.L
900
700
225
250
225
D12-200
R.C.C.
ENCASING
450
225
225
D12-200
D12-200
D12-200
D12-200
200ø HDPVC
PIPE (TYP.)

DET. OF CB–R10 & CB–R12

SCALE 1:25

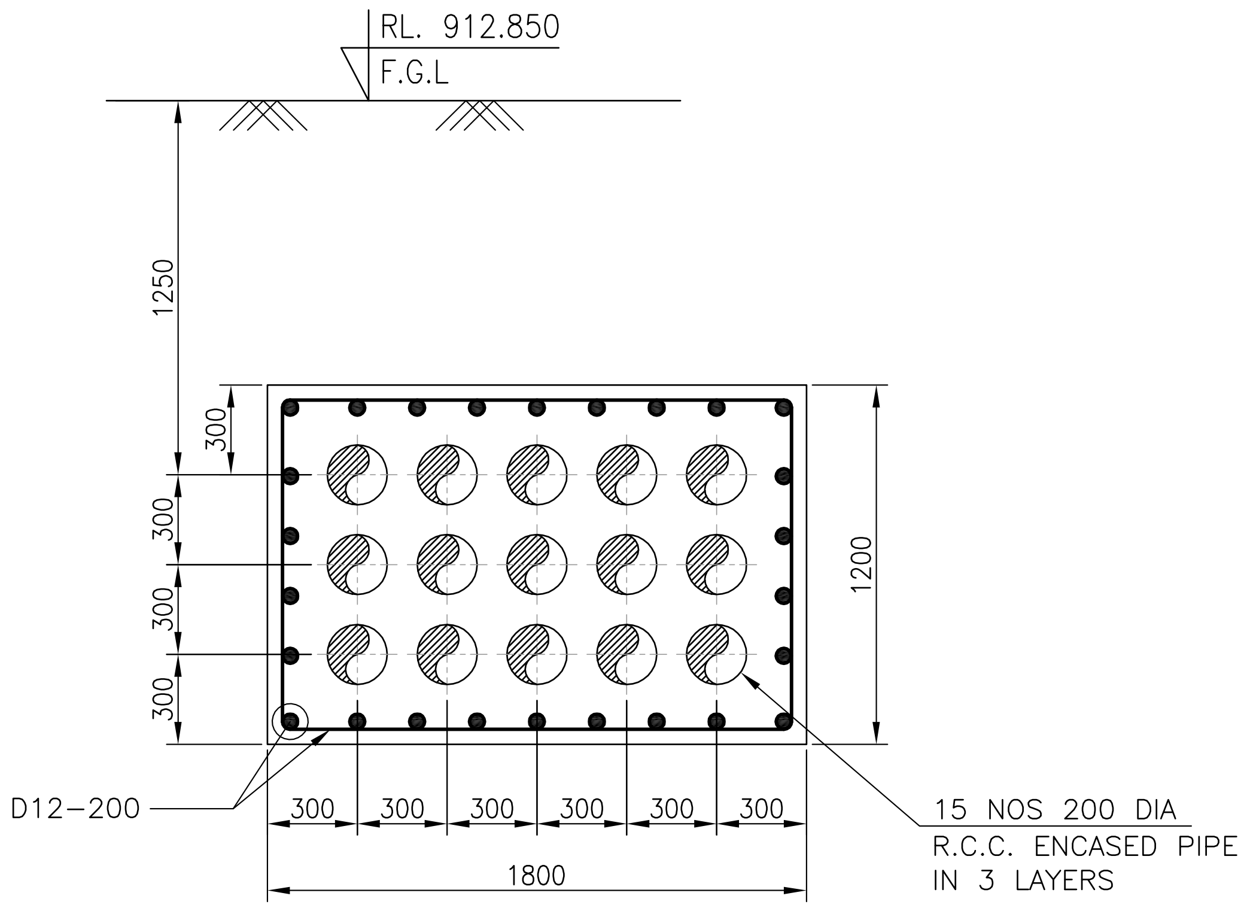
RL. 912.850
F.G.L
1250
300
300
300
300
1200
D12-200
300
300
300
300
300
300
1800
15 NOS 200 DIA
R.C.C. ENCASED PIPE
IN 3 LAYERS

DETAIL OF CB–R11

SCALE 1:25

SHEET 3 OF 3

DOCUMENT NUMBER	REFERENCE DOCUMENTS			REVISION DESCRIPTION	DRN	CHK	ENG	APP	EMP
		D01	06/09/2023	AS-BUILT					
		C01	13/09/2021	ISSUED FOR CONSTRUCTION	SYA	SJM	AVG	AG	
		A02	21/07/2021	REVISED AS PER EMPLOYER COMMENTS DATED 22/06/2021	SYA	SJM	AVG	AG	
MD-216-3000-EG-EL-LAD-1021	PROCESS PLANT UNDER GROUND CABLE ROUTE DETAILS	A01	25/05/2021	ISSUED FOR APPROVAL	SYA	SJM	AVG	AG	

RESERVED FOR VENDOR LOGO AND DRAWING NUMBER

LARSEN & TOUBRO

This drawing is the property of LARSEN & TOUBRO and must not be passed on to any person or body not authorized by us to receive it nor be copied or otherwise made use either in full or in part by such person or body without our prior permission in writing.

Outotec

The content of these documents are the sole property of Outotec Oyj. Any rights not expressly granted herein are reserved. Reproduction, transfer or distribution of part or all of the contents in any form without prior written permission of Outotec is prohibited.

MA'ADEN معادن
Saudi Arabian Mining Company شركة التعدين العربية السعودية

This document and the information contained herein is Ma'aden proprietary know-how. This document or any part thereof should not be reproduced, stored in a retrieval system or transmitted by any means, electronic or otherwise, or divulged without prior written permission of Ma'aden.

LARSEN & TOUBRO DRAWING NUMBER
019045_080_C_G_24550_001
REVISION 3

OUTOTEC DRAWING NUMBER
900707 _GAU01 _AG50_MTL01 _49056
DOCUMENT ID
0U100723932
REVISION 3

DRAWN	SYA	10/05/2021
CHECKED	SJM	11/05/2021
ENGINEER	AVG	10/05/2021
APPROVED	AG	25/05/2021
EMPLOYER		
SCALE	1:150, 50, 40, 30	A1

MANSOURAH - MASSARAH GOLD PROJECT
GENERAL ARRANGEMENT DRAWING
FUEL OIL STORAGE FACILITY
LAYOUT & DETAILS OF CABLE PULL PITS

DRAWING NUMBER
MD - 216 - 49FE - EG - CV - GAD - 1639
REV
D01