

DRAWING NUMBER: MD-216-49EE-EG-CV-DED-1002
REV: D01

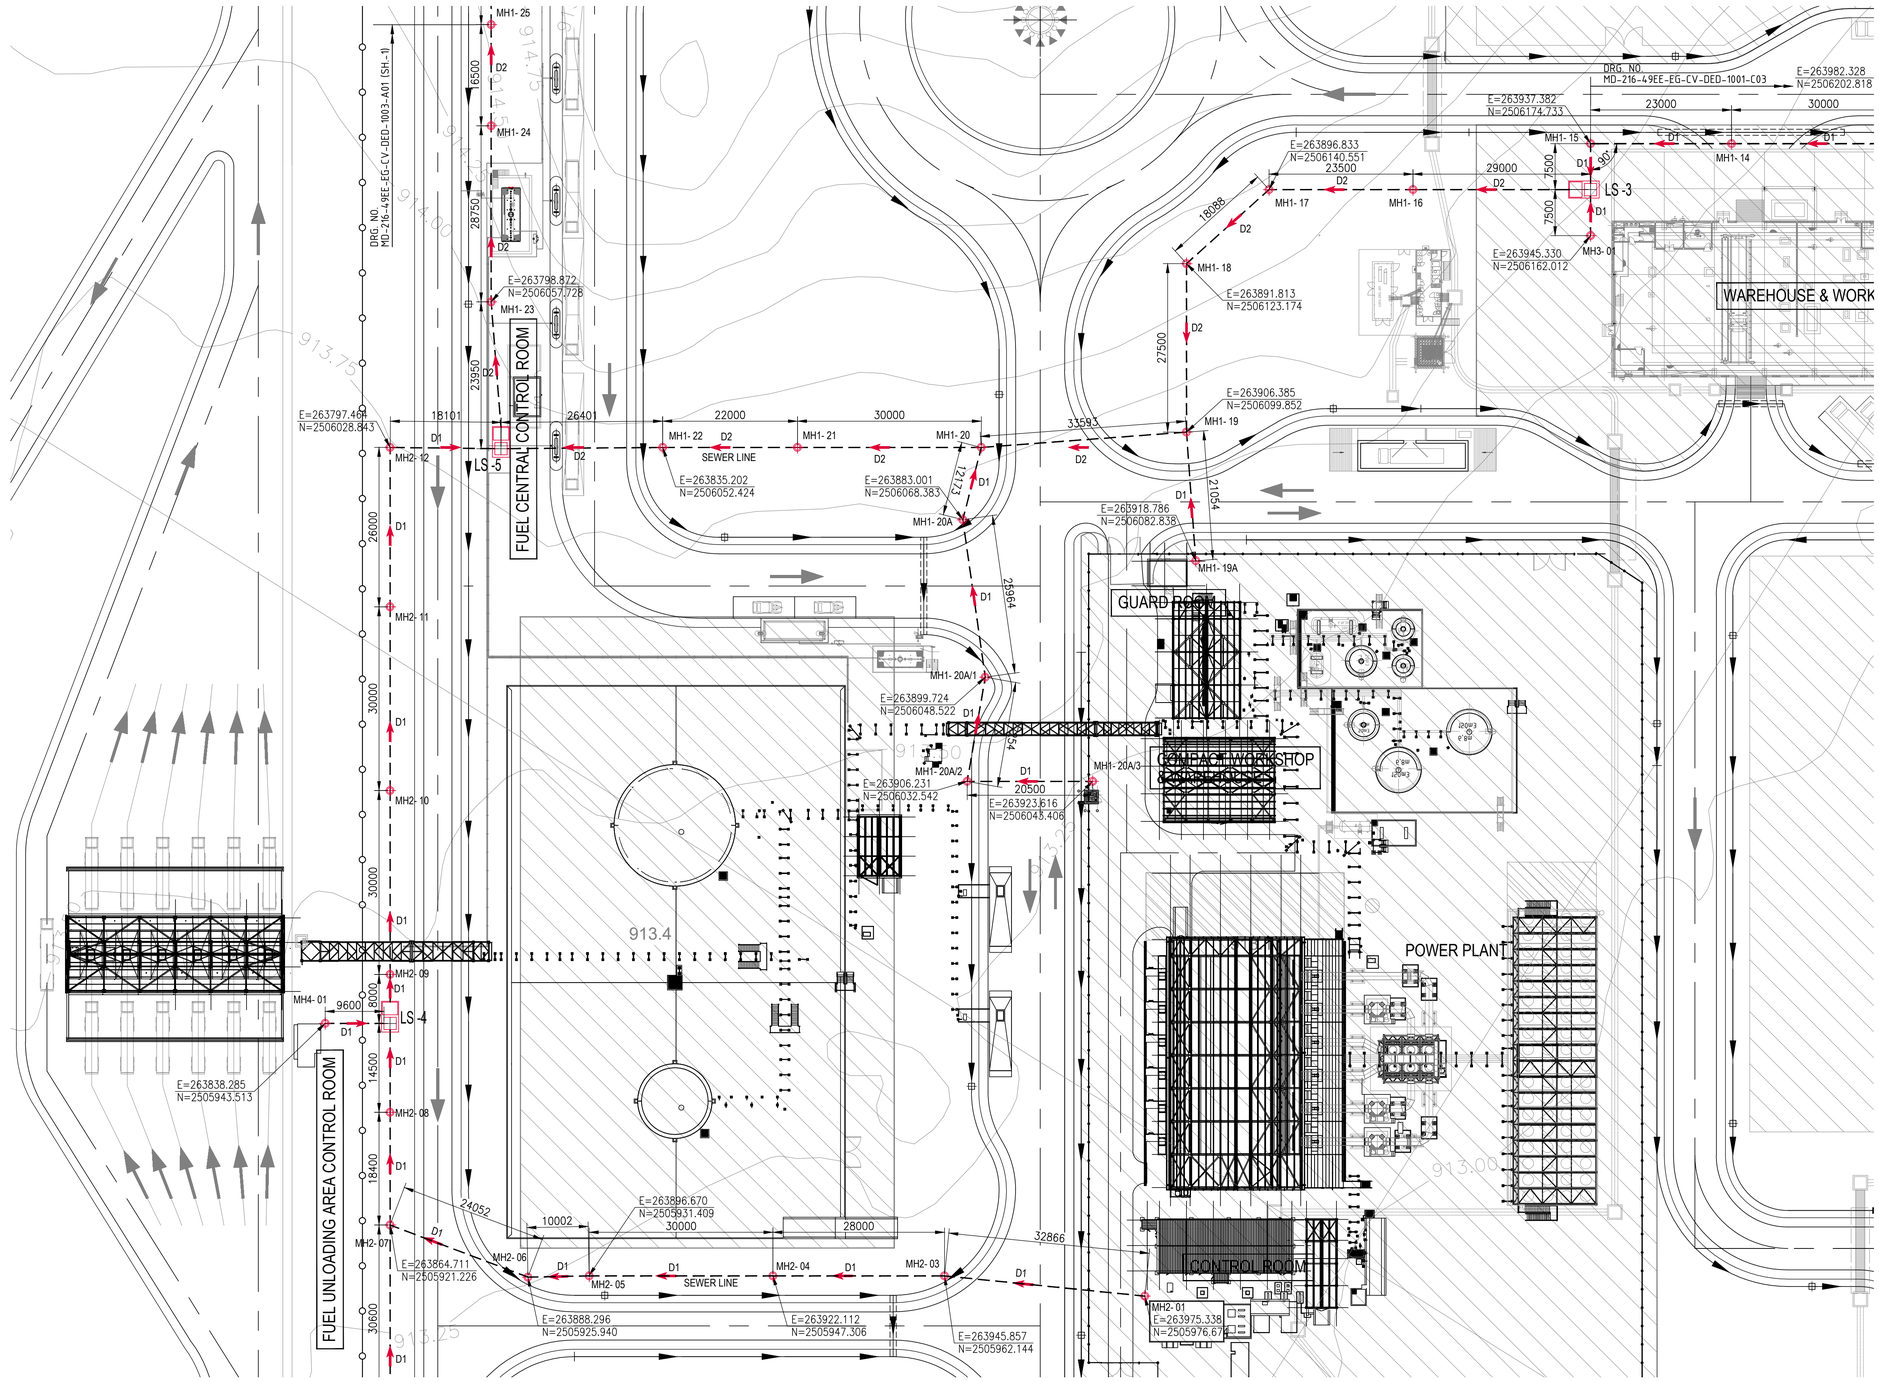

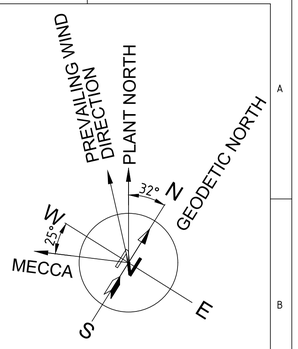

LEGENDS: –

LS = LIFTING STATION
FLSP = FINAL SEWERAGE LIFTING PIT
EGL = EXISTING GROUND LEVEL
FGL = FINISHED GROUND LEVEL
DRG. = DRAWING
S.P. = SOIL PIT
W.P. = WASTE PIT

NOTES:~

1. ALL DIMENSIONS ARE IN MILLIMETESS AND LEVELS AND INVERT LEVEL & CO-ORDINATES ARE IN METRES UNLESS NOTED OTHERWISE.

2. INVERT LEVEL (IL) HAVE BEEN INDICATED FOR POINT OF SEWERAGE DRAIN AND UNIFORM SLOPE SHOULD BE PROVIDED BETWEEN THE MANHOLE.

3. MANHOLE LOCATIONS NEAR TOILET ARE TENTATIVE.

4. LENGTH OF SEWER WATER PIPE BETWEEN MANHOLES ARE INDICATED IN THIS DRAWING. THESE LENGTHS ARE APPROXIMATE (HORIZONTAL) AND TO BE ADJUSTED DURING CONSTRUCTION FOR PROPER FIXING.

5. SEWERAGE COLLECTION PIPE/DRAIN SHALL BE PROVIDED FROM TOILET/OTHER FACILITIES LOCATIONS UP TO MANHOLES WHEREVER REQUIRED. OTHERWISE CONNECTION PIPE/DRAIN SHALL BE PROVIDED BETWEEN S.P/W.P. AND NEAREST SEWERAGE MANHOLE.

6. THIS DRAWING IS APPLICABLE ONLY FOR SEWERAGE DRAIN NETWORK AND MANHOLE LOCATIONS. ALL OTHER INFORMATION, eg. LEVEL(EC.),FACILITY OUTLINE,GRADING ETC. ARE SHOWN IN THIS DRAWING FOR INFORMATION ONLY.

7. INVERT LEVELS (IL) HAVE BEEN INDICATED FOR THE MANHOLES AND UNIFORM SLOPE SHOULD BE PROVIDED IN THE SANITARY SEWER LINES BETWEEN THE MANHOLES.

8. PIPE BETWEEN LIFTING STATION (LS) AND NEXT MANHOLE SHALL BE PRESSURE PIPE, FOR LAYOUT AND DETAILS REFER UTILITY DRAWINGS.

9. FOR S.P./W.P. LOCATION AND DETAILS REFER ARCHITECTURAL DRAWINGS.

10. THIS DRAWING SHOULD BE READ IN CONJUNCTION WITH DRG. NO. MD-216-49EE-EG-CV-DED-1001, MD-216-49EE-EG-CV-DED-1003 & MD-216-49EE-EG-CV-DED-1004.

LIST OF DRAWING NO. OF LIFTING STATION :-

LIFTING STATION	DRAWING NO.
LS-1	MD-216-49EE-EG-CV-GAD-1001
LS-2	MD-216-49EE-EG-CV-GAD-1002
LS-3	MD-216-49EE-EG-CV-GAD-1003
LS-4	MD-216-49EE-EG-CV-GAD-1004
LS-5	MD-216-49EE-EG-CV-GAD-1005
LS-6	MD-216-49EE-EG-CV-GAD-1006

LS=LIFTING STATION, FSLP=FINAL SEWERAGE LIFTING PIT

Schedule of Sewer Water PVC Pipes / Encased PVC Pipes

Pipes	Diameter	Slope
D1	150	1/100
D2	200	1/150
D3	250	1/150

DOCUMENT NUMBER	REFERENCE DOCUMENTS	REV	DATE	REVISION DESCRIPTION	DRN	CHK	ENG	APP	EMP
		D01	16/02/2023	AS-BUILT	PML	BJB	APEX	SJM	
		C05	10/12/2021	ISSUED FOR CONSTRUCTION AND REVISED AS MARKED (A05)	PML	BJB	APEX	SJM	
		C04	27/08/2021	ISSUED FOR CONSTRUCTION AND REVISED AS MARKED (A04)	PML	BJB	APEX	SJM	
		C03	19/04/2021	ISSUED FOR CONSTRUCTION AND REVISED AS MARKED (A03)	APEX	BJB	APEX	SJM	
		C02	20/01/2021	ISSUED FOR CONSTRUCTION AND REVISED AS MARKED (A02)	APEX	BJB	APEX	SJM	
		C01	23/07/2020	ISSUED FOR CONSTRUCTION AND REVISED AS MARKED (A01)	APEX	SNM	APEX	SJM	
MD-216-1000-EG-GE-PPD-1002	PROCESS PLANT LAYOUT	A01	23/06/2020	ISSUED FOR REFERENCE	APEX	SNM	APEX	SJM	

RESERVER FOR VENDOR LOGO AND DRAWING NUMBER

LARSEN & TOUBRO DRAWING NUMBER: 019045_910_C_V_24021_002 — REVISION: 6
OUTOTEC DRAWING NUMBER: 900707__GAU01__AG90__CTB17__50001 — DOCUMENT ID: OU100673151 — REVISION: 6

LARSEN & TOUBRO
This drawing is the property of LARSEN & TOUBRO and must not be passed on to any person or body not authorized by us to receive it nor be copied or otherwise made use either in full or in part by such person or body without our prior permission in writing.

Outotec
The content of these documents are the sole property of Outotec Oyj. Any rights not expressly granted herein are reserved. Reproduction, transfer or distribution of part or all of the contents in any form without prior written permission of Outotec is prohibited.

MA'ADEN معادن
Saudi Arabian Mining Company شركة التعدين العربية السعودية
This document and the information contained herein is Ma'aden proprietary know-how. This document or any part thereof should not be reproduced, stored in a retrieval system or transmitted by any means, electronic or otherwise, or divulged without prior written permission of Ma'aden.

DRAWN	APEX	19/06/2020
CHECKED	SNM	22/06/2020
ENGINEER	APEX	17/06/2020
APPROVED	SJM	23/06/2020
EMPLOYER		
SCALE	1:500	A1

MANSOURAH - MASSARAH GOLD PROJECT
DETAIL DRAWING
PROCESS PLANT SEWERAGE NETWORK
LAYOUT & DETAILS OF SEWERAGE NETWORK

DRAWING NUMBER: MD-216-49EE-EG-CV-DED-1002 — REV: D01