


DRAWING NUMBER MD-216-49EE-EG-CV-DED-1590 REV D01

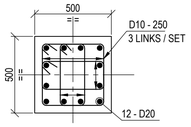


RCC. DET. OF C1 & C1A
SCALE 1:20

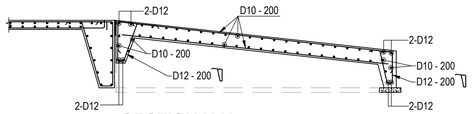


SECTION H-H
SECTION H'-H' (OPPOSITE HAND)
(R.C DETAIL)
SCALE 1:50

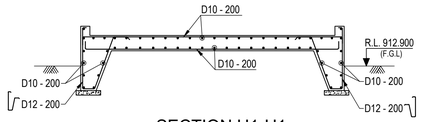


SECTION H1-H1
(RCC DETAIL)
SCALE 1:50

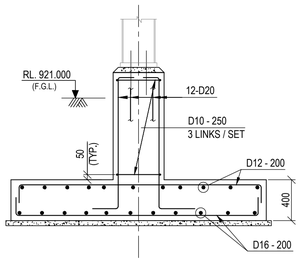


SECTION : A-A
SCALE 1:30

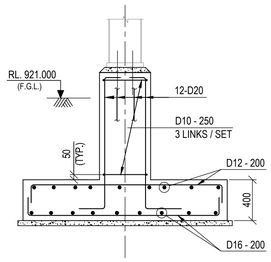


SECTION : B-B
SCALE 1:30

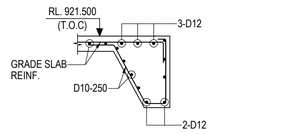


SECTION G-G
SECTION G'-G' (OPPOSITE HAND)
(R.C DETAIL)
SCALE 1:30

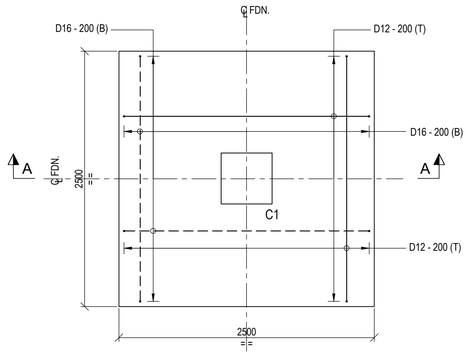

RCC. DETAIL OF
FOUNDATION MKD. F1
SCALE 1:30

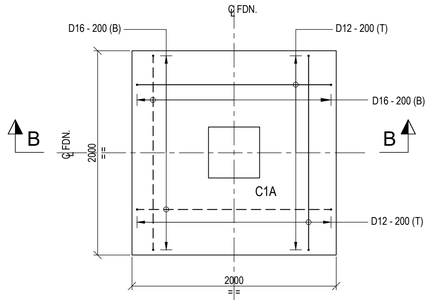

RCC. DETAIL OF
FOUNDATION MKD. F1A
SCALE 1:30

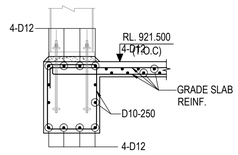

SECTION E-E
SECTION E'-E' (OPPOSITE HAND)
(R.C DETAIL)
SCALE 1:30

LEGENDS :

TOC - TOP OF CONCRETE
RL- REDUCED LEVEL
TYP - TYPICAL
PCC - PLAIN CEMENT CONCRETE
MKD - MARKED
COL - COLUMN
FGL - FINISHED GROUND LEVEL
BOF - BOTTOM OF FOUNDATION
℄ - CENTRE LINE
RCC - REINFORCED CEMENT CONCRETE
DRG. - DRAWING
NO. - NUMBER
THK - THICKNESS
REINF. - REINFORCEMENT
FDN. - FOUNDATION
BOTTOM REBAR (B) - — — — — —
TOP REBAR (T) - ————————

NOTES :-

1. ALL DIMENSIONS ARE IN MILLIMETRES AND LEVELS AND CO-ORDINATES ARE IN METRES UNLESS OTHERWISE STATED.
2. FOR OTHER NOTES REF. DRG. NO. MD-216-49EE-EG-CV-GAD-1587.
3. THIS DRAWING IS TO BE READ IN CONJUNCTION WITH DRG. NO. MD-216-49EE-EG-CV-GAD-1587.

DOCUMENT NUMBER	REFERENCE DOCUMENTS	REV	DATE	REVISION DESCRIPTION	DRN	CHK	ENG	APP	EMP
		D01	16/02/2023	AS-BUILT	SYA	SJM	AVG	AG	
		C03	17/05/2021	ISSUED FOR CONSTRUCTION & REVISED AS MARKED C03	SYA	SJM	AVG	AG	
		C02	15/03/2021	ISSUED FOR CONSTRUCTION & REVISED AS MARKED C02	SYA	SJM	AVG	AG	
		C01	09/09/2020	ISSUED FOR CONSTRUCTION	SYA	SJM	SOR	AG	
MD-216-4010-EG-AR-DGA-0005	GENERAL SITE AREA WASTE STORAGE BUILDING	A01	27/07/2020	ISSUED FOR REFERENCE	DSR	SJM	SOR	AG	

RESERVED FOR VENDOR LOGO AND DRAWING NUMBER

LARSEN & TOUBRO
This drawing is the property of LARSEN & TOUBRO and must not be passed on to any person or body not authorized by us to receive it nor be copied or otherwise made use either in full or in part by such person or body without our prior permission in writing.

Outotec
The content of these documents are the sole property of Outotec Oyj. Any rights not expressly granted herein are reserved. Reproduction, transfer or distribution of part or all of the contents in any form without prior written permission of Outotec is prohibited.

MA'ADEN معادن
Saudi Arabian Mining Company شركة التعدين العربية السعودية
This document and the information contained herein is Ma'aden proprietary know-how. This document or any part thereof should not be reproduced, stored in a retrieval system or transmitted by any means, electronic or otherwise, or divulged without prior written permission of Ma'aden.

LARSEN & TOUBRO DRAWING NUMBER			REVISION
019045_045_C_D_24286_001			4
OUTOTEC DRAWING NUMBER		DOCUMENT ID	REVISION
900707__GAU01__AG90__CTB17__50007		OU100692389	4
DRAWN	DSR	23/07/2020	
CHECKED	SJM	24/07/2020	
ENGINEER	SOR	21/07/2020	
APPROVED	AG	27/07/2020	
EMPLOYER			
SCALE	1:100, 50	A1	

MANSOURAH - MASSARAH GOLD PROJECT
DETAIL DRAWING
WASTE DISPOSAL : WASTE STORAGE BUILDING
BUILDING FOUNDATION RC DETAIL

DRAWING NUMBER MD-216-49EE-EG-CV-DED-1590 REV D01