

DRAWING NUMBER MD-216-1800-EG-CV-GAD-1535 | REV D01

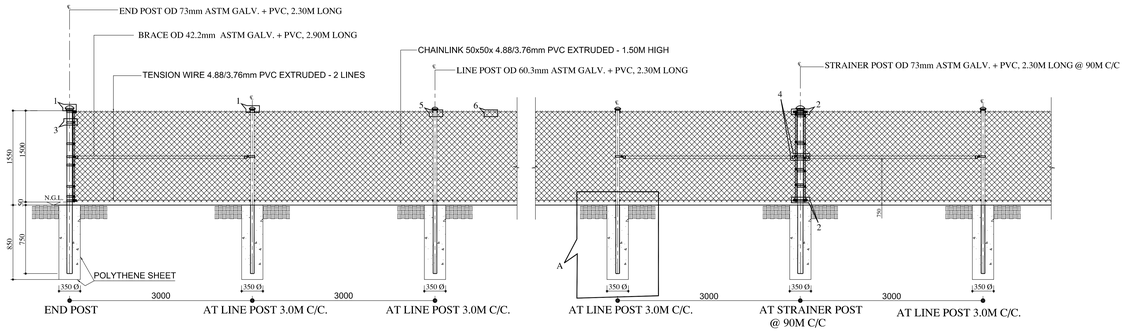

TYPICAL FENCE ELEVATION
1:50

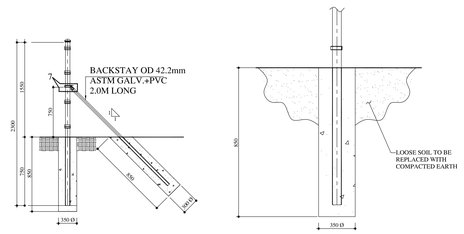

SIDE SECTION DETAIL
FOR CORNER / STRAINING / END POST

DETAIL - A
(WHERE LOOSE SOIL IS ENCOUNTERED)

TECHNICAL SPECIFICATION

FENCE TYPE: DEMARCATION FENCE


POSTS & BRACES

ALL FENCE POSTS & BRACES ARE COMPLYING ASTM A-53 SCH. 40 GALV.


ITEM	POST LENGTH	OUTSIDE DIA(MM)	WALL THICKNESS	WEIGHT Kg/M
LINE POST	2300	60.3	3.91	5.44
CORNER , END AND STRAINING POST	2300	73	5.16	8.65
BRACE PIPE	2900	42.2	3.56	3.39
BACKSTAY PIPE	2000	42.2	3.56	3.39

WIRES


CLASS	CHAIN LINK FABRIC MESH	CHAIN LINK FABRIC WIRE DIA	TENSION WIRE	STIRRUP WIRE	TIE WIRE
A	50	4.88/3.76	4.88 / 3.76	3.55 / 2.50	2.0 / 1.60

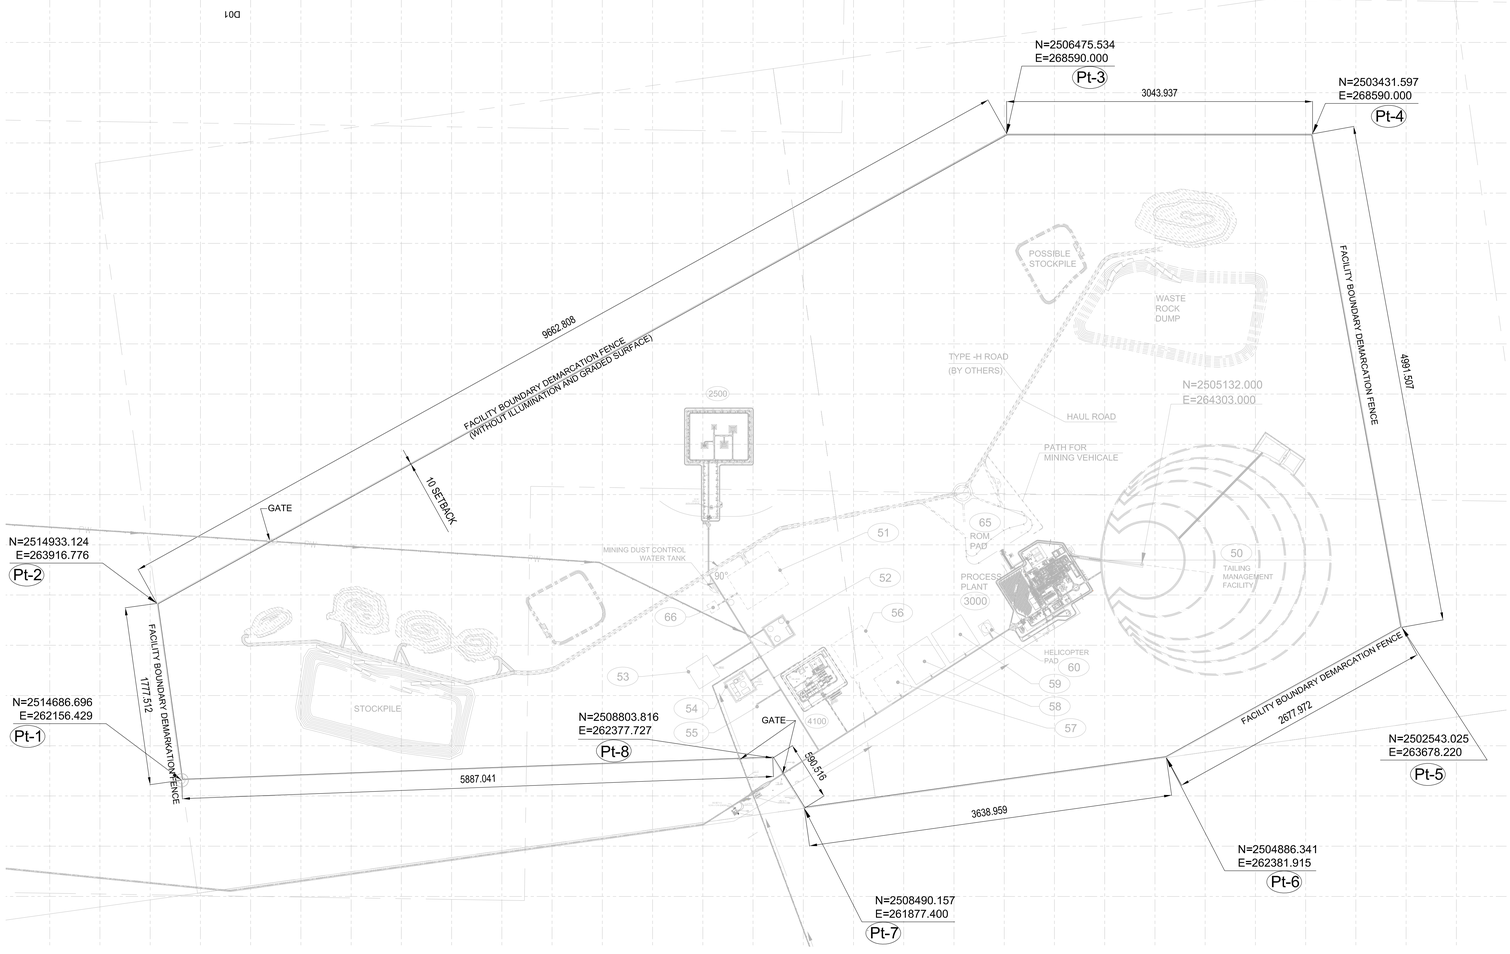


MINING BOUNDARY OVERALL PERIMETER FENCE
1:30000

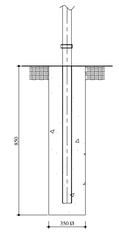


DETAIL - A
(AT NORMAL SOIL CONDITION)

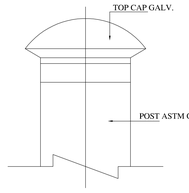


DETAIL - 1
TOP CAP of ALL POST

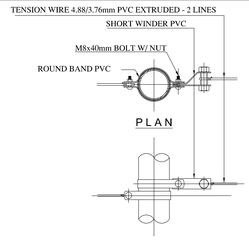


DETAIL - 2

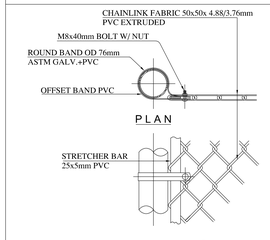


DETAIL - 3

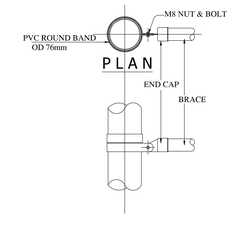


DETAIL - 4

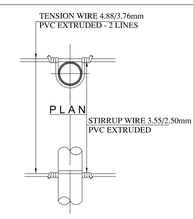

DETAIL - 5

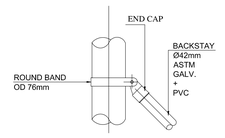

DETAIL -7

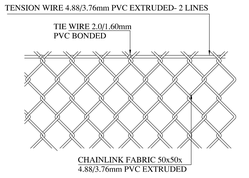

DETAIL - 6

NOTES:~

1. ALL DIMENSION ARE IN MILLMETER UNLESS OTHERWISE NOTED.
2. ALL FENCE POST & BRACES ARE COMPLYING ASTM A-53 SCH. 40 GALVANIZED + PVC COATED AS PER ASTM F1043
3. WIRE FOR CHAIN LINK IS PVC EXTRUDED
4. TENSION WIRE , STIRRUP WIRE & TIE WIRE ARE PVC EXTRUDED
5. ALL FENCE FITTING HOT DIPPED GALVANIZED AS PER ASTM F626 + PVC COATED AS PER ASTM F1043
6. CONCRETE SHALL BE PLAIN CEMENT CONCRETE (P.C.C.) OF GRADE 28 MPA (COMPRESSIVE STRENGTH AT 28 DAYS)
7. FENCE SHALL CONFORM TO PROVISION OF ASTM F 567-11a.
8. FENCE SHALL BE INSTALLED ON EXISTING NATURAL GROUND LEVELS (N.G.L.) AS AVAILABLE AT SITE.

DOCUMENT NUMBER	REFERENCE DOCUMENTS	REV	DATE	REVISION DESCRIPTION	DRN	CHK	ENG	APP	EMP
		D01	05/10/2023	AS BUILT	SYA	SJM	SOR	AG	
		C01	20-12-2019	ISSUED FOR CONSTRUCTION	SYA	SJM	SOR	AG	
MD-216-1800-EG-ME-BOD-1001	BASIS OF DESIGN, GOLD PROCESSING PLANT SECURITY SYSTEM -A01	A02	08-11-2019	REVISED AS PER EMPLOYER / PMC COMMENT DATED 14.10.19	SYA	SJM	SOR	AG	
MD-216-0000-EG-GE-DPP-0003	FACILITY BOUNDARY FENCE - C04	A01	21-09-2019	FIRST ISSUE	SYA	SOR	SOR	SJM	

LARSEN & TOUBRO

This drawing is the property of LARSEN & TOUBRO and must not be passed on to any person or body not authorized by us to receive it nor be copied or otherwise made use either in full or in part by such person or body without our prior permission in writing.

Outotec

The content of these documents are the sole property of Outotec Oyj. Any rights not expressly granted herein are reserved. Reproduction, transfer or distribution of part or all of the contents in any form without prior written permission of Outotec is prohibited.

MA'ADEN معادن
Saudi Arabian Mining Company شركة معادن العربية السعودية

This document and the information contained herein is Ma'aden proprietary know-how. This document or any part thereof should not be reproduced, stored in a retrieval system or transmitted by any means, electronic or otherwise, or divulged without prior written permission of Ma'aden.

DRAWN	SYA 3	21-09-2019	
CHECKED	SOR	21-09-2019	
ENGINEER	SOR	21-09-2019	
APPROVED	SJM	21-09-2019	
EMPLOYER	D01		
SCALE	1:30000, 50, 25	A0	

LARSEN & TOUBRO DRAWING NUMBER: 019045_900_C_G_24240_001 — REVISION: 3

OUTOTEC DRAWING NUMBER: 900707_GAU01_Z3J1_MTL01_00002 — DOCUMENT ID: OU100660773 — REVISION: 3

MANSOURAH - MASSARAH GOLD PROJECT

GENERAL ARRANGEMENT

SECURITY SYSTEM-MINING BOUNDARY OVERALL PERIMETER FENCE PLAN, SECTIONS & DETAILS

DRAWING NUMBER: MD-216-1800-EG-CV-GAD-1535 — REV: D01