


DRAWING NUMBER
MD-216-1800-EG-CV-GAD-1548
REV D01

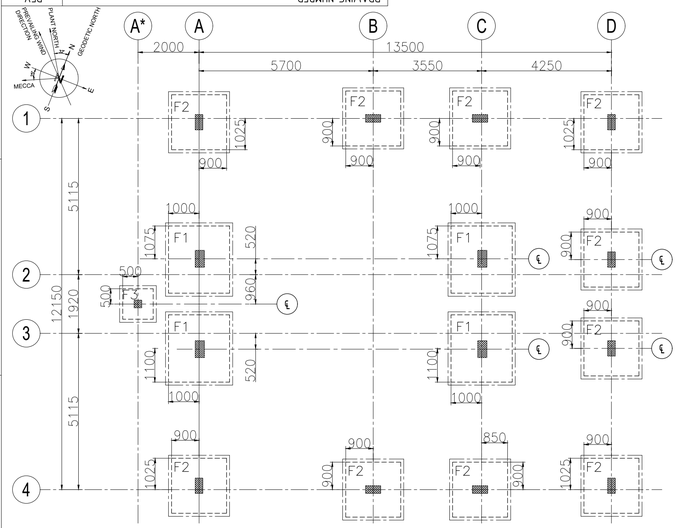

FOUNDATION LAYOUT
SCALE 1:100

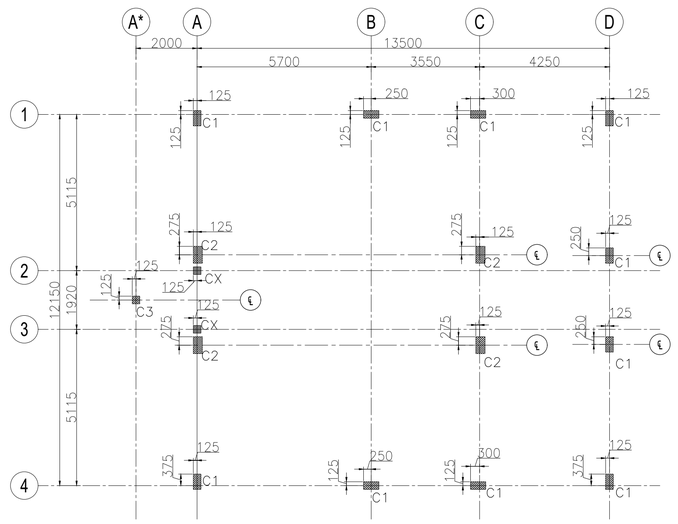



CONCRETE COLUMN LAYOUT
SCALE 1:100

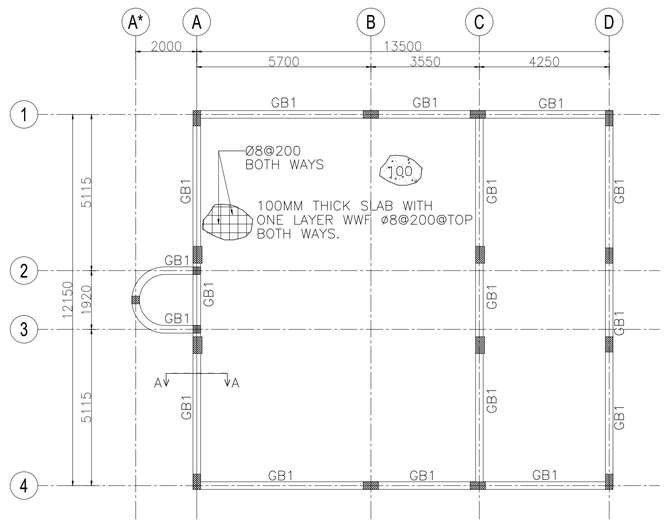

GRADE BEAM LAYOUT
SCALE 1:100

MASTER KEY PLAN

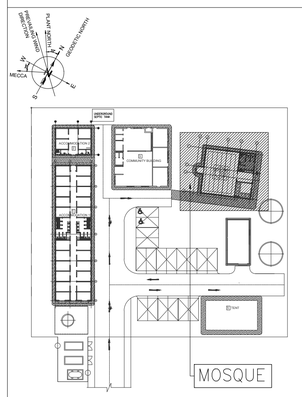

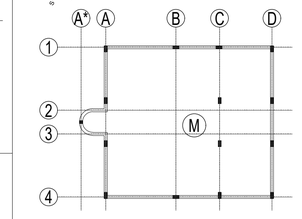


MOSQUE			
BLDG. NO.	CORNER NO.	EASTING	NORTHING
M	A1	E262102.249	N2508759.932
	D4	E262119.619	N2508754.625

SCHEDULE OF FOOTINGS


FOOTING MARK	PLAIN CONCRETE			REINFORCED CONCRETE			BOTTOM REINF.		TOP REINF.		Ha	REMARKS
	L	W	T	L	W	T	SHORT BARS	LONG BARS	SHORT BARS	LONG BARS		
F1	2400	2200	50	2200	2000	450	ø12@125	ø12@125	–	–	1200	
F2	2000	2000	50	1800	1800	400	ø12@150	ø12@150	–	–	1200	
F3	1200	1200	50	1000	1000	400	ø12@150	ø12@150	–	–	1200	

SCHEDULE OF GRADE BEAMS

BEAM MARK	DIMENSIONS		STEEL REINFORCEMENT				STIRRUPS
			BOTTOM		TOP		
	WIDTH	DEPTH	STRAIGHT	ADD.	STRAIGHT	ADD.	
GB1	250	500	3ø20	–	3ø20	–	PROVIDE ø10@150 IN THE END SPAN@DISTANCE OF L/3 FROM THE SUPPORT & ø10@200 IN THE MIDSPAN.

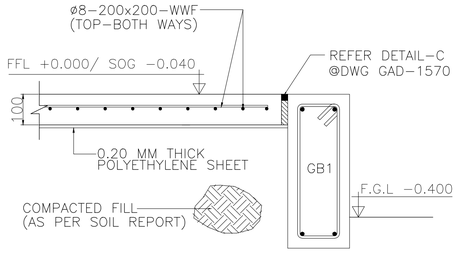

TYP SECTION FOR GRADE SLAB –A
SCALE 1:10

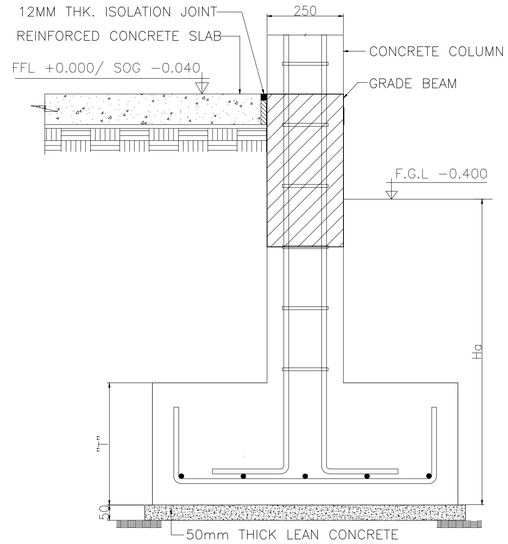


FOUNDATION SECTION
SCALE 1:10

NOTES


1.) ALL DIMENSIONS ARE GIVEN IN MILLIMETRES AND ELEVATIONS ARE IN METRES UNLESS OTHERWISE NOTED.
2.) MINIMUM REINFORCED CONCRETE GRADE TO BE USED FOR SUPERSTRUCTURE & SUBSTRUCTURES IS C35(5000 PSI).
3.) MINIMUM LEAN CONCRETE GRADE TO BE USED FOR THE SUB-STRUCTURES IS C15(2175 PSI).
4.) ALL REINFORCING STEEL SHALL BE DEFORMED BILLET STEEL BARS CONFORMING TO ASTM-A615, WITH MINIMUM YIELD STRENGTH OF FY420 MPA .
5.) THE NET SOIL BEARING CAPACITY CONSIDERED IN FOUNDATION DESIGN IS 350 KPA.(REFER DOC 216-3000-EG-CV-RPT-1008)
6.) WATER PROOFING INSULATION SHALL BE AS PER PROJECT SPECIFICATIONS & ITS MATERIAL TO BE APPROVED BY SITE ENGINEER.
7.) THE MINIMUM CONCRETE COVER AS PER SBC-304-2018(TABLE 20.6.1.3.1) MEASURED FROM REBAR SHALL BE
a) CONCRETE CAST AGAINST & PERMANENTLY EXPOSED TO EARTH (INCLUDING FOUNDATIONS OVER SUB-SLAB) FORMED CONCRETE EXPOSED TO EARTH OR WEATHER.....50MM
b.) CONCRETE NOT EXPOSED TO WEATHER NOR IN CONTACT WITH GROUND
BEAMS, COLUMNS.....40MM
SLABS, WALLS, JOISTS.....20MM
c.) CONCRETE SLAB OVER 50MM SUB-SLAB.....20MM
8.) ALL DRAWINGS MUST BE READ IN CONJUNCTION WITH RELEVANT ARCHITECTURAL AND ENGINEERING DRAWINGS RELATED TO THE SAME SHEET AND ANY ITEM ON IT.
9.) F.F.L +0.00 MENTIONED IS EQUIVALENT TO FINISH FLOOR LVL +922.70M AS PER THE CIVIL DRAWING CE-004A-OVERALL LAYOUT PLAN.

F-FOUNDATION
C-COLUMN
FFL-FINISH FLOOR LVL
FGL-FINISH GRADE LVL
TOS-TOP OF SCREED
WWF-WELDED WIRE FABRIC
HCS-HOLLOW CORE SLAB
GB-GRADE BEAM
IJ-ISOLATION JOINT
CJ-CONTROL JOINT
GA-GALVANIZED
S.O.G-SLAB ON GRADE
ARCH-ARCHITECTURAL
HOR.-HORIZONTAL
REINF.-REINFORCEMENT
LVL.-LEVEL
℄-CENTER OF COLUMN


LEGEND/ABBREVIATIONS

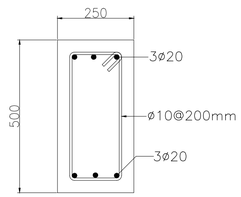


GB1 @ MIDSPAN
SCALE 1:10

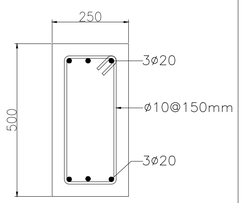


GB1 @ ENDSPAN
SCALE 1:10

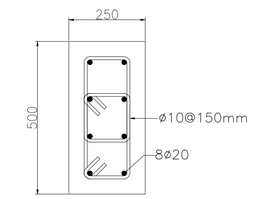


COLUMN DETAIL–C1
SCALE 1:10

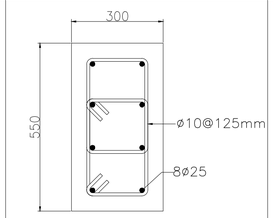

COLUMN DETAIL–C2
SCALE 1:10

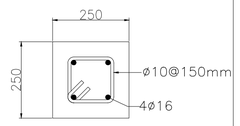

COLUMN DETAIL–C3
SCALE 1:10

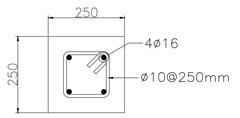

COLUMN DETAIL–CX
SCALE 1:10
CX START FROM GRADE BEAM
& STOP UNDER FIRST DROP BEAM

DRAWING NUMBER	DESCRIPTION	REV	DATE	REVISION DESCRIPTION	DRN	CHK	ENG	APP	EMP
MD-216-1800-EG-AR-GAD-3166	BUILDING ELEVATIONS & SECTIONS								
MD-216-6000-EG-CV-STD-1002	HOLLOW CORE SLAB STANDARD								
MD-216-6000-EG-CV-STD-1001	REINFORCEMENT STANDARD	D01	05/05/2023	AS BUILT	--	AVG	--	SJM	
MD-216-1800-EG-AR-GAD-3165	BUILDING PLANS	C01	19/05/2020	ISSUED FOR CONSTRUCTION	--	AVG		SJM	
MD-216-1800-EG-CV-GAD-1565	OVERALL LAYOUT PLAN	A01	19/04/2020	ISSUED FOR APPROVAL	--	AVG	--	SJM	
DOCUMENT NUMBER	REFERENCE DOCUMENTS	REV	DATE	REVISION DESCRIPTION	DRN	CHK	ENG	APP	EMP

DESIGNER:
مكتب الخليج للاستشارات الهندسية
الخبر، المملكة العربية السعودية
GULF CONSULT
ARCHITECTS AND ENGINEERS

DRAWING NUMBER						REVISION
FACILITY-MOSQUE-ST-001						0
DATE	15/03/2020	DATE	16/04/2020	DATE	17/04/2020	
DRAWN	MAH	CHECKED	MF	APPROVED	FK	

LARSEN & TOUBRO DRAWING NUMBER		REVISION
019045_900_C_G_24249_001		2
OUTOTEC DRAWING NUMBER	DOCUMENT ID	REVISION
900707__GAU01__AN02__MTL01__18028	0U100668734	2

LARSEN & TOUBRO

This drawing is the property of LARSEN & TOUBRO and must not be passed on to any person or body not authorized by us to receive it nor be copied or otherwise made use either in full or in part by such person or body without our prior permission in writing.

Outotec

The content of these documents are the sole property of Outotec Oyj. Any rights not expressly granted herein are reserved. Reproduction, transfer or distribution of part or all of the contents in any form without prior written permission of Outotec is prohibited.

MA'ADEN معادن
Saudi Arabian Mining Company شركة معادن العربية السعودية

This document and the information contained herein is Ma'aden proprietary know-how. This document or any part thereof should not be reproduced, stored in a retrieval system or transmitted by any means, electronic or otherwise, or divulged without prior written permission of Ma'aden.

DRAWN	--	--	MANSOURAH - MASSARAH GOLD PROJECT
CHECKED	AVG	18/04/2020	GENERAL ARRANGEMENT DRAWING
ENGINEER	--	--	SECURITY BASE CAMP: MOSQUE
APPROVED	SJM	19/04/2020	LAYOUT & DETAILS OF FDN, COL. & GRADE BEAM
EMPLOYER			
SCALE	1:100	A1	DRAWING NUMBER: MD-216-1800-EG-CV-GAD-1548 REV: D01