

DRAWING NUMBER MD-216-1800-EG-CV-GAD-1552 REV D01

E 262109.551
N 2508708.991

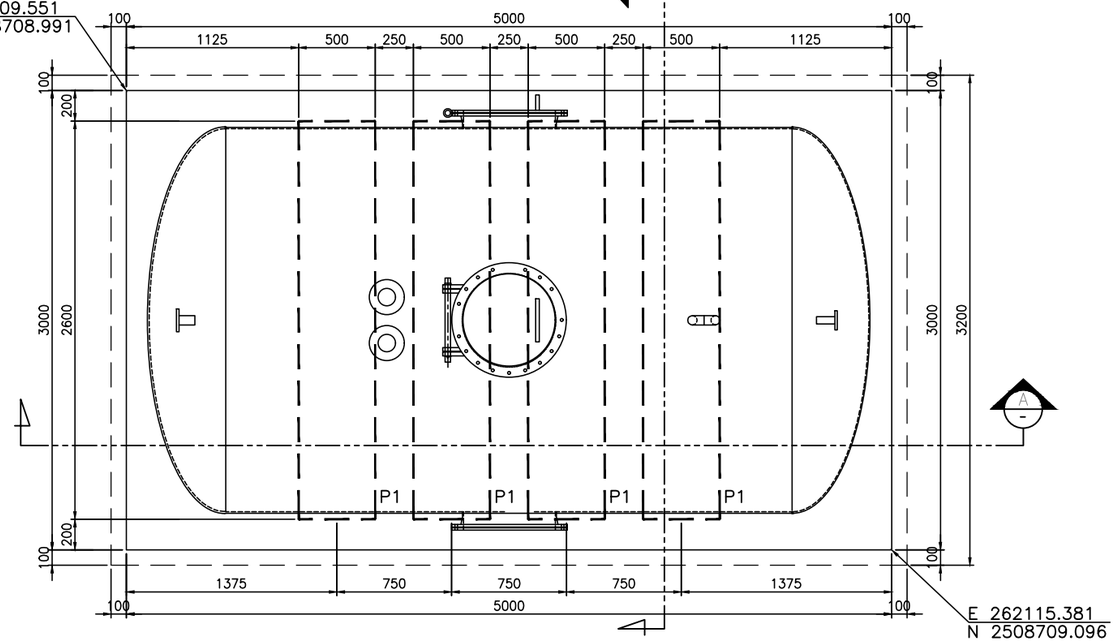


E 262115.381
N 2508709.096

FOUNDATION WITH PEDESTAL PLAN
SCALE 1:20

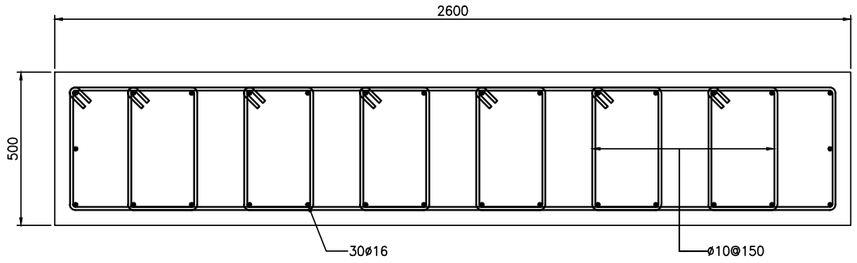



PEDESTAL DETAIL (P1)
SCALE 1:10

MASTER KEY PLAN

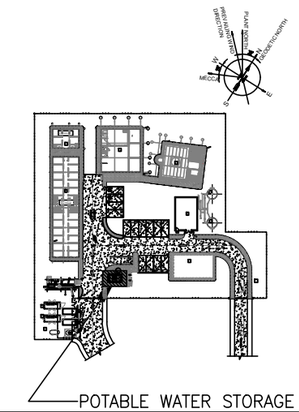


POTABLE WATER STORAGE
ENLARGED LOCATION

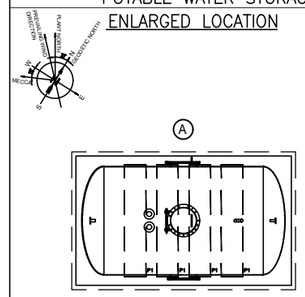

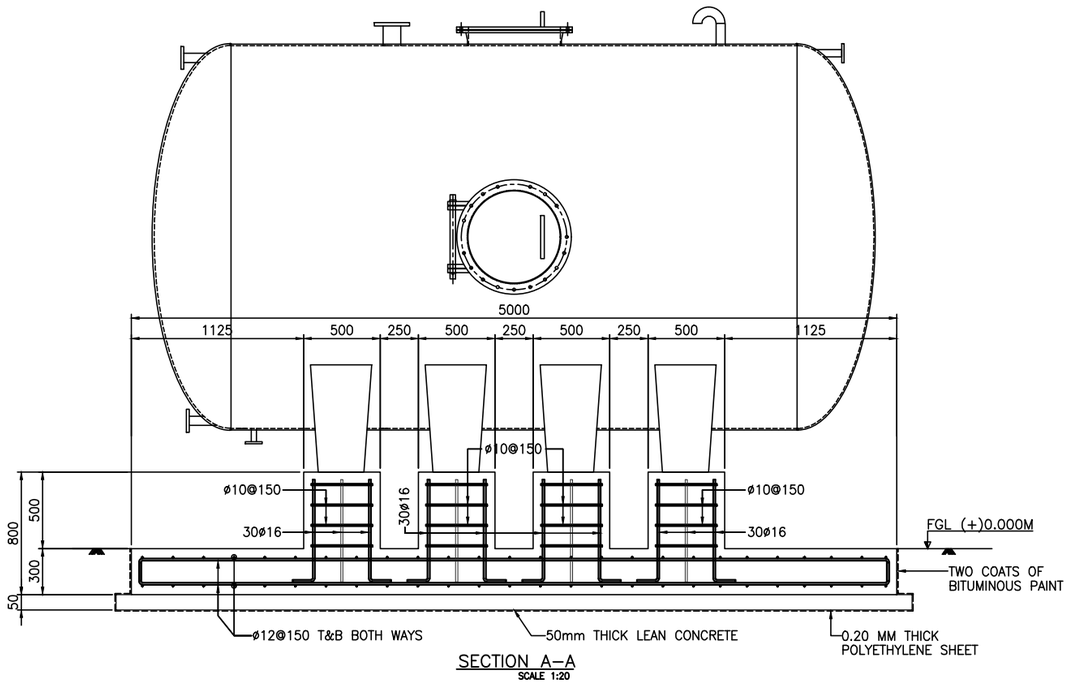

SECTION A–A
SCALE 1:20

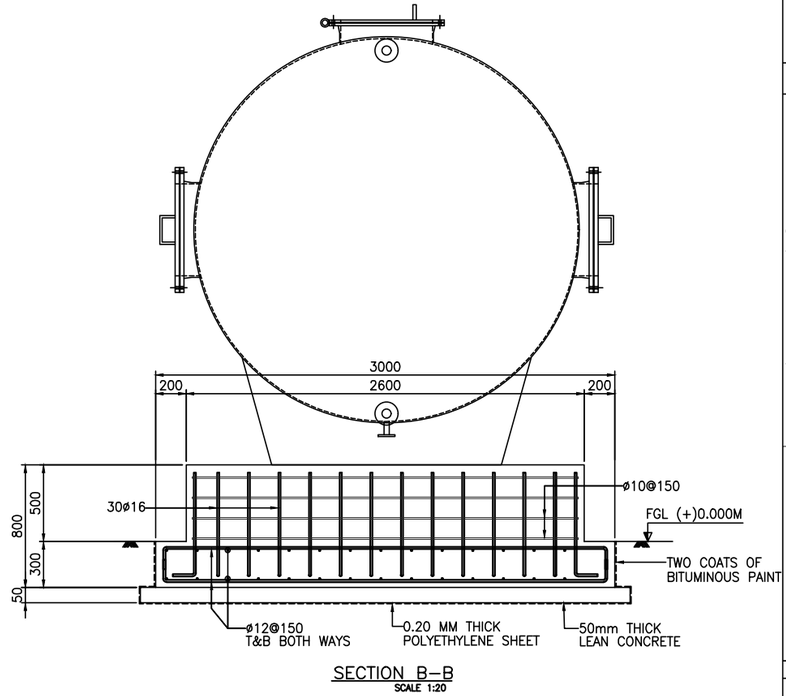

SECTION B–B
SCALE 1:20

NOTES

1.) ALL DIMENSIONS ARE GIVEN IN MILLIMETRES AND ELEVATIONS ARE IN METRES UNLESS OTHERWISE NOTED.

2.) MINIMUM REINFORCED CONCRETE GRADE TO BE USED FOR SUPERSTRUCTURE & SUBSTRUCTURES IS C35(5000 PSI).

3.) MINIMUM LEAN CONCRETE GRADE TO BE USED FOR THE SUB-STRUCTURES IS C15(2175 PSI).

4.) ALL REINFORCING STEEL SHALL BE DEFORMED BILLET STEEL BARS CONFORMING TO ASTM-A615, WITH MINIMUM YIELD STRENGTH OF FY420 MPA.

5.) THE NET SOIL BEARING CAPACITY CONSIDERED IN FOUNDATION DESIGN IS 350 KPA.(REFER DOC 216-3000-EG-CV-RPT-1008).

6.) WATER PROOFING INSULATION SHALL BE AS PER PROJECT SPECIFICATIONS & ITS MATERIAL TO BE APPROVED BY ENGINEER @SITE

7.) THE MINIMUM CONCRETE COVER AS PER SBC-304-2018(TABLE 20.6.1.3.1) MEASURED FROM REBAR SHALL BE
   a) CONCRETE CAST AGAINST & PERMANENTLY EXPOSED TO EARTH (INCLUDING FOUNDATIONS OVER SUB-SLAB) FORMED CONCRETE EXPOSED TO EARTH OR WEATHER.....50MM
   b.) CONCRETE NOT EXPOSED TO WEATHER NOR IN CONTACT WITH GROUND
      BEAMS, COLUMNS.....40MM
      SLABS, WALLS, JOISTS.....20MM
   c.) CONCRETE SLAB OVER 50MM SUB-SLAB.....20MM

8.) ALL DRAWINGS MUST BE READ IN CONJUNCTION WITH RELEVANT ARCHITECTURAL AND ENGINEERING DRAWINGS RELATED TO THE SAME SHEET AND ANY ITEM ON IT.

I-I-ISOLATION JOINT
℄-CENTER LINE
T&B-TOP & BOTTOM
C-C-CENTER TO CENTER

DOCUMENT NUMBER	REFERENCE DOCUMENTS	REV	DATE	REVISION DESCRIPTION	DRN	CHK	ENG	APP	EMP
		D01	20/02/2023	AS-BUILT	--	AVG	--	SJM	
MD-216-6000-EG-CV-STD-1002	HOLLOW CORE SLAB STANDARD	C01	07/01/2021	ISSUED FOR CONSTRUCTION	--	AVG	--	SJM	
MD-216-6000-EG-CV-STD-1001	REINFORCEMENT STANDARD	A02	10/12/2020	REVISED AS PER EMPLOYER COMMENT DATED 04/12/2020	--	AVG	--	SJM	
MD-216-1800-EG-CV-GAD-1565	OVERALL LAYOUT PLAN	A01	04/11/2020	ISSUED FOR APPROVAL	--	AVG	--	SJM	

DESIGNER: GULF CONSULT ARCHITECTS AND ENGINEERS

DRAWING NUMBER					REVISION
PT-WST-ST-001					0
DATE	01/11/2020	DATE	01/11/2020	DATE	02/11/2020
DRAWN	MAH	CHECKED	MF	APPROVED	FK

LARSEN & TOUBRO DRAWING NUMBER		REVISION
019045_900_C_G_24253_001		3
OUTOTEC DRAWING NUMBER	DOCUMENT ID	REVISION
900707__GAU01__AN02__MTL01__18040	OU100676798	3

This drawing is the property of LARSEN & TOUBRO and must not be passed on to any person or body not authorized by us to receive it nor be copied or otherwise made use either in full or in part by such person or body without our prior permission in writing.

The content of these documents are the sole property of Outotec Oyj. Any rights not expressly granted herein are reserved. Reproduction, transfer or distribution of part or all of the contents in any form without prior written permission of Outotec is prohibited.

This document and the information contained herein is Ma'aden proprietary know-how. This document or any part thereof should not be reproduced, stored in a retrieval system or transmitted by any means, electronic or otherwise, or divulged without prior written permission of Ma'aden.

DRAWN	--	--	MANSOURAH - MASSARAH GOLD PROJECT
CHECKED	AVG	06/01/2021	GENERAL ARRANGEMENT
ENGINEER	--	--	SECURITY BASE CAMP: POTABLE WATER STORAGE
APPROVED	SJM	07/01/2021	LAYOUT AND DETAIL OF TANK FOUNDATION
EMPLOYER			
SCALE	1:20	A1	DRAWING NUMBER: MD-216-1800-EG-CV-GAD-1552 REV: D01