


DRAWING NUMBER MD-216-1800-EG-CV-GAD-1554 | REV D01

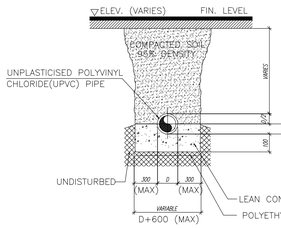


(ALONG ROADWAY)
SANITARY SEWER PIPE SECTION
SCALE: N.T.S.

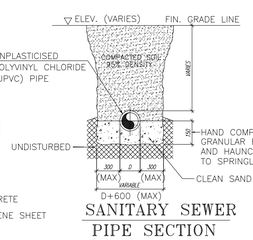


SANITARY SEWER PIPE SECTION
SCALE: N.T.S.

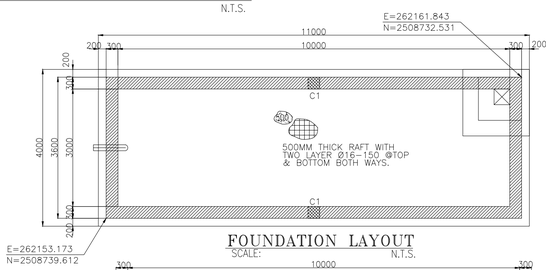


FOUNDATION LAYOUT
SCALE: N.T.S.

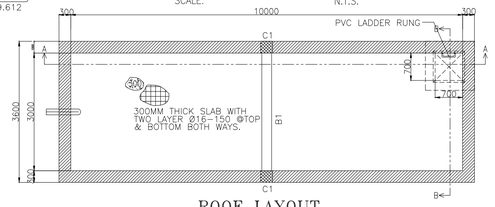


ROOF LAYOUT
SCALE: N.T.S.

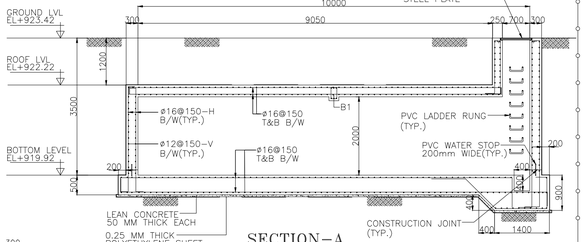

SECTION-A
SCALE: N.T.S.

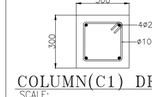


COLUMN(C1) DETAIL
SCALE: N.T.S.

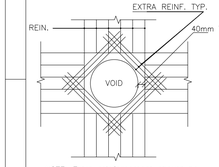


NOTE: Extra reinforcement should be same size as main reinforcement


TYP. INTERMEDIATE SLAB WALL OPENING REINF. DETAILS
SCALE: N.T.S.

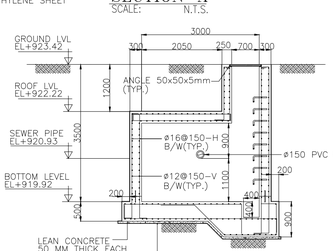


SECTION-B
SCALE: N.T.S.

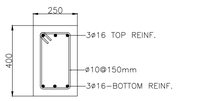


B1 @ MIDSPAN & ENDSPAN
SCALE: N.T.S.

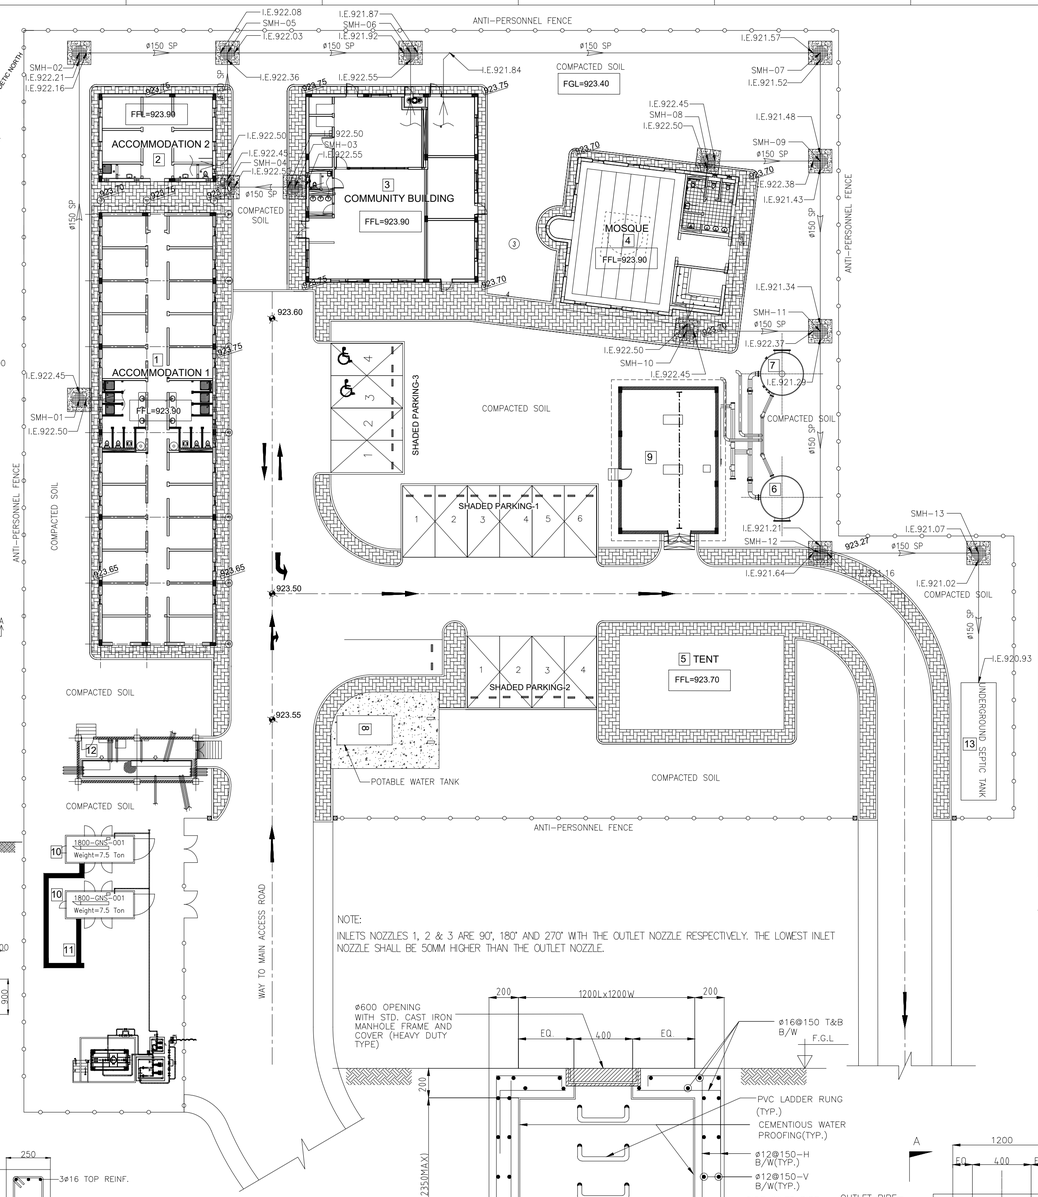


NOTE:
INLETS NOZZLES 1, 2 & 3 ARE 90°, 180° AND 270° WITH THE OUTLET NOZZLE RESPECTIVELY. THE LOWEST INLET NOZZLE SHALL BE 50MM HIGHER THAN THE OUTLET NOZZLE.

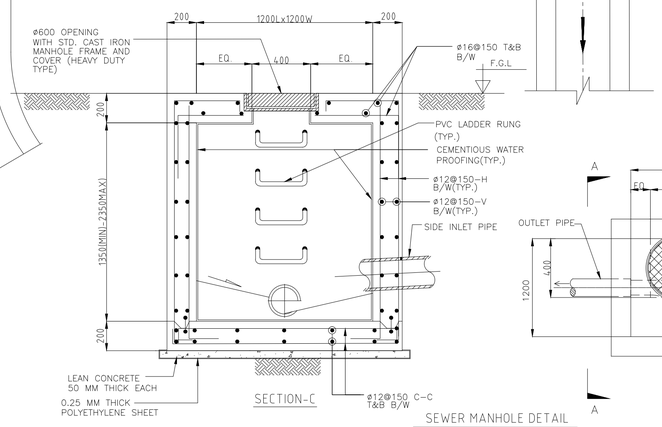

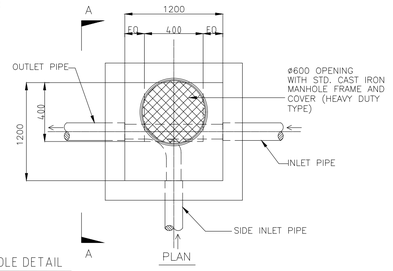

SEWER MANHOLE DETAIL
SCALE: N.T.S

OVERALL LAYOUT
FACILITY SECURITY FORCES BASE CAMP
SCALE 1:200

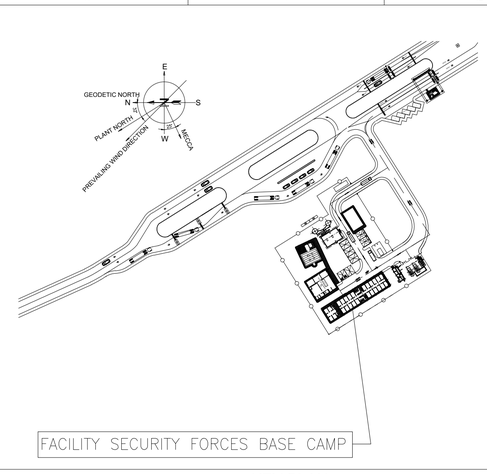

KEY PLAN

SEWER MANHOLE SCHEDULE

MANHOLE NO.	GROUND LEVEL	PIPE LENGHT (M)	PIPE DIAMETER (MM)	SLOPE (%)	INVERT LEVEL				MANHOLE DEPTH (M)	MANHOLE SIZE
					INLET 1	INLET 2	INLET 3	OUTLET		
SMH-01	923.70	29.5	150.0	1.0	–	–	922.50	922.45	1.35	1200x1200
SMH-02	923.75	12.6	150.0	1.0	–	–	922.21	922.16	1.69	1200x1200
SMH-03	923.75	5.81	150.0	1.0	–	922.55	–	922.50	1.35	1200x1200
SMH-04	923.70	11.42	150.0	1.0	–	–	922.50	922.45	1.35	1200x1200
SMH-05	923.75	15.58	150.0	1.0	–	922.08	922.36	922.03	1.82	1200x1200
SMH-06	923.75	34.85	150.0	1.0	–	921.92	922.55	921.87	1.98	1200x1200
SMH-07	923.70	9.2	150.0	1.0	–	–	921.57	921.52	2.28	1200x1200
SMH-08	923.70	9.56	150.0	1.0	–	–	922.50	922.45	1.35	1200x1200
SMH-09	923.70	14.47	150.0	1.0	–	921.48	922.38	921.43	2.37	1200x1200
SMH-10	923.70	11.34	150.0	1.0	922.50	–	–	922.45	1.35	1200x1200
SMH-11	923.70	18.87	150.0	1.0	–	921.34	922.37	921.29	2.51	1200x1200
SMH-12	923.27	13.46	150.0	1.0	921.21	–	–	921.16	2.21	1200x1200
SMH-13	923.27	11.45	150.0	1.0	–	–	921.07	921.02	2.35	1200x1200

NOTE:
INLETS NOZZLES 1, 2 & 3 ARE 90°, 180° AND 270° WITH THE OUTLET NOZZLE RESPECTIVELY. THE LOWEST INLET NOZZLE SHALL BE 50MM HIGHER THAN THE OUTLET NOZZLE.

NOTES:

1. ALL DIMENSIONS ARE IN MILLIMETRES UNLESS OTHERWISE NOTED.
2. ALL CO-ORDINATES ARE IN METRES.
3. INLETS NOZZLES 1, 2 & 3 ARE 90°, 180° AND 270° WITH THE OUTLET NOZZLE RESPECTIVELY.
4. THE LOWEST INLET NOZZLE SHALL BE 50MM HIGHER THAN THE OUTLET NOZZLE.

LEGEND:

SEWER MANHOLE
GROUND CLEANOUT
DISABLED PARKING
SEWER PIPELINE

GCO	GROUND CLEANOUT
SMH	SEWER MANHOLE
SP	SEWER PIPE
I.E.	INVERT ELEVATION
ELEV.	ELEVATION
FIN.	FINISHED
FGL.	FINISHED GROUND LEVEL
LEV.	LEVEL
T&B.	TOP AND BOTTOM
REINF.	REINFORCED
TYP.	TYPICAL
ø	DIAMETER

REV	DATE	DESCRIPTION	DRN	CHK	ENG	APP	EMP
D01	20/02/2023	AS-BUILT	--	AVG	--	SJM	
C02	14/01/2021	ISSUED FOR CONSTRUCTION & REVISED AS MARKED	- -	AVG	- -	SJM	
C01	30/11/2020	ISSUED FOR CONSTRUCTION	- -	AVG	- -	SJM	
A01	29/10/2020	ISSUED FOR REFERENCE	- -	AVG	- -	SJM	

DOCUMENT NUMBER	REFERENCE DOCUMENTS
MD-216-4200-EG-GE-DLO-0007	FACILITY SECURITY FORCE BASE CAMP SITE PLAN

DESIGNER: مكتب الخليج للاستشارات الهندسية GULF CONSULT ARCHITECTS AND ENGINEERS

DRAWING NUMBER					REVISION
ME-FSBC-SS-PL-001					0
DATE	13/10/2020	DATE	14/10/2020	DATE	15/10/2020
DRAWN	RAFI	CHECKED	SHAU	APPROVED	NILO

LARSEN & TOUBRO DRAWING NUMBER		REVISION
019045_900_C_G_24255_001		3
OUTOTEC DRAWING NUMBER	DOCUMENT ID	REVISION
900707__GAU01__AN02__MTL01__18041	OU100676799	3

LARSEN & TOUBRO

This drawing is the property of LARSEN & TOUBRO and must not be passed on to any person or body not authorized by us to receive it nor be copied or otherwise made use either in full or in part by such person or body without our prior permission in writing.

Outotec

The content of these documents are the sole property of Outotec Oyj. Any rights not expressly granted herein are reserved. Reproduction, transfer or distribution of part or all of the contents in any form without prior written permission of Outotec is prohibited.

MA'ADEN معادن
Saudi Arabian Mining Company شركة المعادن العربية السعودية

This document and the information contained herein is Ma'aden proprietary know-how. This document or any part thereof should not be reproduced, stored in a retrieval system or transmitted by any means, electronic or otherwise, or divulged without prior written permission of Ma'aden.

DRAWN			
CHECKED	AVG	28/10/2020	
ENGINEER			
APPROVED	SJM	29/10/2020	
EMPLOYER			
SCALE	1:200	A1	

MANSOURAH - MASSARAH GOLD PROJECT
GENERAL ARRANGEMENT DRAWING
FACILITY SECURITY FORCES BASE CAMP
SEWERAGE NETWORK & UNDERGROUND SEPTIC TANK

DRAWING NUMBER	REV
MD-216-1800-EG-CV-GAD-1554	D01