


DRAWING NUMBER MD-216-1800-EG-CV-GAD-1555 REV D01

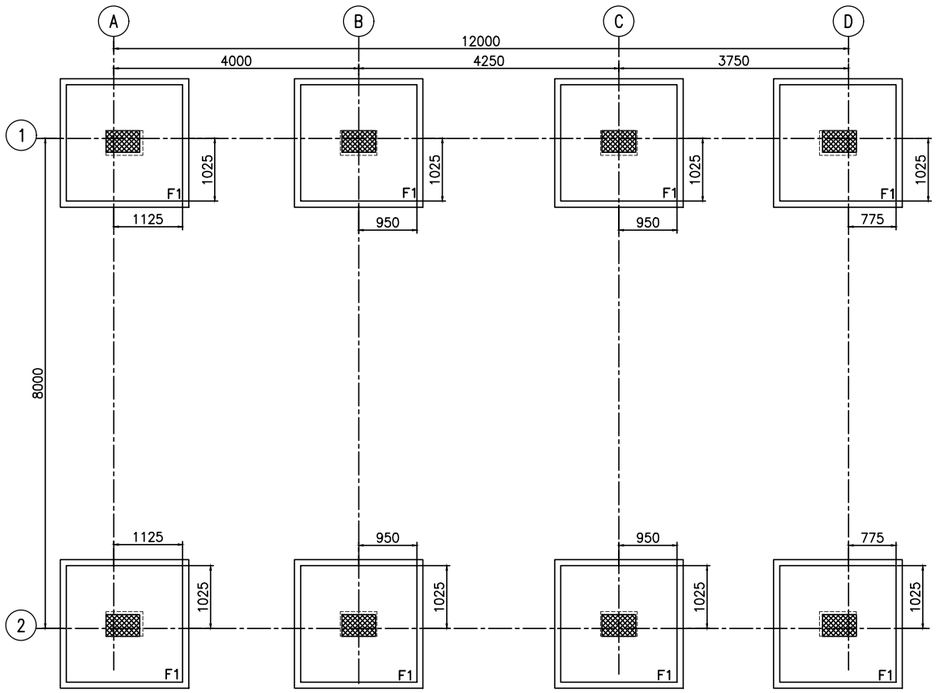


FOUNDATION LAYOUT
SCALE 1:50

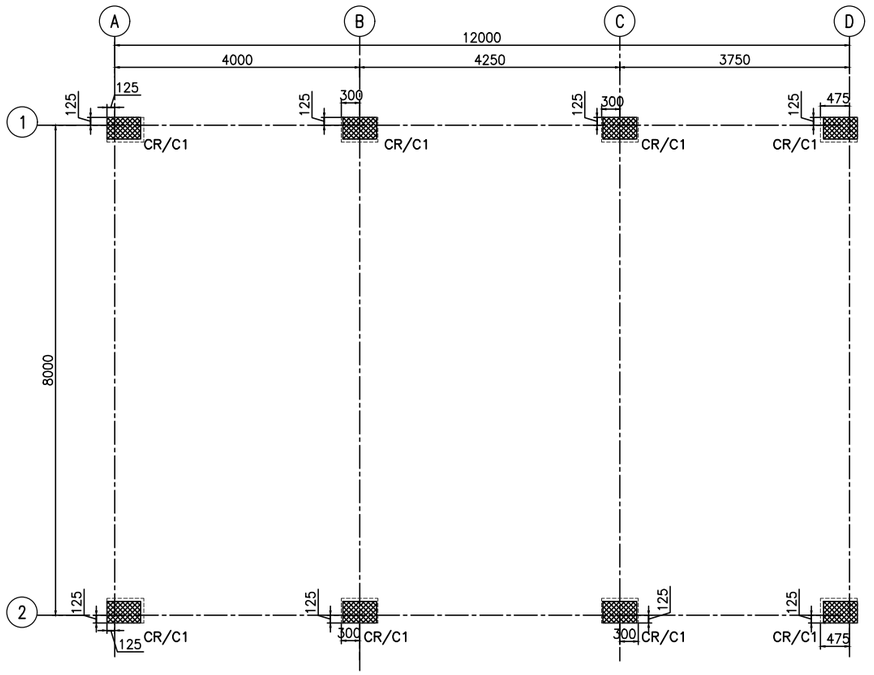


CONCRETE COLUMN LAYOUT
SCALE 1:50

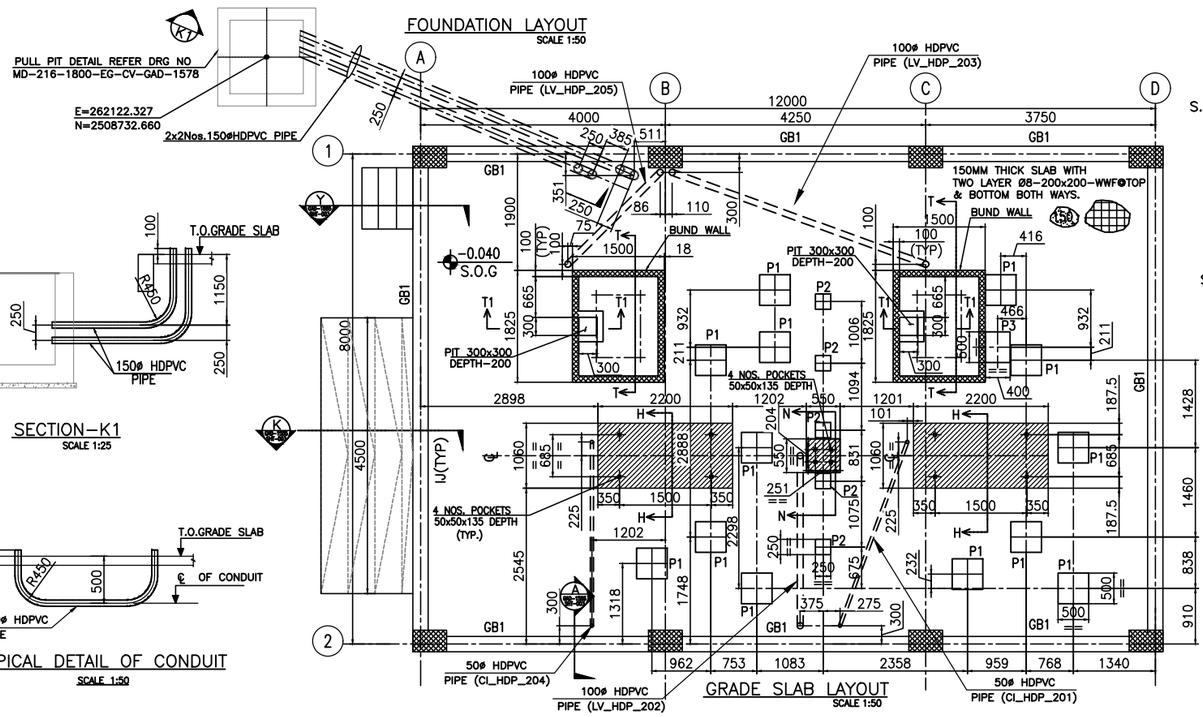


GRADE SLAB LAYOUT
SCALE 1:50

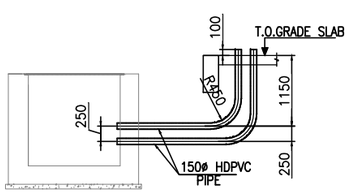


SECTION–K1
SCALE 1:25

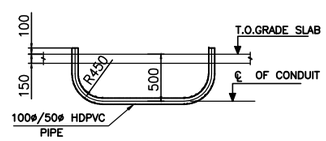


TYPICAL DETAIL OF CONDUIT
SCALE 1:50

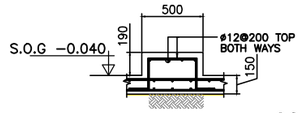


TYP. DETAIL OF P1
SCALE 1:25

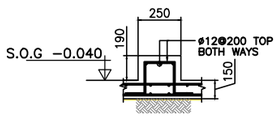


TYP. DETAIL OF P2
SCALE 1:25

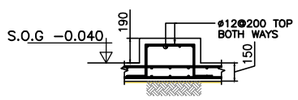


TYP. DETAIL OF P3
SCALE 1:25

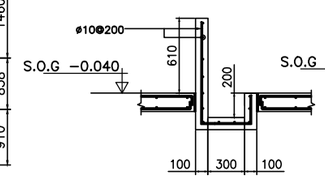


SECTION–T1
SCALE 1:25

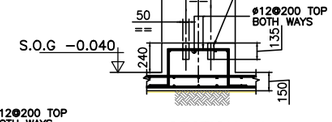

SECTION–N
SCALE 1:25

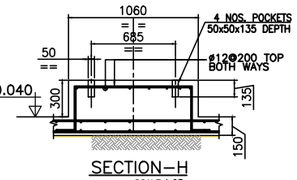


SECTION–H
SCALE 1:25

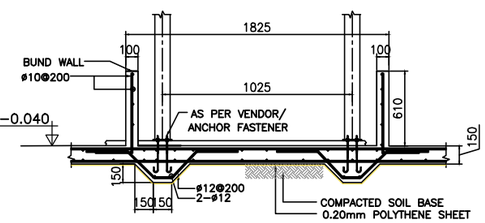


SECTION–T
SCALE 1:25

MASTER KEY PLAN

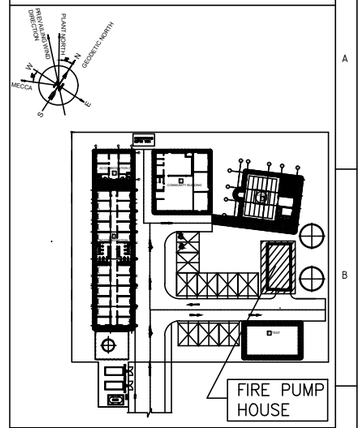

FIRE PUMP HOUSE ENLARGED KEYPLAN

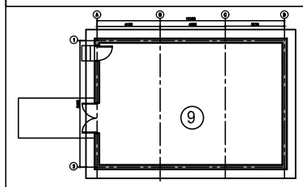

FIRE PUMP HOUSE			
BLDG NO.	CORNER NO.	EASTING	NORTHING
9	A1	E 262122.062	N 2508735.588
	D2	E 262122.545	N 2508749.628

NOTES

1.) ALL DIMENSIONS ARE GIVEN IN MILLIMETRES AND ELEVATIONS ARE IN METRES UNLESS OTHERWISE NOTED.
2.) MINIMUM REINFORCED CONCRETE GRADE TO BE USED FOR SUPERSTRUCTURE & SUBSTRUCTURES IS M35(5000 PSI).
3.) MINIMUM LEAN CONCRETE GRADE TO BE USED FOR THE SUB-STRUCTURES IS M15(2175 PSI).
4.) ALL REINFORCING STEEL SHALL BE DEFORMED BILLET STEEL BARS CONFORMING TO ASTM-A615, WITH MINIMUM YIELD STRENGTH OF FY420 MPA.
5.) THE NET SOIL BEARING CAPACITY CONSIDERED IN FOUNDATION DESIGN IS 350 KPA(REFER DOC 216-3000-EG-CV-CAL-1008).
6.) WATER PROOFING INSULATION SHALL BE AS PER PROJECT SPECS AND ITS MATERIAL TO BE APPROVED BY ENGINEER ON SITE.
7.) THE MINIMUM CONCRETE COVER AS PER SBC-304-2018(TABLE 20.6.1.3.1) MEASURED FROM REBAR SHALL BE
   a) CONCRETE CAST AGAINST & PERMANENTLY EXPOSED TO EARTH (INCLUDING FOUNDATIONS OVER SUB-SLAB) FORMED CONCRETE EXPOSED TO EARTH OR WEATHER.....50MM
   b.) CONCRETE NOT EXPOSED TO WEATHER NOR IN CONTACT WITH GROUND
   BEAMS, COLUMNS.....40MM
   SLABS, WALLS, JOISTS.....20MM
   c.) CONCRETE SLAB OVER 50MM SUB-SLAB.....20MM
8.) ALL DRAWINGS MUST BE READ IN CONJUNCTION WITH RELEVANT ARCHITECTURAL AND ENGINEERING DRAWINGS RELATED TO THE SAME SHEET AND ANY ITEM ON IT.
9.) F.F.L +0.00 MENTIONED IS EQUIVALENT TO RL 923.70 AS PER THE CIVIL DRAWING CE-004A-OVERALL LAYOUT PLAN.

LEGENDS
F-FOUNDATION
C-COLUMN
FFL-FINISH FLOOR LVL
FGL-FINISH GRADE LVL
TOS-TOP OF SCREED
WWF-WELDED WIRE FABRIC
HCS-HOLLOW CORE SLAB
GB-GRADE BEAM
IJ-ISOLATION JOINT
CJ-CONTROL JOINT
GA-GALVANIZED
S.O.G-SLAB ON GRADE
ARCH-ARCHITECTURAL
HOR.-HORIZONTAL
REINF.-REINFORCEMENT
LVL.-LEVEL
RL-REDUCED LEVEL
℄-CENTRE LINE
CR-COLUMN NECK
EQUIPMENT PAD
BUND WALL
CR-COLUMN NECK

SHEET 1 OF 3

DOCUMENT NUMBER	REFERENCE DOCUMENTS	REV	DATE	REVISION DESCRIPTION	DRN	CHK	ENG	APP	EMP
MD-216-39LA-EG-FG-GAD-V513-2004	VILLAGE-FIRE PUMP HOUSE MISCELLANEOUS DETAIL								
MD-216-39LA-EG-FG-LAD-V513-2029	SECURITY FORCE BASE CAMP - FIRE PUMP HOUSE								
MD-216-1800-EG-EL-LAD-1015	CABLE ROUTE LAYOUT FIREWATER PUMP HOUSE								
MD-216-6000-EG-CV-STD-1002	HOLLOW CORE SLAB STANDARD	D01	27/02/2023	AS-BUILT	--	AVG	--	SJM	
MD-216-6000-EG-CV-STD-1001	REINFORCEMENT STANDARD	C02	22/06/2021	ISSUED FOR CONSTRUCTION AND REVISED AS MARKED △02	--	AVG	--	SJM	
MD-216-39LA-EG-FG-GAD-V513	BUILDING PLANS	C01	27/11/2020	ISSUED FOR CONSTRUCTION	--	AVG	--	SJM	
MD-216-6000-EG-CV-GAD-1535	OVERALL LAYOUT PLAN	A01	22/10/2020	ISSUED FOR APPROVAL	--	AVG	--	SJM	








MA'ADEN معادن Saudi Arabian Mining Company
This document and the information contained herein is Ma'aden proprietary know-how. This document or any part thereof should not be reproduced, stored in a retrieval system or transmitted by any means, electronic or otherwise, or divulged without prior written permission of Ma'aden.

DRAWN	--	--	MANSOURAH - MASSARAH GOLD PROJECT
CHECKED	AVG	21/10/2020	GENERAL ARRANGEMENT
ENGINEER	--	--	SECURITY BASE CAMP:FIRE FIGHTING PUMP HOUSE
APPROVED	SJM	22/10/2020	LAYOUT OF FDN, COL & GRADE BEAM
EMPLOYER			
SCALE	1:50	A1	DRAWING NUMBER: MD-216-1800-EG-CV-GAD-1555 REV: D01


DRAWING NUMBER MD-216-1800-EG-CV-GAD-1555 REV D01

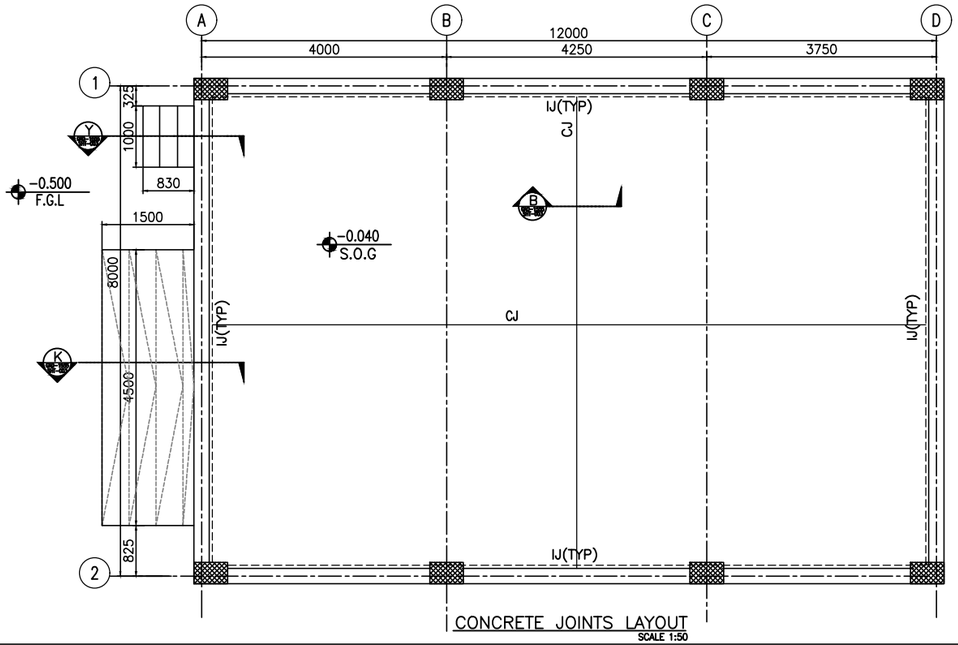


CONCRETE JOINTS LAYOUT
SCALE 1:50

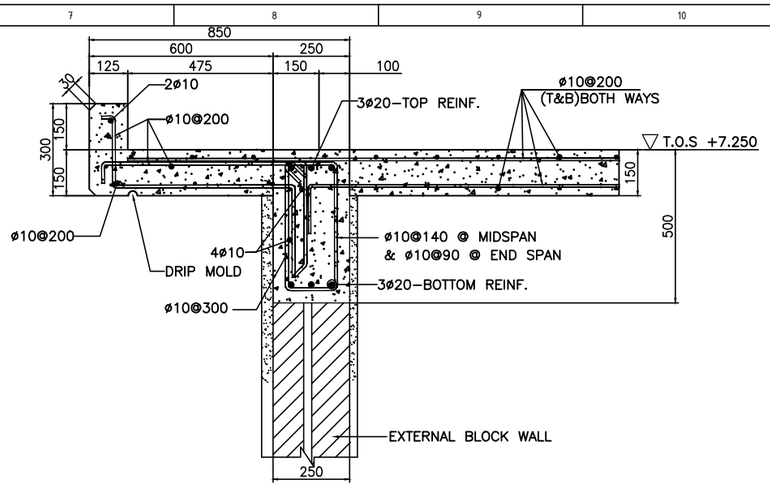


SECTION-X (LB1)
SCALE 1:10

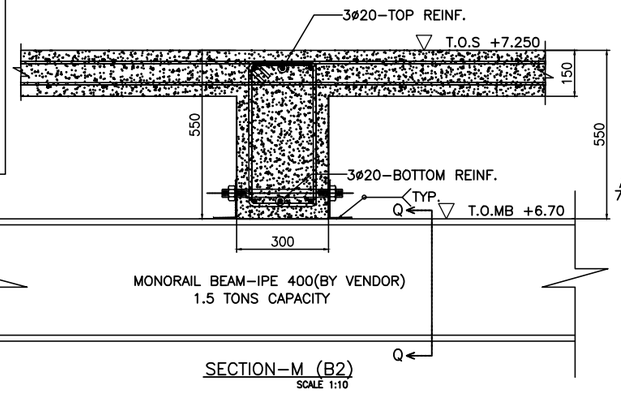


SECTION-M (B2)
SCALE 1:10

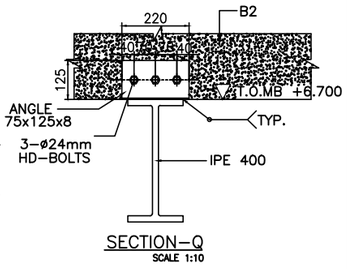

SECTION-Q
SCALE 1:10

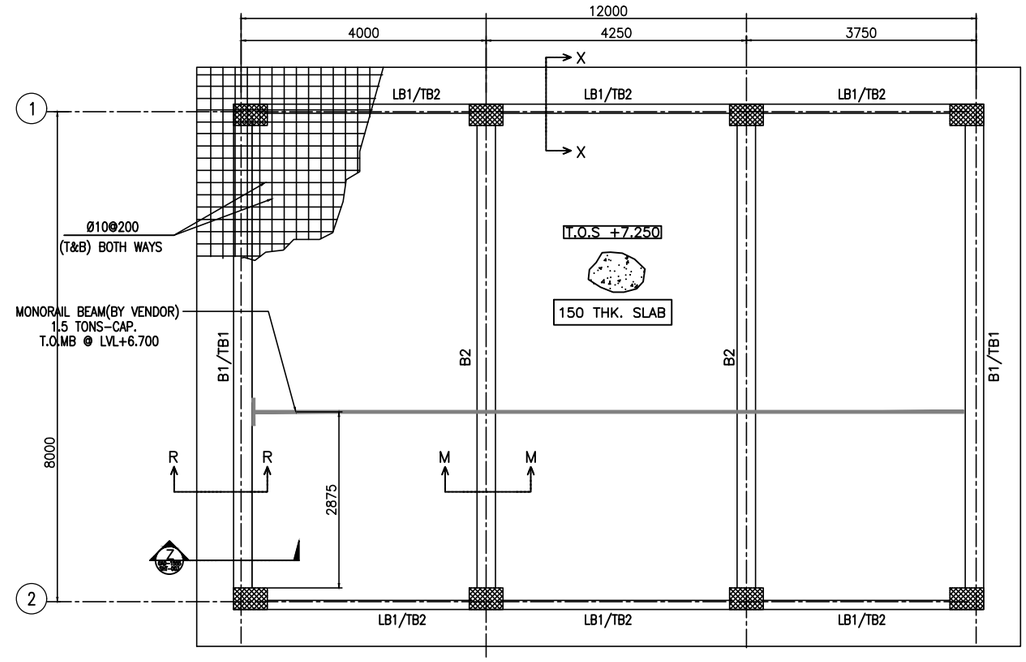

ROOF SLAB LAYOUT
SCALE 1:50

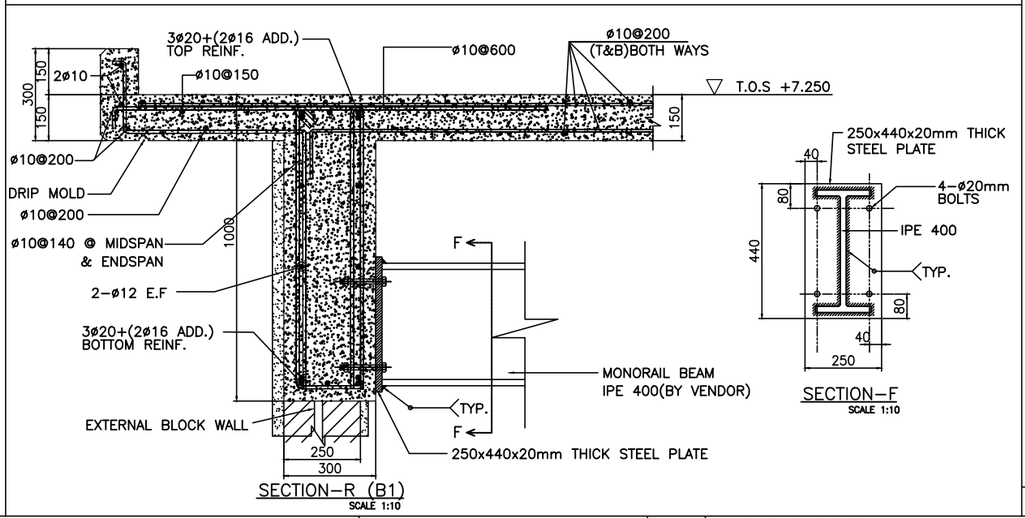

SECTION-R (B1)
SCALE 1:10

SECTION-F
SCALE 1:10

NOTES

1.) ALL DIMENSIONS ARE GIVEN IN MILLIMETRES AND ELEVATIONS ARE IN METRES UNLESS OTHERWISE NOTED.
2.) MINIMUM REINFORCED CONCRETE GRADE TO BE USED FOR SUPERSTRUCTURE & SUBSTRUCTURES IS M35(5000 PSI).
3.) MINIMUM LEAN CONCRETE GRADE TO BE USED FOR THE SUB-STRUCTURES IS M15(2175 PSI).
4.) ALL REINFORCING STEEL SHALL BE DEFORMED BILLET STEEL BARS CONFORMING TO ASTM-A615, WITH MINIMUM YIELD STRENGTH OF FY420 MPA .
5.) THE NET SOIL BEARING CAPACITY CONSIDERED IN FOUNDATION DESIGN IS 350 KPA(REFER DOC 216-3000-EG-CV-CAL-1008).
6.) WATER PROOFING INSULATION SHALL BE AS PER PROJECT SPECS AND ITS MATERIAL TO BE APPROVED BY ENGINEER ON SITE.
7.) THE MINIMUM CONCRETE COVER AS PER SBC-304-2018(TABLE 20.6.1.3.1) MEASURED FROM REBAR SHALL BE
   a) CONCRETE CAST AGAINST & PERMANENTLY EXPOSED TO EARTH (INCLUDING FOUNDATIONS OVER SUB-SLAB) FORMED CONCRETE EXPOSED TO EARTH OR WEATHER.....50MM
   b.) CONCRETE NOT EXPOSED TO WEATHER NOR IN CONTACT WITH GROUND
   BEAMS, COLUMNS.....40MM
   SLABS, WALLS, JOISTS.....20MM
   c.) CONCRETE SLAB OVER 50MM SUB-SLAB.....20MM
8.) ALL DRAWINGS MUST BE READ IN CONJUNCTION WITH RELEVANT ARCHITECTURAL AND ENGINEERING DRAWINGS RELATED TO THE SAME SHEET AND ANY ITEM ON IT.
9.) F.F.L +0.00 MENTIONED IS EQUIVALENT TO RL RL 923.70 AS PER THE CIVIL DRAWING CE-004A-OVERALL LAYOUT PLAN.

LEGENDS
F-FOUNDATION
C-COLUMN
FFL-FINISH FLOOR LVL
FGL-FINISH GRADE LVL
TOS-TOP OF SCREED
WWF-WELDED WIRE FABRIC
HCS-HOLLOW CORE SLAB
GB-GRADE BEAM
IJ-ISOLATION JOINT
CJ-CONTROL JOINT
SCJ-SLAB CONSTRUCTION JOINT
GA-GALVANIZED
S.O.G-SLAB ON GRADE
ARCH-ARCHITECTURAL
HOR.-HORIZONTAL
REINF.-REINFORCEMENT
LVL.-LEVEL
TOS-TOP OF SCREED
RL-REDUCED LEVEL
TB-TIE BEAM/BOND BEAM
B/LB1-ROOF BEAMS
TOMB-TOP OF MONORAIL BEAM
CAP.-CAPACITY
E.F-EACH FACE
(T&B)-TOP & BOTTOM

SHEET 2 OF 3

DOCUMENT NUMBER	REFERENCE DOCUMENTS	REV	DATE	REVISION DESCRIPTION	DRN	CHK	ENG	APP	EMP
MD-216-6000-EG-CV-STD-1002	HOLLOW CORE SLAB STANDARD	D01	27/02/2023	AS-BUILT	--	AVG	--	SJM	
MD-216-6000-EG-CV-STD-1001	REINFORCEMENT STANDARD	C02	22/06/2021	ISSUED FOR CONSTRUCTION AND REVISED AS MARKED (02)	--	AVG	--	SJM	
MD-216-39LA-EG-FG-GAD-V513	BUILDING PLANS	C01	27/11/2020	ISSUED FOR CONSTRUCTION	--	AVG	--	SJM	
MD-216-6000-EG-CV-GAD-1535	OVERALL LAYOUT PLAN	A01	22/10/2020	ISSUED FOR APPROVAL	--	AVG	--	SJM	

DESIGNER: GULF CONSULT ARCHITECTS AND ENGINEERS

DRAWING NUMBER	REVISION
SC-PH-ST-002	A01

DATE	15/10/2020	DATE	16/10/2020	DATE	17/10/2020
DRAWN	MAH	CHECKED	MF	APPROVED	FK

LARSEN & TOUBRO DRAWING NUMBER: 019045_900_C_G_24256_001 — REVISION 3
OUTOTEC DRAWING NUMBER: 900707__GAU01__AN02__MTL01__18167 — DOCUMENT ID: OU100696616 — REVISION 3


LARSEN & TOUBRO
This drawing is the property of LARSEN & TOUBRO and must not be passed on to any person or body not authorized by us to receive it nor be copied or otherwise made use either in full or in part by such person or body without our prior permission in writing.

Outotec
The content of these documents are the sole property of Outotec Oyj. Any rights not expressly granted herein are reserved. Reproduction, transfer or distribution of part or all of the contents in any form without prior written permission of Outotec is prohibited.


MA'ADEN معادن
Saudi Arabian Mining Company
This document and the information contained herein is Ma'aden proprietary know-how. This document or any part thereof should not be reproduced, stored in a retrieval system or transmitted by any means, electronic or otherwise, or divulged without prior written permission of Ma'aden.

DRAWN	--	--	MANSOURAH - MASSARAH GOLD PROJECT
CHECKED	AVG	21/10/2020	GENERAL ARRANGEMENT
ENGINEER	--	--	SECURITY BASE CAMP:FIRE FIGHTING PUMP HOUSE
APPROVED	SJM	22/10/2020	LAYOUT & DETAILS OF ROOF & GRADE SLAB
EMPLOYER			
SCALE 1:50		A1	DRAWING NUMBER: MD-216-1800-EG-CV-GAD-1555 — REV: D01

DRAWING NUMBER MD-216-1800-EG-CV-GAD-1555 REV D01

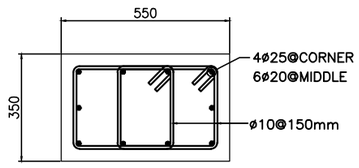


COLUMN DETAIL C1 SCALE 1:10 GAD-1555 SHT-01

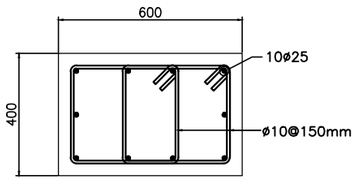


COLUMN DETAIL CR SCALE 1:10 GAD-1555 SHT-01


NOTE: CONTROL JOINTS SHALL BE PROVIDED AT MAXIMUM SPACING OF 20 FT (6.10 M) AS PER ACI CODE

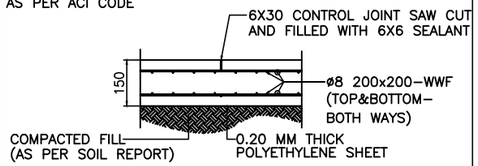


SECTION-B CJ SCALE NTS GAD-1555 SHT-02

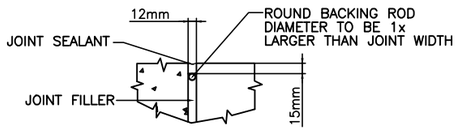

TYP JOINT SEAL DETAIL C SCALE NTS GAD-1555 SHT-02

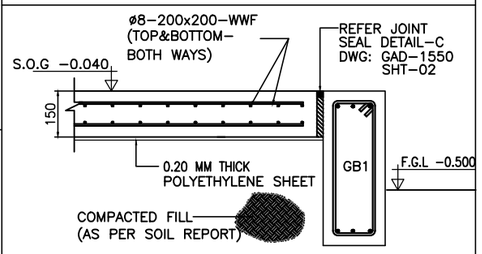

TYP SECTION FOR GRADE SLAB A SCALE 1:10 GAD-1555 SHT-01

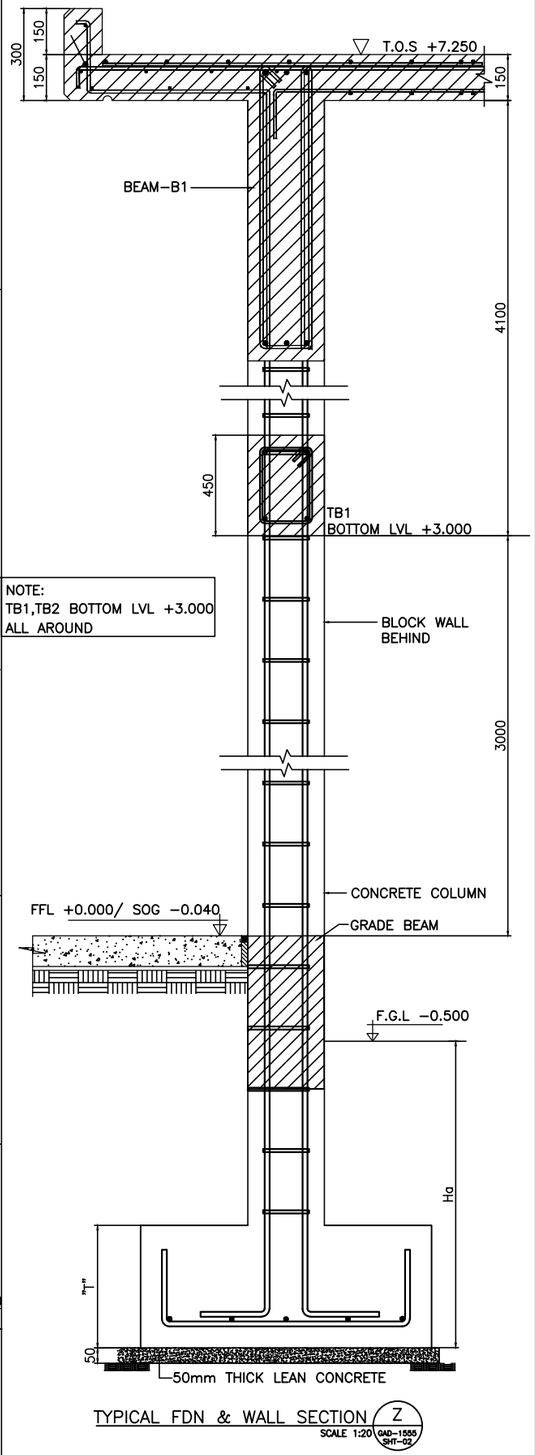

NOTE:
TB1,TB2 BOTTOM LVL +3.000 ALL AROUND

TYPICAL FDN & WALL SECTION Z SCALE 1:20 GAD-1555 SHT-02

SCHEDULE OF FOOTINGS


FOOTING MARK	PLAIN CONCRETE			REINFORCED CONCRETE			BOTTOM REINFORCEMENT		TOP REINFORCEMENT		Ha	REMARKS
	L	W	T	L	W	T	SHORT BARS	LONG BARS	SHORT BARS	LONG BARS		
F1	2100	2100	50	1900	1900	450	ø12@125	ø12@125	–	–	1500	

SCHEDULE OF GRADE BEAMS


BEAM MARK	DIMENSIONS		STEEL REINFORCEMENT				STIRRUPS
			BOTTOM		TOP		
	WIDTH	DEPTH	STRAIGHT	ADD.	STRAIGHT	ADD.	
GB1	250	600	3ø16	–	3ø16	–	PROVIDE AT THE ⊕DISTANCE OF L/3 FROM THE SUPPORT IN ø10@140 IN THE END SPAN & MID SPAN

SCHEDULE OF ROOF BEAMS


BEAM MARK	DIMENSIONS		STEEL REINFORCEMENT					STIRRUPS	REMARKS
			TOP		BOTTOM		SIDE BAR		
	WIDTH	DEPTH	STRAIGHT	ADD.	STRAIGHT	ADD.	EACH FACE		
LB1	250	500	3ø20	–	3ø20	–	–	PROVIDE ø10⊕90 AT THE ⊕DISTANCE OF L/3 FROM THE SUPPORT IN END SPAN & ø10@140 IN THE MID SPAN	REFER DETAIL-X
B1	300	1000	3ø20	2ø16	3ø20	2ø16	2ø12	PROVIDE ø10@140 AT MID SPAN & END SPAN	REFER DETAIL-R
B2	300	550	3ø20	–	3ø20	–	–	PROVIDE ø10⊕90 AT THE ⊕DISTANCE OF L/3 FROM THE SUPPORT IN END SPAN & ø10@140 IN THE MID SPAN	REFER DETAIL-M
TB1	250	450	3ø12	–	3ø12	–	–	PROVIDE ø10⊕200 AT MID SPAN & END SPAN	BOTTOM⊕LVL 3.000
TB2	250	250	2ø12	–	2ø12	–	–	PROVIDE ø10⊕200 AT MID SPAN & END SPAN	BOTTOM⊕LVL 3.000

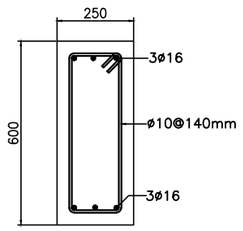

GB1 @ MIDSPAN & ENDSPAN S SCALE 1:20 GAD-1555 SHT-01

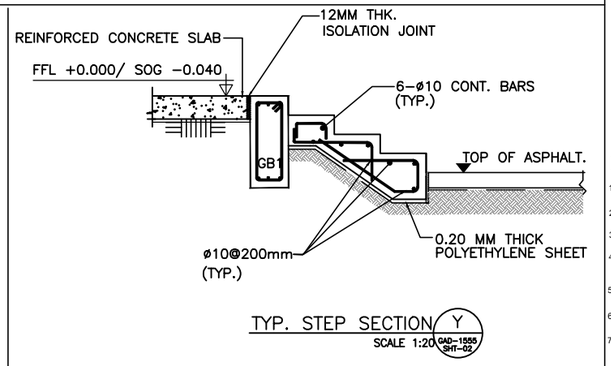

TYP. STEP SECTION Y SCALE 1:20 GAD-1555 SHT-02

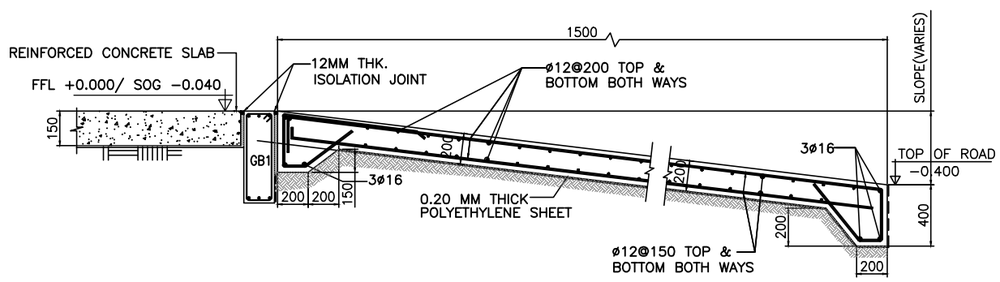

TYPICAL RAMP SECTION K SCALE 1:20 GAD-1555 SHT-02

NOTES

1.) ALL DIMENSIONS ARE GIVEN IN MILLIMETRES AND ELEVATIONS ARE IN METRES UNLESS OTHERWISE NOTED.
2.) MINIMUM REINFORCED CONCRETE GRADE TO BE USED FOR SUPERSTRUCTURE & SUBSTRUCTURES IS M35(5000 PSI).
3.) MINIMUM LEAN CONCRETE GRADE TO BE USED FOR THE SUB-STRUCTURES IS M15(2175 PSI).
4.) ALL REINFORCING STEEL SHALL BE DEFORMED BILLET STEEL BARS CONFORMING TO ASTM-A615, WITH MINIMUM YIELD STRENGTH OF FY420 MPA.
5.) THE NET SOIL BEARING CAPACITY CONSIDERED IN FOUNDATION DESIGN IS 350 KPA(REFER DOC 216-3000-EG-CV-CAL-1008).
6.) WATER PROOFING INSULATION SHALL BE AS PER PROJECT SPECS AND ITS MATERIAL TO BE APPROVED BY ENGINEER ON SITE.
7.) THE MINIMUM CONCRETE COVER AS PER SBC-304-2018(TABLE 20.6.1.3.1) MEASURED FROM REBAR SHALL BE
   a) CONCRETE CAST AGAINST & PERMANENTLY EXPOSED TO EARTH (INCLUDING FOUNDATIONS OVER SUB-SLAB) FORMED CONCRETE EXPOSED TO EARTH OR WEATHER.....50MM
   b.) CONCRETE NOT EXPOSED TO WEATHER NOR IN CONTACT WITH GROUND
   BEAMS, COLUMNS.....40MM
   SLABS, WALLS, JOISTS.....20MM
   c.) CONCRETE SLAB OVER 50MM SUB-SLAB.....20MM
8.) ALL DRAWINGS MUST BE READ IN CONJUNCTION WITH RELEVANT ARCHITECTURAL AND ENGINEERING DRAWINGS RELATED TO THE SAME SHEET AND ANY ITEM ON IT.
9.) F.F.L +0.00 MENTIONED IS EQUIVALENT TO RL 923.70 AS PER THE CIVIL DRAWING CE-004A-OVERALL LAYOUT PLAN.

LEGENDS
F-FOUNDATION
C-COLUMN
FFL-FINISH FLOOR LVL
FGL-FINISH GRADE LVL
TOS-TOP OF SCREED
WWF-WELDED WIRE FABRIC
HCS-HOLLOW CORE SLAB
GB-GRADE BEAM
IJ-ISOLATION JOINT
CJ-CONTROL JOINT
GA-GALVANIZED
S.O.G-SLAB ON GRADE
ARCH-ARCHITECTURAL
HOR.-HORIZONTAL
REINF.-REINFORCEMENT
LVL-LEVEL
RL-REDUCED LEVEL
VER-VERTICAL
FDN-FOUNDATION
TB-TIE BEAM/BOND BEAM
B/LB1-ROOF BEAMS

SHEET 3 OF 3

DOCUMENT NUMBER	REFERENCE DOCUMENTS	REV	DATE	REVISION DESCRIPTION	DRN	CHK	ENG	APP	EMP
MD-216-6000-EG-CV-STD-1002	HOLLOW CORE SLAB STANDARD	D01	27/02/2023	AS-BUILT	--	AVG	--	SJM	
MD-216-6000-EG-CV-STD-1001	REINFORCEMENT STANDARD	C02	22/06/2021	ISSUED FOR CONSTRUCTION AND REVISED AS MARKED △02	--	AVG	--	SJM	
MD-216-39LA-EG-FG-GAD-V513	BUILDING PLANS	C01	27/11/2020	ISSUED FOR CONSTRUCTION	--	AVG	--	SJM	
MD-216-6000-EG-CV-GAD-1535	OVERALL LAYOUT PLAN	A01	22/10/2020	ISSUED FOR APPROVAL	--	AVG	--	SJM	

DESIGNER: مكتب الخليج للاستشارات الهندسية - الغير - الشركة العربية السعودية
GULF CONSULT ARCHITECTS AND ENGINEERS

DRAWING NUMBER						REVISION
SC-PH-ST-003						A01
DATE	15/10/2020	DATE	16/10/2020	DATE	17/10/2020	
DRAWN	MAH	CHECKED	MF	APPROVED	FK	

LARSEN & TOUBRO DRAWING NUMBER	REVISION
019045_900_C_G_24256_001	3
OUTOTEC DRAWING NUMBER	DOCUMENT ID / REVISION
900707__GAU01__AN02__MTL01__18167	OU100696616 / 3

LARSEN & TOUBRO

This drawing is the property of LARSEN & TOUBRO and must not be passed on to any person or body not authorized by us to receive it nor be copied or otherwise made use either in full or in part by such person or body without our prior permission in writing.

Outotec

The content of these documents are the sole property of Outotec Oyj. Any rights not expressly granted herein are reserved. Reproduction, transfer or distribution of part or all of the contents in any form without prior written permission of Outotec is prohibited.

MA'ADEN معادن Saudi Arabian Mining Company

This document and the information contained herein is Ma'aden proprietary know-how. This document or any part thereof should not be reproduced, stored in a retrieval system or transmitted by any means, electronic or otherwise, or divulged without prior written permission of Ma'aden.

DRAWN	--	--
CHECKED	AVG	21/10/2020
ENGINEER	--	--
APPROVED	SJM	22/10/2020
EMPLOYER		
SCALE	1:50	A1

MANSOURAH - MASSARAH GOLD PROJECT
GENERAL ARRANGEMENT
SECURITY BASE CAMP:FIRE FIGHTING PUMP HOUSE
SECTIONS & DETAILS OF BUILDING

DRAWING NUMBER MD-216-1800-EG-CV-GAD-1555 REV D01