



DRAWING NUMBER: MD-216-1800-EG-CV-GAD-1557 REV D01

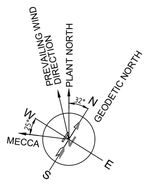


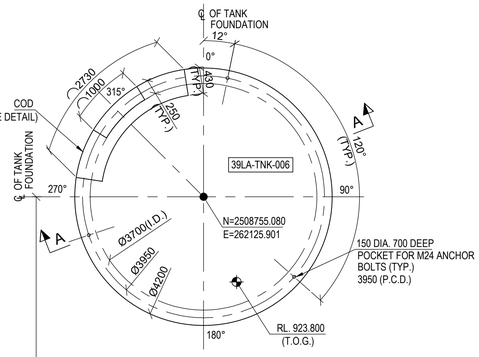

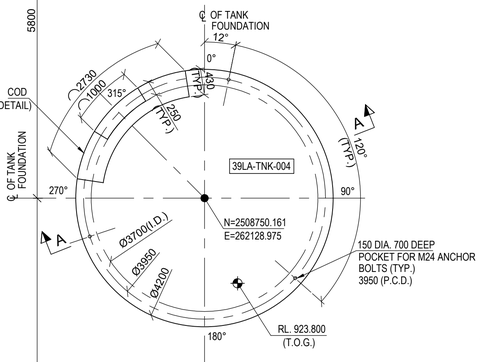


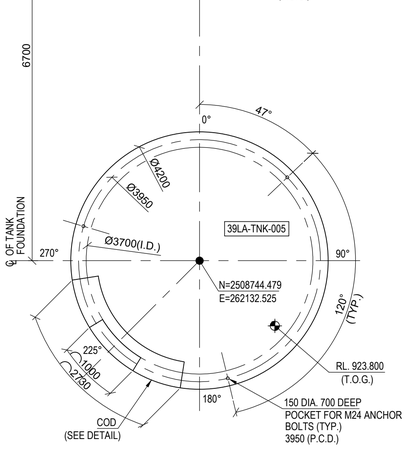


LAYOUT OF TANK FOUNDATION
SCALE 1:50

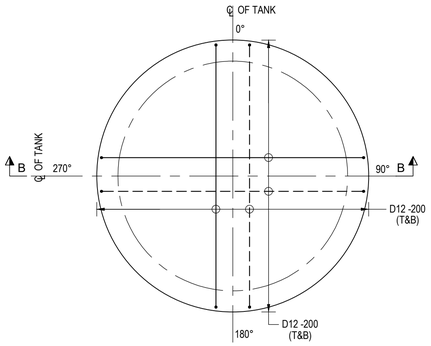


RCC. DETAIL OF TANK FOUNDATION
SCALE 1:40

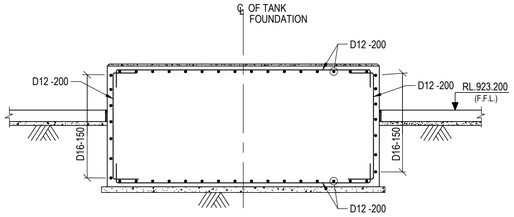


SECTION : B-B
SCALE 1:40

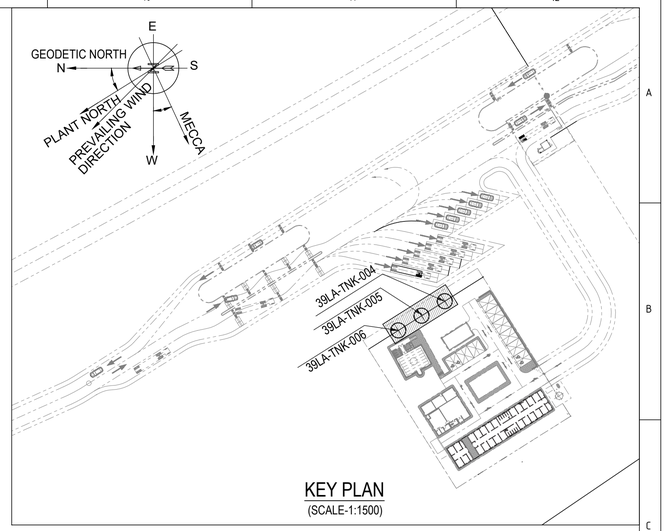


KEY PLAN
(SCALE-1:1500)

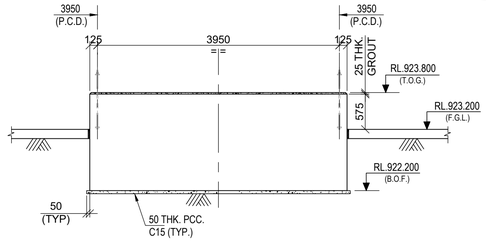


SECTION : A-A
SCALE 1:50

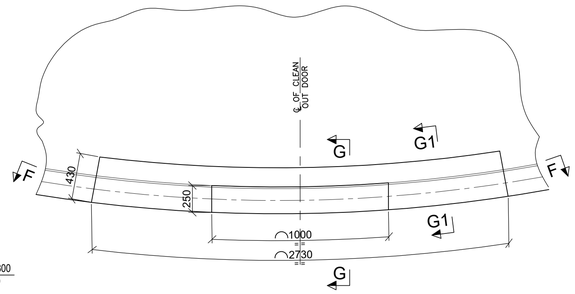


DETAIL OF CLEAN OUT DOOR (COD)
SCALE- 1:20

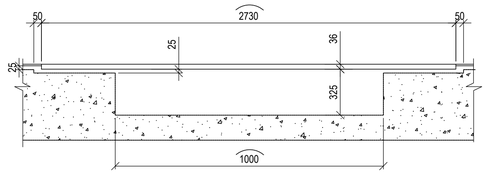


SECTION F-F
SCALE- 1:20

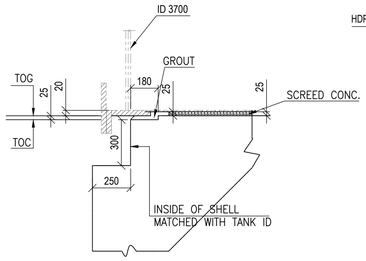

SECTION G-G
SCALE- 1:20

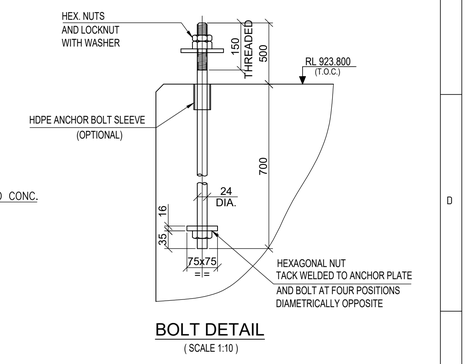

BOLT DETAIL
(SCALE 1:10)

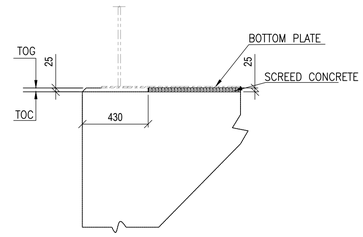

SECTION G1-G1
SCALE- 1:20

LEGEND :-
R.L. - REDUCED LEVEL
℄ - CENTRE LINE
T.O.G. - TOP OF GROUT
TYP. - TYPICAL
F.G.L. - FINISHED GROUND LEVEL
F.F.L. - FINISHED FLOOR LEVEL
B.O.F. - BOTTOM OF FOUNDATION
MKD. - MARKED
P.C.C - PLAIN CEMENT CONCRETE
P.C.D. - PITCH CIRCLE DIAMETER
I.D - INTERNAL DIAMETER
DET. - DETAIL
SQ. - SQUARE
FDN. - FOUNDATION
THK. - THICK
Ø.DIA. - DIAMETER
R.C.C - REINFORCED CEMENT CONCRETE
C.O.D - CLEAN OUT DOOR

NOTES:-
1. ALL DIMENSIONS ARE IN MILLIMETRES AND LEVELS AND CO-ORDINATES ARE IN METRES UNLESS OTHERWISE STATED.
2. NET SAFE BEARING CAPACITY OF SOIL AT BOTTOM OF FOUNDATION CONSIDER 450KN/ SQ. M
3. GRADE OF CONCRETE SHALL BE C35 (35MPa) FOR FOUNDATION & C15 (15MPa) FOR BLINDING CONCRETE.
4. GRADE OF REINFORCEMENT SHALL BE DEFORMED BAR 420 MPa (GRADE 60) - ASTM A615/A615M.
5. IF ANY PART OF FOUNDATION COMES ON BACKFILL ZONE OF ADJACENT FOUNDATION OR ANY LOOSE SOIL ARE ENCOUNTERED BELOW FOUNDATION LEVEL THE SAME SHALL BE REMOVED AND FILLED WITH PCC (C15).

DOCUMENT NUMBER	REFERENCE DOCUMENTS	REV	DATE	REVISION DESCRIPTION	DRN	CHK	ENG	APP	EMP
		D01	27/02/2023	AS-BUILT	PML	SJM	SOR	AG	
		C02	01/06/2021	ISSUED FOR CONSTRUCTION AND REVISED AS MARKED C02	PML	SJM	SOR	AG	
MD-216-1000-EG-ST-CRT-1001	CIVIL, STRUCTURAL & ARCHITECTURAL-DESIGN CRITERIA	C01	02/01/2021	ISSUED FOR CONSTRUCTION	ABS	SJM	AVG	AG	
MD-216-39LA-EG-FG-GAD-1003	PLAN, ELVN, DETAIL OF TANK 39LA-TNK-004&005	A01	28/11/2020	ISSUED FOR APPROVAL	ABS	SJM	AVG	AG	

RESERVED FOR VENDOR LOGO AND DRAWING NUMBER

LARSEN & TOUBRO

This drawing is the property of LARSEN & TOUBRO and must not be passed on to any person or body not authorized by us to receive it nor be copied or otherwise made use either in full or in part by such person or body without our prior permission in writing.

Outotec

The content of these documents are the sole property of Outotec Oyj. Any rights not expressly granted herein are reserved. Reproduction, transfer or distribution of part or all of the contents in any form without prior written permission of Outotec is prohibited.

MA'ADEN معادن
Saudi Arabian Mining Company شركة التعدين العربية السعودية

This document and the information contained herein is Ma'aden proprietary know-how. This document or any part thereof should not be reproduced, stored in a retrieval system or transmitted by any means, electronic or otherwise, or divulged without prior written permission of Ma'aden.

LARSEN & TOUBRO DRAWING NUMBER: 019045_900_C_G_24258_001 — REVISION: 3
OUTOTEC DRAWING NUMBER: 900707__GAU01__AN02__MTL01__18168 — DOCUMENT ID: OU100696617 — REVISION: 3

DRAWN	ABS	26/11/2020
CHECKED	SJM	27/11/2020
ENGINEER	AVG	26/11/2020
APPROVED	AG	28/11/2020
EMPLOYER		
SCALE	1:10, 1:40, 1:50	A1

MANSOURAH - MASSARAH GOLD PROJECT
GENERAL ARRANGEMENT DRAWING
FIRE WATER STORAGE & DISTRIBUTION
LAYOUT & DETAIL OF TANK 39LA-TNK-004,005 & 006

DRAWING NUMBER: MD-216-1800-EG-CV-GAD-1557 — REV: D01