MA'ADEN معادن

Saudi Arabian Mining Company شركة التعدين العربية السعودية

Project **Mansourah Massarah Gold Project**

Customer: **MA'ADEN GOLD AND BASE METALS (MA'ADEN)**

Title: **GENERAL ARRANGEMENT DRAWING FACILITY SECURITY FORCES BASE CAMP ROAD LAYOUT PLAN & DETAILS**

Document Number: **MD-216-1800-EG-CV-GAD-1559**

Revision: **D01**

Revision Date: **28.02.2023**


Status: **ASBUILT**

Outotec Document Number:	900707	GAU01	AN02	MTL01	18042	OU10076800	4
L&T Document Number:	O19045	900	C	G	24260	001	4


REVISION HISTORY


Rev	Date	Revision Text	Prepared By	Reviewed By	Approved By	Employer
A01	04.06.2020	ISSUED FOR APPROVAL	---	AVG	SJM	
C01	29.06.2020	ISSUED FOR CONSTRUCTION	---	AVG	SJM	
C02	26.08.2021	ISSUED FOR CONSTRUCTION AND REVISED AS MKD C02	---	AVG	SJM	
C03	23.02.2022	ISSUED FOR CONSTRUCTION AND REVISED AS MKD C03	---	AVG	SJM	
D01	28.02.2023	AS BUILT	----	AVG	SJM	

DRAWING NUMBER: MD-216-1800-EG-CV-GAD-1559 | REV: D01

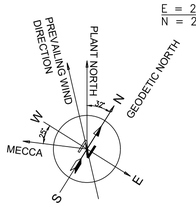

KEY PLAN

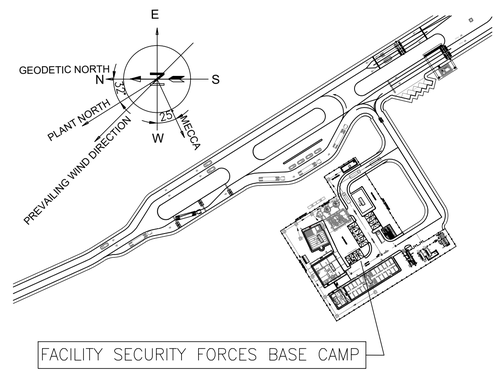

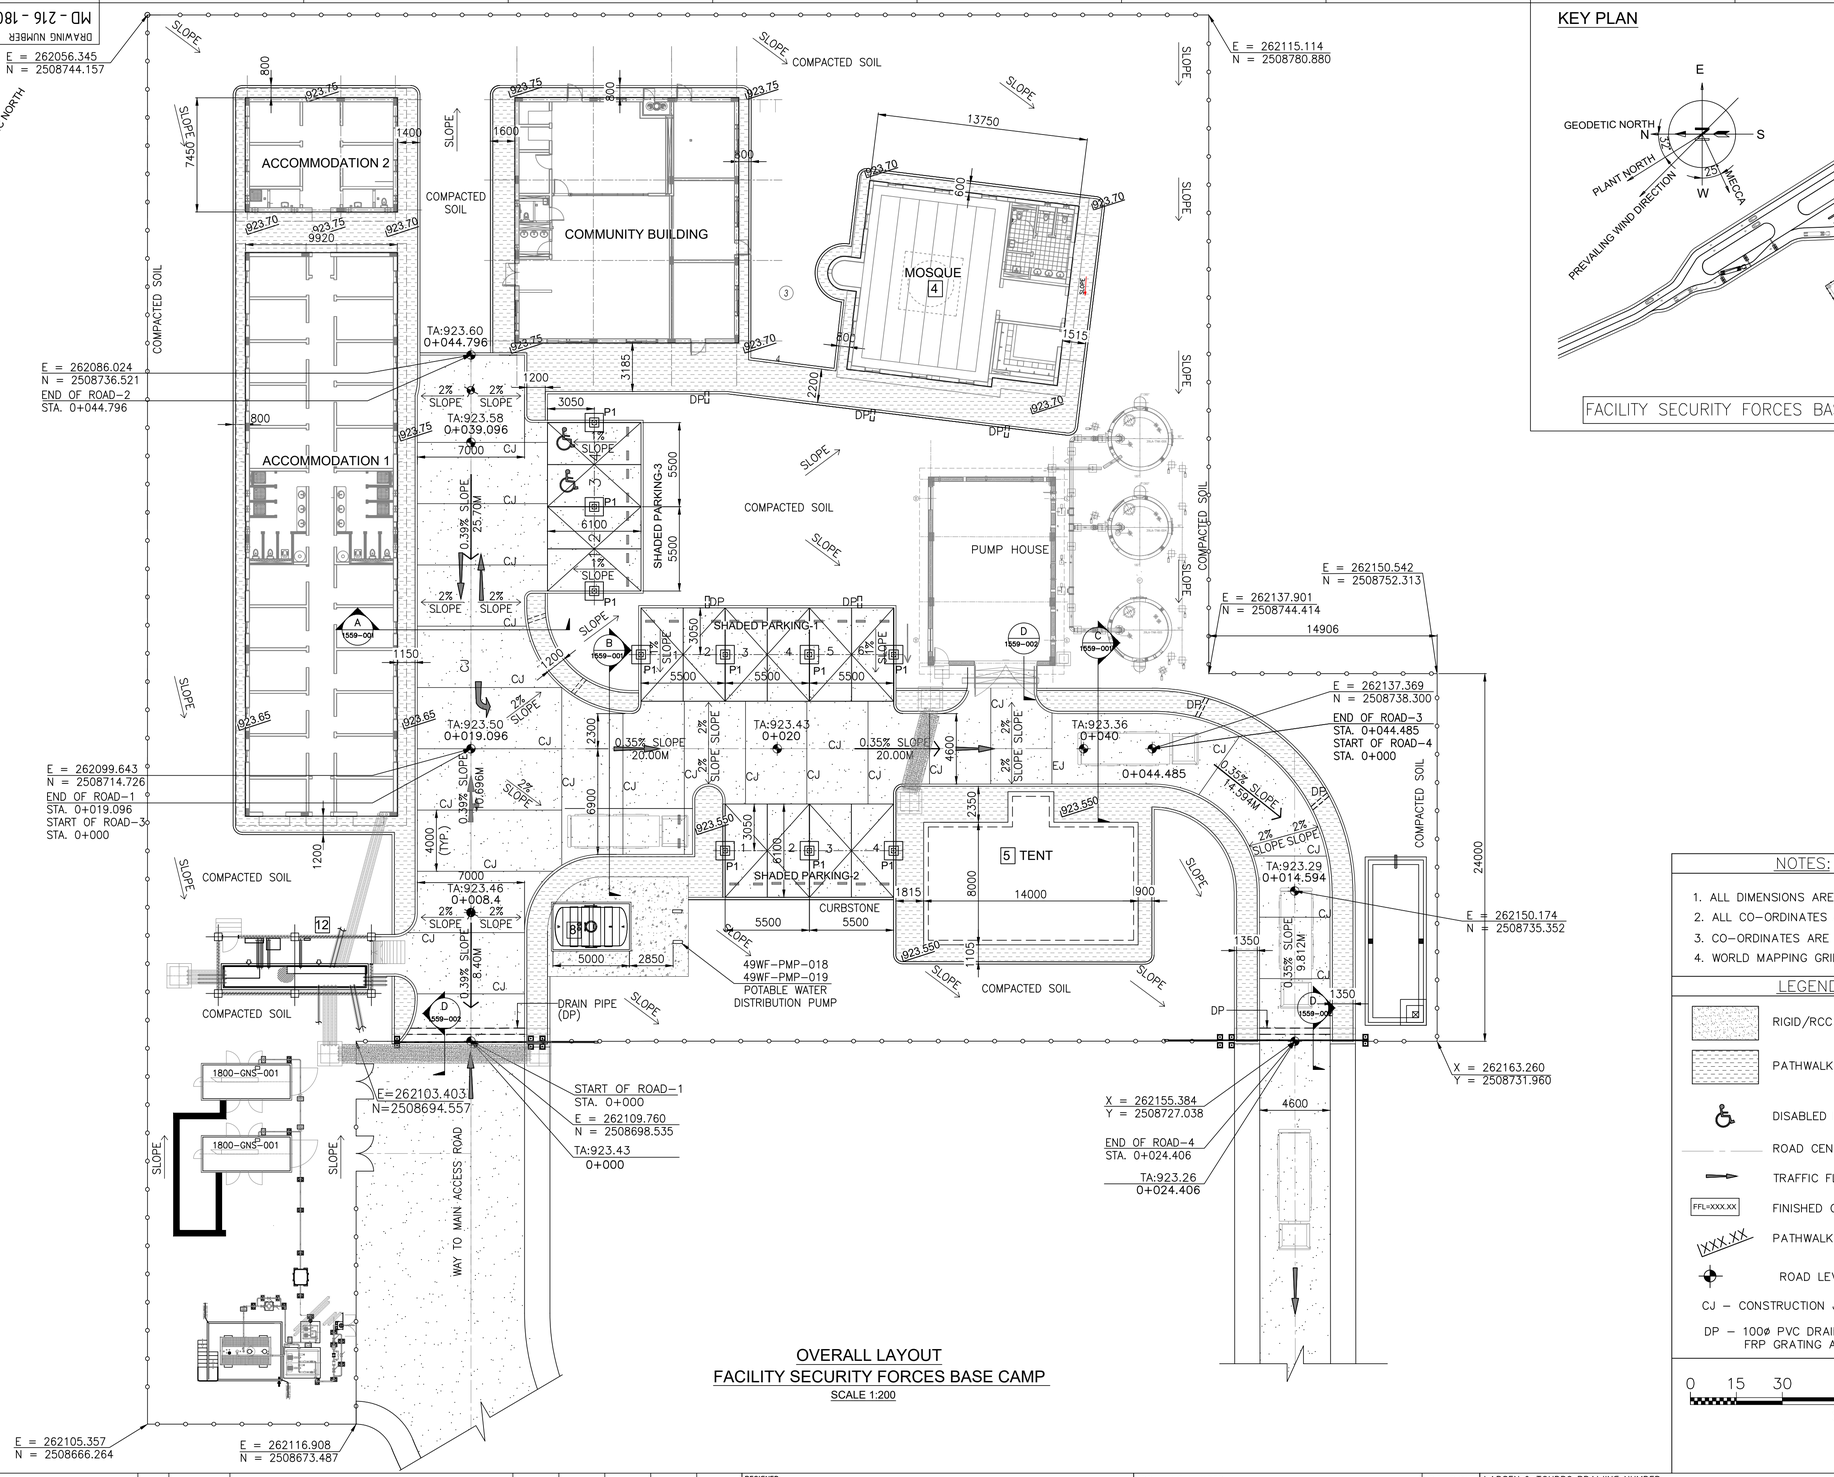

OVERALL LAYOUT
FACILITY SECURITY FORCES BASE CAMP
SCALE 1:200

NOTES:

1. ALL DIMENSIONS ARE IN MILLIMETERS UNLESS OTHERWISE NOTED.
2. ALL CO-ORDINATES ARE IN METERS.
3. CO-ORDINATES ARE ON WORLD GRID (FLAT PLANT/WORLD).
4. WORLD MAPPING GRID BASED ON UTM (WGS 84) Q38N.

LEGEND:

- RIGID/RCC PAVEMENT
- PATHWALK/SIDE WALK (CONCRETE BROOM FINISH)
- DISABLED PARKING
- ROAD CENTERLINE
- TRAFFIC FLOW DIRECTIONAL SIGN
- FFL=XXX.XX — FINISHED GROUND LEVEL(FGL)/FINISHED FLOOR LEVEL(FFL)
- XXX.XX — PATHWALK/SIDE WALK LEVEL
- ROAD LEVEL

CJ – CONSTRUCTION JOINT , EJ – EXPANSION JOINT

DP – 100ø PVC DRAIN PIPE WITH STEEL/ FRP GRATING AT MOUTH

0 15 30 60 90 120 METERS

SCALE 1 : 1200

SHEET 1 OF 3

DOCUMENT NUMBER	REFERENCE DOCUMENTS	REV	DATE	REVISION DESCRIPTION	DRN	CHK	ENG	APP	EMP
		D01	28/02/2023	AS-BUILT	--	AVG	--	SJM	
		C03	23/02/2022	ISSUED FOR CONSTRUCTION & REVISED AS MARKED C03	--	AVG	--	SJM	
		C02	26/08/2021	ISSUED FOR CONSTRUCTION & REVISED AS MARKED C02	--	AVG	--	SJM	
		C01	29/06/2020	REVISED AS PER EMPLOYER COMMENTS DATED					
MD-216-1800-EG-CV-GAD-1578	SECURITY BASE CAMP: PULL PIT LAYOUT			27/01/2020 AND REVISED AS MKD. C01	--	AVG	--	SJM	
MD-216-1800-EG-CV-GAD-1565	OVERALL LAYOUT PLAN	A01	04/06/2020	ISSUED FOR APPROVAL	RAFI	AVG	NILO	SHAU/SJM	

DESIGNER: مكتب الخليج للاستشارات الهندسية – العبر، المملكة العربية السعودية — GULF CONSULT ARCHITECTS AND ENGINEERS

DRAWN	RAN	CHECKED	SHAU	APPROVED	NILO		
DATE	30/05/2020	DATE	30/05/2020	DATE	30/05/2020		

DRAWING NUMBER: CIVIL-FSBC-002 | REVISION: 2

LARSEN & TOUBRO DRAWING NUMBER: 019045_900_C_G_24260_001 | REVISION: 4

OUTOTEC DRAWING NUMBER: 900707__GAU01__AN02__MTL01__18042 | DOCUMENT ID: OU100676800 | REVISION: 4

DRAWN		
CHECKED	AVG	03/06/2020
ENGINEER		
APPROVED	SJM	04/06/2020
EMPLOYER		
SCALE	1:200	A1

MANSOURAH - MASSARAH GOLD PROJECT
GENERAL ARRANGEMENT
FACILITY SECURITY FORCES BASE CAMP
ROAD LAYOUT PLAN & DETAIL


DRAWING NUMBER: MD-216-1800-EG-CV-GAD-1559 | REV: D01

LARSEN & TOUBRO
This drawing is the property of LARSEN & TOUBRO and must not be passed on to any person or body not authorized by us to receive it nor be copied or otherwise made use either in full or in part by such person or body without our prior permission in writing.


Outotec
The content of these documents are the sole property of Outotec Oyj. Any rights not expressly granted herein are reserved. Reproduction, transfer or distribution of part or all of the contents in any form without prior written permission of Outotec is prohibited.

MA'ADEN معادن
Saudi Arabian Mining Company شركة التعدين العربية السعودية
This document and the information contained herein is Ma'aden proprietary know-how. This document or any part thereof should not be reproduced, stored in a retrieval system or transmitted by any means, electronic or otherwise, or divulged without prior written permission of Ma'aden.


DRAWING NUMBER: MD-216-6000-EG-CV-GAD-1559 | REV: D01

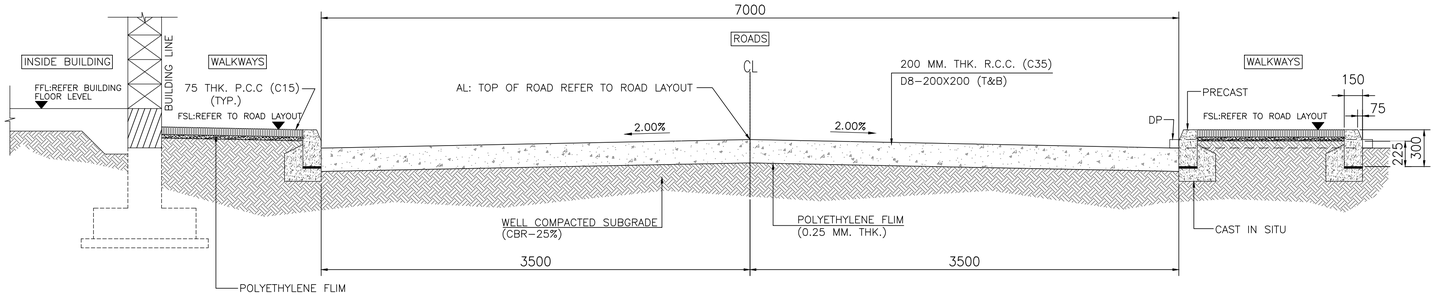


ROAD SECTION FOR 7.0M WIDE (SECTION A) – ROAD 1 & 2
SCALE 1:25

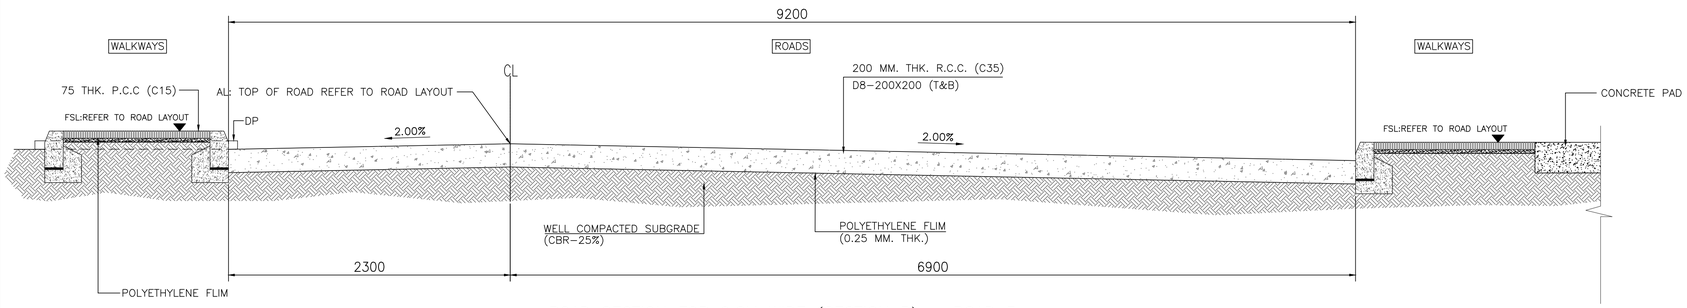


ROAD SECTION FOR 9.2M WIDE (SECTION B) – ROAD 3
SCALE 1:25

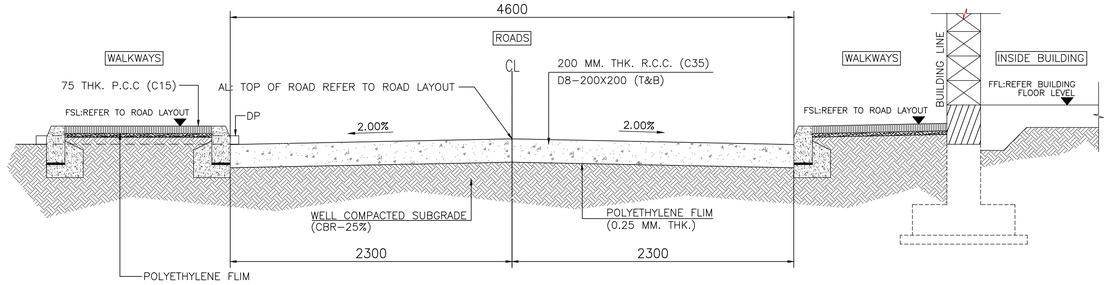


ROAD SECTION FOR 4.6M WIDE (SECTION C) – ROAD 3 & 4
SCALE 1:25

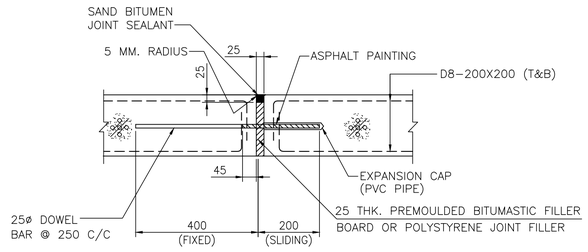

EXPANSION JOINT
(HEAVY DUTY)
SCALE–1:10

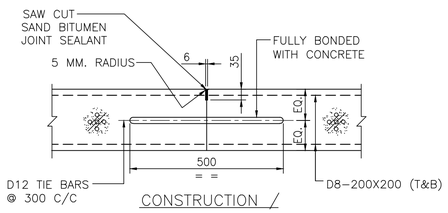


CONSTRUCTION / CONTRACTION JOINT
SCALE–1:10

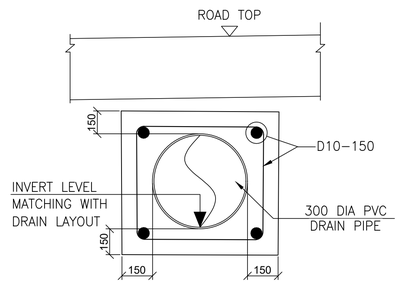


TYPICAL TRENCH SECTION–D
SCALE 1:10

MASTER KEY PLAN

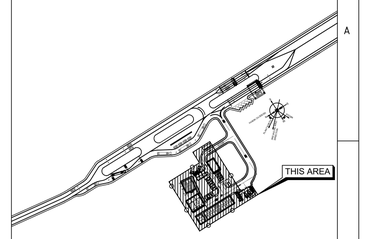

ENLARGED KEY PLAN

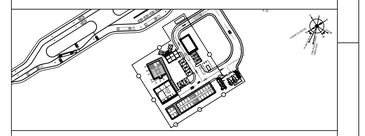

NOTES

1. ALL DIMENSIONS ARE IN MILLIMETERS UNLESS OTHERWISE NOTED.
2. ALL CO-ORDINATES ARE IN METERS.
3. CO-ORDINATES ARE ON WORLD GRID (FLAT PLANT/WORLD).
4. THE JOINT LOCATION (CONSTRUCTION/ CONTRACTION/ EXPANSION) AS INDICATED IN LAYOUT.
5. FOR STANDARD DETAILS OF GRADE SLAB REFER DRAWING NO. MD-216-1000-EG-CV-DED-1002.

LEGEND & ABBREVATION

FFL – FINISH FLOOR LEVEL
FSL – FINISH SIDEWALK LEVEL
FGL – FINISH GRADE LEVEL
AL – FINISH ROAD LEVEL
DP – 100ø PVC DRAIN PIPE WITH STEEL/ FRP GRATING AT MOUTH

SCALE

0 15 30 60 90 120 METERS
SCALE 1 : 25

SHEET 2 OF 3

DOCUMENT NUMBER	REFERENCE DOCUMENTS	REV	DATE	REVISION DESCRIPTION	DRN	CHK	ENG	APP	EMP
		D01	28/02/2023	AS-BUILT	---	AVG	---	SJM	
		C03	23/02/2022	ISSUED FOR CONSTRUCTION & REVISED AS MARKED /C03	---	AVG	---	SJM	
		C02	26/08/2021	ISSUED FOR CONSTRUCTION & REVISED AS MARKED /C02	---	AVG	---	SJM	
MD-216-1800-EG-CV-GAD-1562	STORM DRAINAGE LAYOUT PLAN & DETAIL	C01	29/06/2020	ISSUED FOR CONSTRUCTION	---	AVG	---	SJM	
MD-216-1800-EG-CV-GAD-1565	ROAD LAYOUT PLAN	A01	04/06/2020	ISSUED FOR APPROVAL	---	AVG	---	SJM	

DESIGNER: مكتب الخليج للاستشارات الهندسية – الغير، المملكة العربية السعودية / GULF CONSULT ARCHITECTS AND ENGINEERS

DRAWING NUMBER	REVISION
CIVIL-FSBC-002	2

DATE		DATE		DATE	
30/05/2020	30/05/2020			30/05/2020	
DRAWN	RAN	CHECKED	NILO	APPROVED	SHAU

LARSEN & TOUBRO DRAWING NUMBER	REVISION
019045_900_C_G_24260_001	4
OUTOTEC DRAWING NUMBER	DOCUMENT ID / REVISION
900707__GAU01__AN02__MTL01__18042	OU100676800 / 4

LARSEN & TOUBRO

This drawing is the property of LARSEN & TOUBRO and must not be passed on to any person or body not authorized by us to receive it nor be copied or otherwise made use either in full or in part by such person or body without our prior permission in writing.

Outotec

The content of these documents are the sole property of Outotec Oyj. Any rights not expressly granted herein are reserved. Reproduction, transfer or distribution of part or all of the contents in any form without prior written permission of Outotec is prohibited.

MA'ADEN معادن – Saudi Arabian Mining Company شركة التعدين العربية السعودية


This document and the information contained herein is Ma'aden proprietary know-how. This document or any part thereof should not be reproduced, stored in a retrieval system or transmitted by any means, electronic or otherwise, or divulged without prior written permission of Ma'aden.

DRAWN	---	---
CHECKED	AVG	03/06/2020
ENGINEER	---	---
APPROVED	SJM	04/06/2020
EMPLOYER		
SCALE	1:25	A1


MANSOURAH-MASSARAH GOLD PROJECT
GENERAL ARRANGEMENT
FACILITY SECURITY FORCES BASE CAMP
ROAD LAYOUT PLAN & DETAIL

DRAWING NUMBER: MD-216-1800-EG-CV-GAD-1559 | REV: D01


DRAWING NUMBER: MD-216-6000-EG-CV-GAD-1559
REV: D01

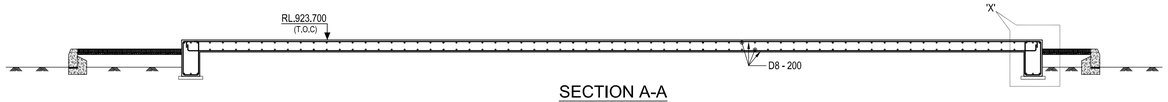


SECTION A-A
(R.C DETAILS)
(SCALE 1:50)

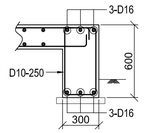


DETAIL - X
(SCALE 1:25)

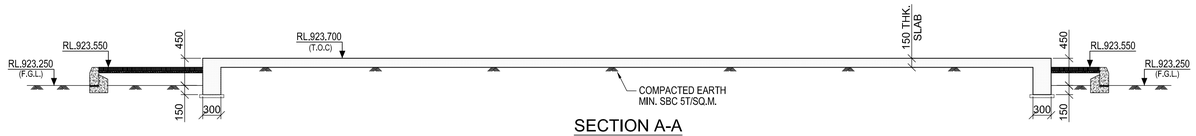


SECTION A-A
(SCALE 1:50)

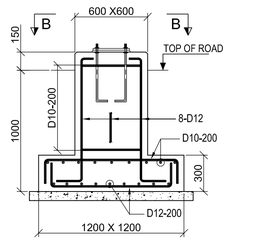

DETAILS OF FOUNDATION MKD. F1
(SCALE 1:25)

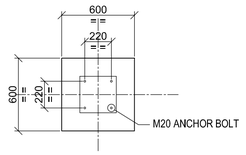


VIEW B-B
(10 NOS. REQUIRED)
(SCALE 1:25)

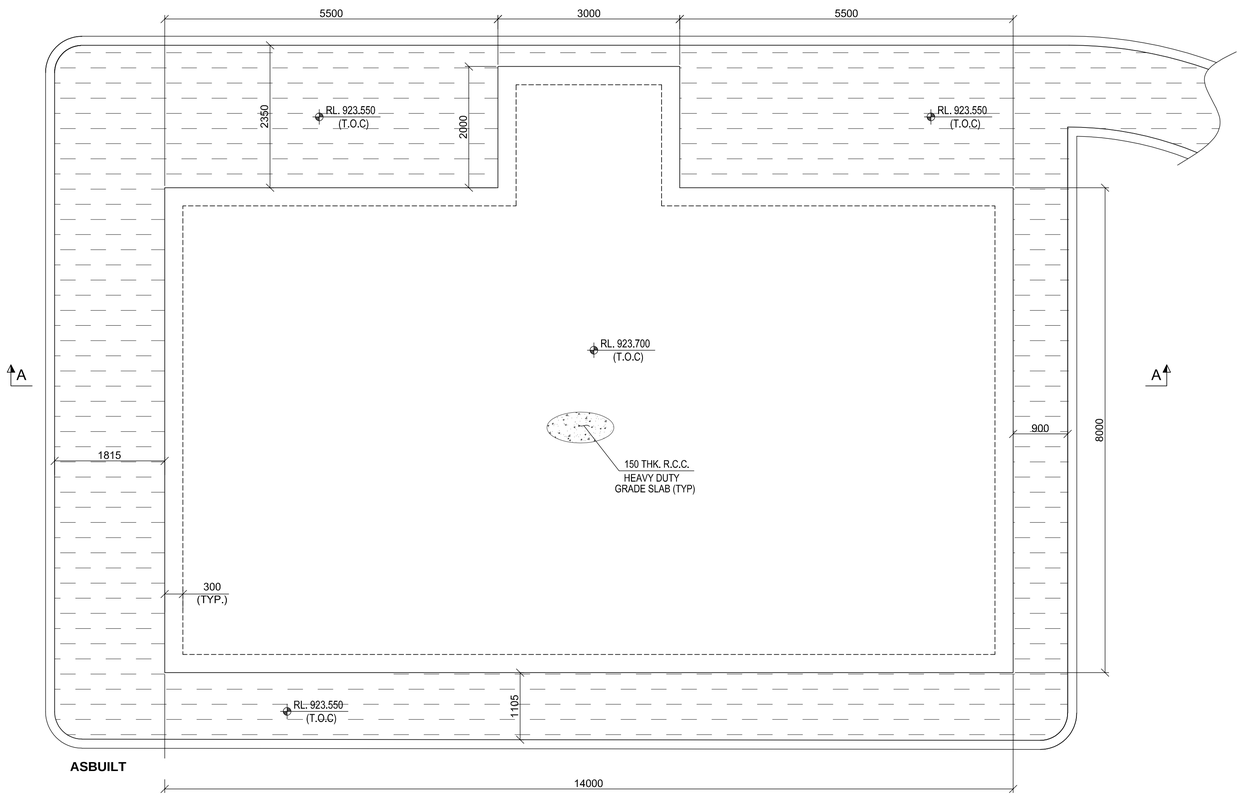

ASBUILT

PLAN OF TENT GRADE SLAB
(SCALE 1:50)

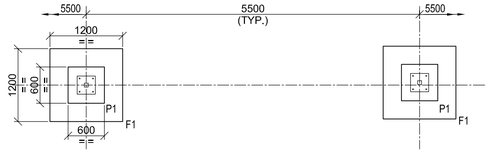

PLAN OF PARKING SHED FOUNDATION
(10 NOS. REQUIRED)
REFER DRG. NO.MD-216-1800-EGCV-GAD-1559 SHEET 1 OF 3)
(SCALE 1:50)

LEGEND :-

RL. - REDUCED LEVEL.
T.O.C. - TOP OF CONCRETE.
F.G.L. - FINISHED GROUND LEVEL.
TYP. - TYPICAL.

NOTES :-

1. ALL DIMENSIONS ARE IN MILLIMETRES AND LEVELS AND CO-ORDINATES ARE IN METRES, UNLESS OTHERWISE STATED.
2. GRADE OF CONCRETE SHALL BE (C35) MPa FOR ROAD & GRADE SLAB (C15) MPa FOR APPRON.
3. GRADE OF REINFORCEMENT SHALL BE DEFORMED BAR 420 MPa (GRADE 60) - ASTM A615/A615M.
4. ALL OTHER NOTES REFER DRAWING NO. MD-101-SMEM-EG-ST-DST-0001 TO 0008.
5. GENERAL NOTES FOR CIVIL WORKS & STANDARD REINFORCEMENT DETAIL REFER DRAWING NO. MD-216-1000-EG-CV-DED-1001 & 1005.
6. FOR STANDARD DETAILS OF GRADE SLAB REFER DRAWING NO. MD-216-1000-EG-CV-DED-1002.

SHEET 3 OF 3

DOCUMENT NUMBER	REFERENCE DOCUMENTS	REV	DATE	REVISION DESCRIPTION	DRN	CHK	ENG	APP	EMP
		D01	28/02/2023	AS-BUILT	----	AVG	----	SJM	
		C03	23/02/2022	ISSUED FOR CONSTRUCTION & REVISED AS MARKED /C03	---	AVG	---	SJM	
		C02	26/08/2021	ISSUED FOR CONSTRUCTION & REVISED AS MARKED /C02	---	AVG	---	SJM	
MD-216-1800-EG-CV-GAD-1562	STORM DRAINAGE LAYOUT PLAN & DETAIL	C01	29/06/2020	ISSUED FOR CONSTRUCTION	---	AVG	---	SJM	
MD-216-1800-EG-CV-GAD-1565	ROAD LAYOUT PLAN	A01	04/06/2020	ISSUED FOR APPROVAL	---	AVG	---	SJM	

DESIGNER:
معكب الخليج للاستشارات الهندسية
GULF CONSULT
ARCHITECTS AND ENGINEERS

DRAWING NUMBER					REVISION
CIVIL-FSBC-002					2
DATE	30/05/2020	DATE	30/05/2020	DATE	30/05/2020
DRAWN	RAN	CHECKED	NILO	APPROVED	SHAU

LARSEN & TOUBRO DRAWING NUMBER		REVISION
019045_900_C_G_24260_001		4
OUTOTEC DRAWING NUMBER	DOCUMENT ID	REVISION
900707__GAU01__AN02__MTL01__18042	OU100676800	4

LARSEN & TOUBRO

This drawing is the property of LARSEN & TOUBRO and must not be passed on to any person or body not authorized by us to receive it nor be copied or otherwise made use either in full or in part by such person or body without our prior permission in writing.

Outotec

The content of these documents are the sole property of Outotec Oyj. Any rights not expressly granted herein are reserved. Reproduction, transfer or distribution of part or all of the contents in any form without prior written permission of Outotec is prohibited.

MA'ADEN معادن
Saudi Arabian Mining Company شركة التعدين العربية السعودية

This document and the information contained herein is Ma'aden proprietary know-how. This document or any part thereof should not be reproduced, stored in a retrieval system or transmitted by any means, electronic or otherwise, or divulged without prior written permission of Ma'aden.

DRAWN	---	---
CHECKED	AVG	03/06/2020
ENGINEER	---	---
APPROVED	SJM	04/06/2020
EMPLOYER		
SCALE	1:25	A1

MANSOURAH-MASSARAH GOLD PROJECT
GENERAL ARRANGEMENT
FACILITY SECURITY FORCES BASE CAMP
ROAD LAYOUT PLAN & DETAIL

DRAWING NUMBER	REV
MD-216-1800-EG-CV-GAD-1559	D01