


DRAWING NUMBER MD-216-1800-EG-CV-GAD-1562 REV D01

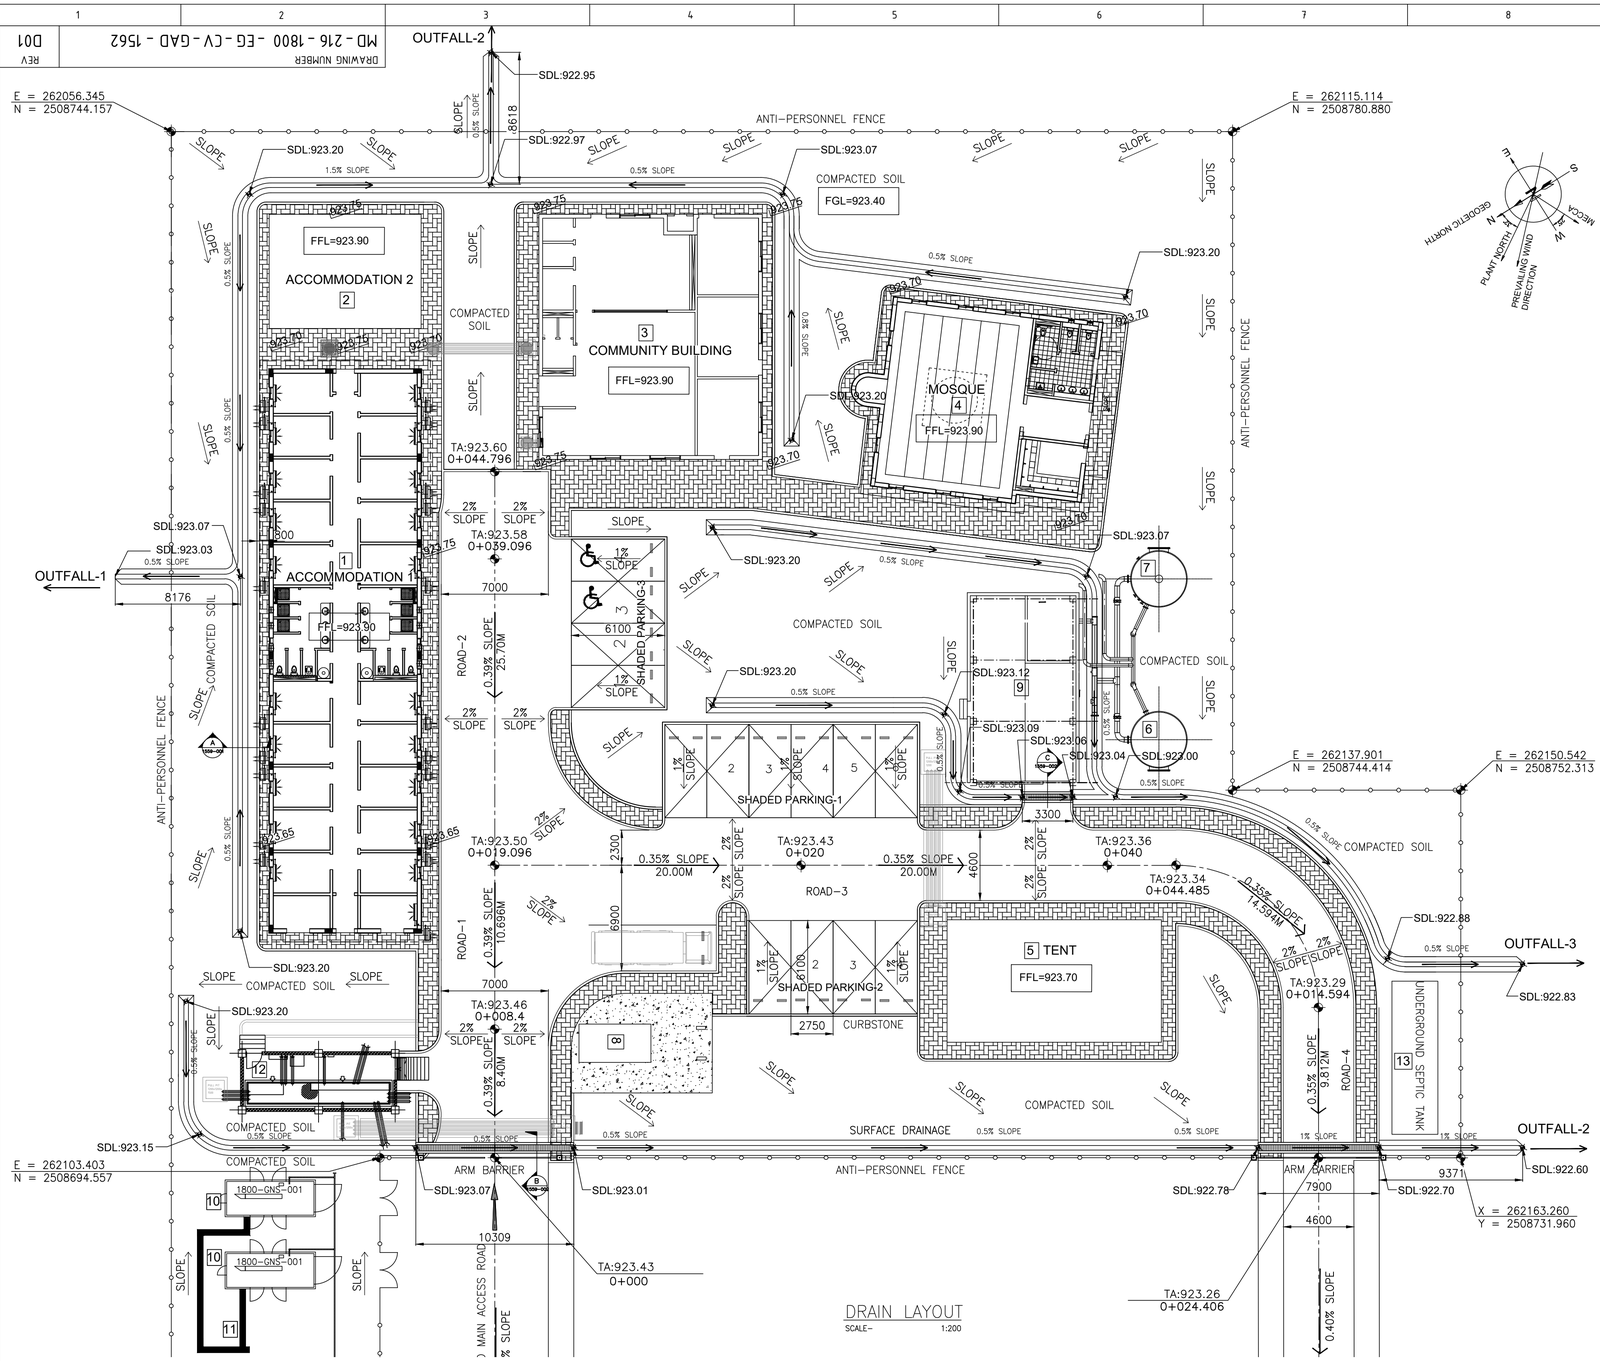


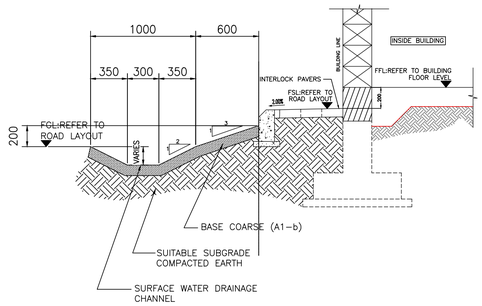

TYPICAL SURFACE DRAIN WATER SECTION DETAIL-A (1) SCALE NTS (1560)

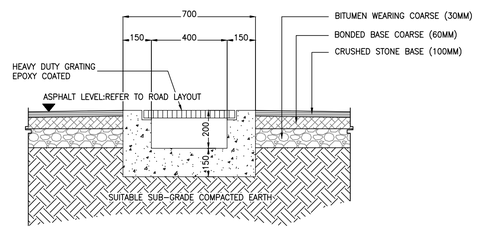


TYPICAL TRENCH SECTION-B (2) SCALE NTS. (1560)

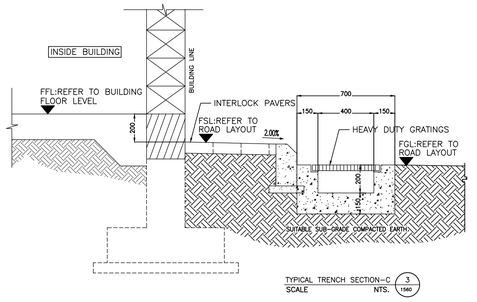


TYPICAL TRENCH SECTION-C (3) SCALE NTS. (1560)

MASTER KEY PLAN

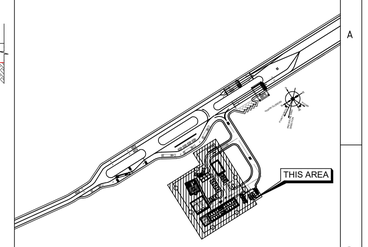

ENLARGED KEY PLAN

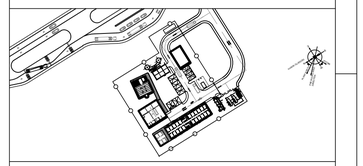

NOTES

1. ALL DIMENSIONS ARE IN MILLIMETERS UNLESS OTHERWISE NOTED.
2. ALL CO-ORDINATES ARE IN METERS.
3. CO-ORDINATES ARE ON WORLD GRID (FLAT PLANT/WORLD).
4. WORLD MAPPING GRID BASED ON UTM (WGS 84) Q38N.

LEGEND

	ROAD CENTERLINE
	FENCE
000.00	FINISHED GROUND LEVEL(FGL)
TA=000.00	TOP OF ASPHALT
N 2508261.799 / E 263293.131	PROPERTY COORDINATES
	SURFACE DRAIN OPEN CHANNEL
SDL: 922.60	SURFACE DRAIN INVERT LEVEL
0.73% SLOPE	SURFACE DRAIN SLOPE
0.73% SLOPE 71.155M.	ROAD ASPHALT SLOPE
AL	ASPHALT LEVEL
SDL	SURFACE DRAIN LEVEL
CL	ROAD CENTER LINE
FSL	FINISH SIDEWALK LEVEL

DOCUMENT NUMBER	REFERENCE DOCUMENTS	REV	DATE	REVISION DESCRIPTION	DRN	CHK	ENG	APP	EMP
		D01	28/02/2023	AS-BUILT	-	AVG	-	SJM	
		C01	07/01/2021	ISSUED FOR CONSTRUCTION	-	AVG	-	SJM	
MD-216-1800-EG-CV-GAD-1559	ROAD LAYOUT PLAN & DETAIL	A02	10/12/2020	REVISED AS PER EMPLOYER'S COMMENT DATED 18.07.2020	-	AVG	-	SJM	
MD-216-1800-EG-CV-GAD-1565	OVERALL LAYOUT PLAN	A01	15/06/2020	ISSUED FOR APPROVAL	-	AVG	-	SJM	

DESIGNER: مكتب الخليج للاستشارات الهندسية - المملكة العربية السعودية — GULF CONSULT ARCHITECTS AND ENGINEERS

DRAWN	RAN	CHECKED	NILO	APPROVED	SHAU	
DATE	08/06/2020	DATE	09/06/2020	DATE	10/06/2020	

DRAWING NUMBER: CIVIL-FSBC-002 — REVISION: 1

LARSEN & TOUBRO DRAWING NUMBER: 019045_900_C_G_24263_001 — REVISION: 3

OUTOTEC DRAWING NUMBER: 900707__GAU01__AN02__MTL01__18048 — DOCUMENT ID: OU100688268 — REVISION: 3

This drawing is the property of LARSEN & TOUBRO and must not be passed on to any person or body not authorized by us to receive it nor be copied or otherwise made use either in full or in part by such person or body without our prior permission in writing.

The content of these documents are the sole property of Outotec Oyj. Any rights not expressly granted herein are reserved. Reproduction, transfer or distribution of part or all of the contents in any form without prior written permission of Outotec is prohibited.

This document and the information contained herein is Ma'aden proprietary know-how. This document or any part thereof should not be reproduced, stored in a retrieval system or transmitted by any means, electronic or otherwise, or divulged without prior written permission of Ma'aden.

DRAWN	--	
CHECKED	AVG	12/06/2020
ENGINEER	--	
APPROVED	SJM	15/06/2020
EMPLOYER		
SCALE	1:200	A1

MANSOURAH-MASSARAH GOLD PROJECT
GENERAL ARRANGEMENT DRAWING
FACILITY SECURITY FORCES BASE CAMP
STORM DRAINAGE LAYOUT PLAN & DETAIL

DRAWING NUMBER: MD-216-1800-EG-CV-GAD-1562 — REV: D01