


DRAWING NUMBER MD-216-1800-EG-CV-GAD-1565 REV D01

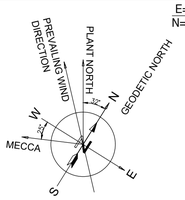

E=262056.345
N=2508744.156

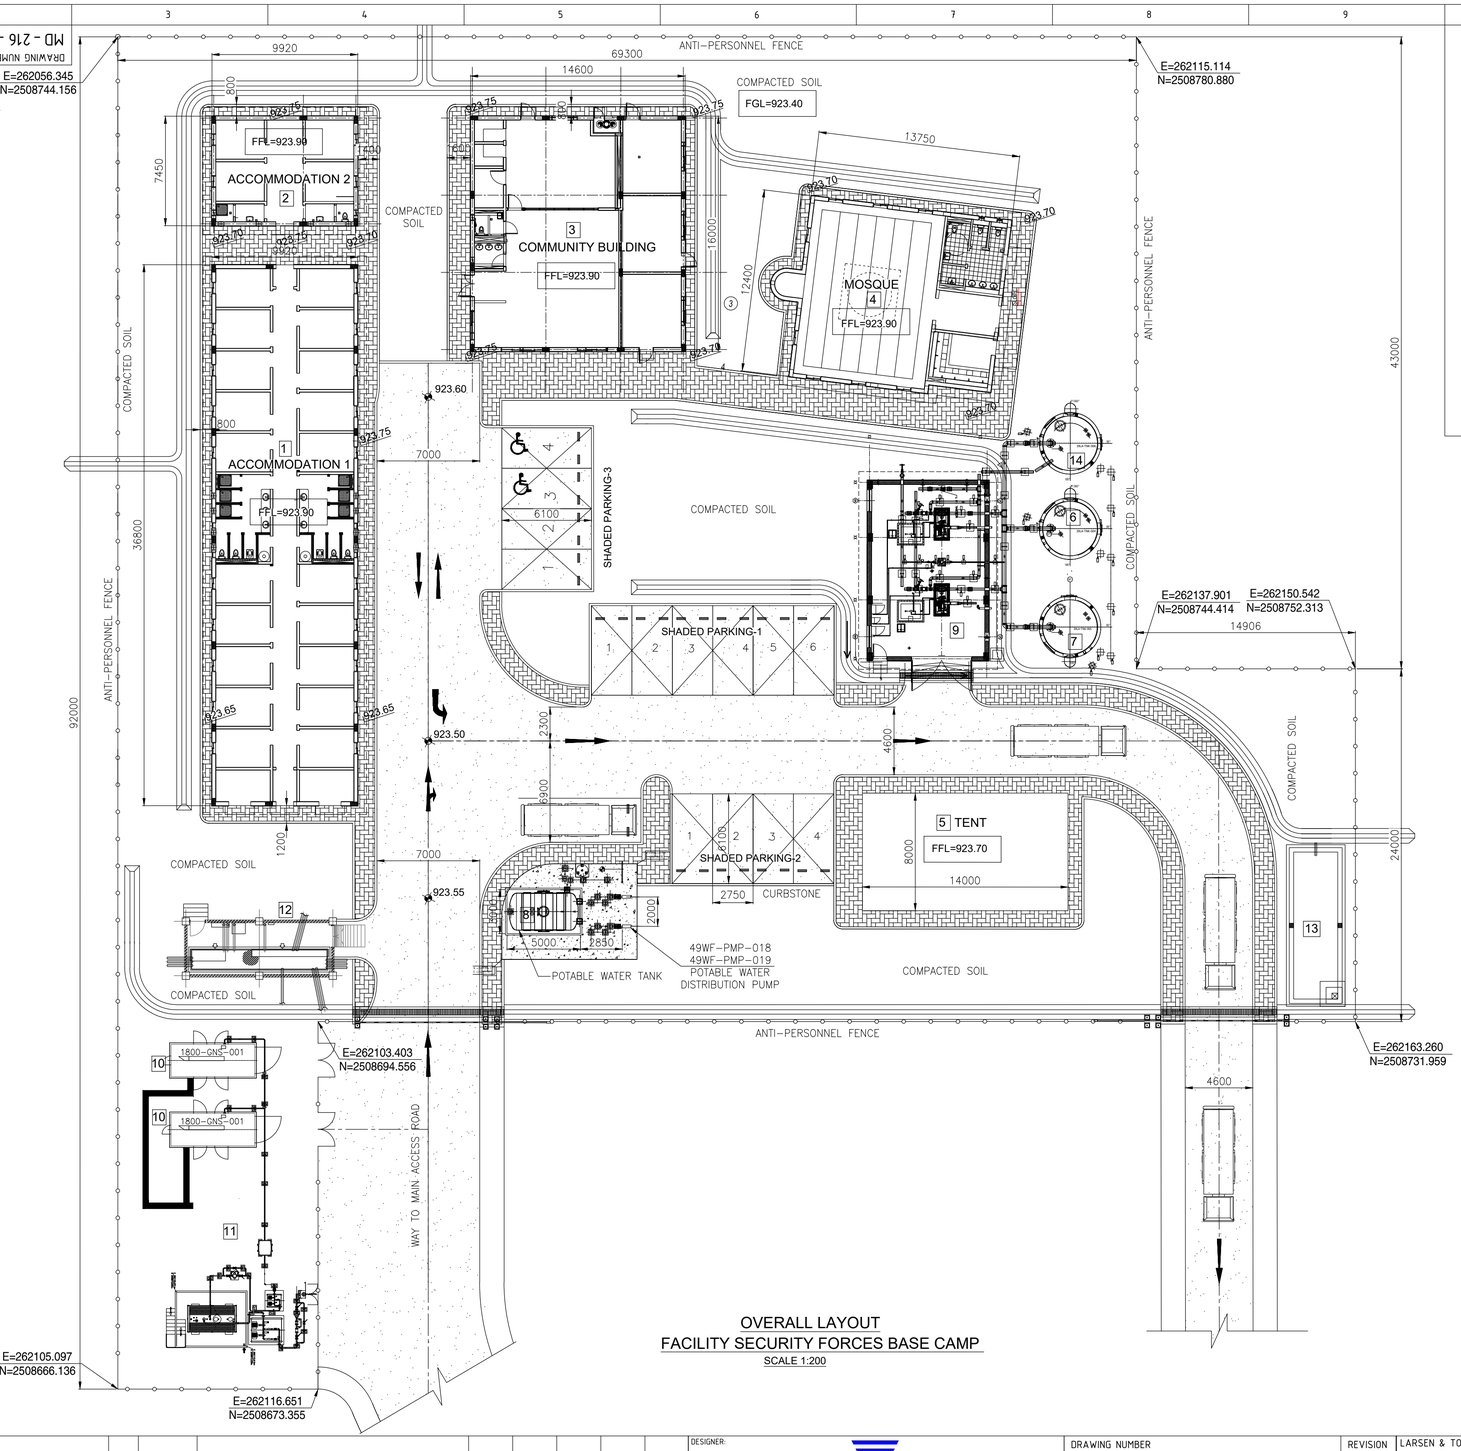

KEY PLAN

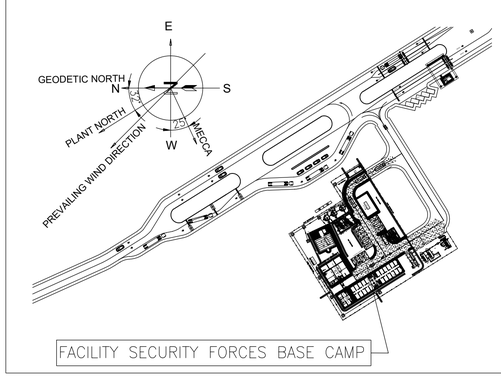

SN.	DESCRIPTION	FINISH FLOOR LEVEL (FFL)
1	ACCOMMODATION -1	923.90
2	ACCOMMODATION -2	923.90
3	COMMUNITY BUILDING	923.90
4	MOSQUE	923.90
5	TENT	923.70
6	FIRE FIGHTING WATER TANK 39LA-TNK-004	923.70
7	FIRE FIGHTING WATER TANK 39LA-TNK-005	923.70
8	POTABLE WATER TANK 49WF-TNK-006	923.60
9	FIRE FIGHTING PUMP HOUSE	923.70
10	DIESEL GENERATOR	923.90
11	OIL TANK FOR DIESEL GENERATOR	923.90
12	ELECTRICAL ROOM	923.90
13	SEPTIC TANK	923.90
14	FIRE FIGHTING WATER TANK 39LA-TNK-006	923.70

NOTES:

1. ALL DIMENSIONS ARE IN MILLIMETERS UNLESS OTHERWISE NOTED.
2. ALL CO-ORDINATES ARE IN METERS.
3. CO-ORDINATES ARE ON WORLD GRID (FLAT PLANT/WORLD).
4. WORLD MAPPING GRID BASED ON UTM (WGS 84) Q38N.

LEGEND:

- ASPHALT PAVEMENT
- PATHWALK/SIDE WALK
- DISABLED PARKING
- ROAD CENTERLINE
- TRAFFIC FLOW DIRECTIONAL SIGN
- FFL=XXX.XX — FINISHED GROUND LEVEL(FGL)/FINISHED FLOOR LEVEL(FFL)
- XXX.XX — PATHWALK/SIDE WALK LEVEL
- ASPHALT ROAD LEVEL

0 15 30 60 90 120 METERS

SCALE 1 : 1200

OVERALL LAYOUT
FACILITY SECURITY FORCES BASE CAMP
SCALE 1:200

REV	DOCUMENT NUMBER	REFERENCE DOCUMENTS	DATE	REVISION DESCRIPTION	DRN	CHK	ENG	APP	EMP
D01			28/02/2023	AS-BUILT	- -	AVG	- -	SJM	
C02			17/05/2021	ISSUED FOR CONSTRUCTION & GENERALLY REVISED (C02)	- -	AVG	- -	SJM	
C01			11/03/2020	REVISED AS PER EMPLOYER COMMENTS DATED 27.01.2020 AND REVISED AS MKD. (C01)	- -	AVG	- -	SJM	
A01	MD-216-4200-EG-GE-DLO-0007	FACILITY SECURITY FORCE BASE CAMP SITE PLAN	20/12/2019	ISSUED FOR APPROVAL	RAFI	AVG	NILO	SHAU/SJM	

DESIGNER: مكتب الخليج للاستشارات الهندسية
GULF CONSULT ARCHITECTS AND ENGINEERS

DRAWING NUMBER	REVISION
CIVIL-PAV-016	3

DATE	DRAWN	DATE	CHECKED	DATE	APPROVED
29/09/2020	RAN	29/09/2020	SHAU	29/09/2020	NILO

LARSEN & TOUBRO DRAWING NUMBER: 019045_910_C_G_24349_001 — REVISION 3

OUTOTEC DRAWING NUMBER: 900707__GAU01__AN02__MTL01__18026 — DOCUMENT ID: OU100666795 — REVISION 3

LARSEN & TOUBRO

This drawing is the property of LARSEN & TOUBRO and must not be passed on to any person or body not authorized by us to receive it nor be copied or otherwise made use either in full or in part by such person or body without our prior permission in writing.

Outotec

The content of these documents are the sole property of Outotec Oyj. Any rights not expressly granted herein are reserved. Reproduction, transfer or distribution of part or all of the contents in any form without prior written permission of Outotec is prohibited.

MA'ADEN معادن
Saudi Arabian Mining Company شركة التعدين العربية السعودية

This document and the information contained herein is Ma'aden proprietary know-how. This document or any part thereof should not be reproduced, stored in a retrieval system or transmitted by any means, electronic or otherwise, or divulged without prior written permission of Ma'aden.

DRAWN			
CHECKED	AVG	25/11/2019	
ENGINEER			
APPROVED	SJM	20/12/2019	
EMPLOYER			
SCALE	1:200	A1	

MANSOURAH - MASSARAH GOLD PROJECT
GENERAL ARRANGEMENT DRAWING
FACILITY SECURITY FORCES BASE CAMP
OVERALL LAYOUT

DRAWING NUMBER: MD-216-1800-EG-CV-GAD-1565 — REV: D01