
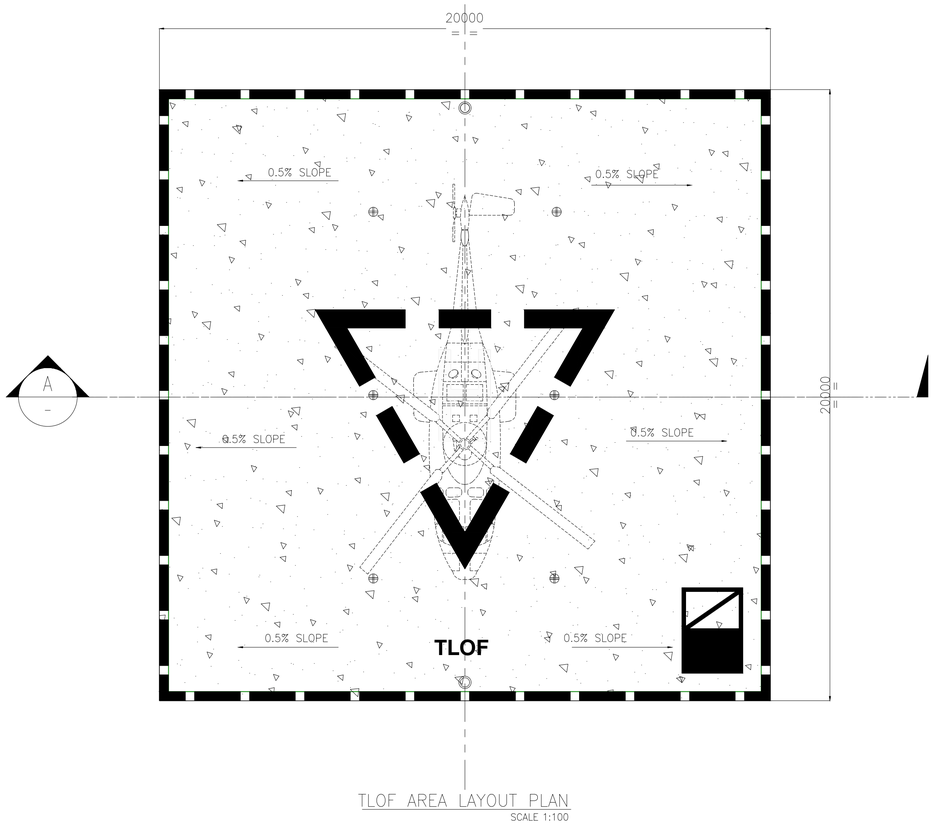


TLOF AREA LAYOUT PLAN
SCALE 1:100

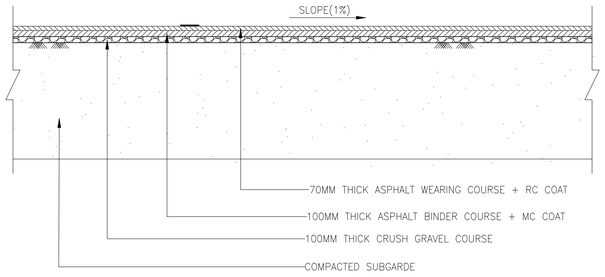


TYPICAL SECTION OF ASPHALT SURFACE
SCALE 1:50

NOTES

1. ALL DIMENSIONS ARE IN MILLIMETRES AND ALL LEVELS ARE GIVEN IN METRES UNLESS OTHERWISE NOTED.
2. HELIPAD DESIGN IS BASED ON MOI DIRECTORATE OF SAFETY – SPECIFICATION GUIDE FOR HELICOPTERS AIRFIELDS DATED JULY 2017.
3. ALL REINFORCING STEEL SHALL BE DEFORMED BILLET STEEL BARS CONFORMING TO ASTM–A615, WITH MINIMUM YIELD STRENGTH OF FY420 MPA .
4. THE MINIMUM CONCRETE COVER SHALL BE 25 MM.
5. FOR ELECTRICAL CONDUIT LAYING AND LIGHTING FIXTURE ARRANGEMENT REFER SEPARATE ELECTRICAL DRAWING.
6. MINIMUM REINFORCED CONCRETE GRADE TO BE USED FOR SUPERSTRUCTURE & SUBSTRUCTURES IS C35(5000 PSI).
7. HELIPAD HAS BEEN DESIGNED TO SERVE HELICOPTER AW139 & ALL THE APPLICABLE LOADS HAVE BEEN CONSIDERED.

LEGENDS

T & B	TOP AND BOTTOM
B / W	BOTH WAYS
CJ	CONTROL JOINT(BOTH WAYS)
REINF.	REINFORCEMENT
TYP.	TYPICAL
MC	MEDIUM CURE
RC	RAPID CURE
Ø	DIAMETER
TLOF	TOUCHDOWN & LIFT–OFF AREA

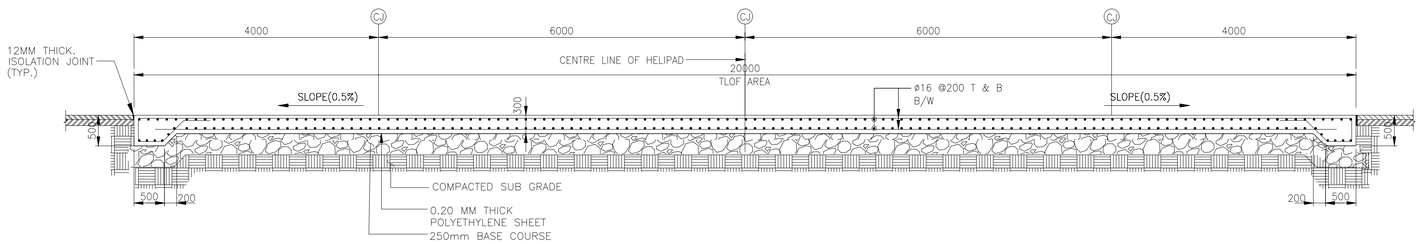

SECTION–A
SCALE 1:50

DOCUMENT NUMBER	REFERENCE DOCUMENTS	REV	DATE	REVISION DESCRIPTION	DRN	CHK	ENG	APP	EMP
		D01	22/05/2023	AS - BUILT	-	AVG	-	SJM	
		C01	12/08/2020	ISSUED FOR CONSTRUCTION & REVISED AS PER					
				EMPLOYERS COMMENT ON 24/07/2020	-	AVG	-	SJM	
MD-216-49RH-EG-CV-DED-1006	LAYOUT AND DETAILS	A02	28/06/2020	REVISED AS PER EMPLOYER COMMENTS ON 11/06/2020	-	AVG	-	SJM	
MD-216-1000-EG-ST-CRT-1001	CIVIL, STRUCTURAL & ARCHITECTURAL DESIGN CRITERIA	A01	15/05/2020	ISSUED FOR APPROVAL	-	AVG	-	SJM	



LARSEN & TOUBRO DRAWING NUMBER: 019045_910_C_D_24005_001 — REVISION 3

OUTOTEC DRAWING NUMBER: 900707 _ GAU01 _ AN03 _ CTB17 _ 00001 — DOCUMENT ID: OU100686691 — REVISION 3

LARSEN & TOUBRO

This drawing is the property of *LARSEN & TOUBRO* and must not be passed on to any person or body not authorized by us to receive it nor be copied or otherwise made use either in full or in part by such person or body without our prior permission in writing.

Outotec

The content of these documents are the sole property of Outotec Oyj. Any rights not expressly granted herein are reserved. Reproduction, transfer or distribution of part or all of the contents in any form without prior written permission of Outotec is prohibited.

MA'ADEN معادن
Saudi Arabian Mining Company شركة المعادن العربية السعودية

This document and the information contained herein is Ma'aden proprietary know-how. This document or any part thereof should not be reproduced, stored in a retrieval system or transmitted by any means, electronic or otherwise, or divulged without prior written permission of Ma'aden.

DRAWN	_		MANSOURAH - MASSARAH GOLD PROJECT
CHECKED	AVG	13/05/2020	DETAIL DRAWING
ENGINEER	_		HELIPAD
APPROVED	SJM	15/05/2020	DETAILS OF FLOOR
EMPLOYER			
SCALE	1:100,50	A1	DRAWING NUMBER: MD - 216 - 49RH - EG - CV - DED - 1007 — REV: D01

MA'ADEN معادن Saudi Arabian Mining Company شركة التعدين العربية السعودية	BECHTEL	**Mansourah Massarah Gold Project** **Comment Resolution Log Sheet / Compliance Report**	Outotec LARSEN & TOUBRO

PROJECT: **MANSOURAH MASSARAH GOLD PROJECT** **PROJECT NO.:** **216**

STAGE: **4 - PROJECT EXECUTION.** **REVIEW LOG DOC. NO. & REV.:**

ACONEX REF. NO. & DATE: BECHTEL-WTRAN-003896, 24 July 2020

STATUS CODE: A - APPROVED, C - APPROVED WITH COMMENTS, R - REVISE & RESUBMIT & O - OTHERS (INFORMATION, REFERENCE, REVIEWED)

DOCUMENT NUMBER	Area / Title	Comment No.	PMC/PMT COMMENT DATE:24 July 2020	Comment by	EPC Response DATE: 12 August,2020	Status	Remarks
			General Comments (cc)				
MD-216-49RH-EG-CV-DED-1007-A02	49RH	1	Please consider the comments done to the corresponding calculation sheet.	Mr.Klaus Grof Bechtel	Noted & Considered.	Closed	