


DRAWING NUMBER: MD-216-49RH-EG-CV-GAD-1006 | REV: D01

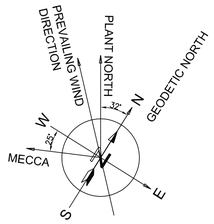

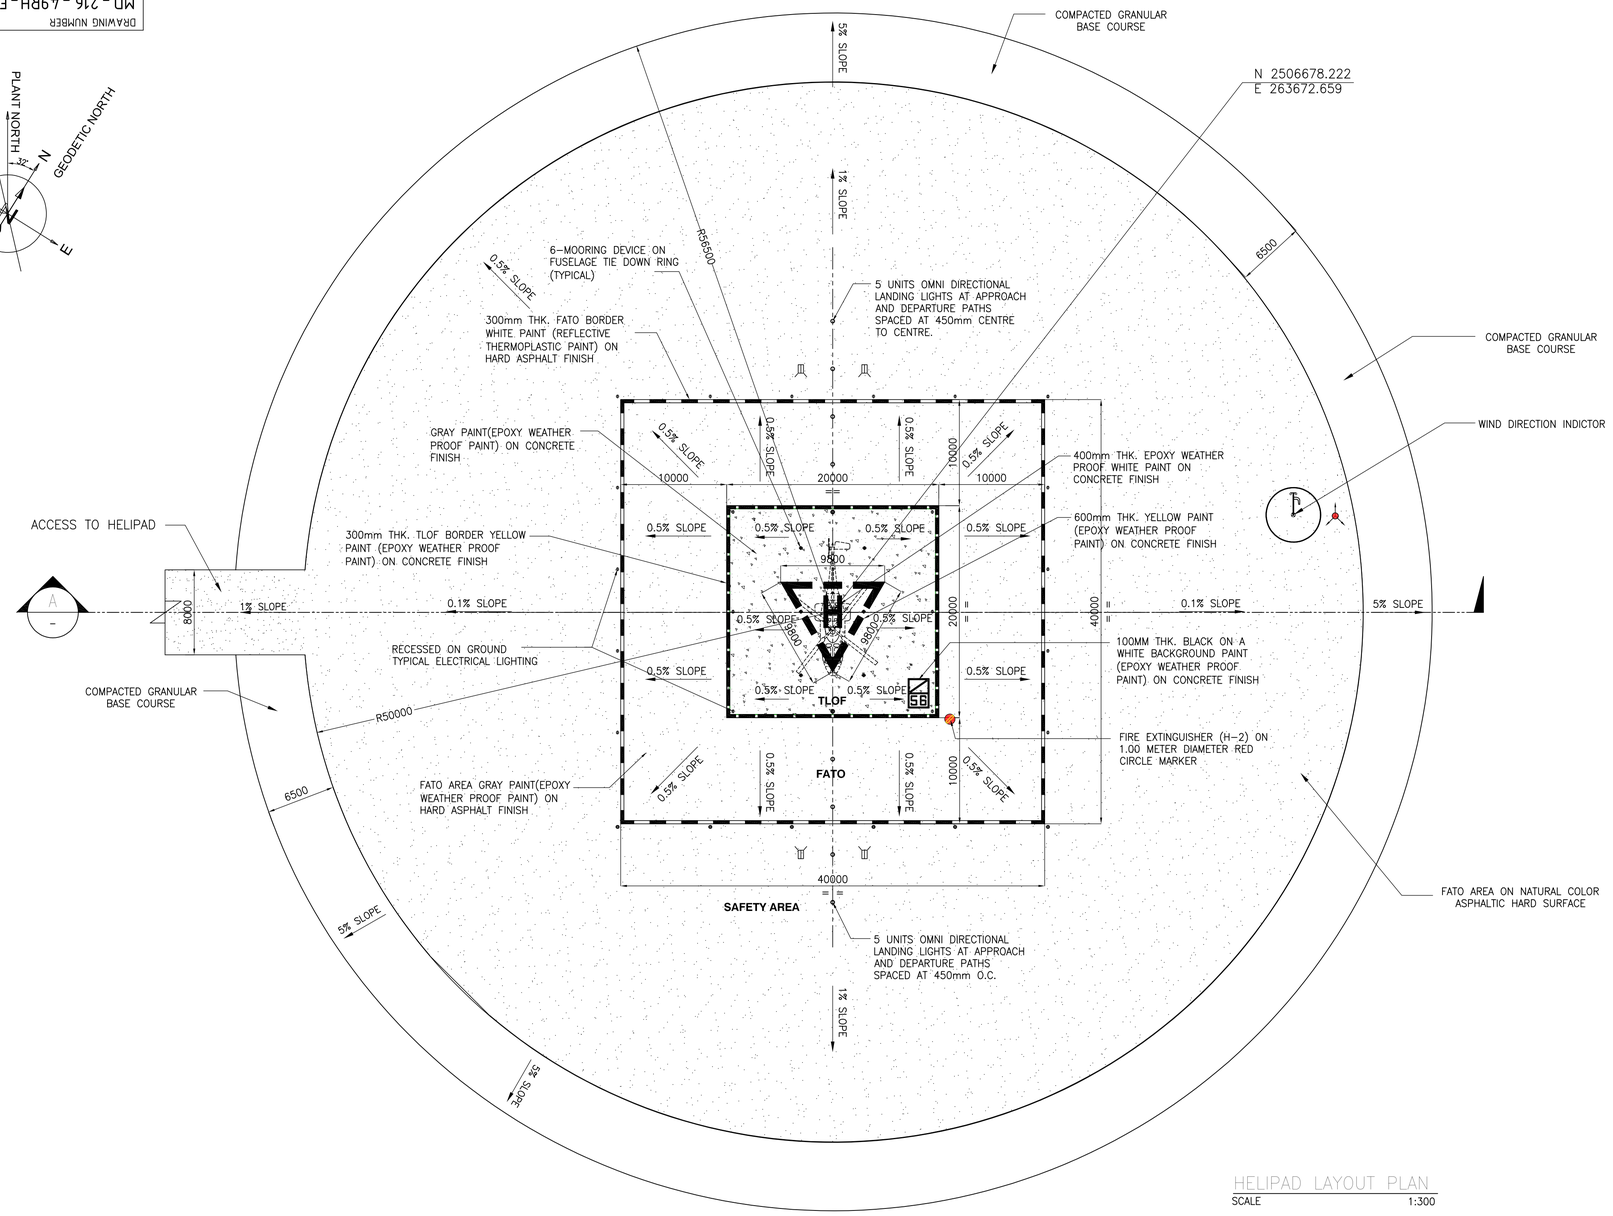


HELIPAD LAYOUT PLAN
SCALE 1:300

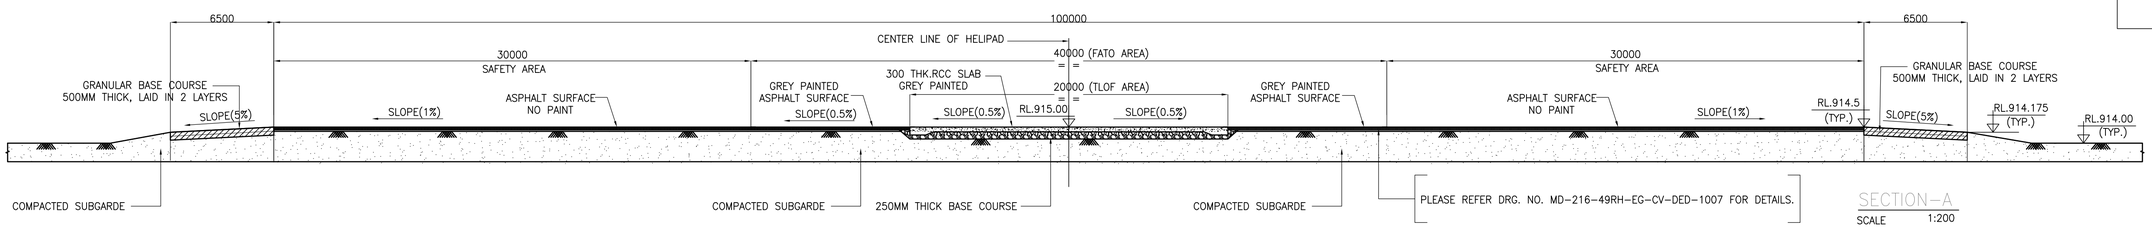

SECTION-A
SCALE 1:200

MASTER KEY PLAN

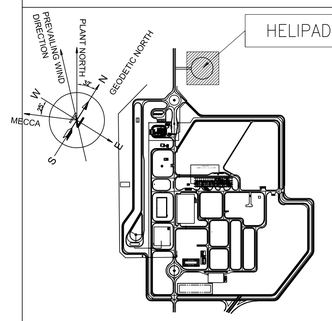

NOTES

1. ALL DIMENSIONS ARE IN MILLIMETRES AND ALL LEVELS ARE GIVEN IN METRES UNLESS OTHERWISE NOTED.
2. HELIPAD DESIGN IS BASED ON MOI DIRECTORATE OF SAFETY – SPECIFICATION GUIDE FOR HELICOPTERS AIRFIELDS DATED JULY 2017.
3. FOR ELECTRICAL CONDUIT LAYING AND LIGHTING FIXTURE ARRANGEMENT REFER SEPARATE ELECTRICAL DRAWING.

LEGEND

HELIPORT SYMBOL LEGEND

SYMBOL	DESCRIPTION
●	TLOF FLUSH INSET LIGHTING
●	FLUSH INSET LIGHT – GREEN
○	LANDING DIRECTION (WHITE)
⊕	FLUSH INSET LIGHT – BLUE
	ROTATING HELIPORT BEACON OR FLASHINH MORSE CODE "H BEACON"
	LIGHTED WINDSOCK
	CHAPI–HELICOPTER APPROACH PATH INDICATOR
56	TLOF SIZE/WEIGHT LIMITATION BOX

COLOR MARKING	
SYMBOL	COLOR
H	WHITE
TRIANGLE	YELLOW
TLOF	YELLOW
FATO	WHITE
BACKGROUND	GRAY

DOCUMENT NUMBER	REFERENCE DOCUMENTS	REV	DATE	REVISION DESCRIPTION	DRN	CHK	ENG	APP	EMP
		D01	17/03/2023	AS-BUILT	-	AVG	-	SJM	
		C03	09/01/2021	ISSUED FOR CONSTRUCTION & REVISED AS MARKED (03)	-	AVG	-	SJM	
		C02	14/12/2020	ISSUED FOR CONSTRUCTION & REVISED AS MKD. (02)	-	AVG	-	SJM	
MD-216-49RH-EG-CV-DED-1007	DETAILS OF FLOOR	C01	11/06/2020	ISSUED FOR CONSTRUCTION	-	AVG	-	SJM	
MD-216-1000-EG-ST-CRT-1001	CIVIL, STRUCTURAL & ARCHITECTURAL DESIGN CRITERIA	A01	15/05/2020	ISSUED FOR APPROVAL	-	AVG	-	SJM	

DESIGNER: مكتب الفليج للاستشارات الهندسية الغير، المملكة العربية السعودية
GULF CONSULT ARCHITECTS AND ENGINEERS

DRAWING NUMBER	DRAWING NO:		REVISION
AR-NPB-HEL-001			A01
DATE	08/05/2020	DATE 10/05/2020	DATE 12/05/2020
DRAWN	ABD	CHECKED ZYD	APPROVED NILO

LARSEN & TOUBRO DRAWING NUMBER: 019045_910_C_G_24004_001 | REVISION: 4
OUTOTEC DRAWING NUMBER: 900707 _ GAU01 _ AN03 _MTL01 _ 00003 | DOCUMENT ID: OU100686690 | REVISION: 4

LARSEN & TOUBRO

This drawing is the property of LARSEN & TOUBRO and must not be passed on to any person or body not authorized by us to receive it nor be copied or otherwise made use either in full or in part by such person or body without our prior permission in writing.

Outotec

The content of these documents are the sole property of Outotec Oyj. Any rights not expressly granted herein are reserved. Reproduction, transfer or distribution of part or all of the contents in any form without prior written permission of Outotec is prohibited.

MA'ADEN معادن
Saudi Arabian Mining Company شركة معادن العربية السعودية

This document and the information contained herein is Ma'aden proprietary know-how. This document or any part thereof should not be reproduced, stored in a retrieval system or transmitted by any means, electronic or otherwise, or divulged without prior written permission of Ma'aden.

DRAWN	–	
CHECKED	AVG	13/05/2020
ENGINEER	–	
APPROVED	SJM	15/05/2020
EMPLOYER		
SCALE	1:200,300	A1

MANSOURAH - MASSARAH GOLD PROJECT
GENERAL ARRANGEMENT DRAWING
HELIPAD
LAYOUT AND DETAILS

DRAWING NUMBER: MD-216-49RH-EG-CV-GAD-1006 | REV: D01